


5.28.20 E.T.
10.14.20 | 1.3.22
8.25.21 | 8.30.22
File 70TH ST

CELL 7001W = 7011W
0 - 50 ft

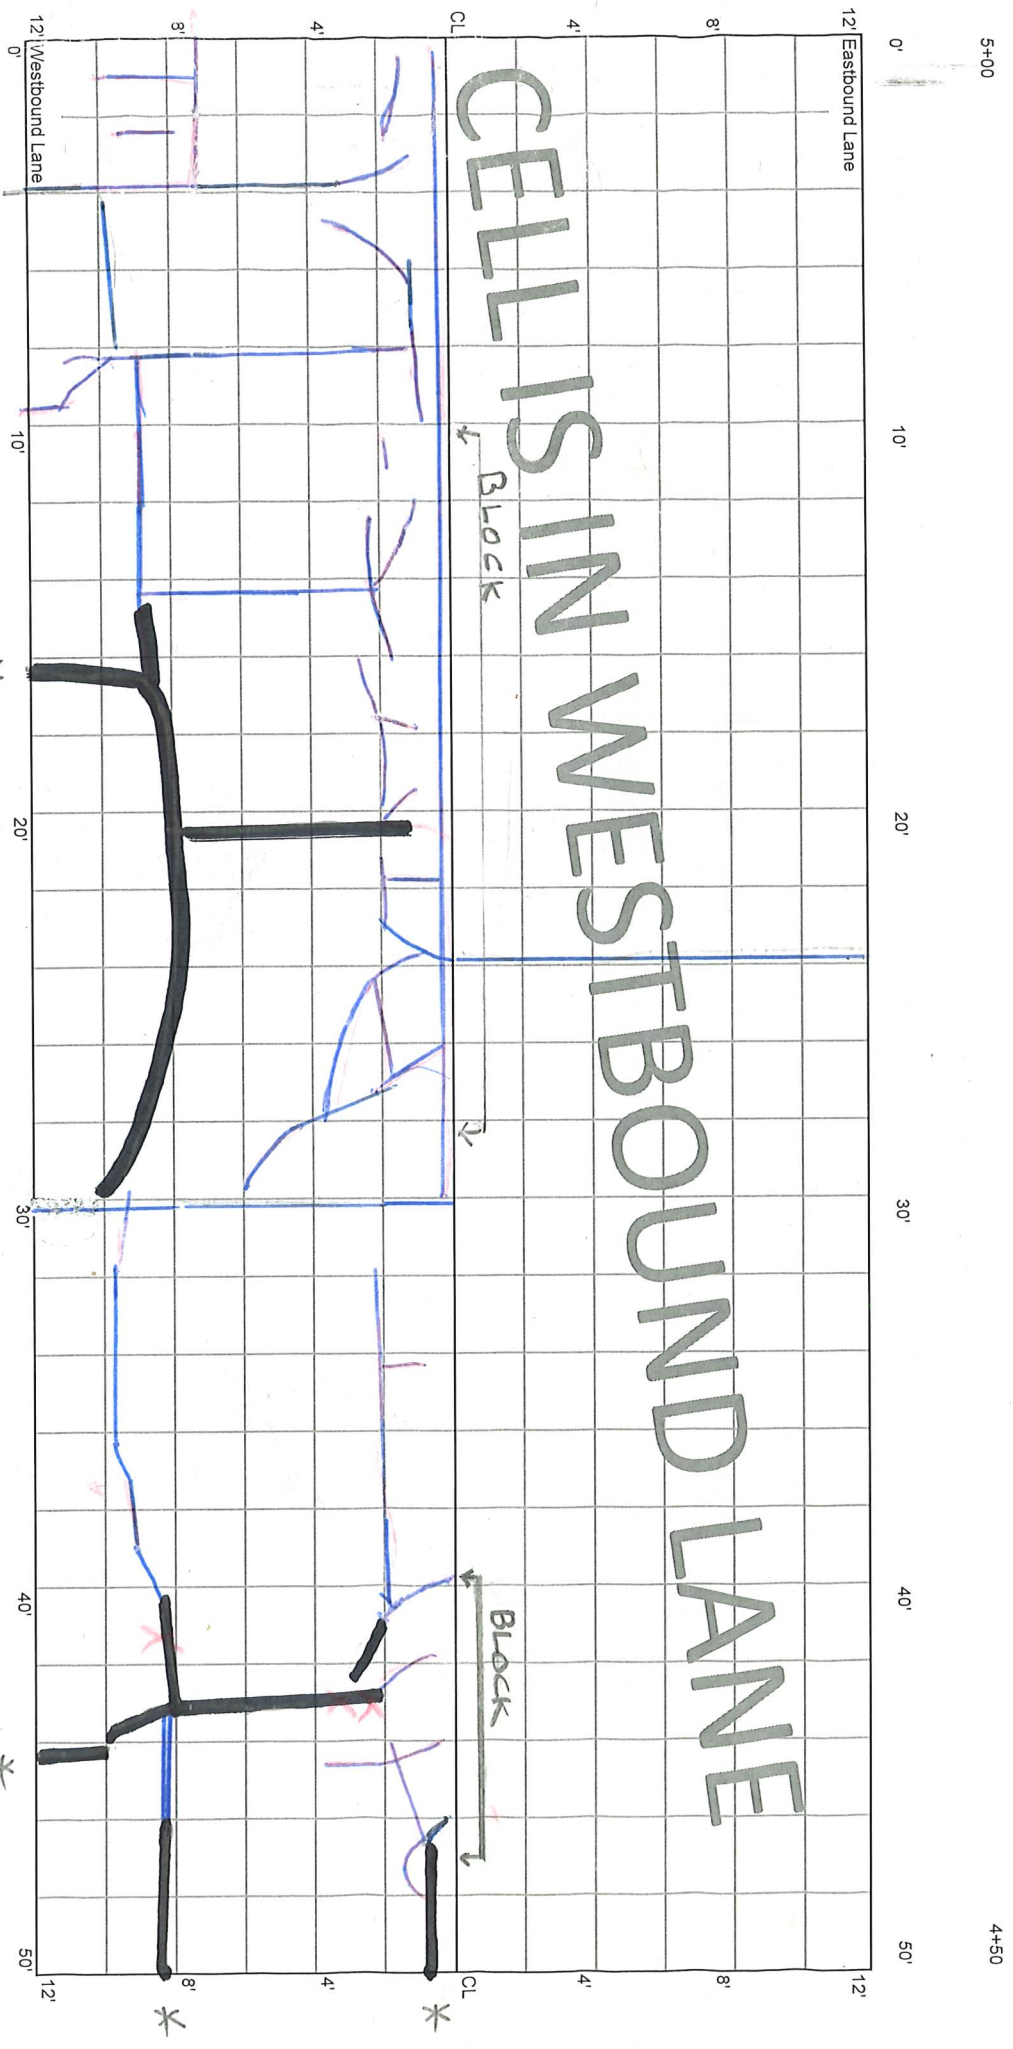

* Root & Seal

AF_L
Stones Throughout

F-1.1/2
R¹
P²

AF_L

4+50

2024.03.27
10

CELL 7001W
50 - 100 ft


4+50

4+00

12 Eastbound Lane

12 Westbound Lane

CELLS IN WESTBOUND LANE

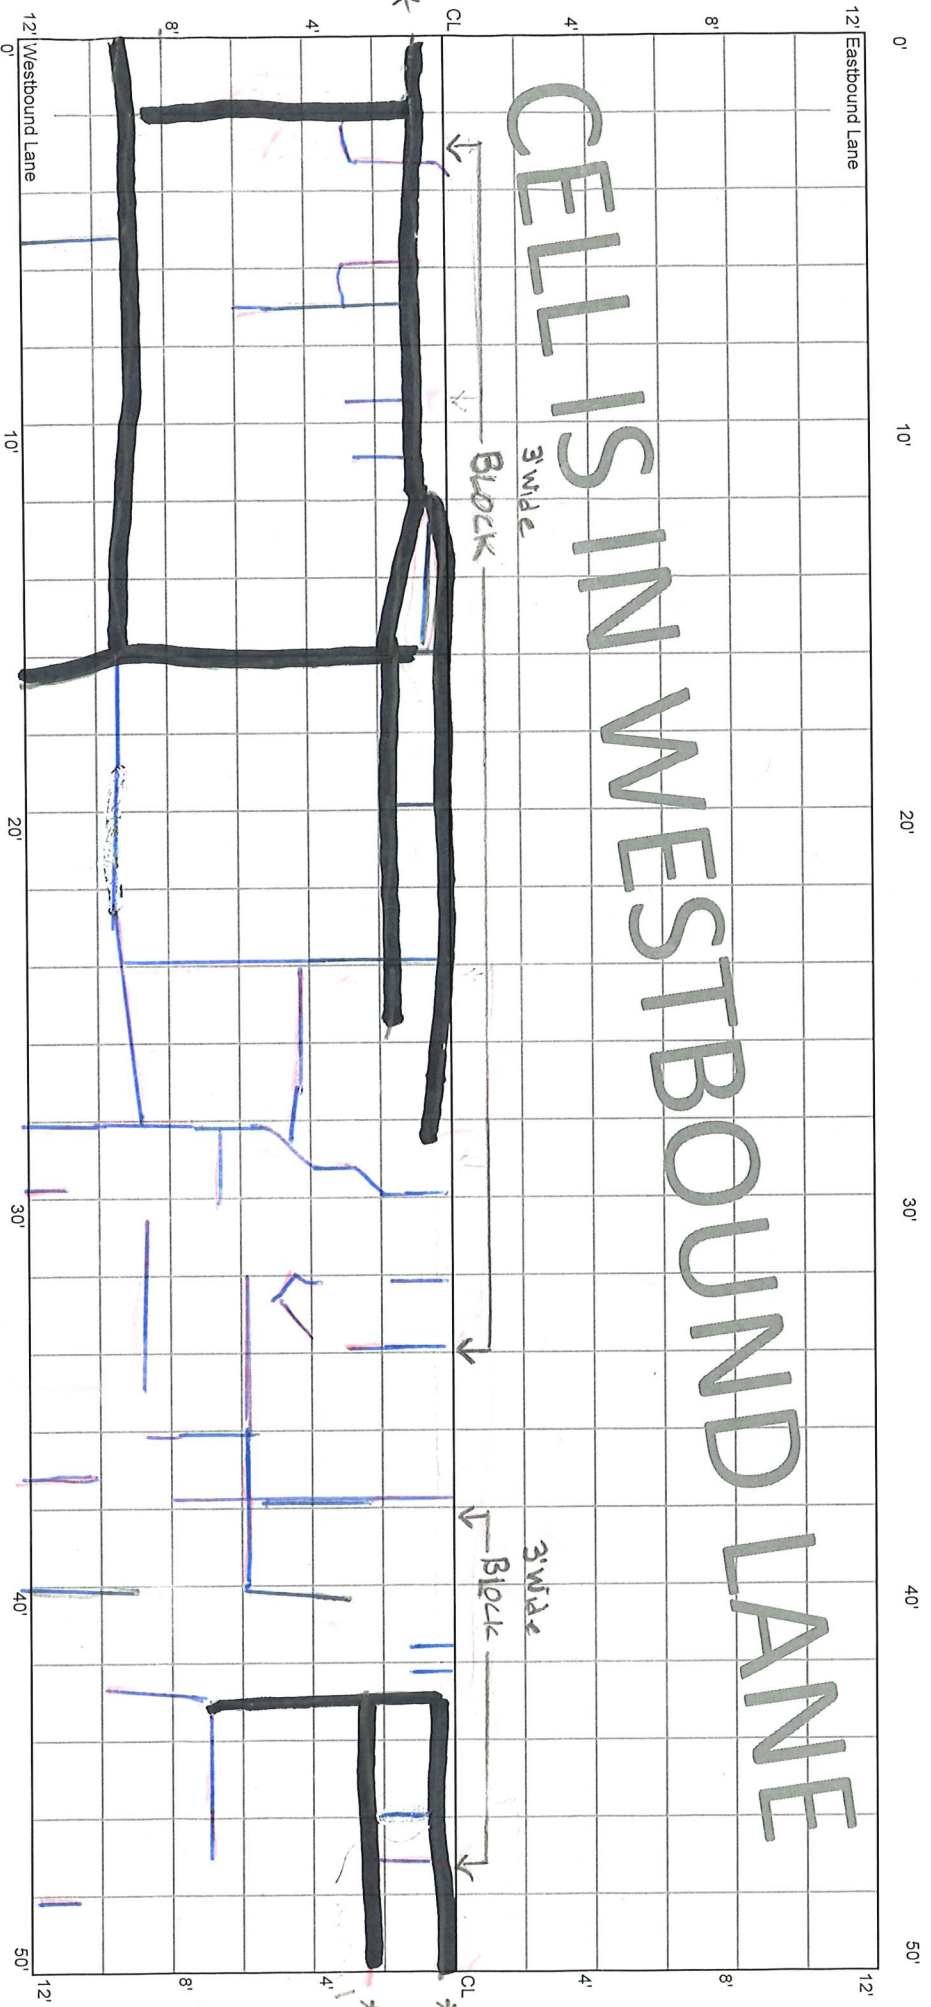

1'S.P.

* M


* M

* M

CELL 7001W
100 - 150 ft

4+00


3+50

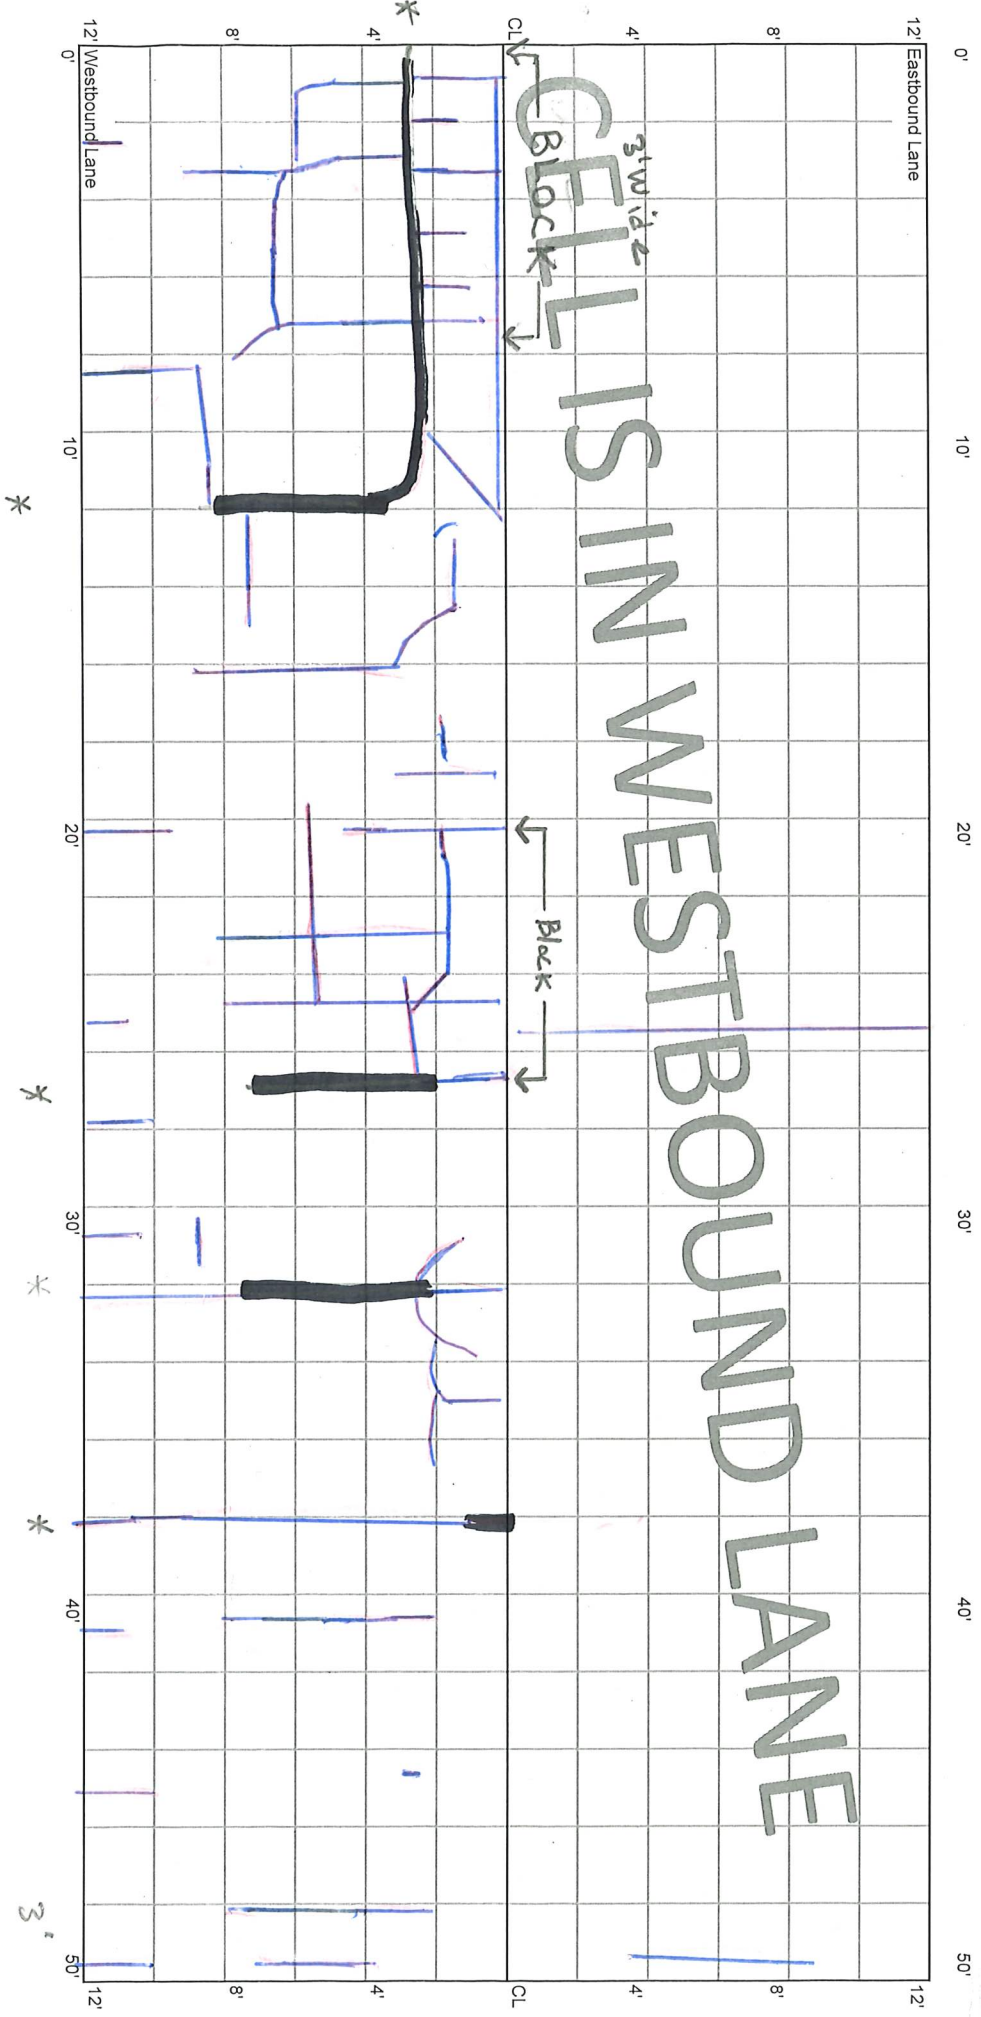

CELL 7001W 150 - 200 ft

3+50

3+00

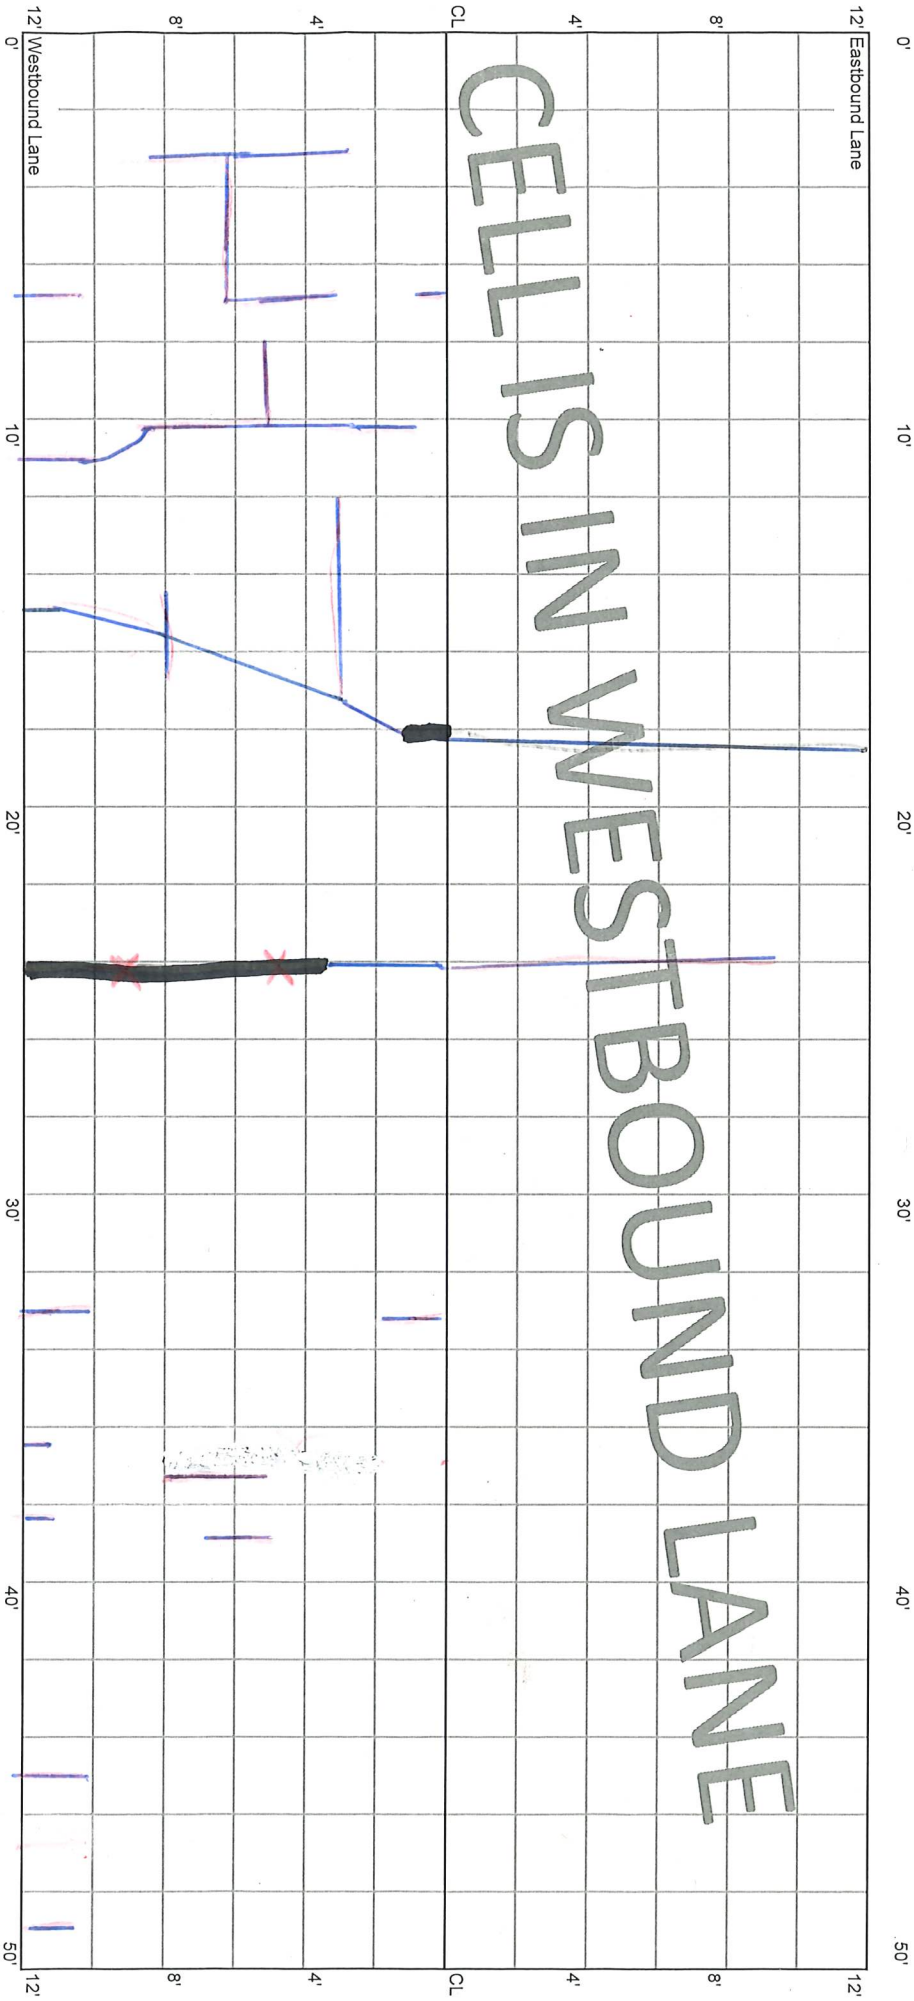

CELLS IN WESTBOUND LANE


2' AF

*

CELL 7001W
200 - 250 ft

3+00


2+50

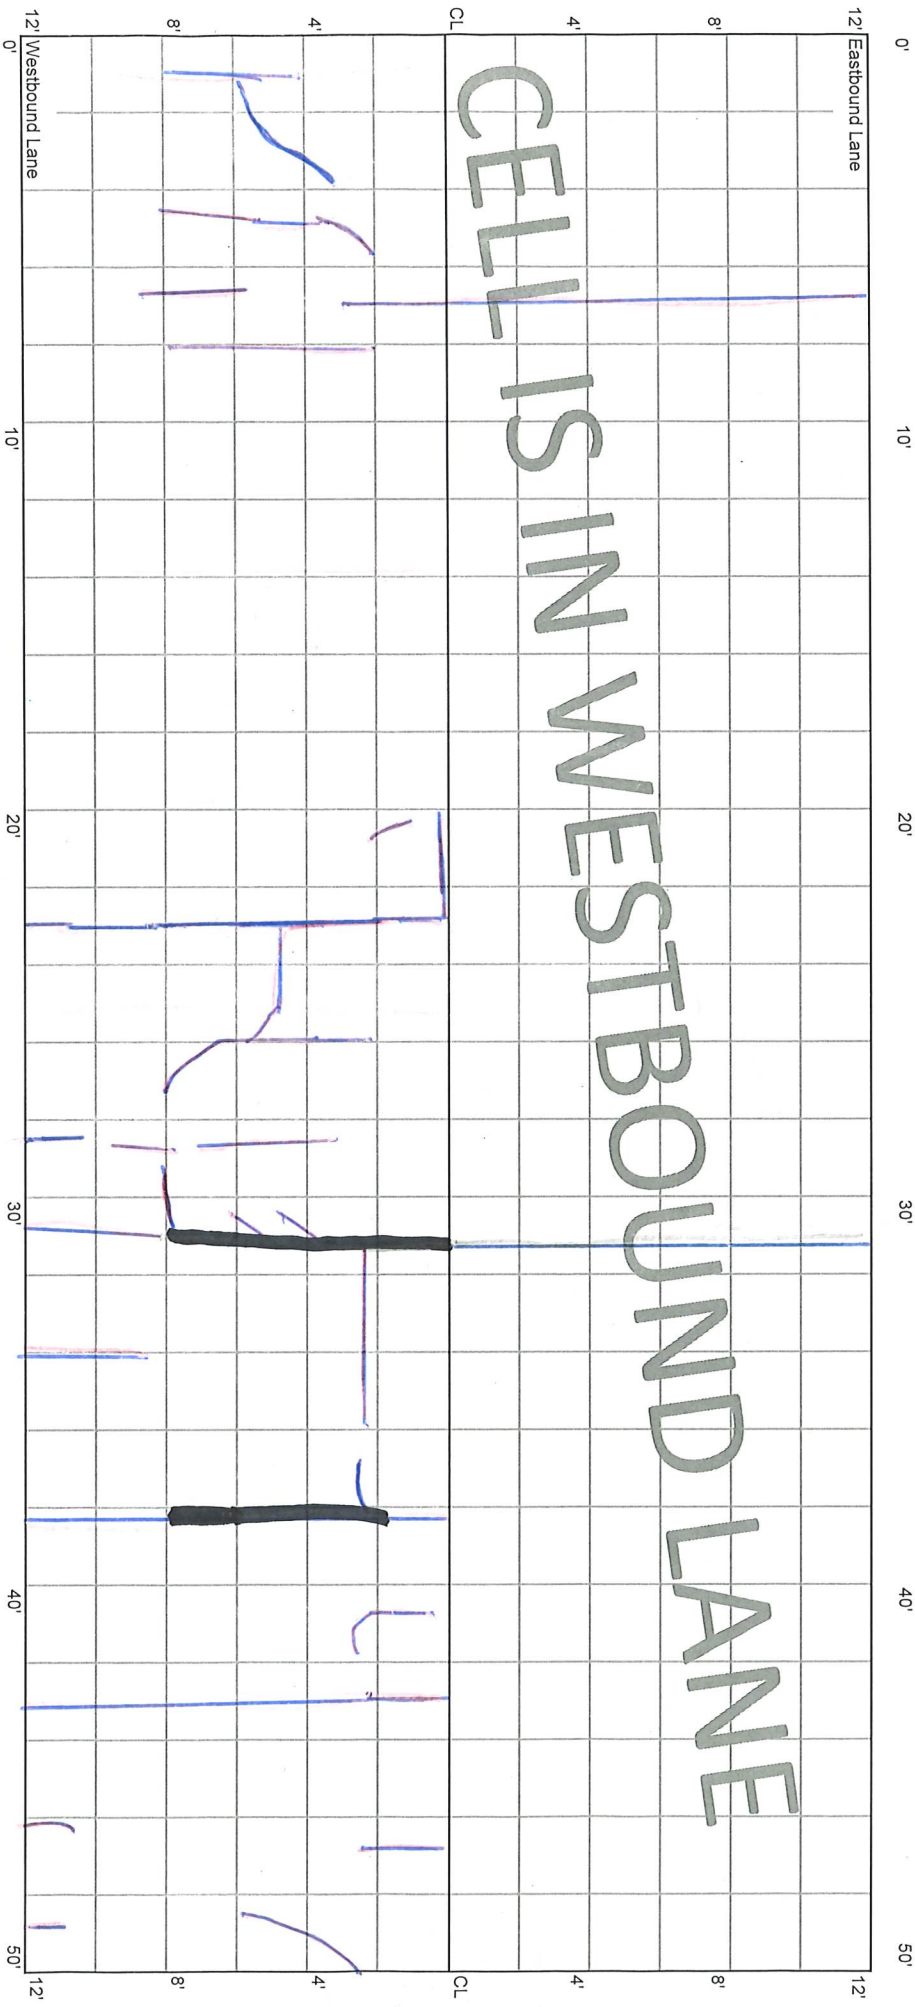

CELL 7001W
250 - 300 ft

2+50

2+00

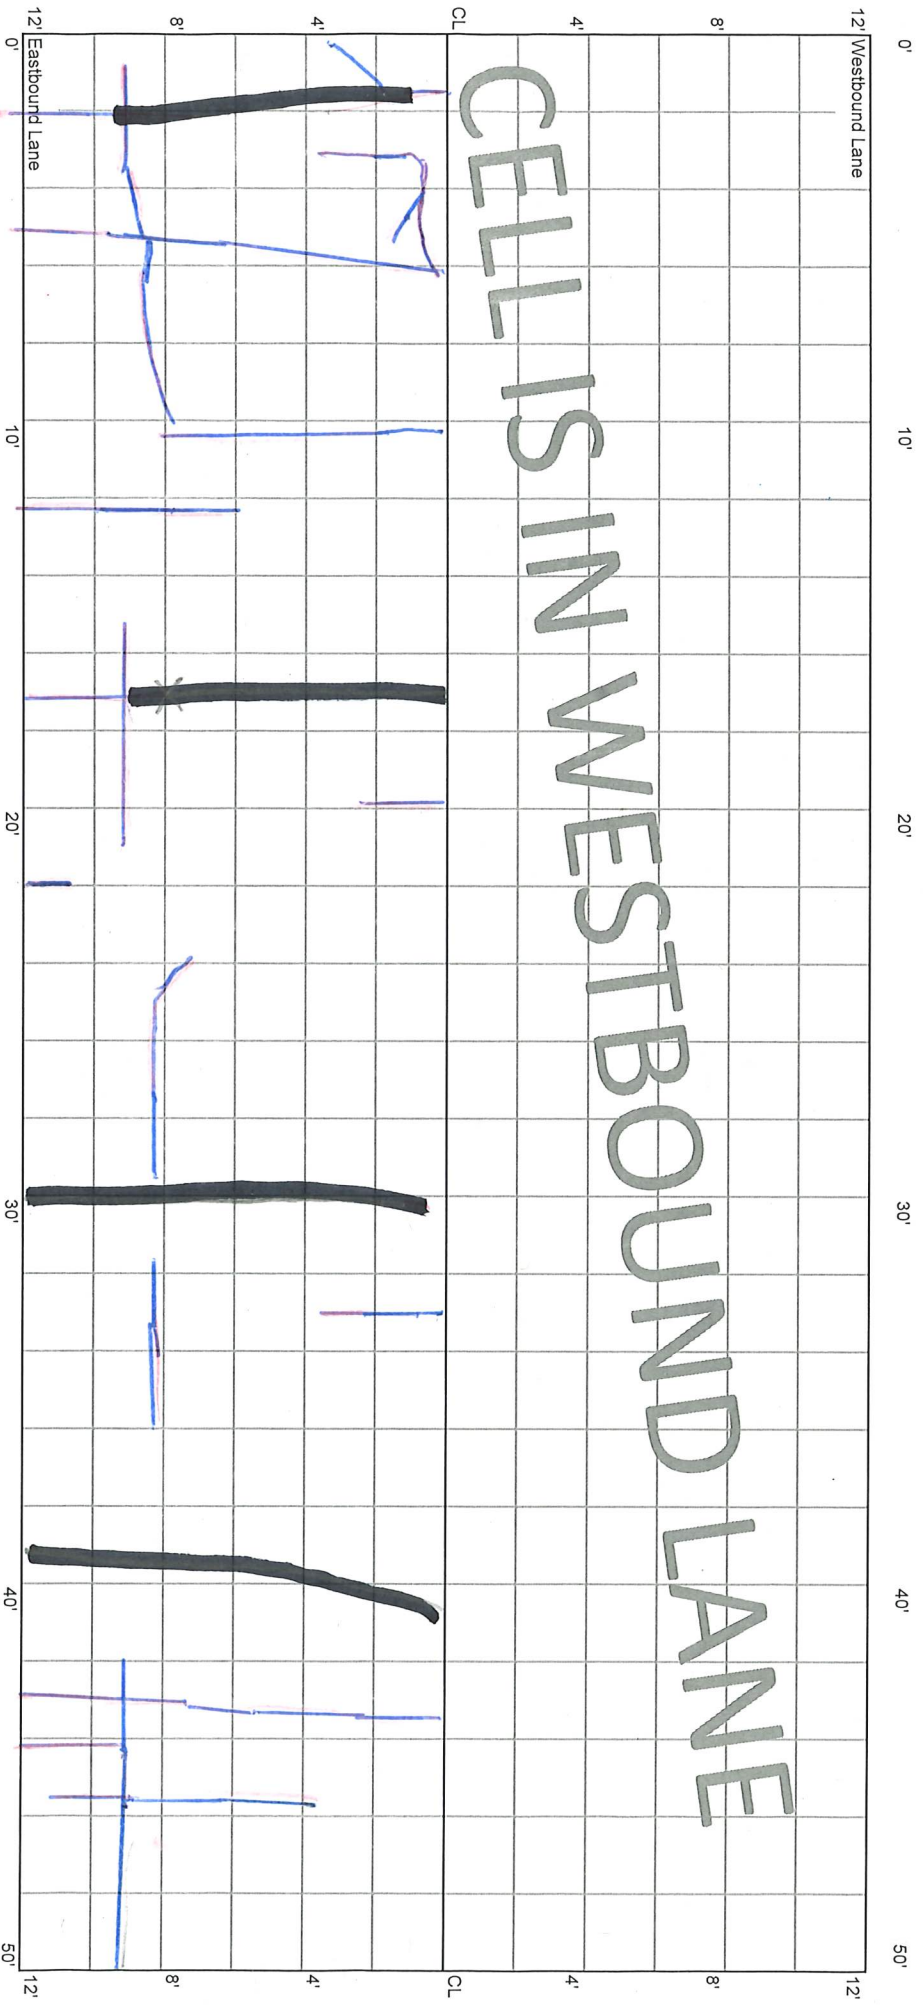

CELLS IN WESTBOUND LANE

*

* M

* SP

* AF

1' AF

SP

AF


X 4' Seal Lanes

CELL 7001W
300 - 350 ft


2+00

1+50

CELLS IN WESTBOUND LANE

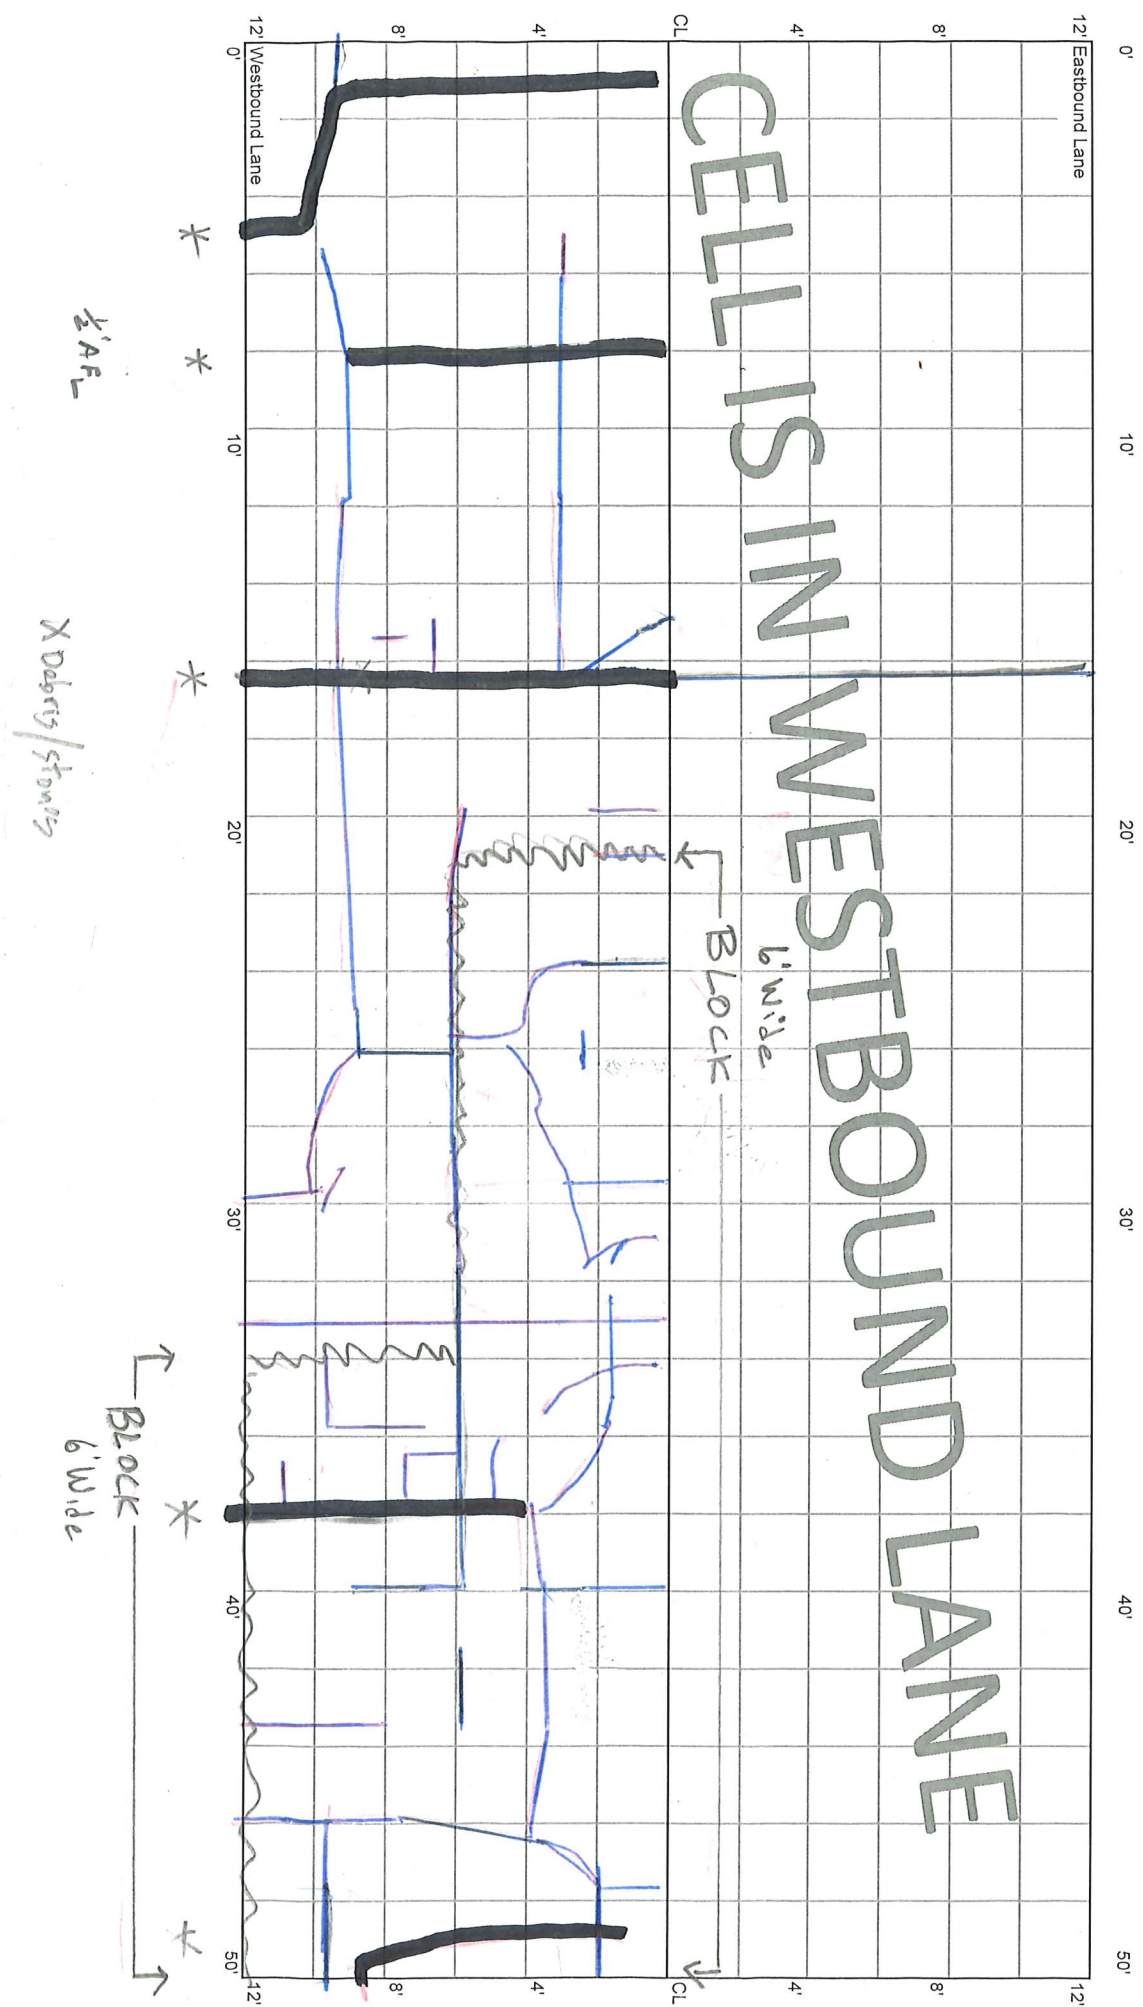

CELL 7001W
350 - 400 ft

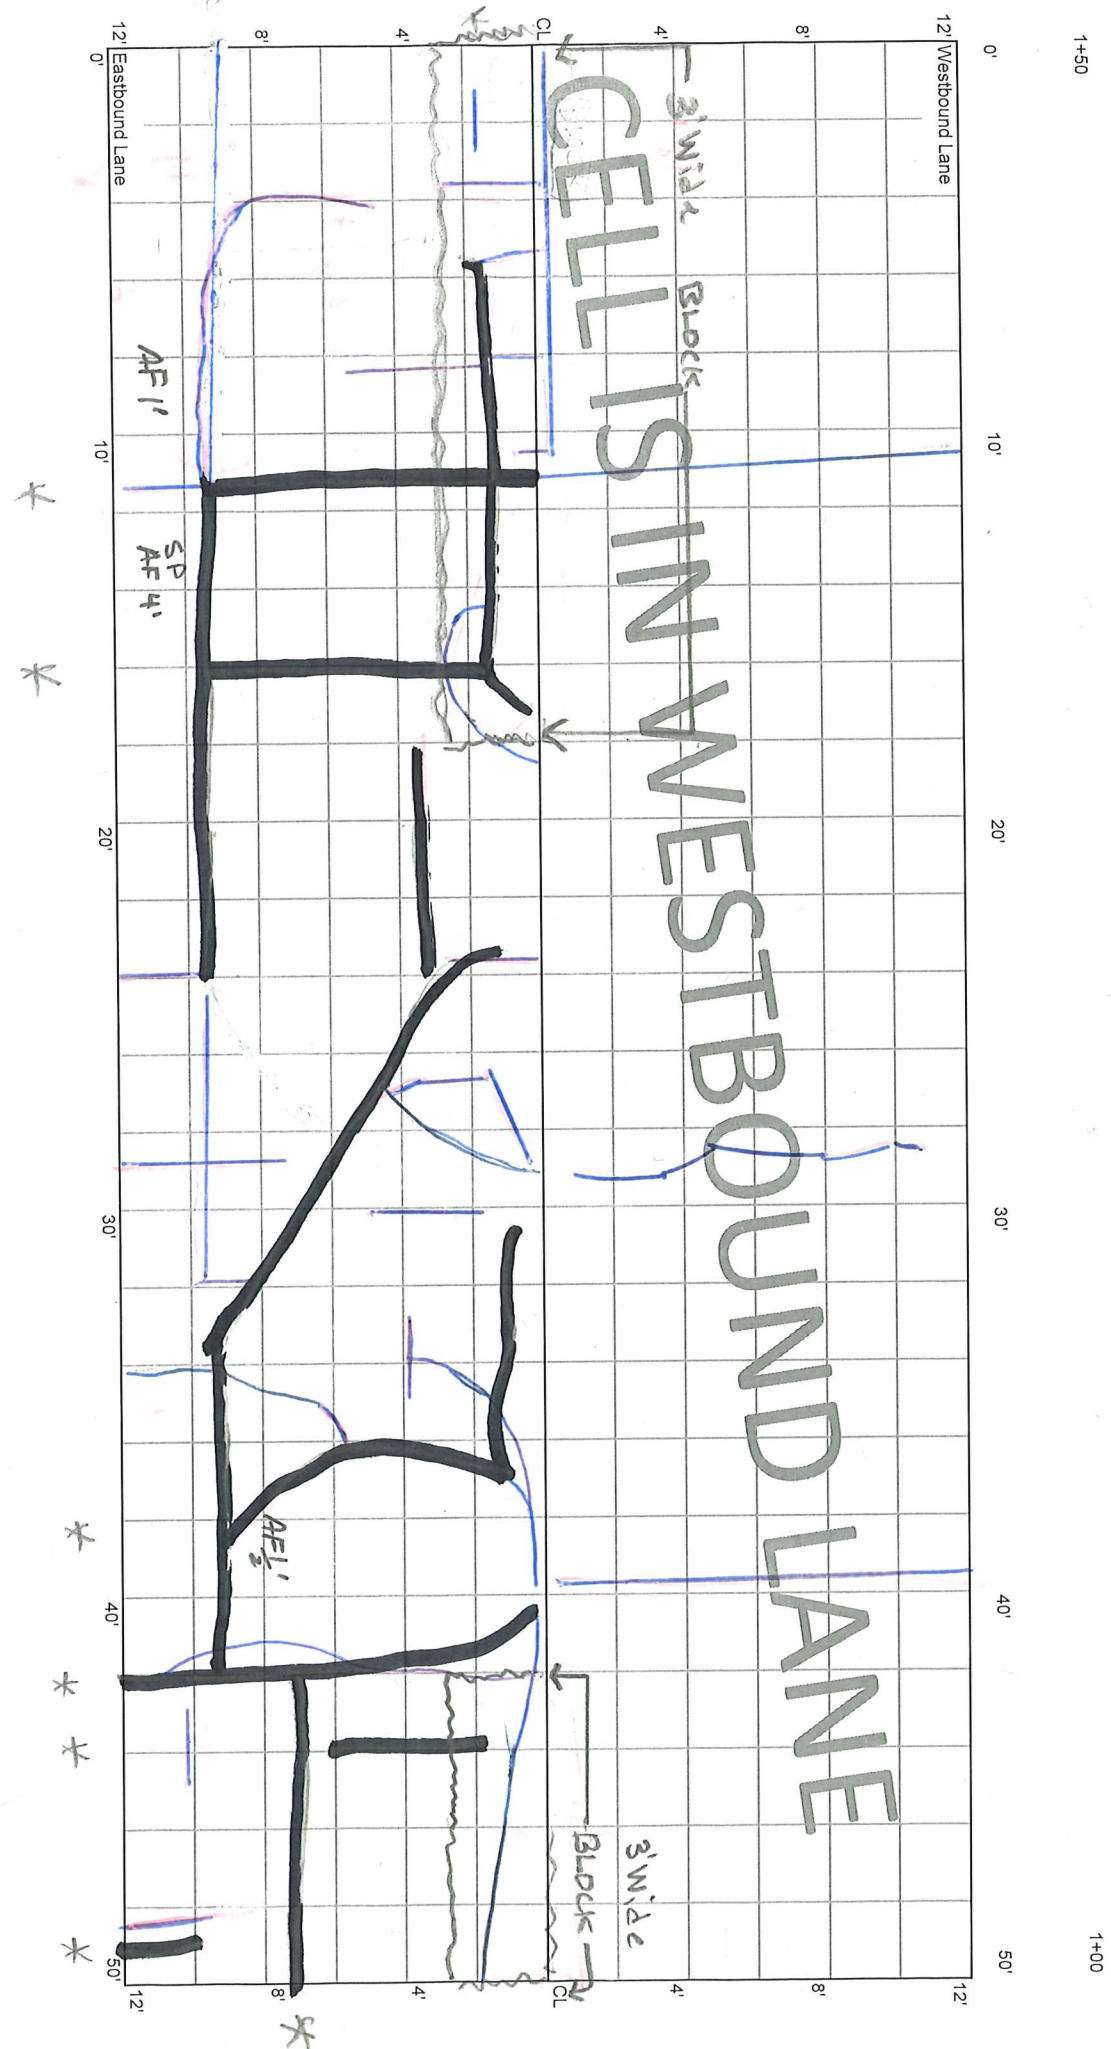

CELL 7001W
400 - 450 ft

1+00

0+50

12' Eastbound Lane

12' Westbound Lane

CELLS IN WESTBOUND LANE


Block 3' wide

Block

3' wide


Block

med

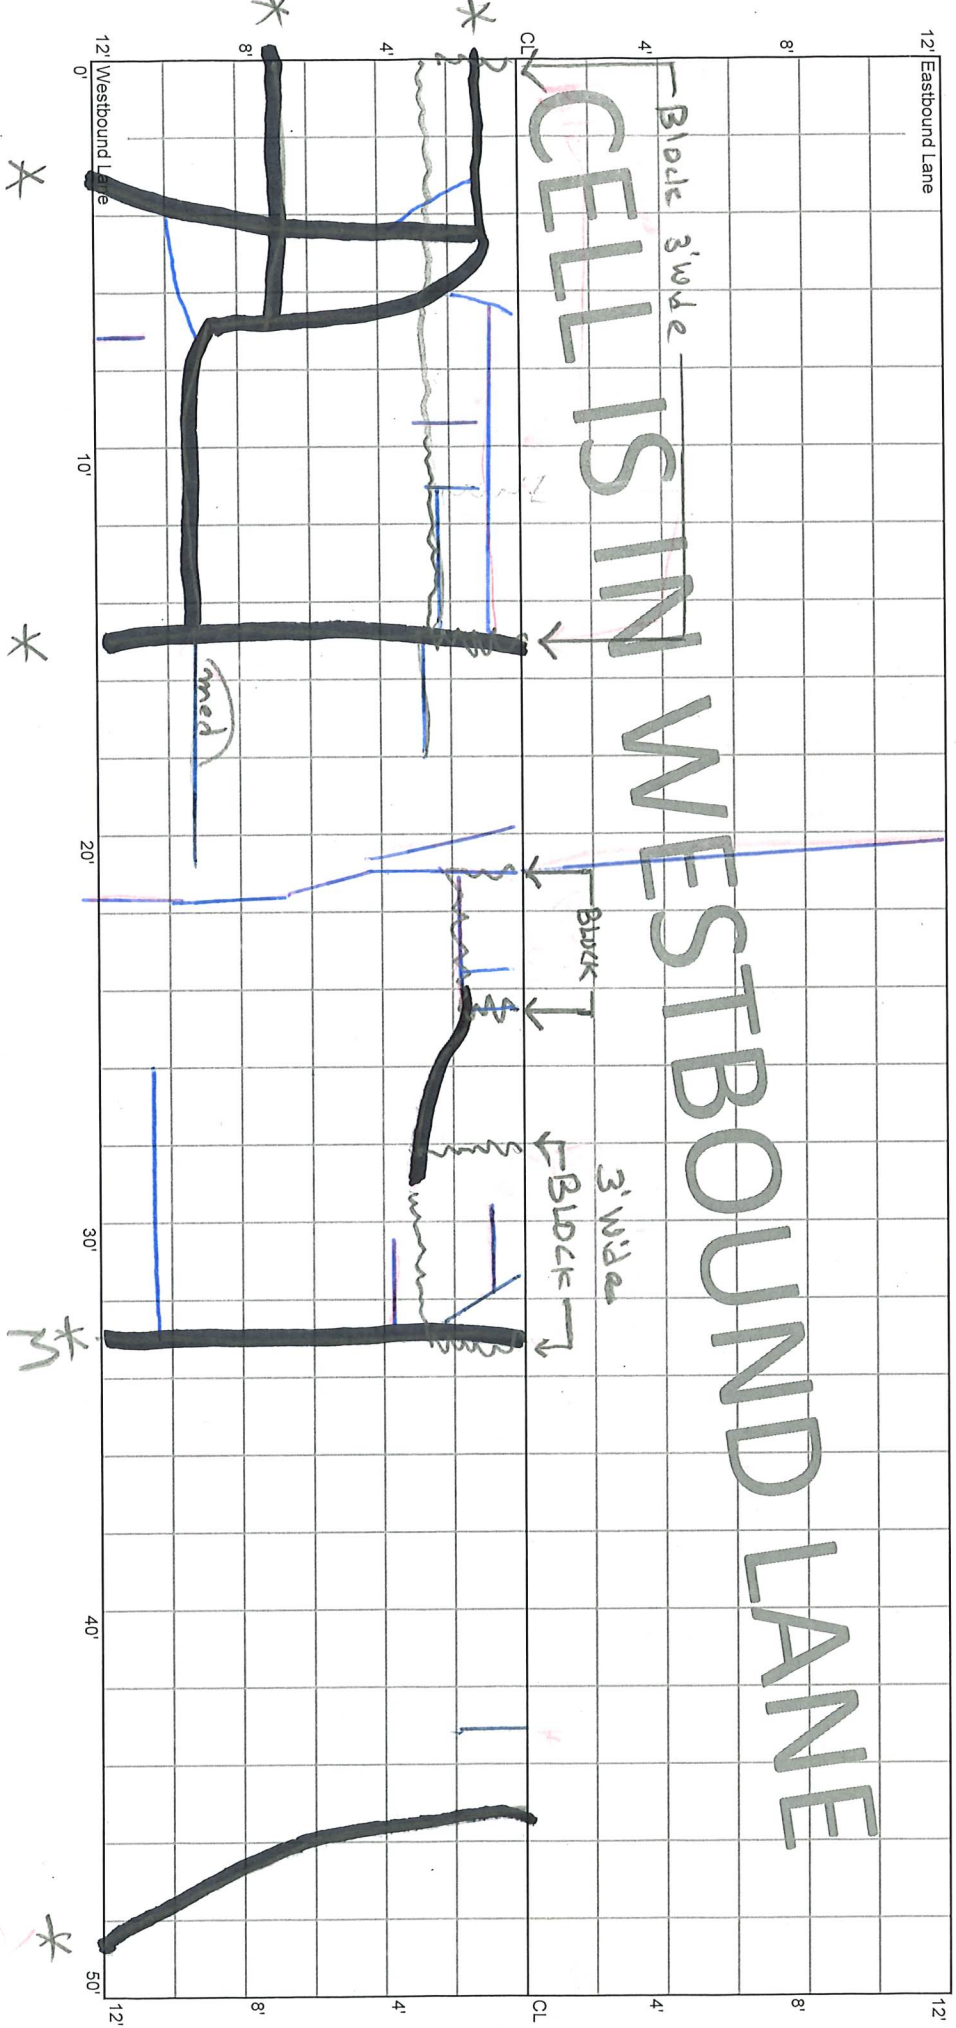

AF

End CL Kadler

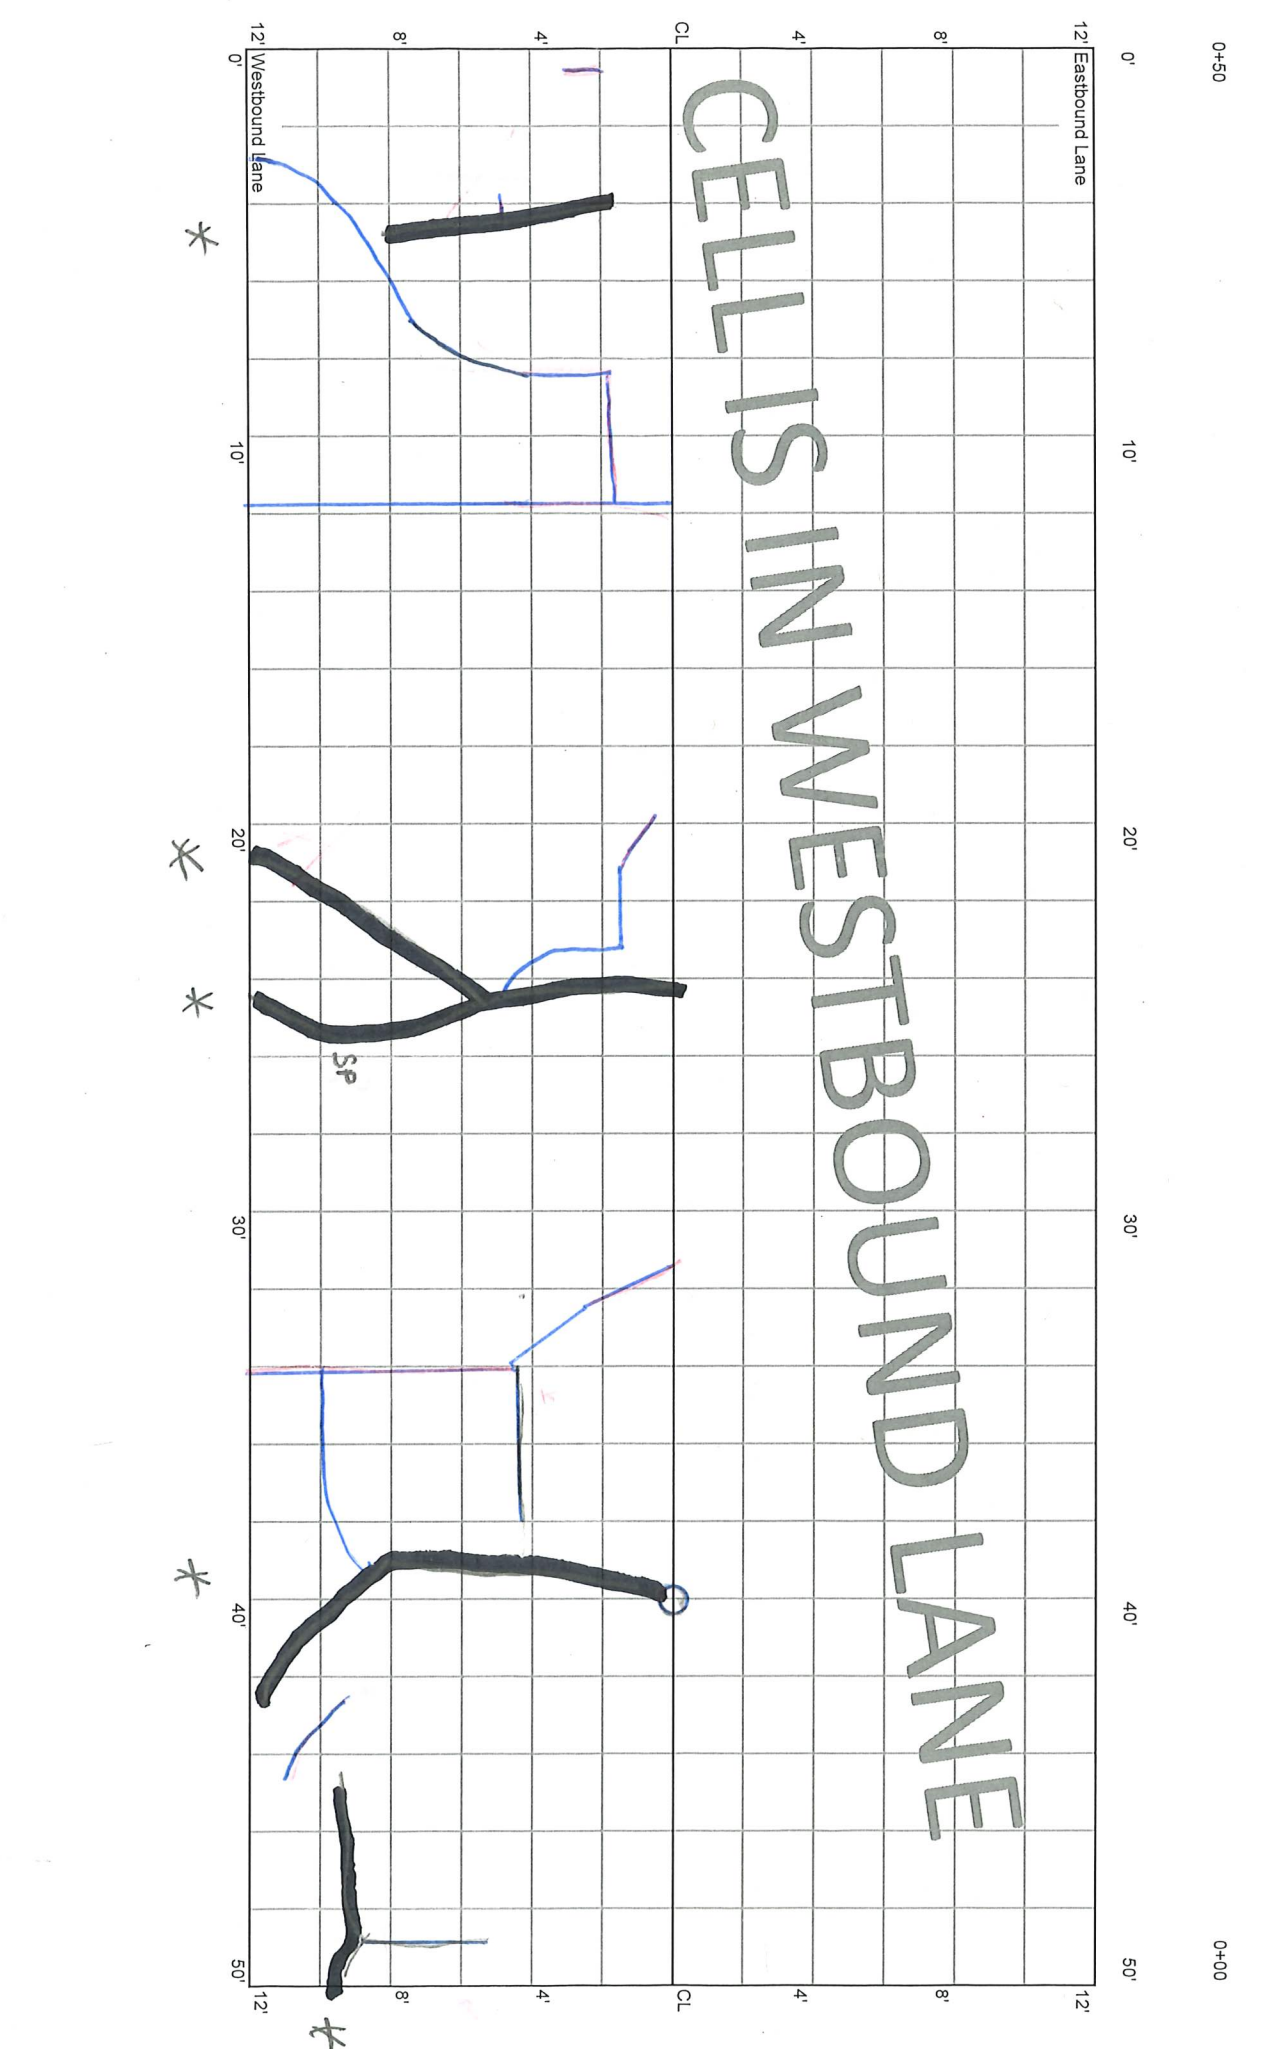

End CL Kadler

CELL 7001W
500 - 550 ft

0+00 -0+23

