


5.28.20 E.T.
 10.14.20 | 1.3.22
 1.4.21 | 8.30.22
 8.29.21 | 2.2.23
 File 70TH ST

CELL 7001W = 7011W
 0 - 50 ft

CELLS IN WESTBOUND LANE

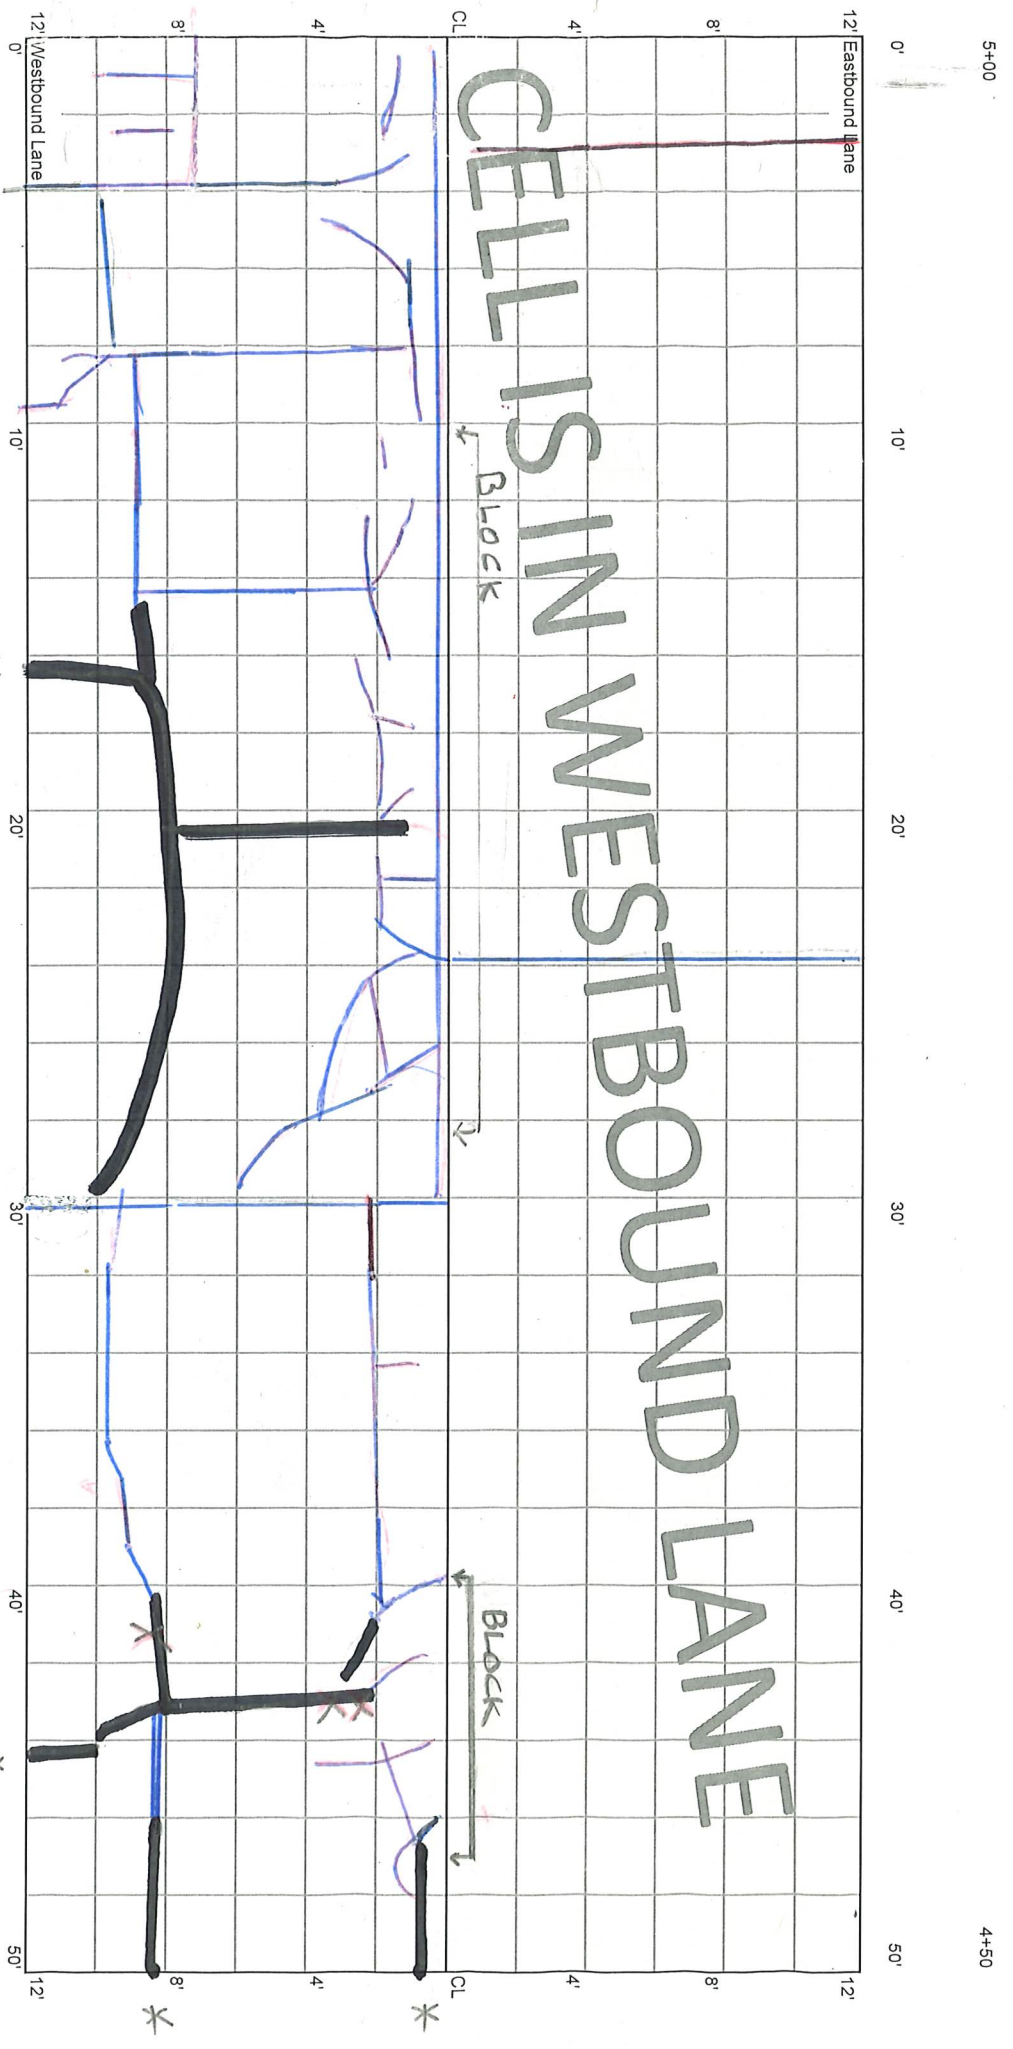

* Rout & Seal

AF_L
 Stones Throughout

F-11k
 R1
 R2

AF_L

2023.03.01
D

CELL 7001W
50 - 100 ft


4+50

4+00

12' Eastbound Lane

12'

CELLS IN WESTBOUND LANE

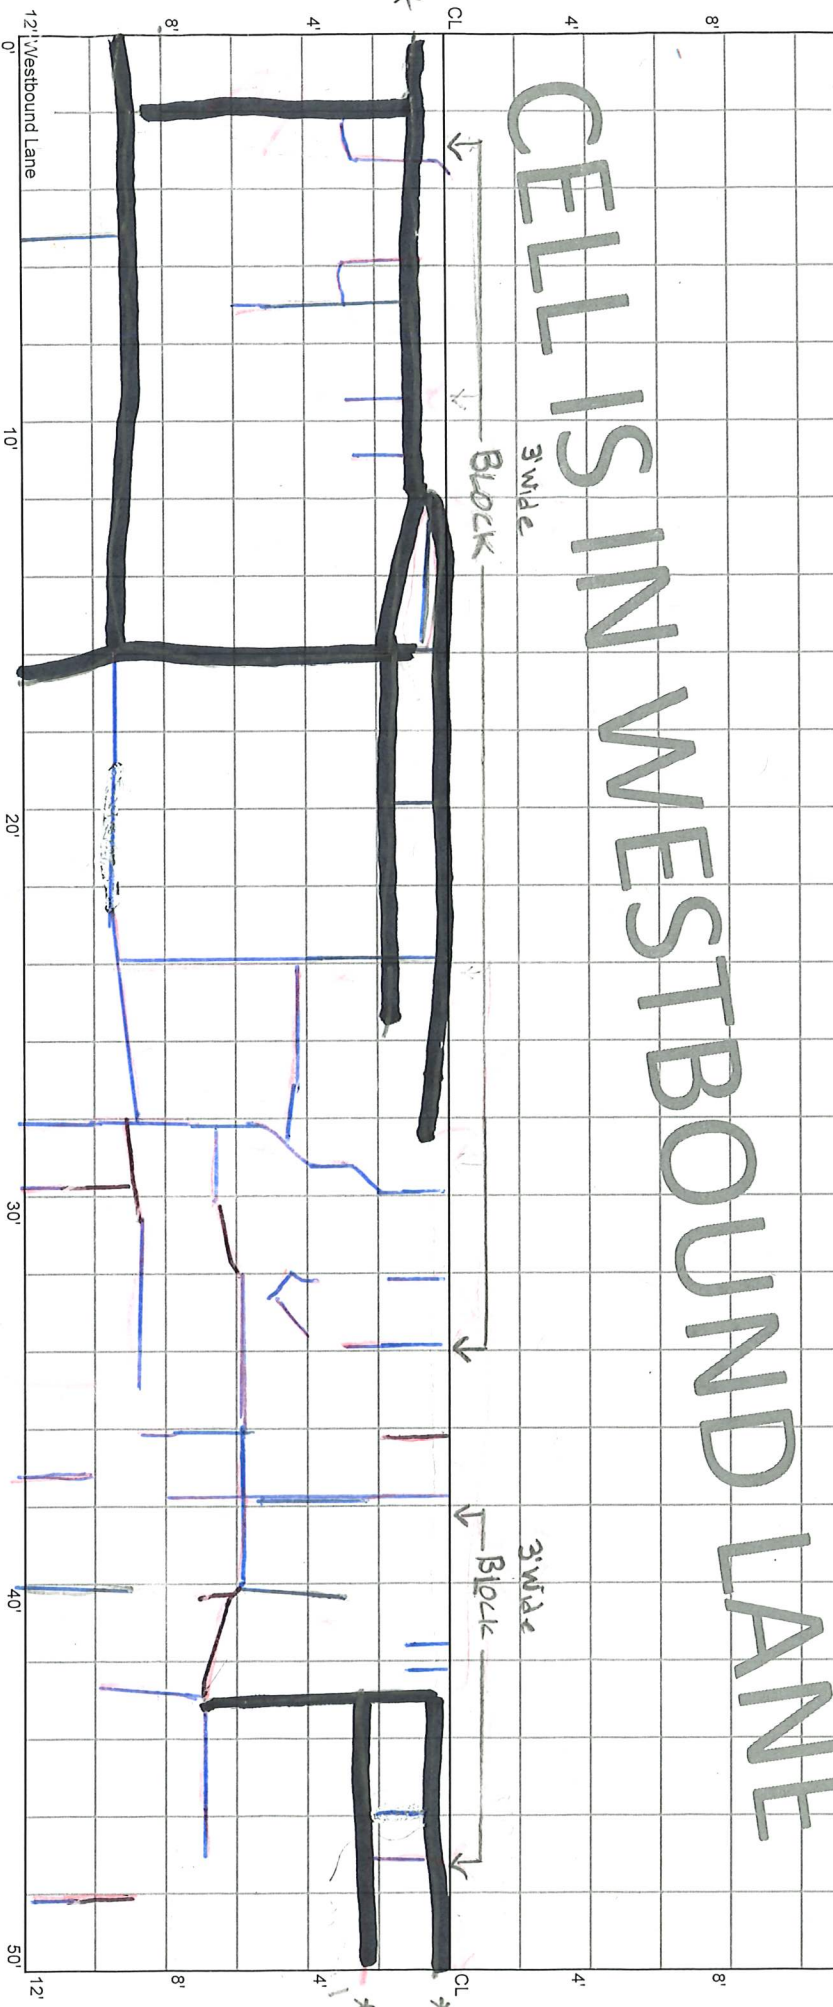

12' Westbound Lane

12'

1'S.P.

* M

* M


* M

* CL

CELL 7001W
100 - 150 ft

4+00

3+50

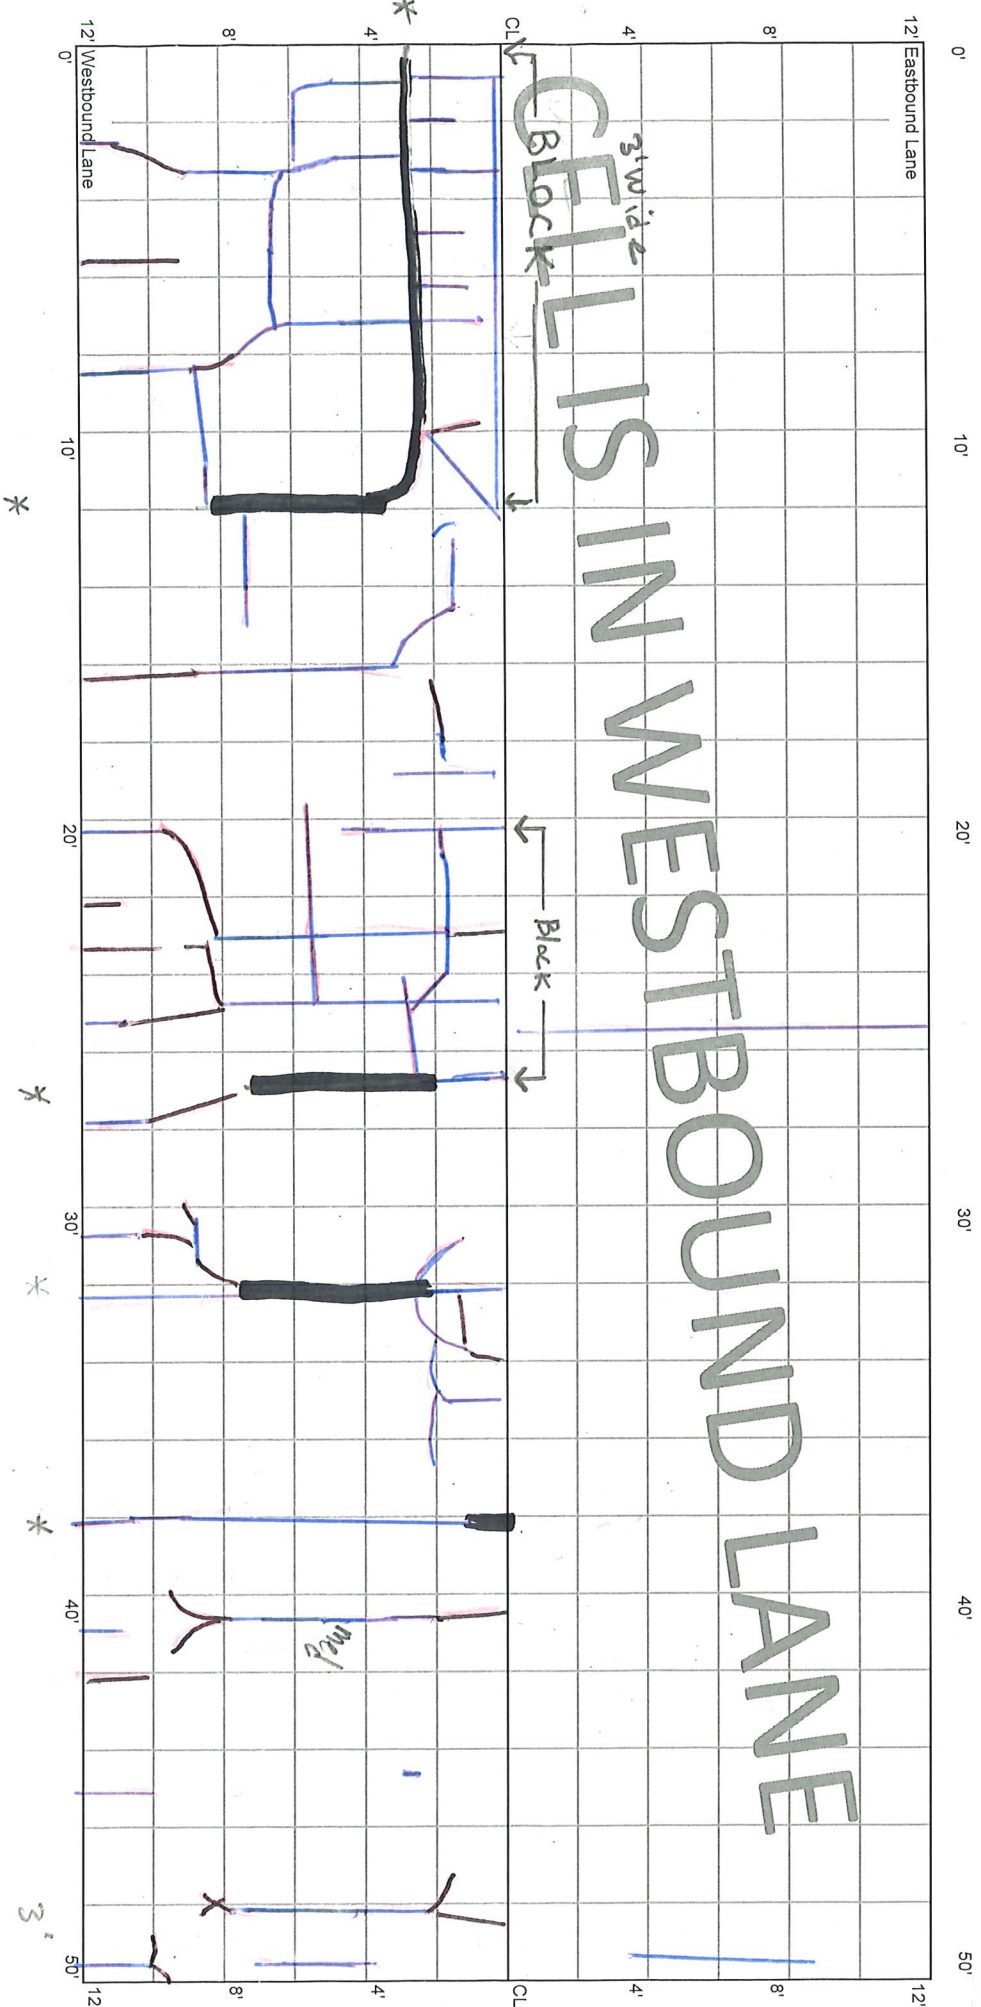


CELLS IN WESTBOUND LANE

3' W.I.D.
Block

Block

P.W.

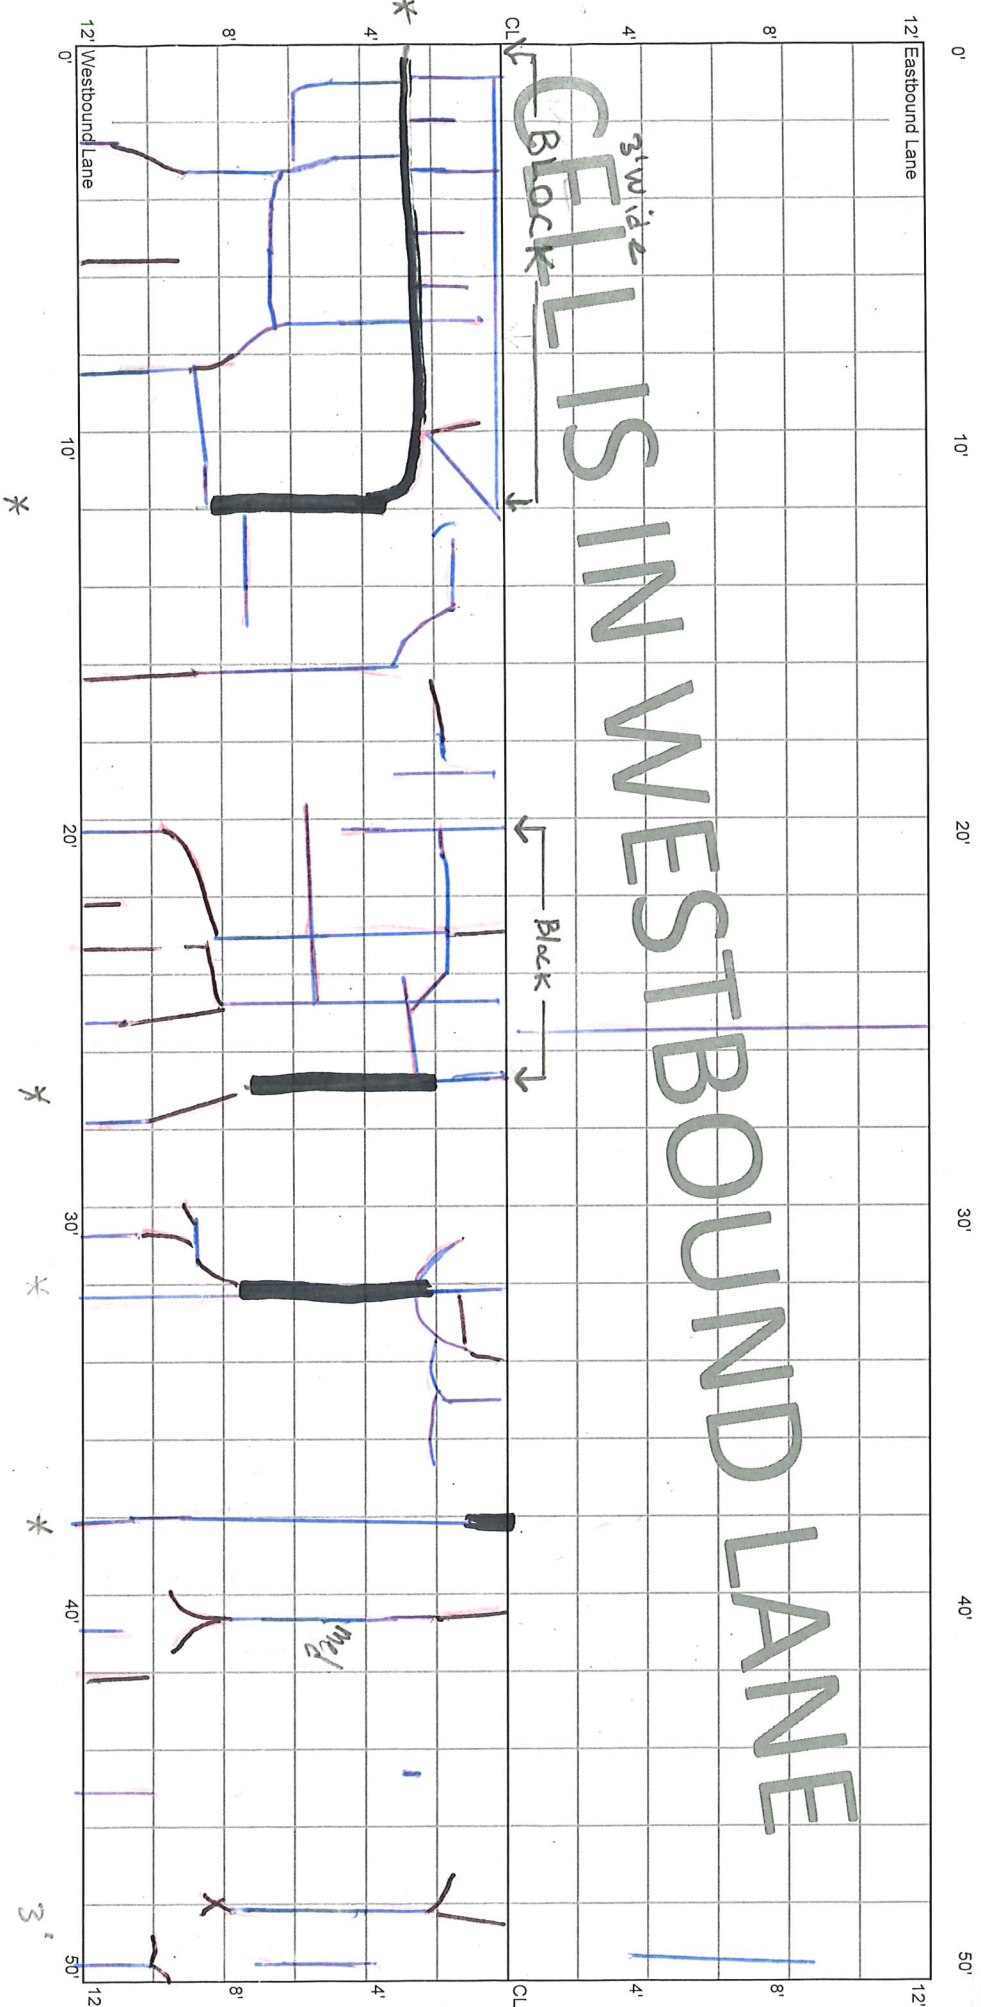


CELL 7001W
150 - 200 ft

3+50


3+00

CELLS IN WESTBOUND LANE

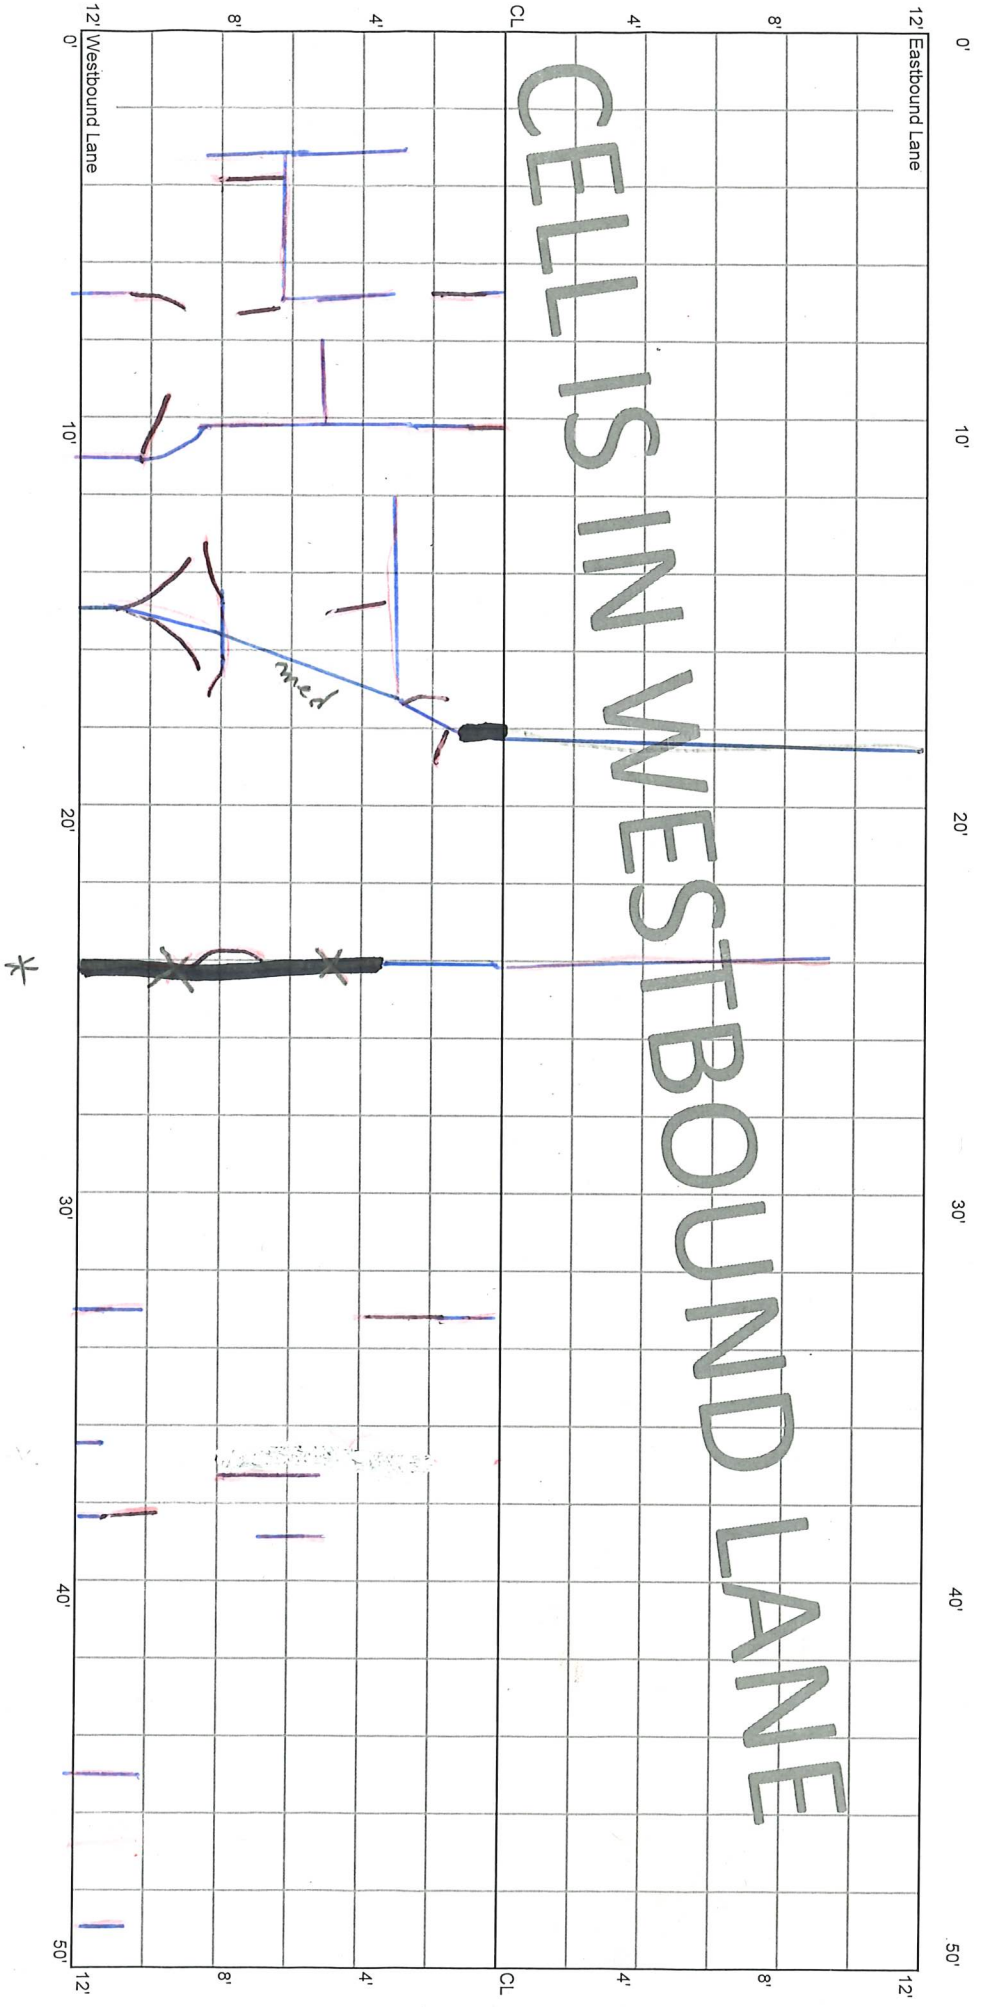

1/2 AF

CELL 700-1W
200 - 250 ft

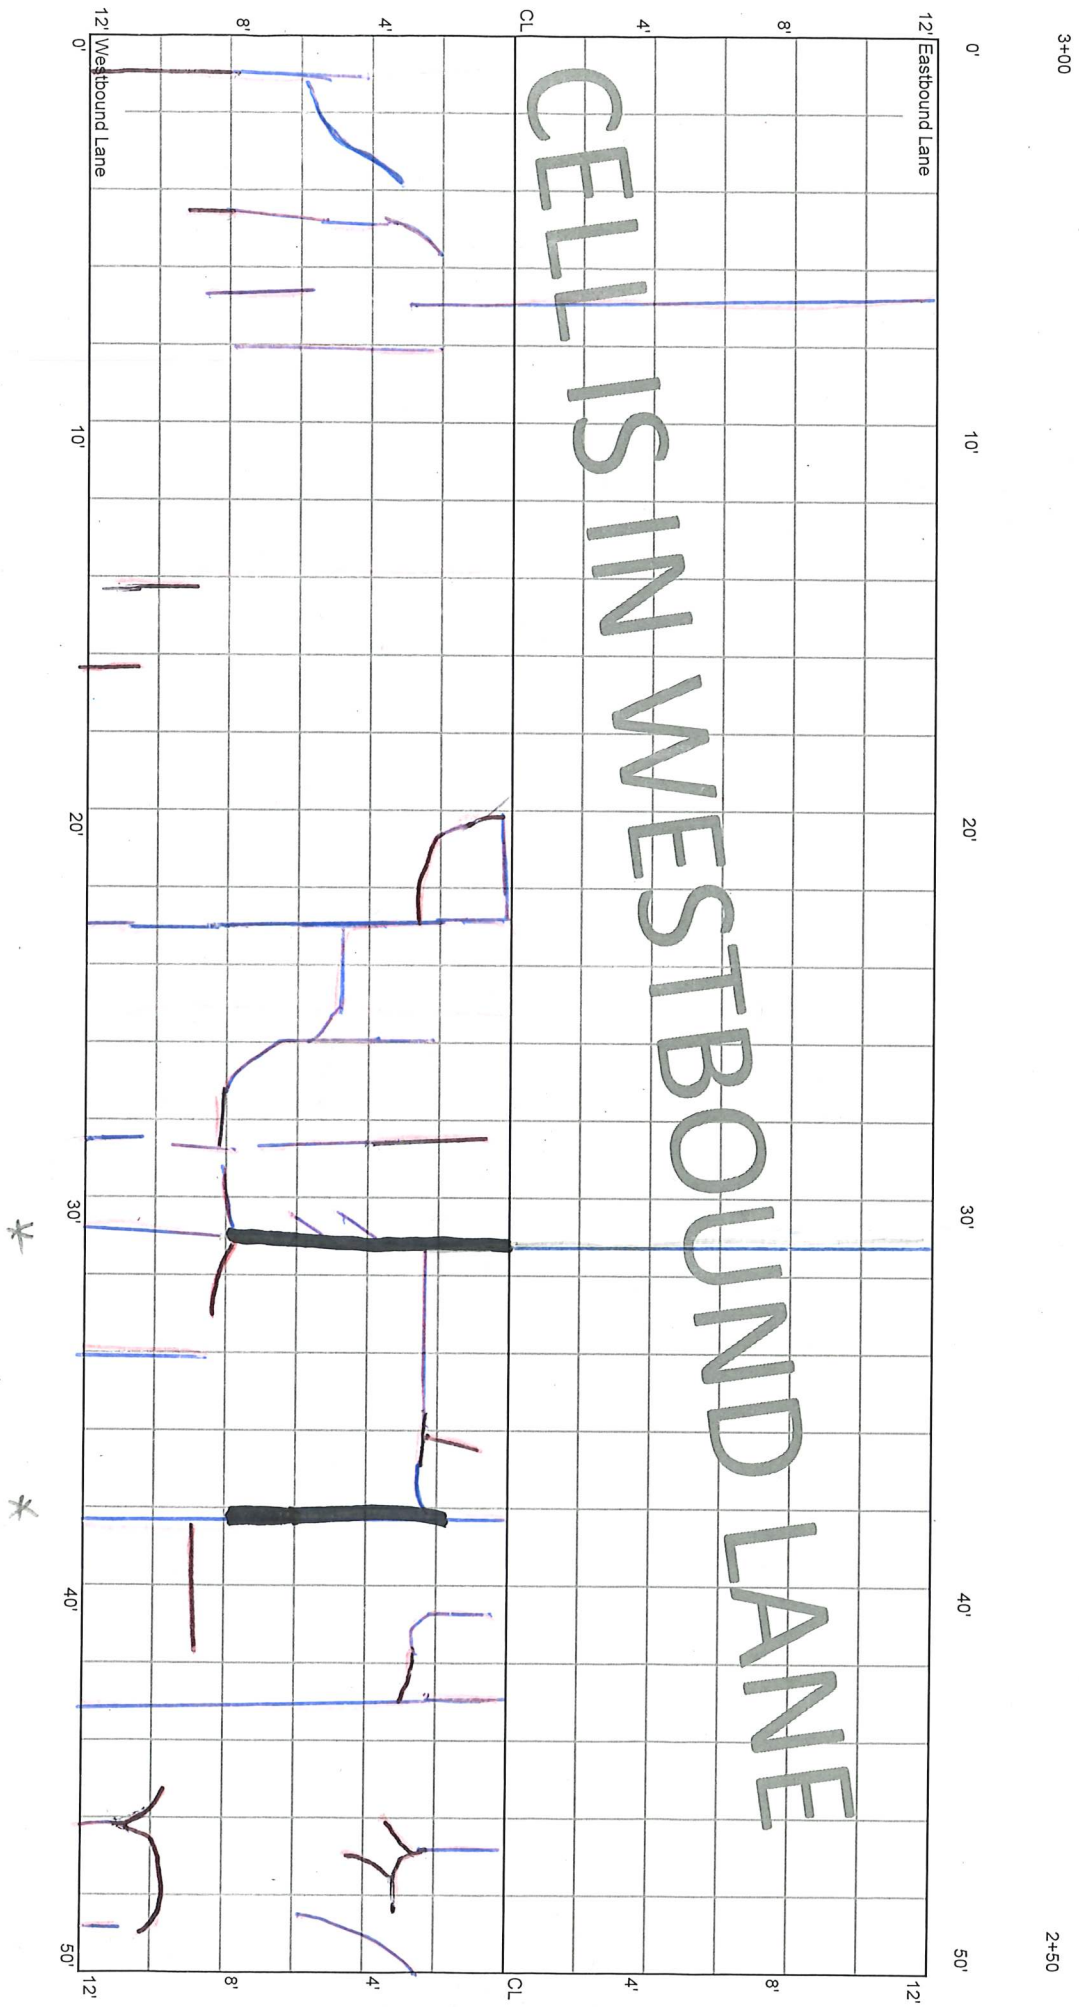


3+00

2+50

CELL 7001W
250 - 300 ft

2+50

2+00

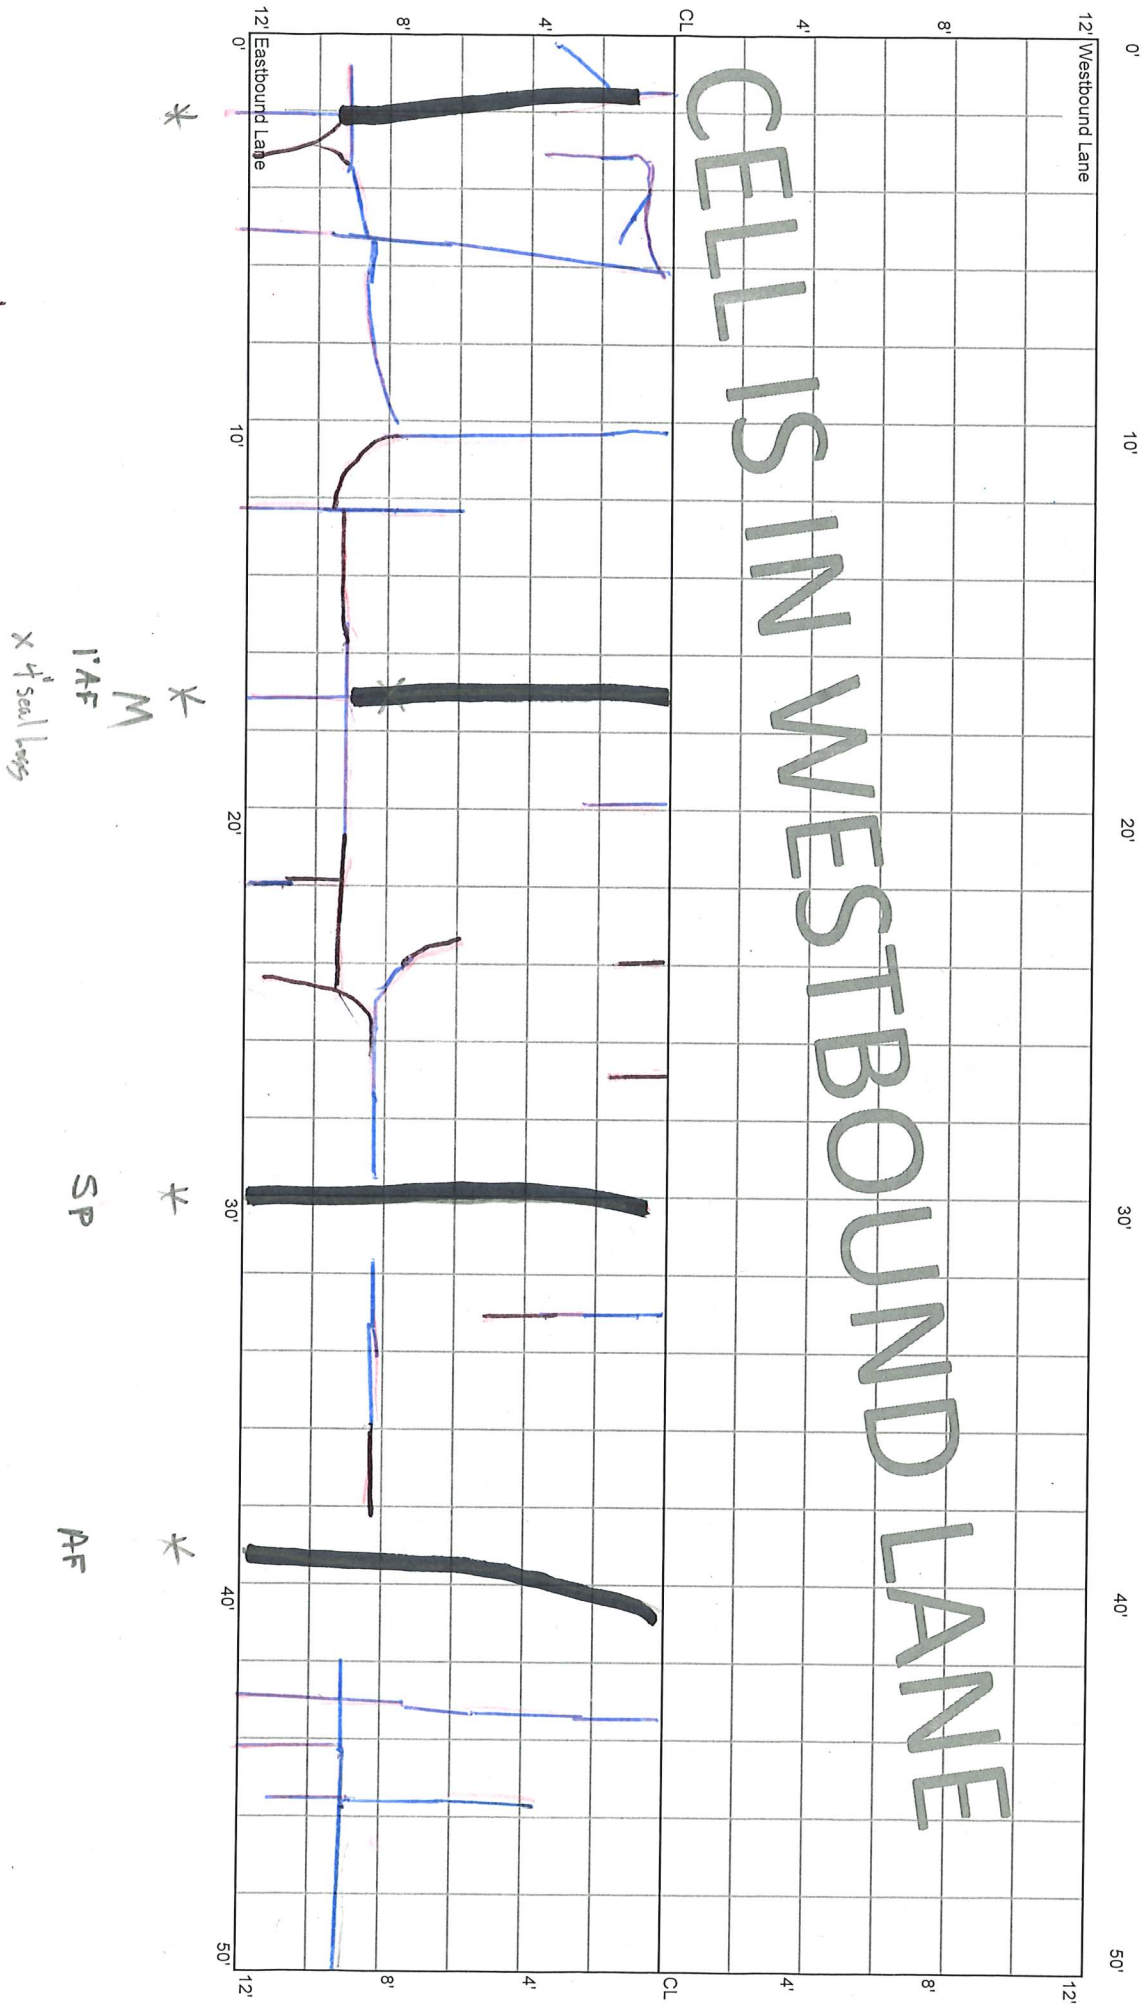


CELL 7001W
300 - 350 ft

2+00

1+50

12' Eastbound Lane 0' 10' 20' 30' 40' 50' 12' Westbound Lane

CELLS IN WESTBOUND LANE

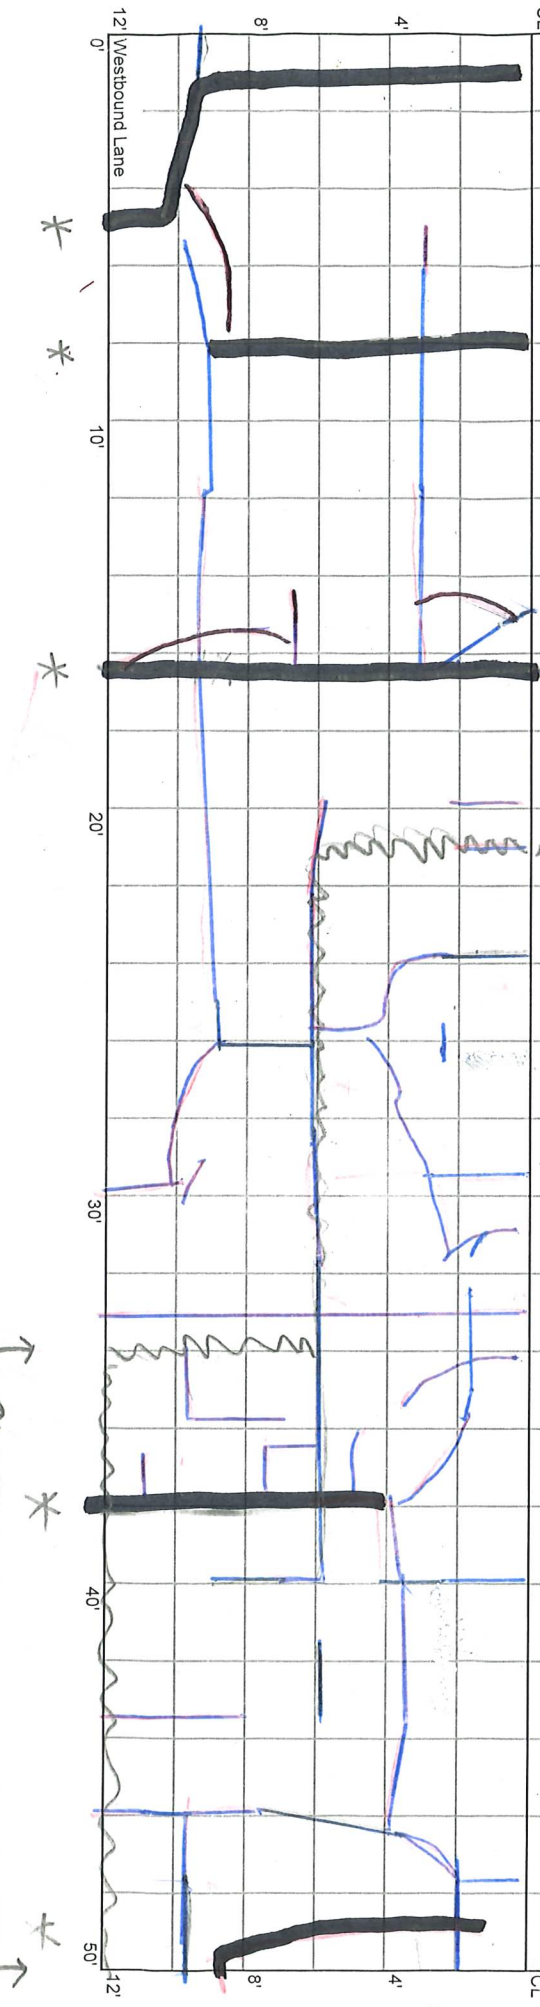

2' AF


X Dobers/stours

Block 6'wide

Block 6'wide

Block 6'wide

CELL 7001W
350 - 400 ft

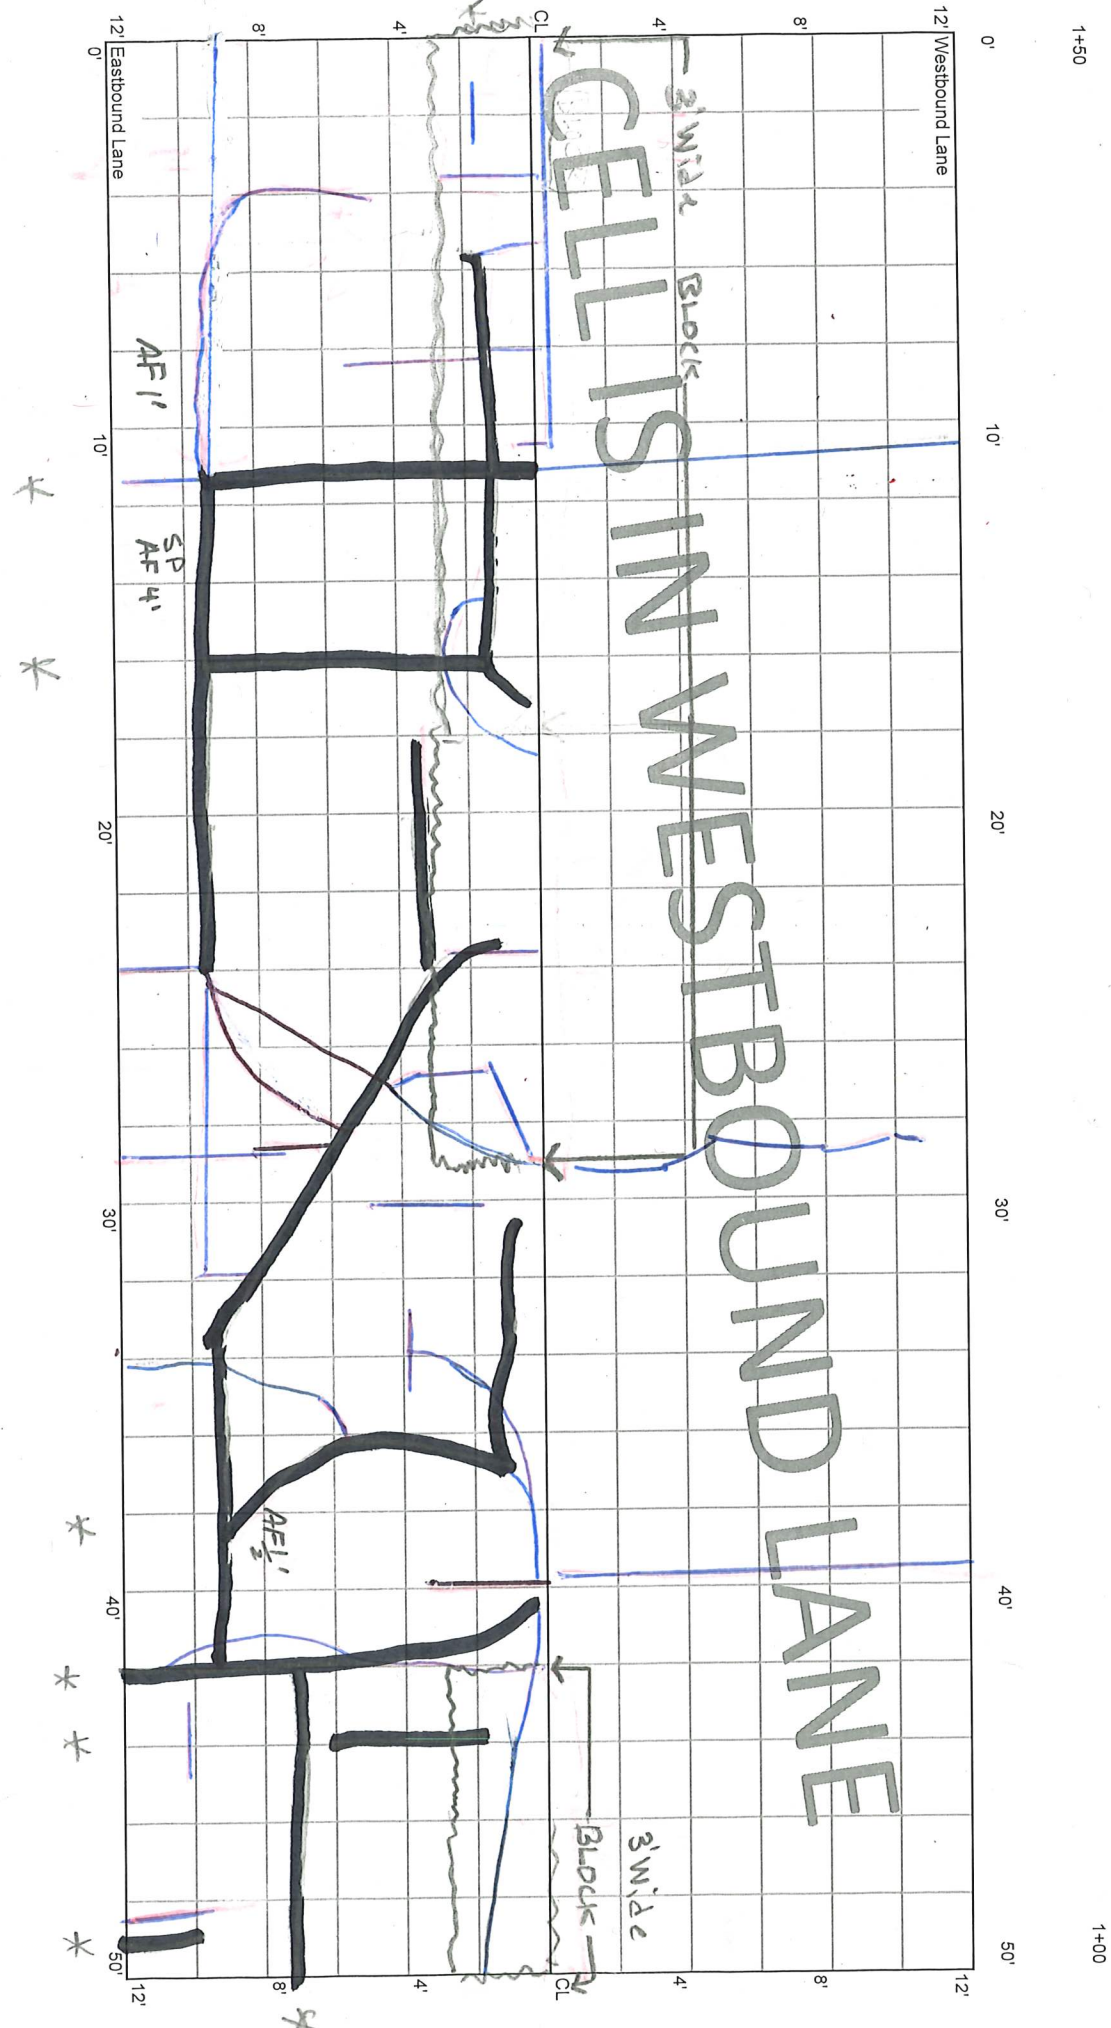

CELL 7001W
400 - 450 ft


1+00

0+50

12' Eastbound Lane


12' Westbound Lane

CELLS IN WESTBOUND LANE

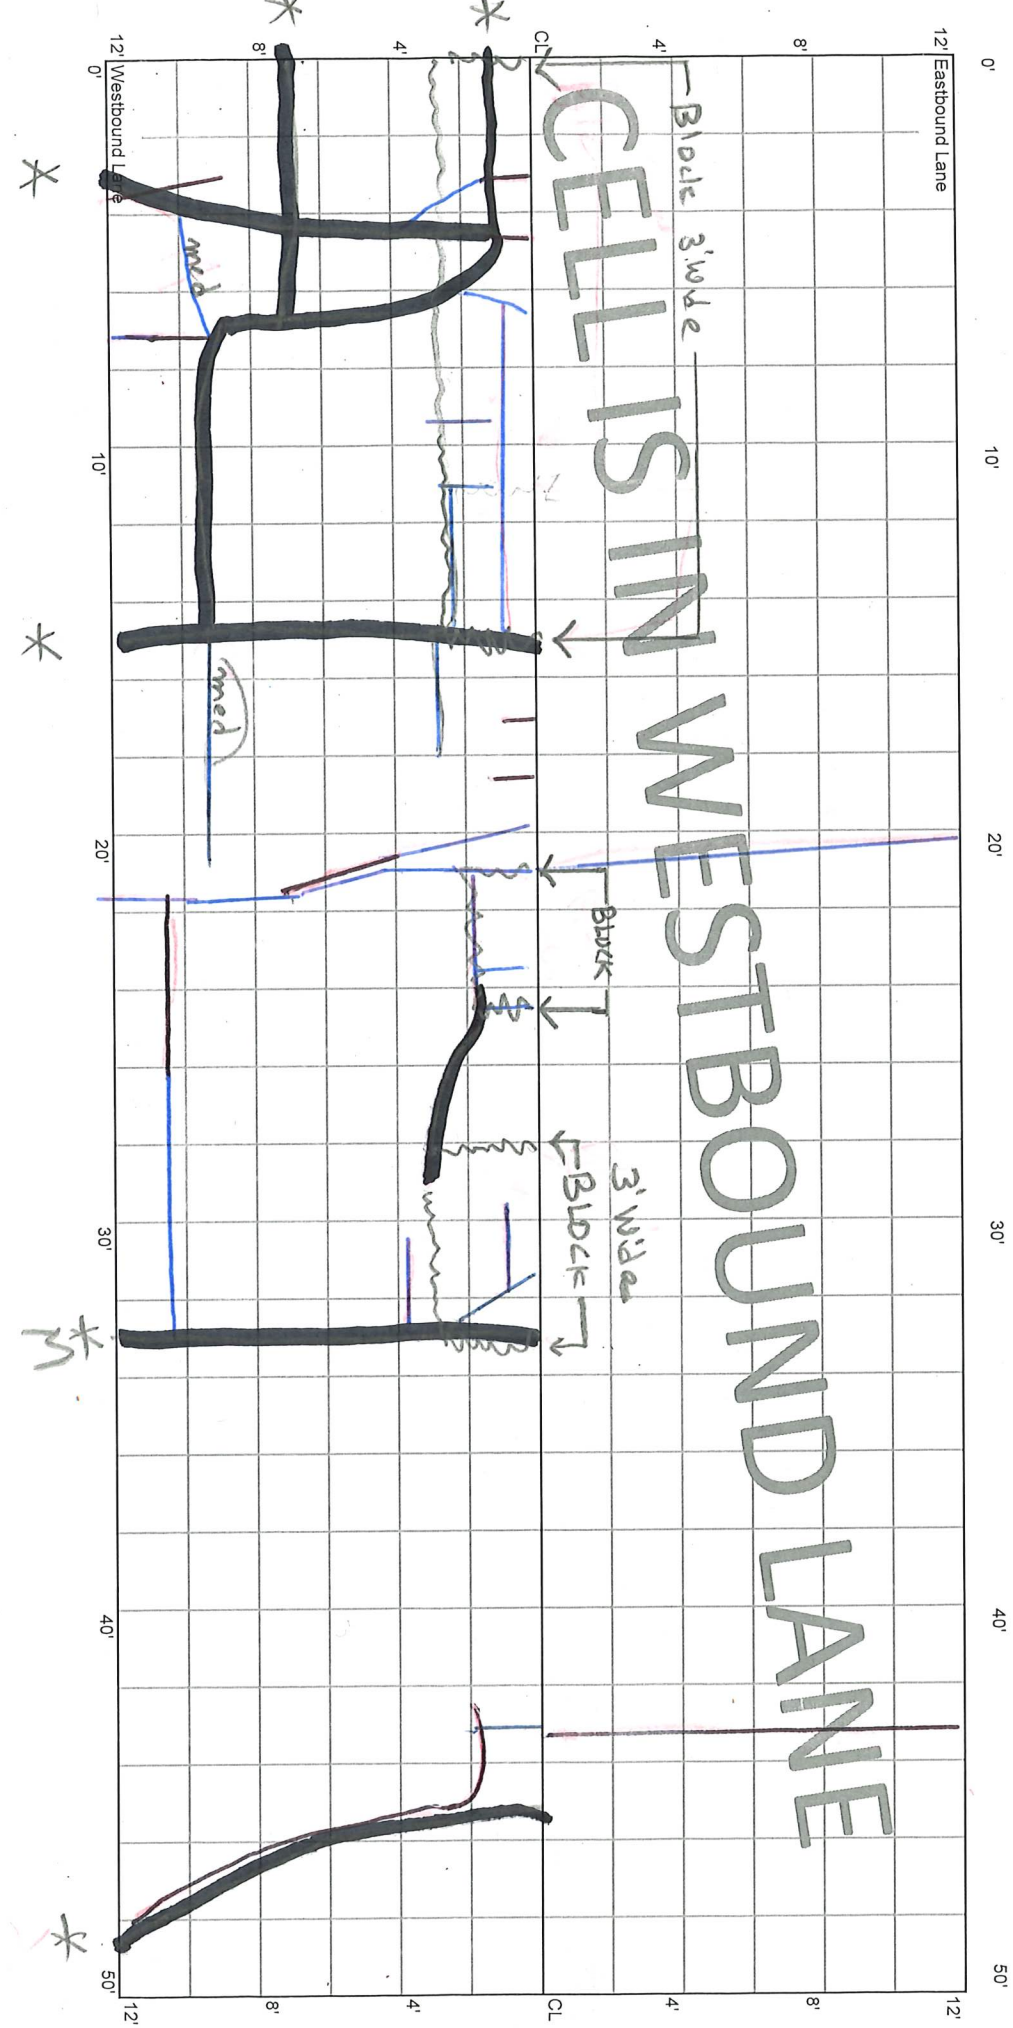

CELL 7001W
450 - 500 ft

End CL Kadler

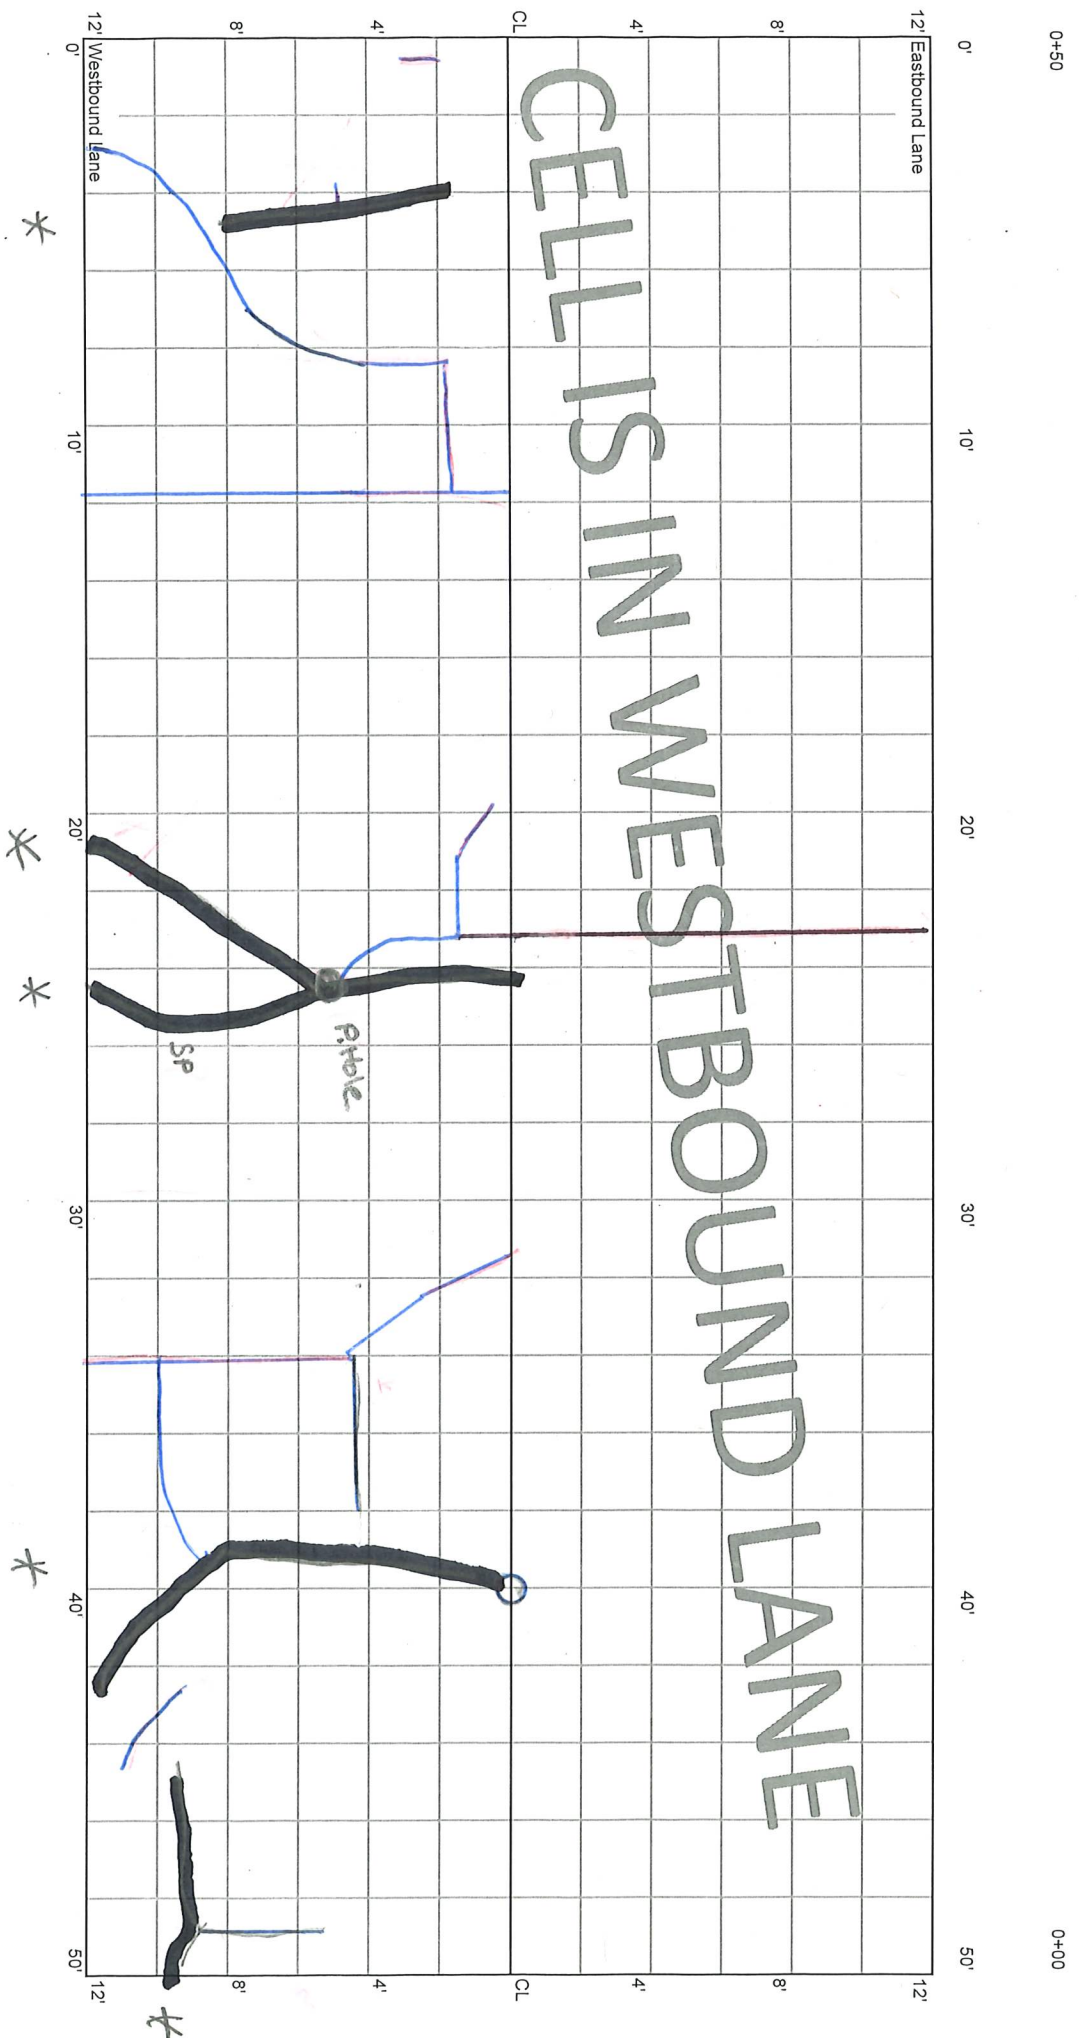

End CL Kadler

CELL 7001W
500 - 550 ft

0+00

-0+23

0'

-10'

-20'

-23'

12' Eastbound Lane

12'

8'

8'

4'

4'

CL

CL

CELLS IN WESTBOUND LANE

4'

4'

8'

8'

END RATING: CL KADLER

12' Westbound Lane

12'

0'

-10'

-20'

-23'