

5:28:20 E.J.

10.14.20 13:22

1.4.21 8:30.22


9.16.21

Cell 7012W
CELL 7002W
0 - 50 ft

10+50

10+00

0' 10' 20' 30' 40' 50'

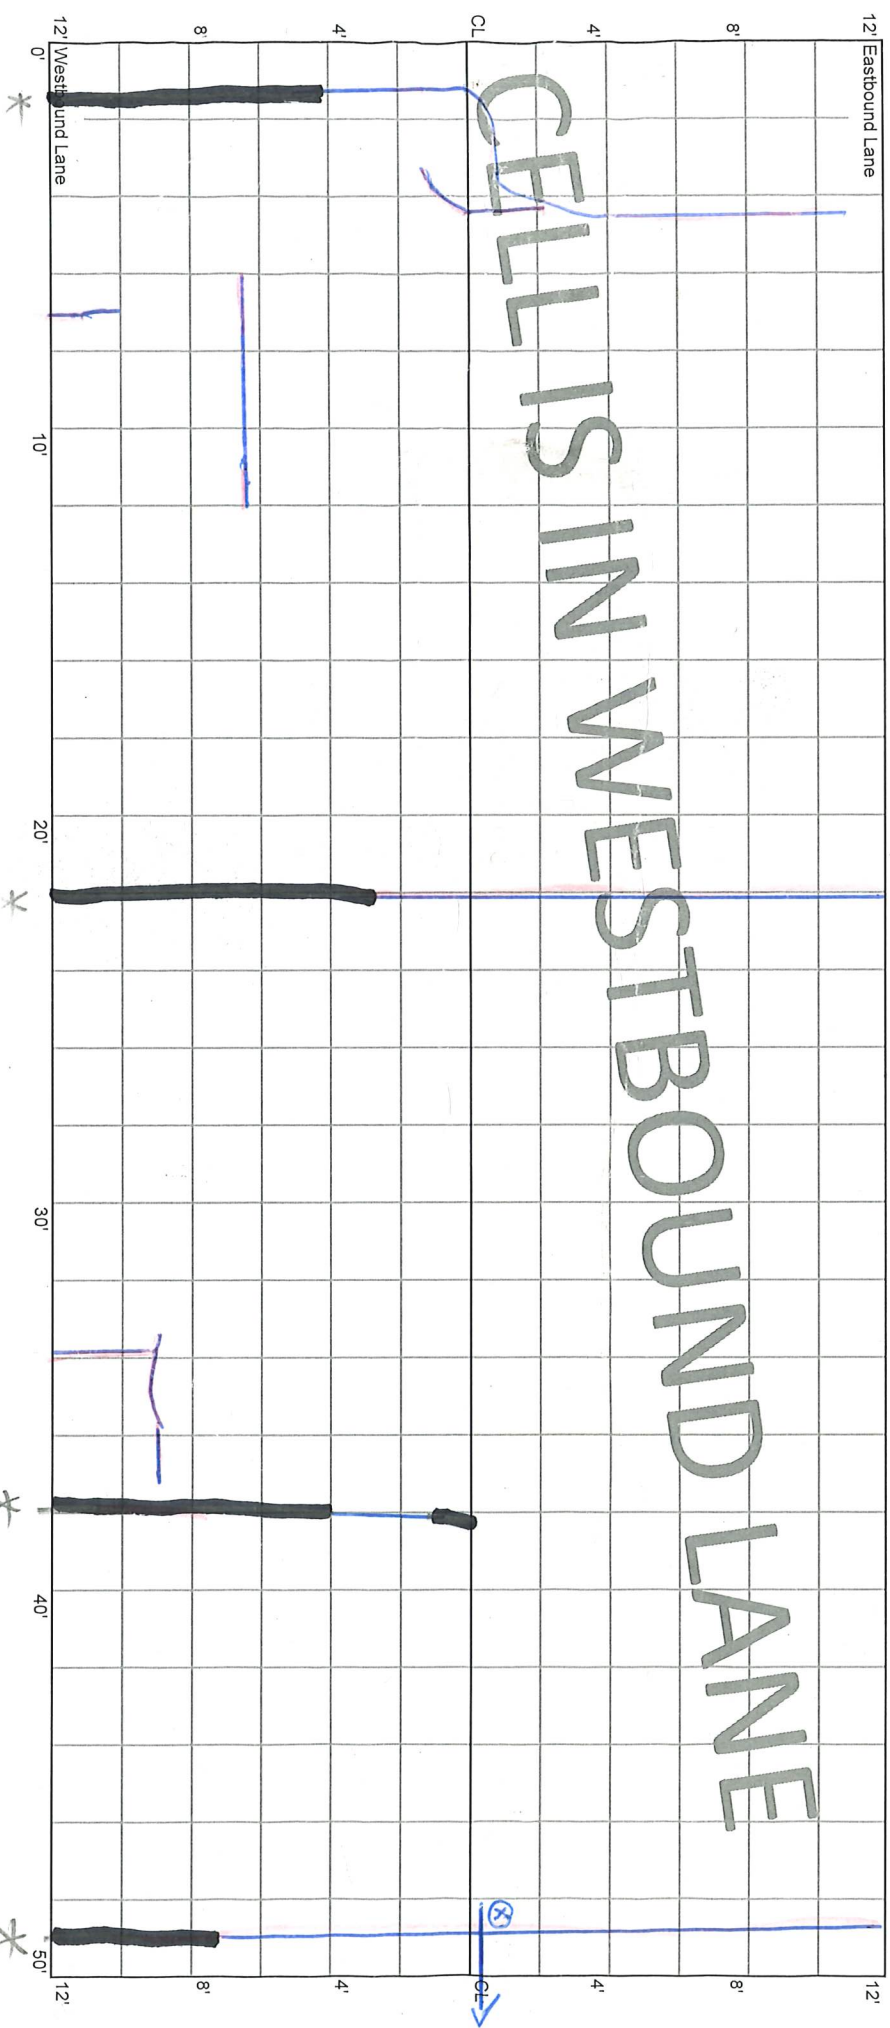

⊗ → CL ST RS

⊗ → CL →

* Route Seal

AF, SP 1.5'

CELL 7002W
50 - 100 ft


10+00

9+50

12' Eastbound Lane

12'

CELLS IN WESTBOUND LANE

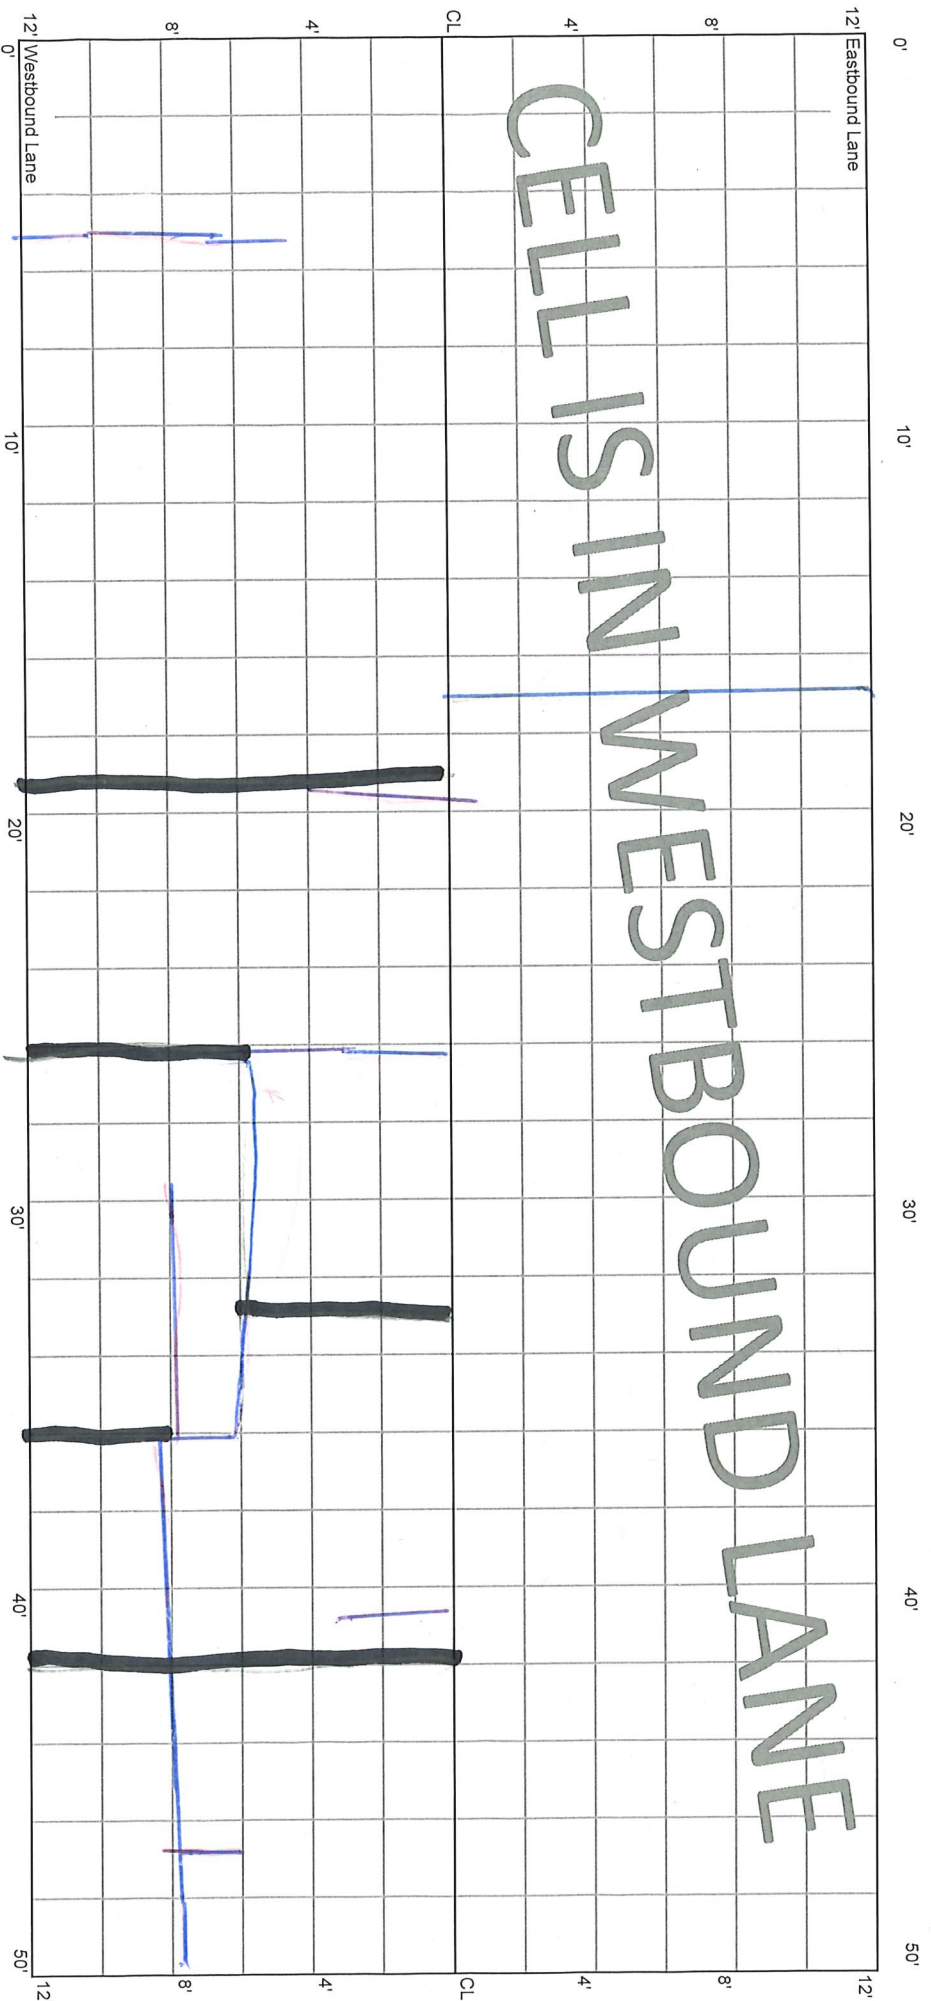

S.P.1


A.F.

CELL 7002W
100 - 150 ft

9+50

9+00

CELLS IN WESTBOUND LANE

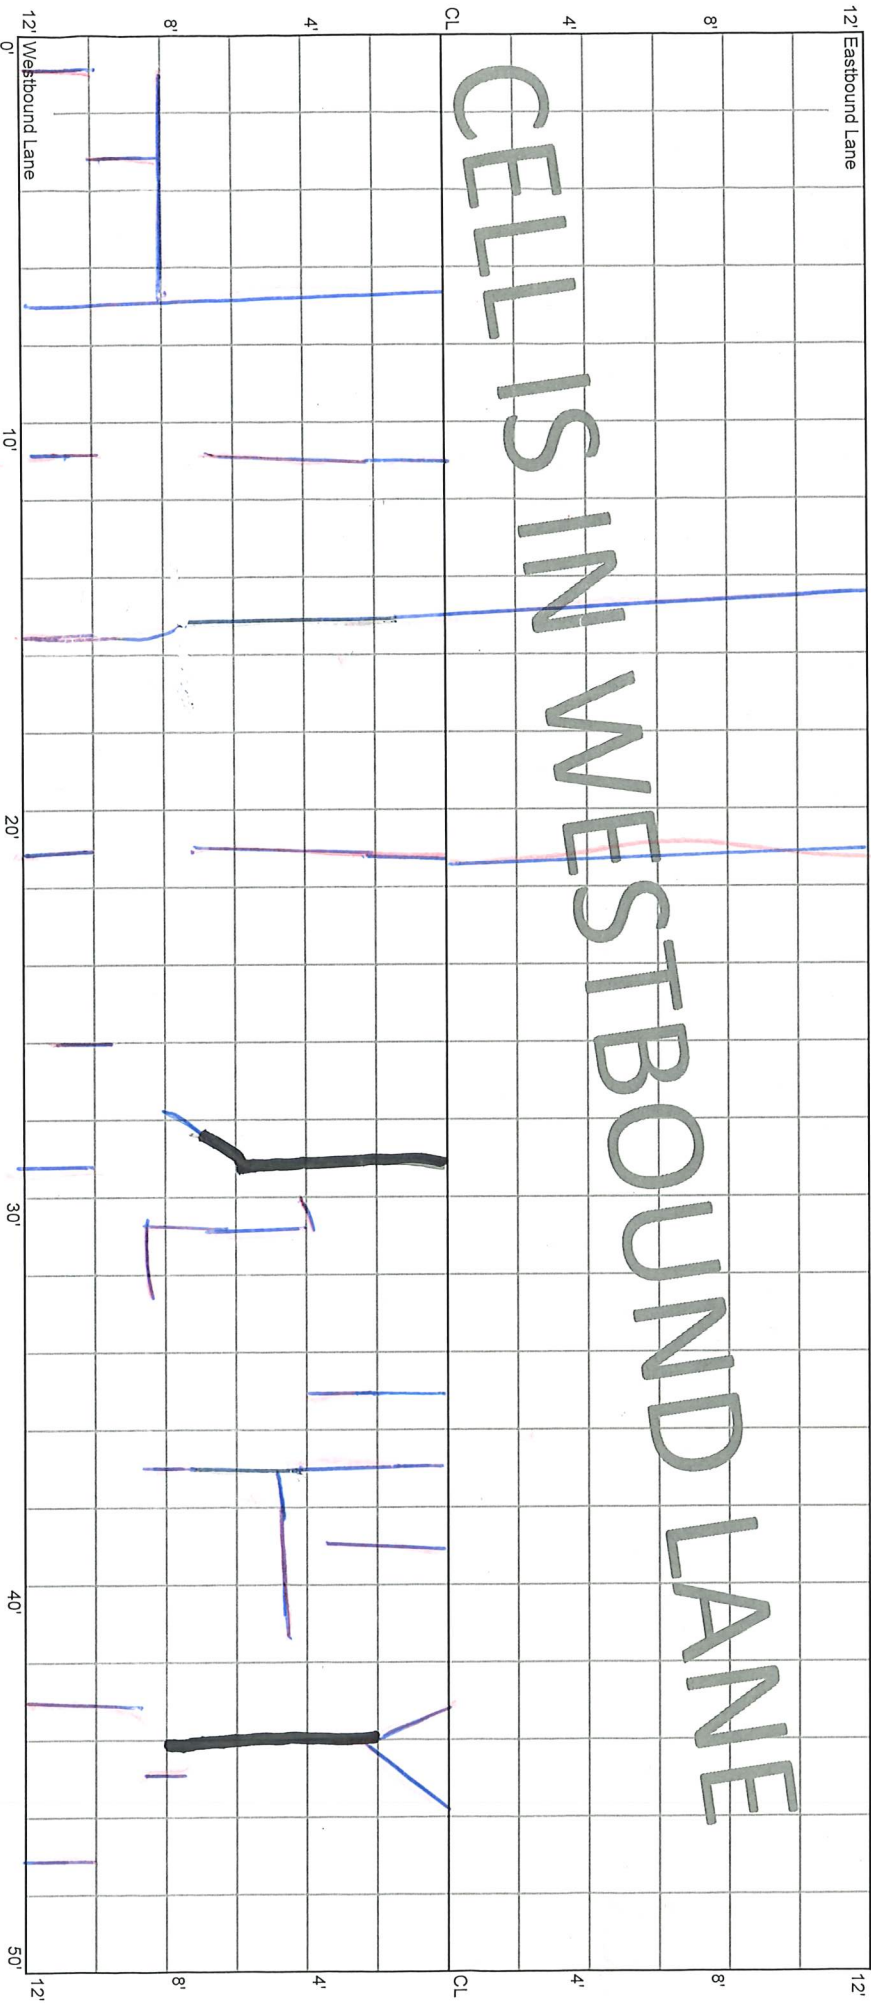


APF

CELL 7002W
150 - 200 ft

9+00

8+50

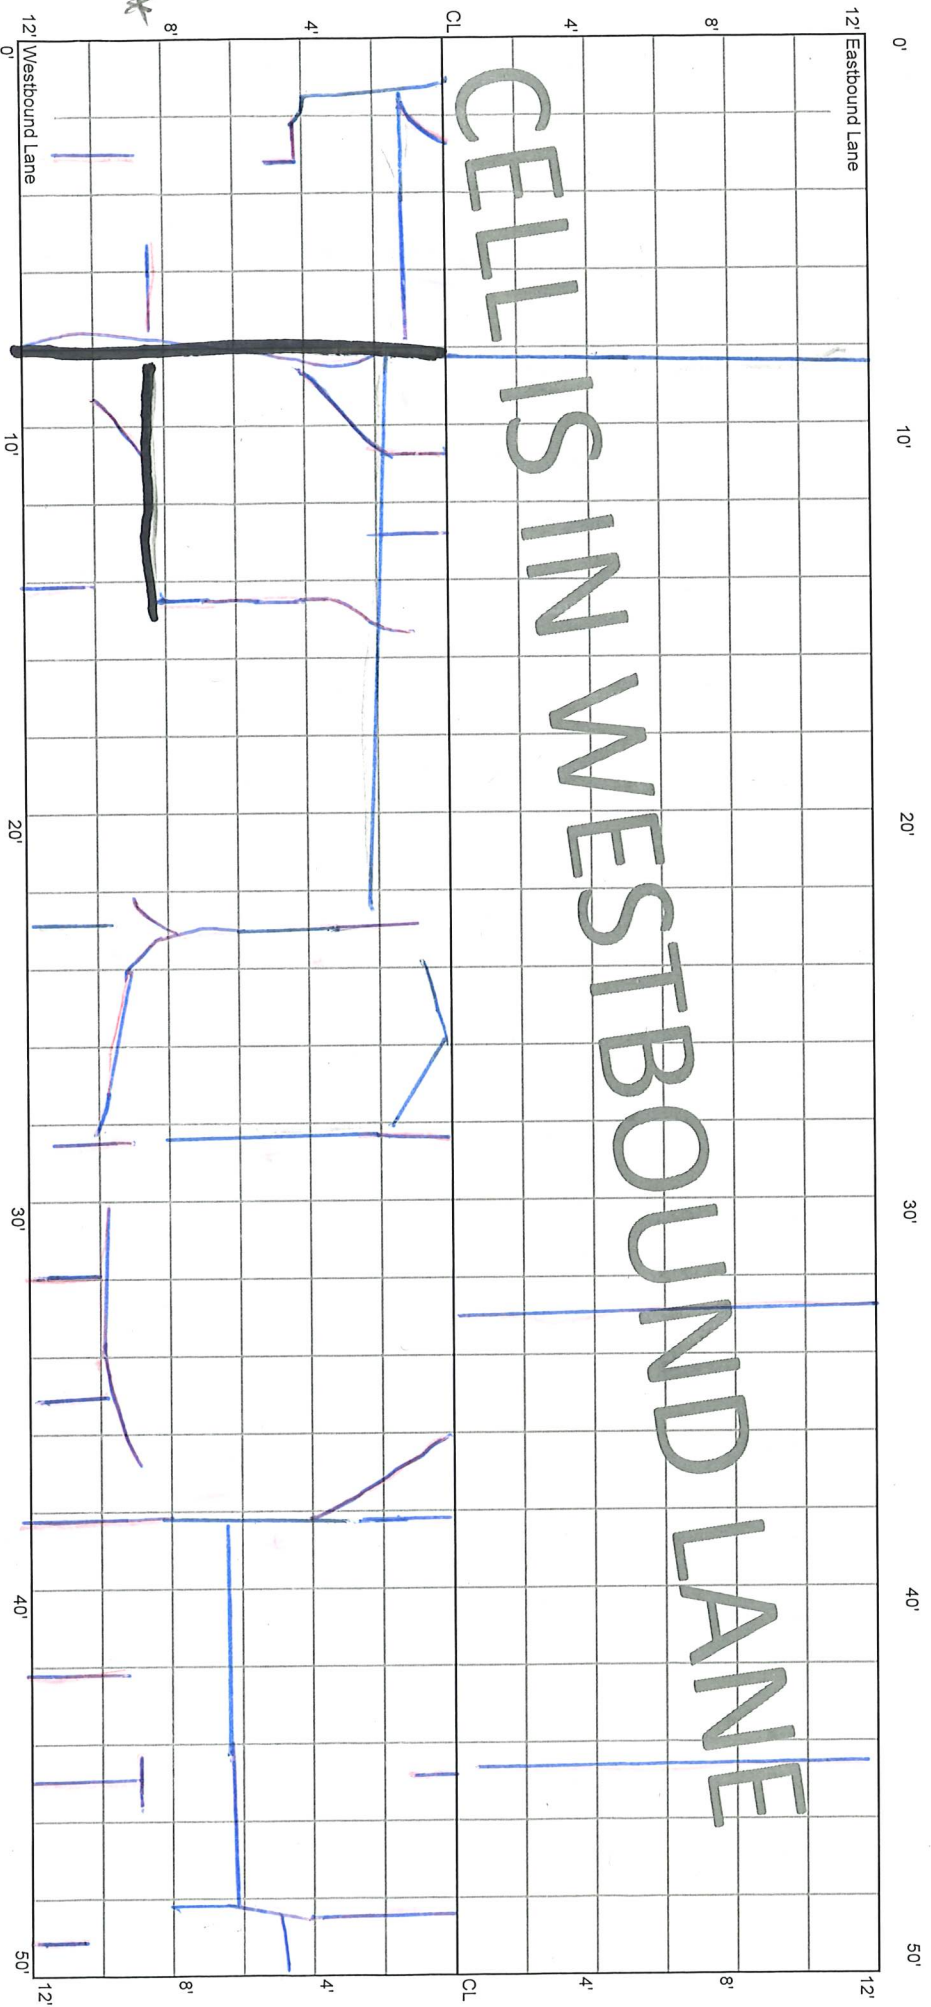

CELL IS IN WESTBOUND LANE

12' Eastbound Lane

12' Westbound Lane

0' 10' 20' 30' 40' 50'

CL CL

0' 10' 20' 30' 40' 50'


*

*

CELL 7002W
200 - 250 ft

8+50

8+00

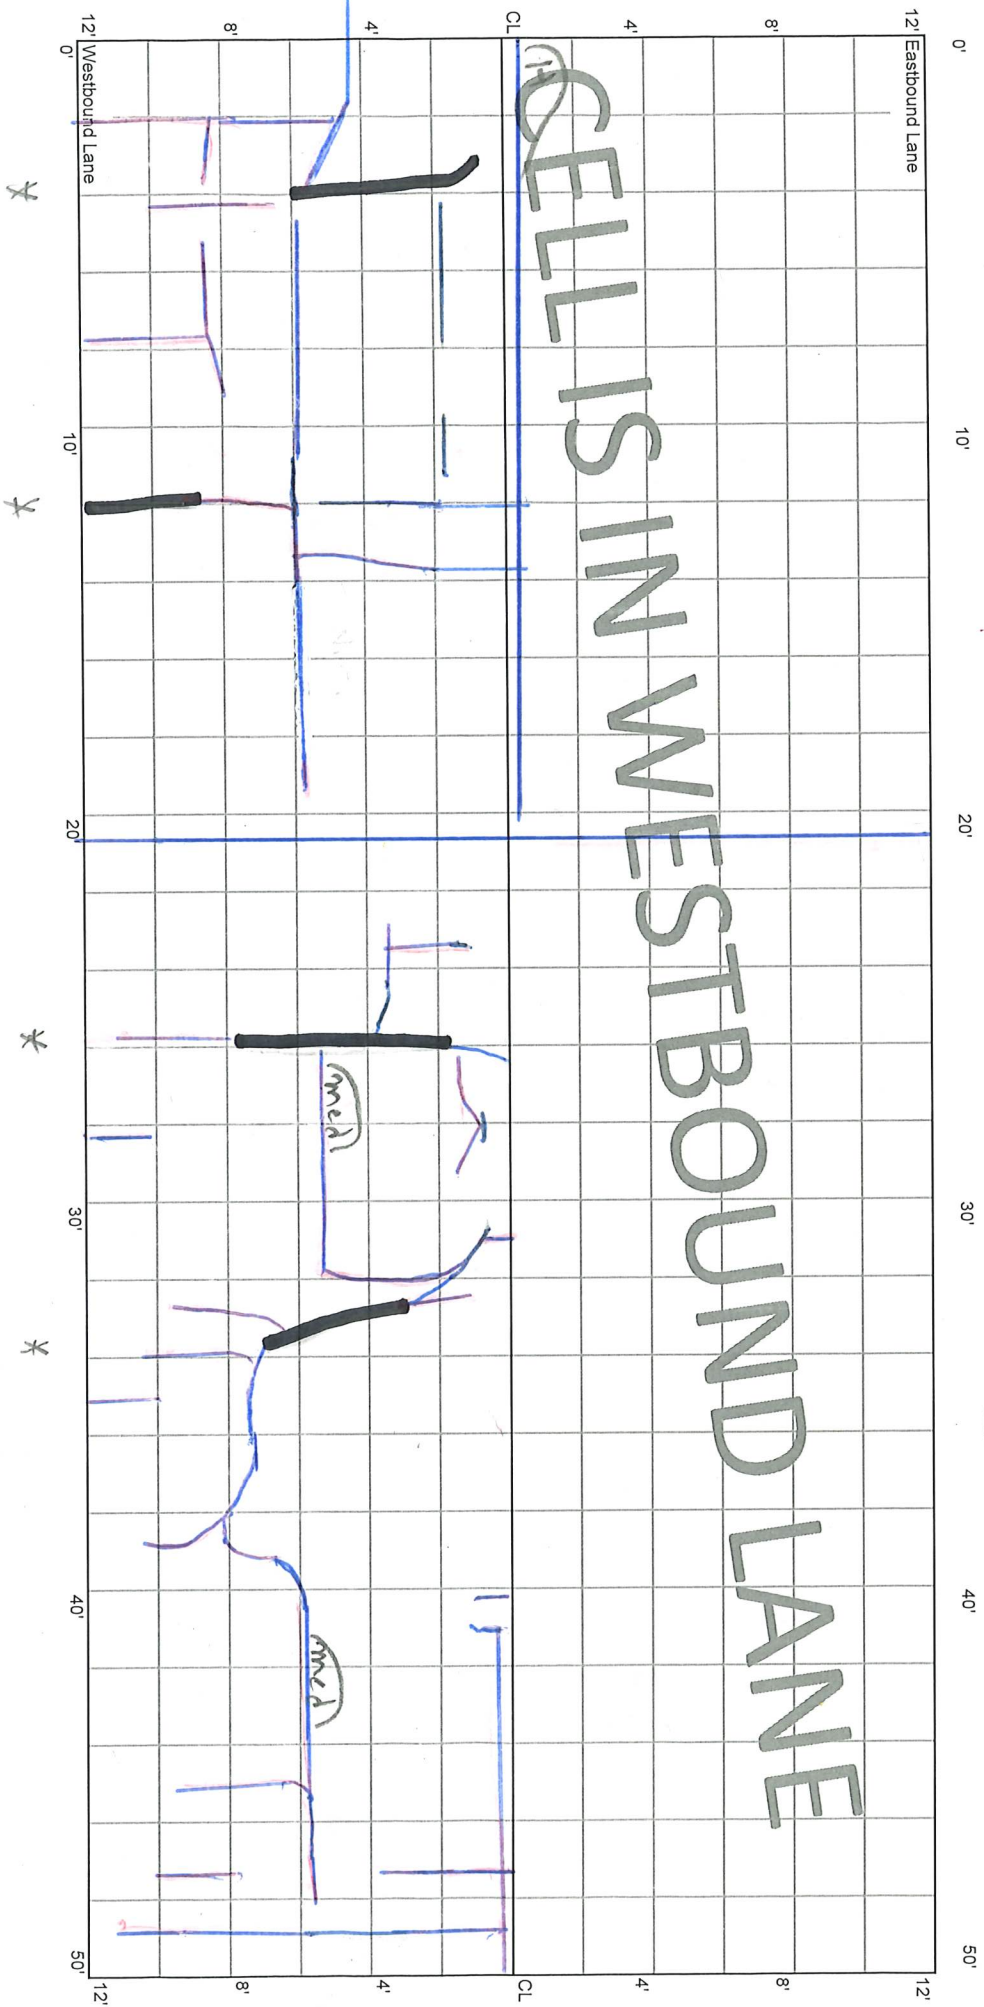


SP 1/2

CELL 7002W
250 - 300 ft

8+00

7+50


CELLS IN WESTBOUND LANE

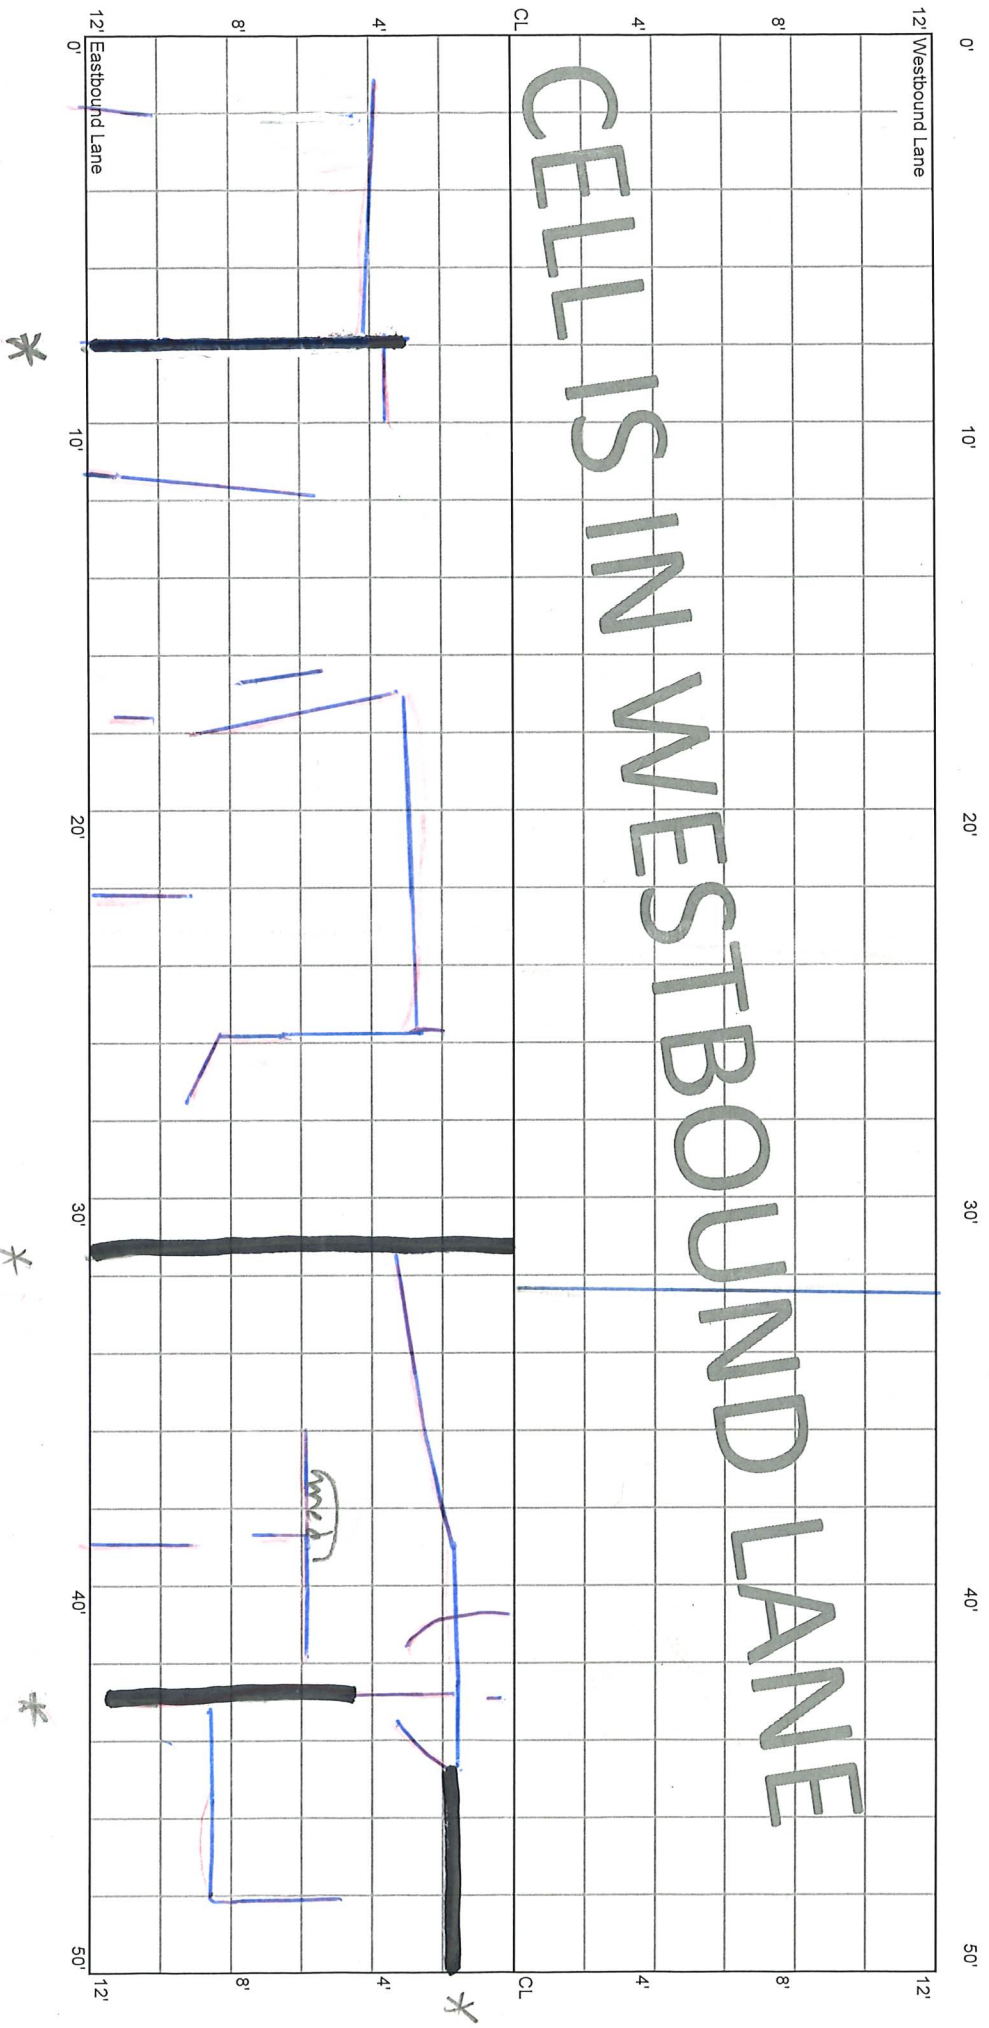

CELL 7002W
300 - 350 ft

7+50


7+00

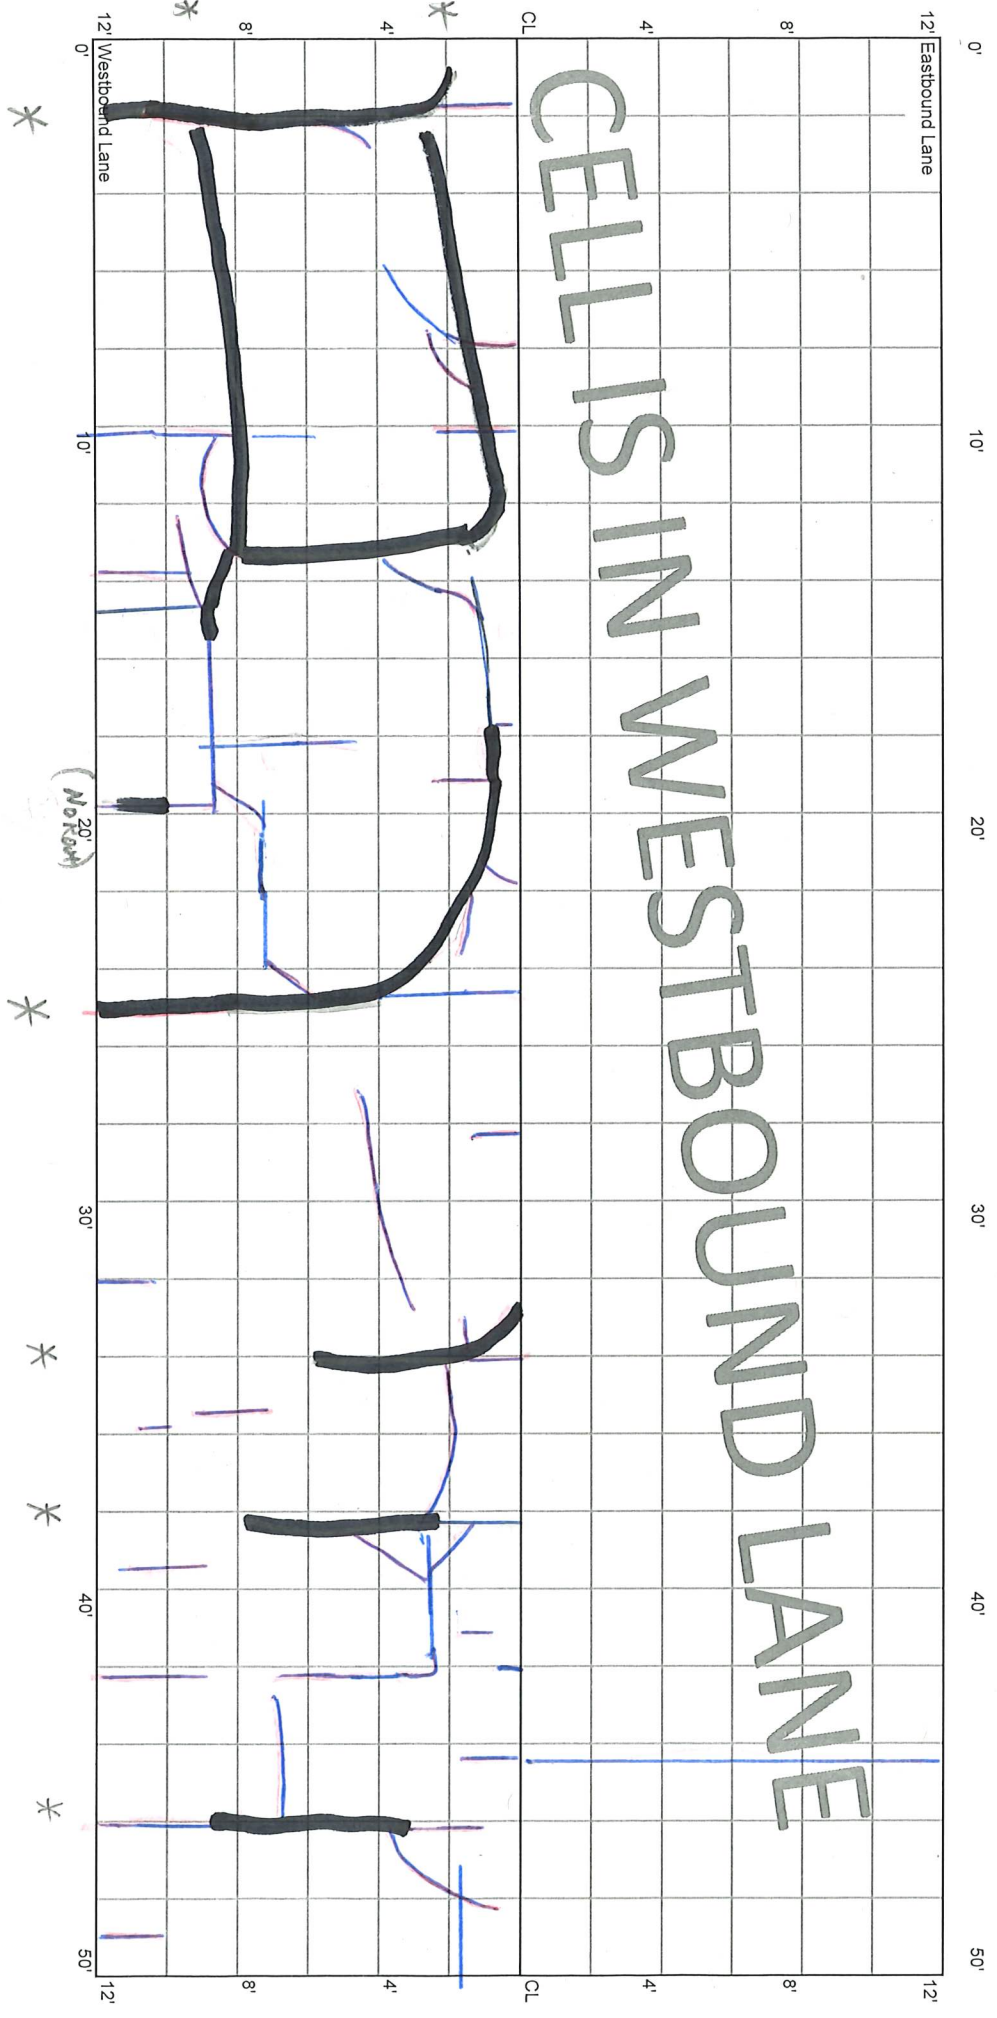

CELL 7002W
350 - 400 ft

7+00

6+50

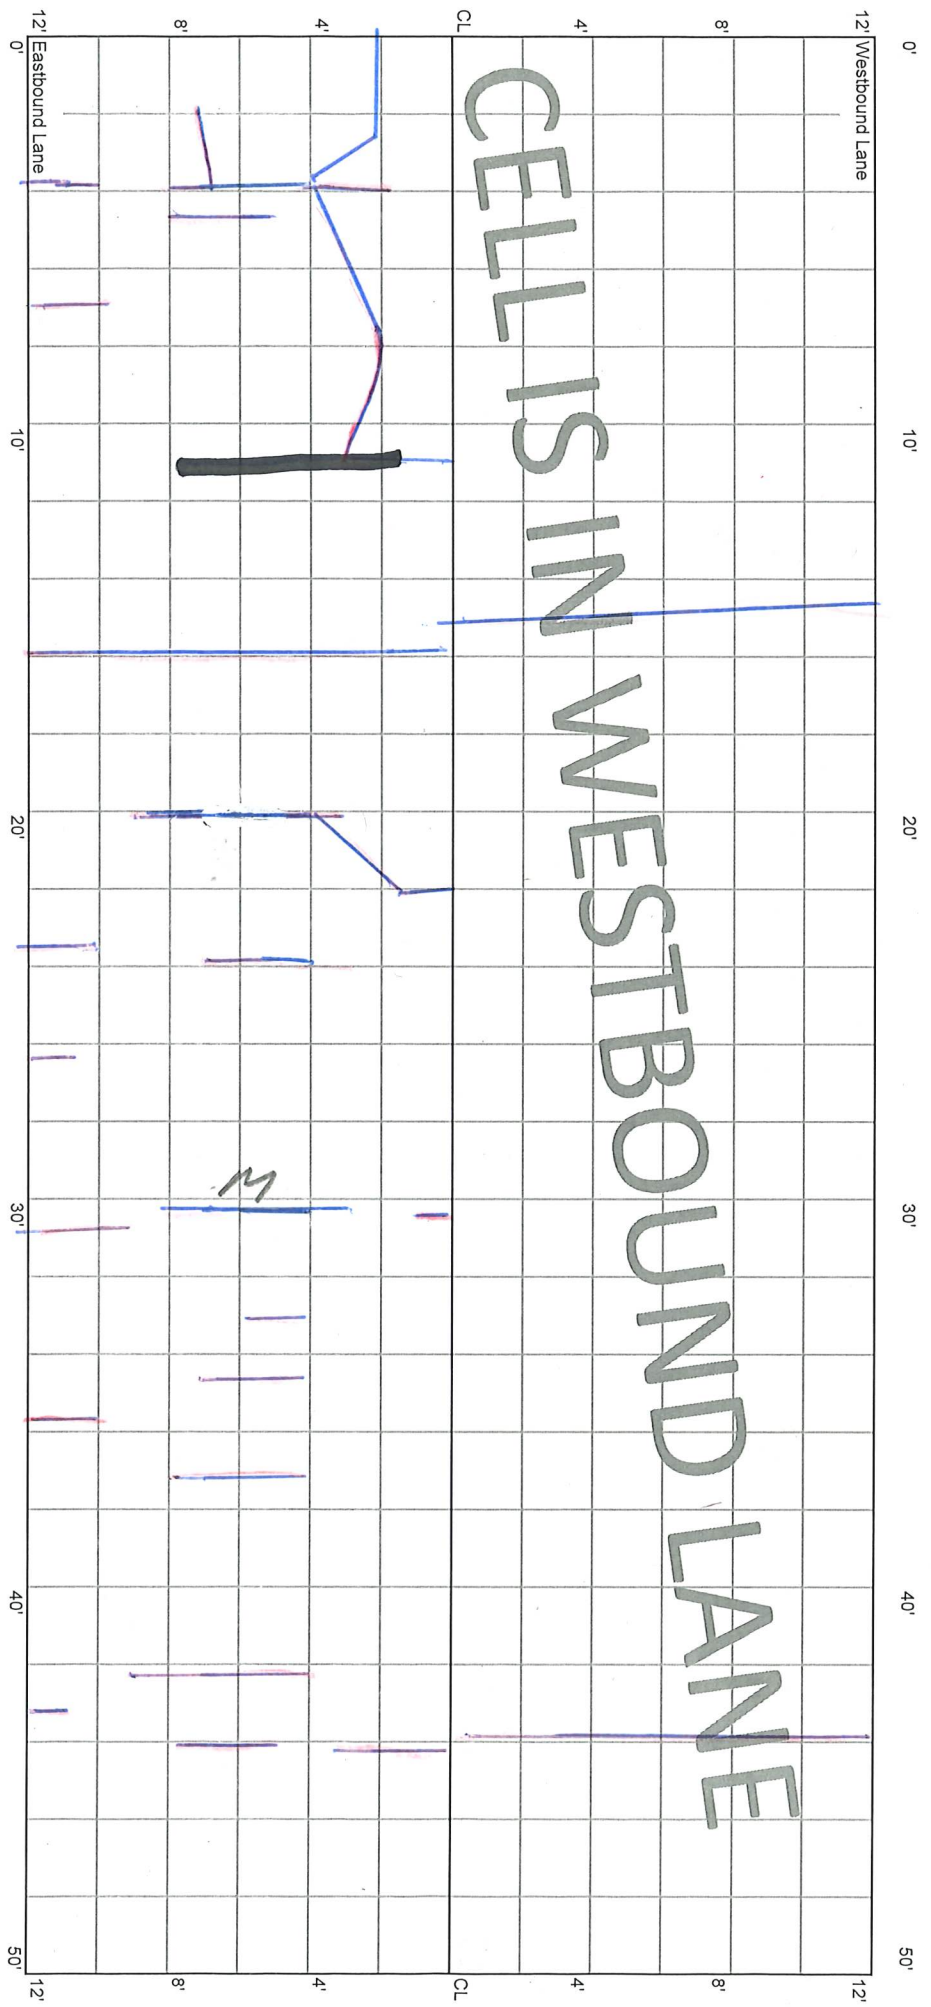

6'

*

M

CELLS IN WESTBOUND LANE

12' Eastbound Lane

12' Westbound Lane

0' 10' 20' 30' 40' 50'

0' 10' 20' 30' 40' 50'

CL

4'


8'

12'

CELL 7002W
400 - 450 ft

6+50

6+00

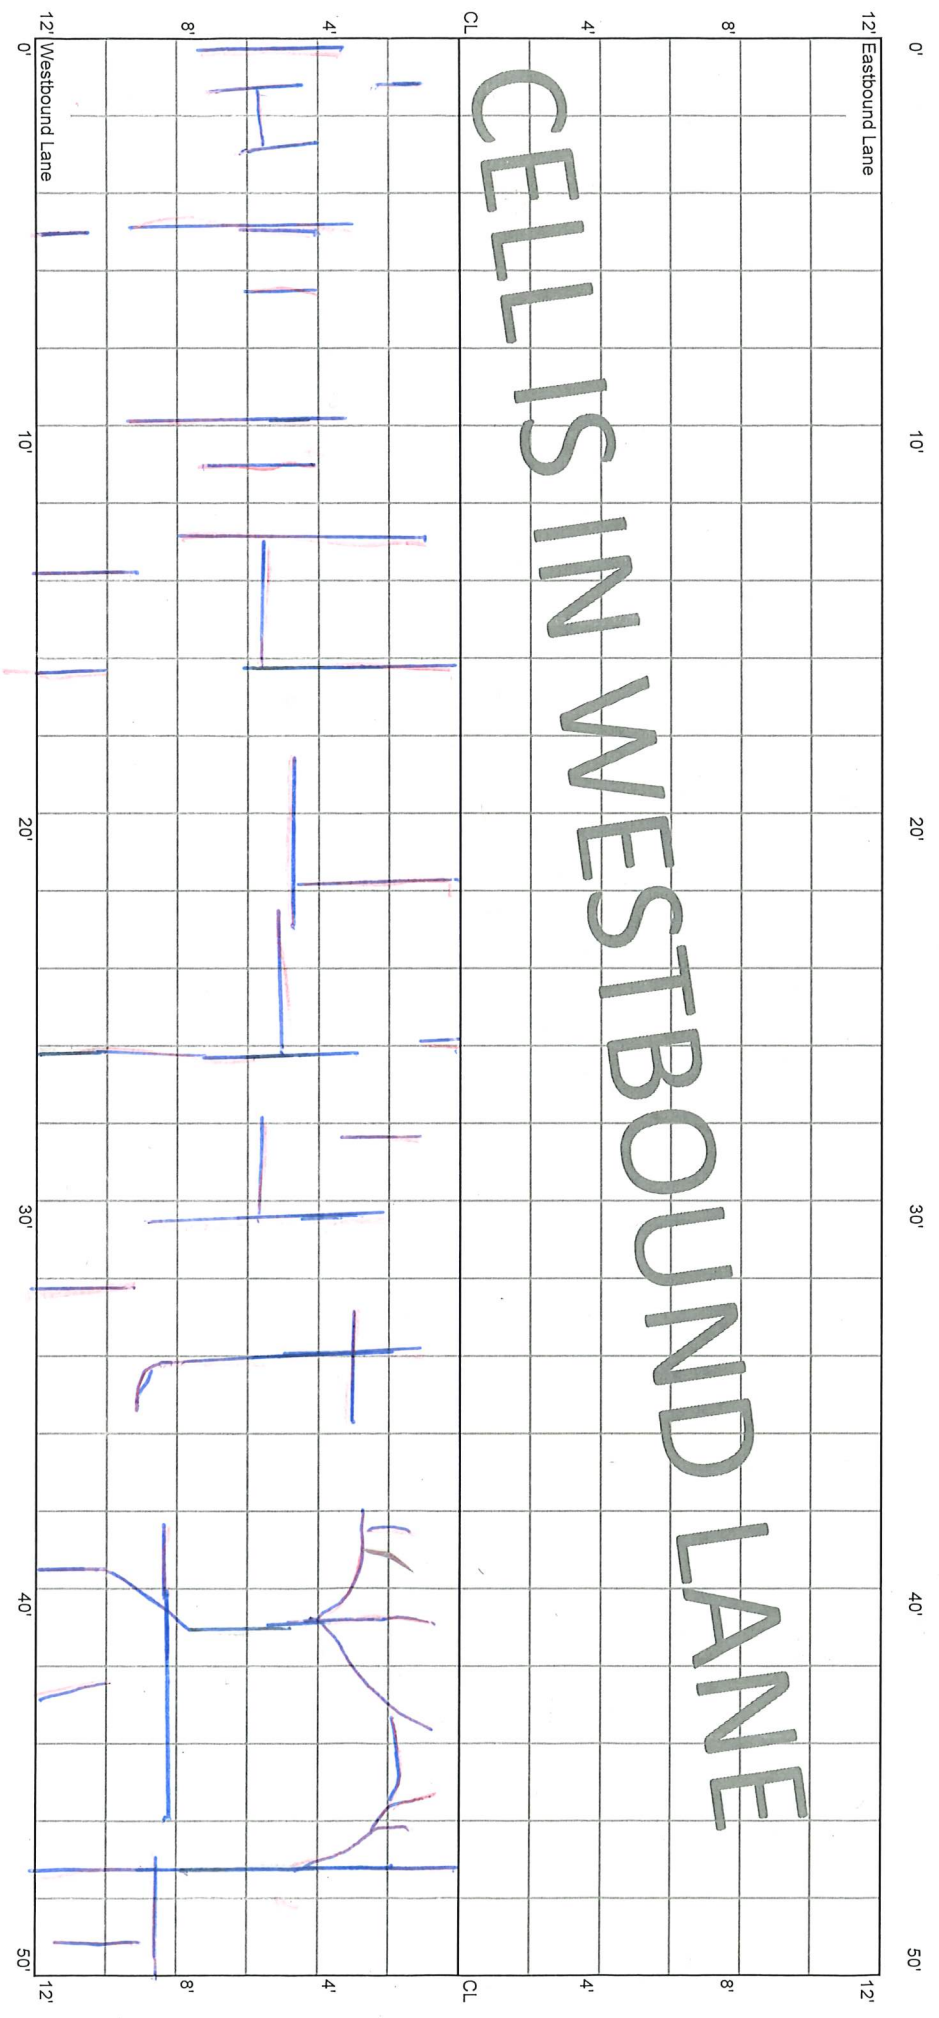


6'

CELL 7002W
450 - 500 ft

6+00

5+50

CELLS IN WESTBOUND LANE

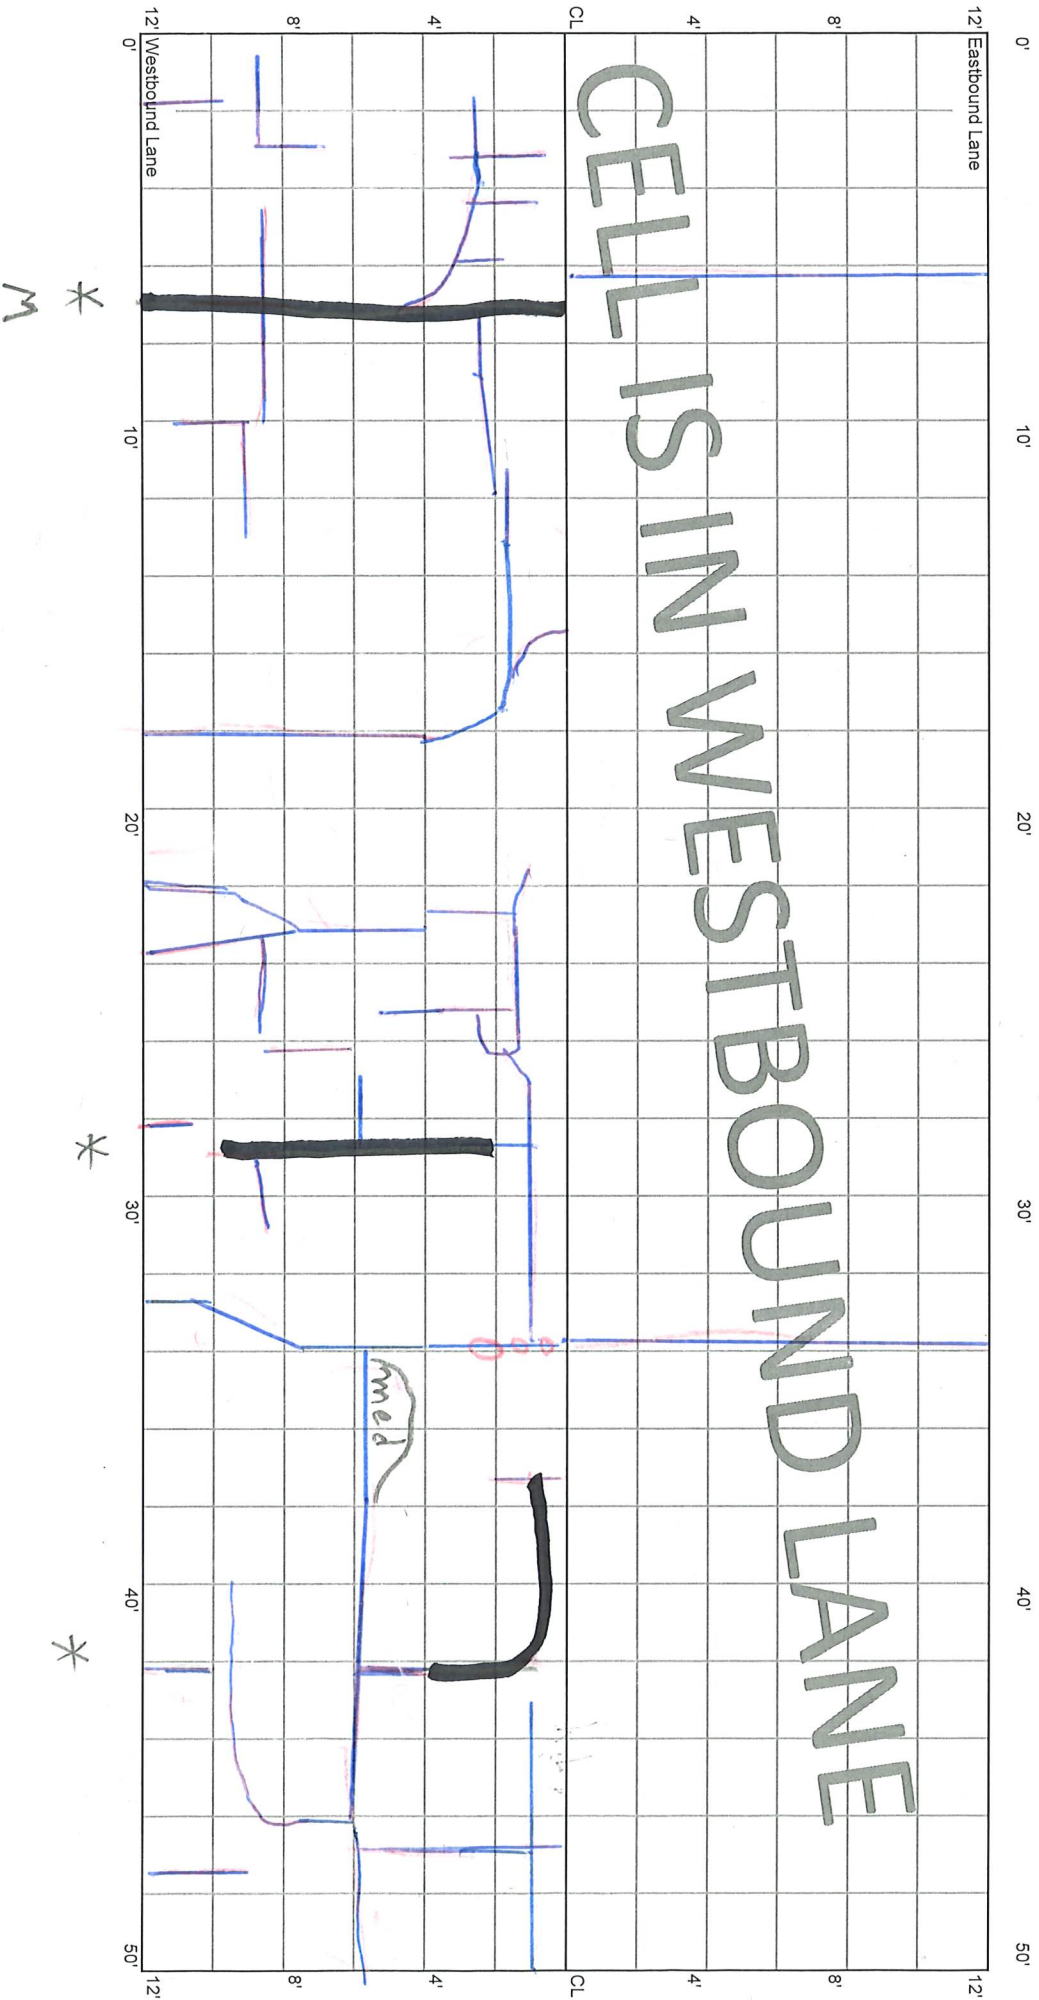

CELL 7002W
500 - 550 ft

