

5.28.20 E.J.

10.14.20 1.3.22

1.4.21 8.30.22


File 70TH ST 1.20.23

16+00

Cell 7013 W
CELL 7003W
0 - 50 ft

15+50

CELLS IN WESTBOUND LANE

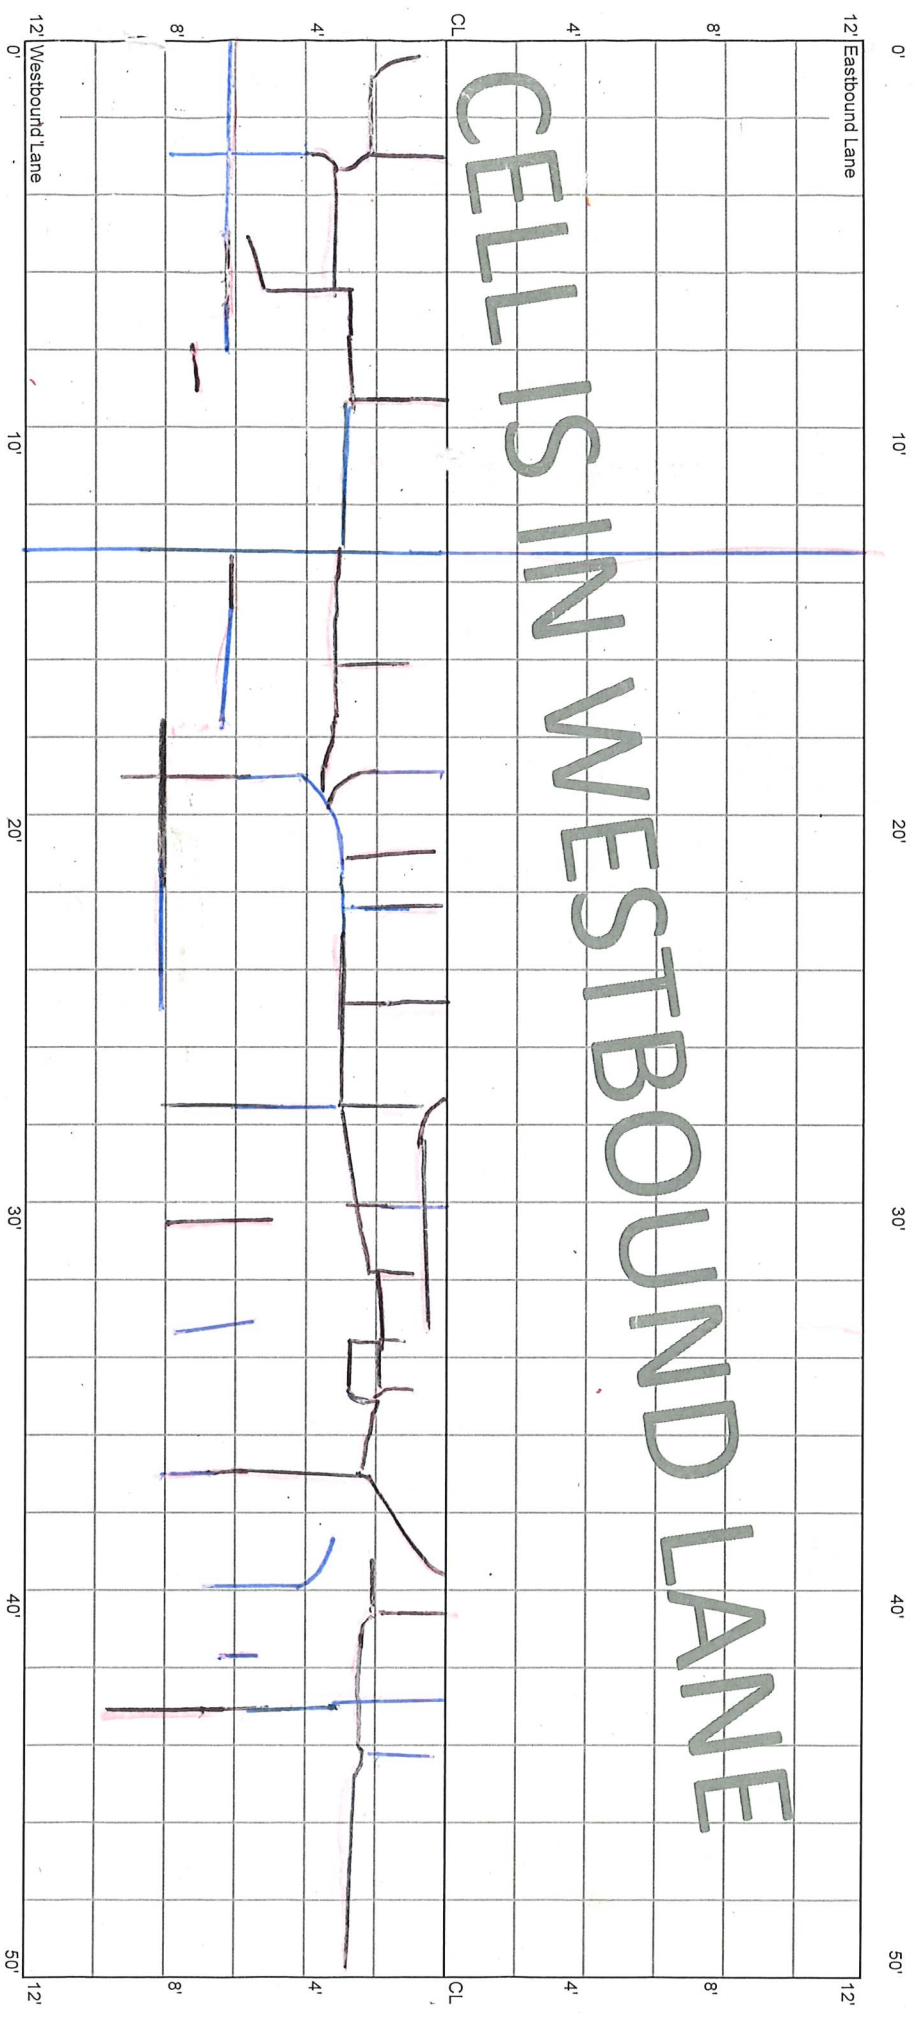


* Rout & Seal

CELL 7003W
50 - 100 ft

15+50

15+00

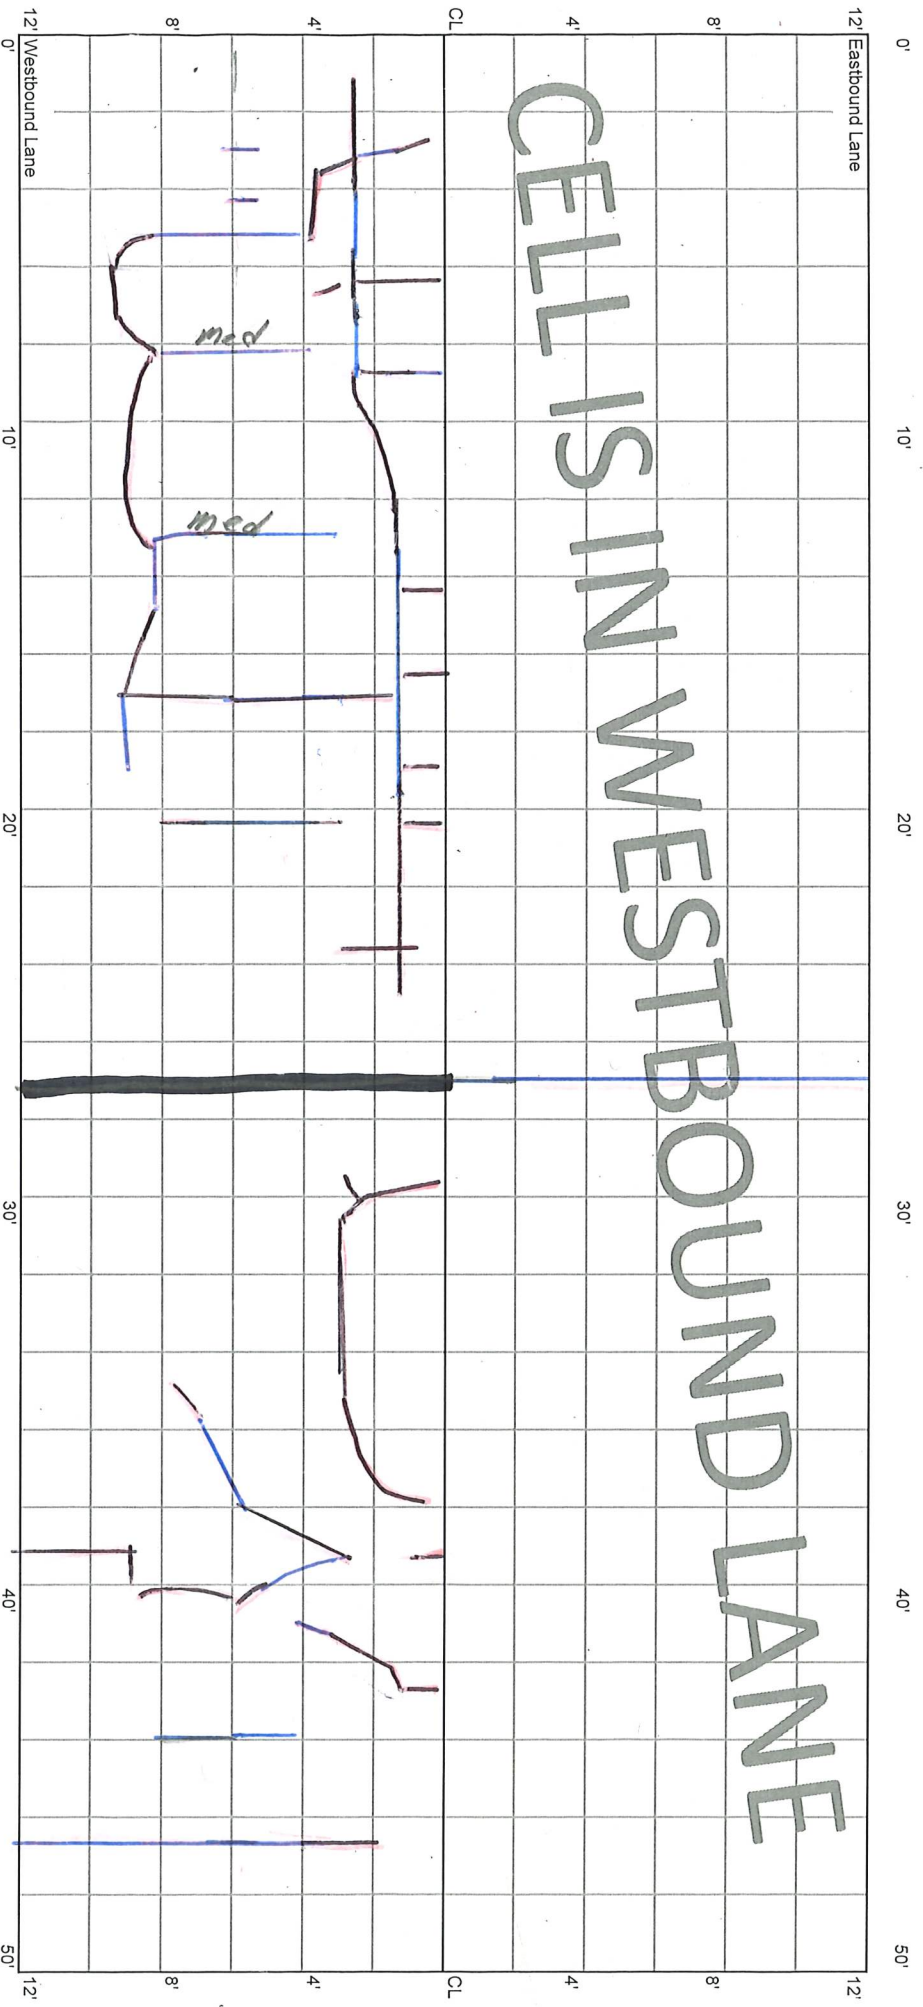


CELLS IN WESTBOUND LANE

*M
AF

CELL 7003W
100 - 150 ft

15+00

14+50

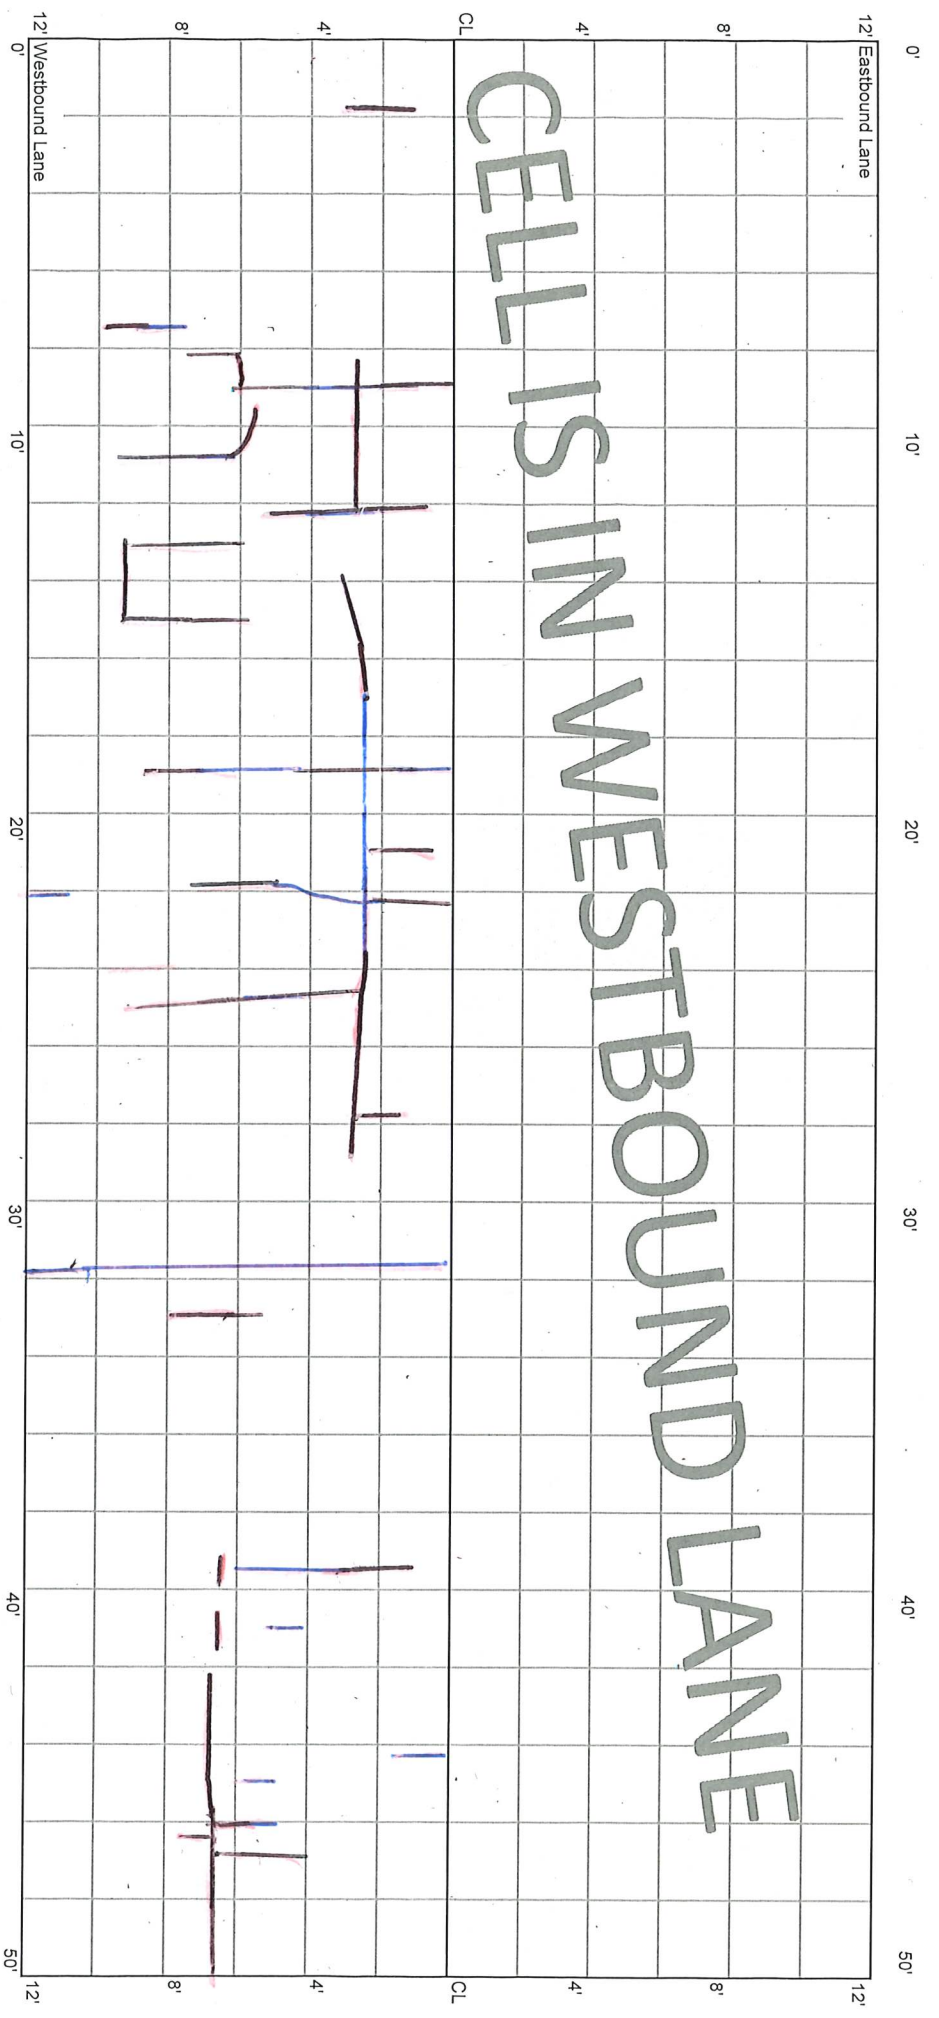

12' Eastbound Lane

12' Westbound Lane


CELLS IN WESTBOUND LANE

CELL 7003W
150 - 200 ft

14+50

14+00

CELLS IN WESTBOUND LANE

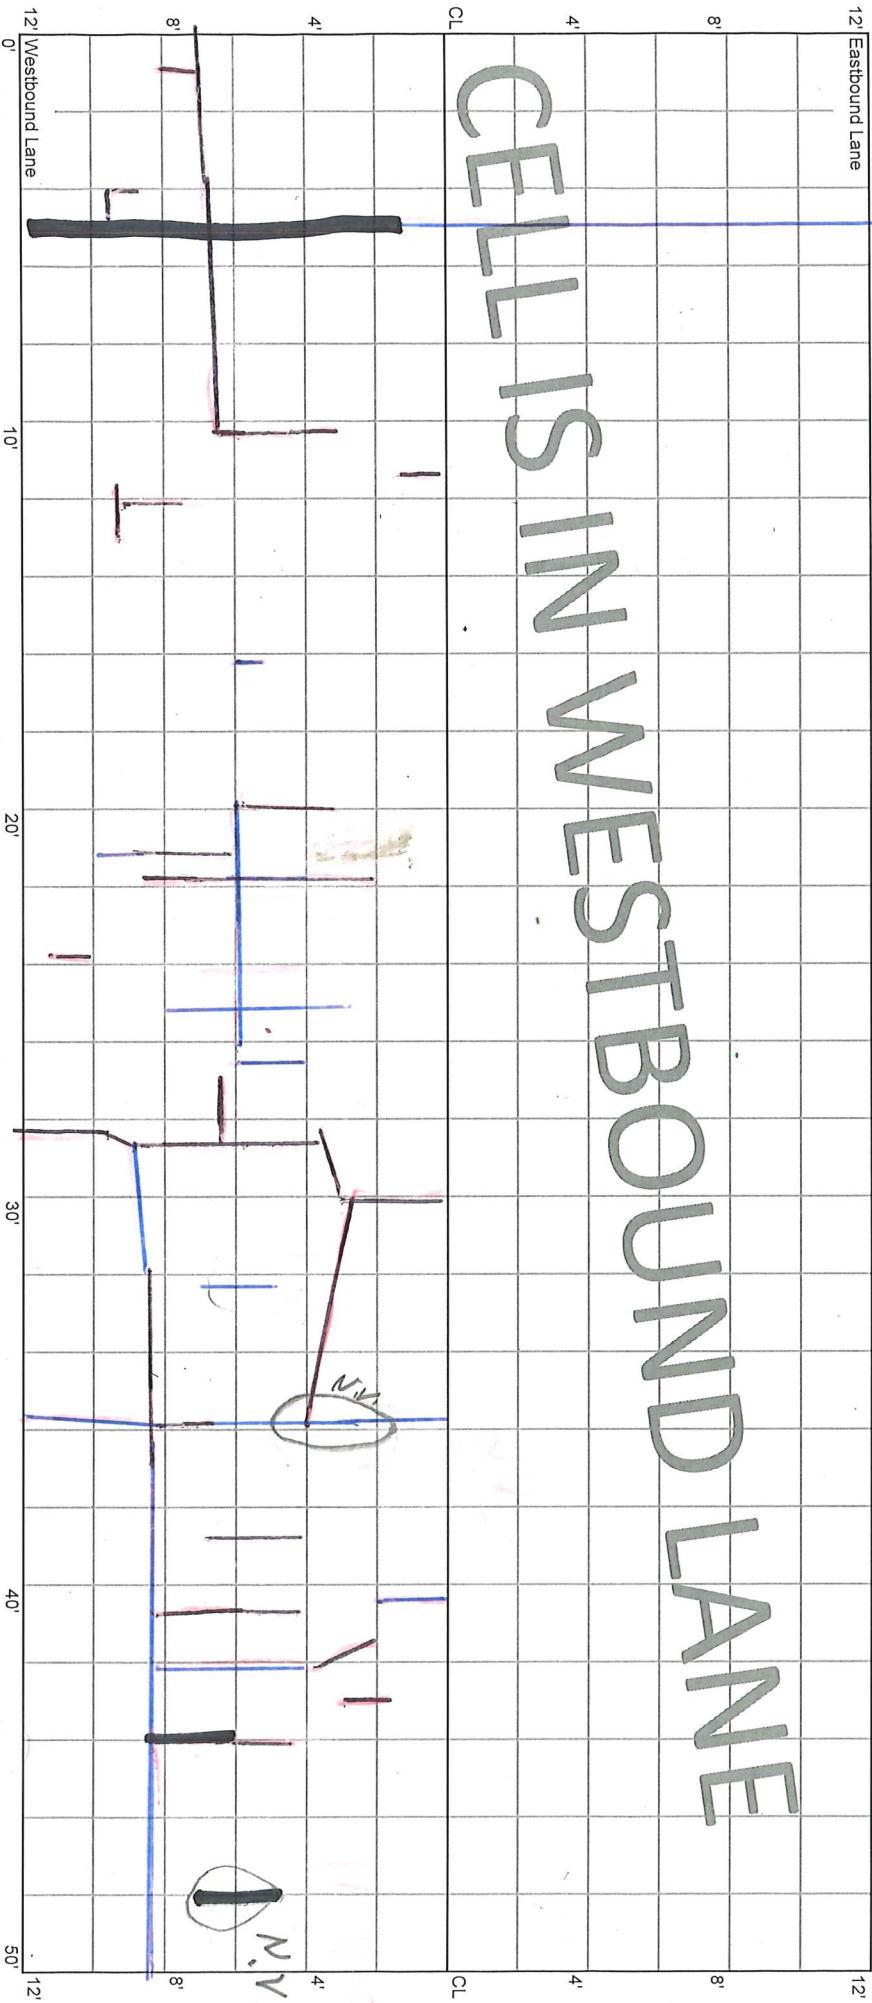

No Seal

4'

No Seal

CELL 7003W
200 - 250 ft


14+00

13+50

12' Eastbound Lane

12' Westbound Lane

CELLS IN WESTBOUND LANE

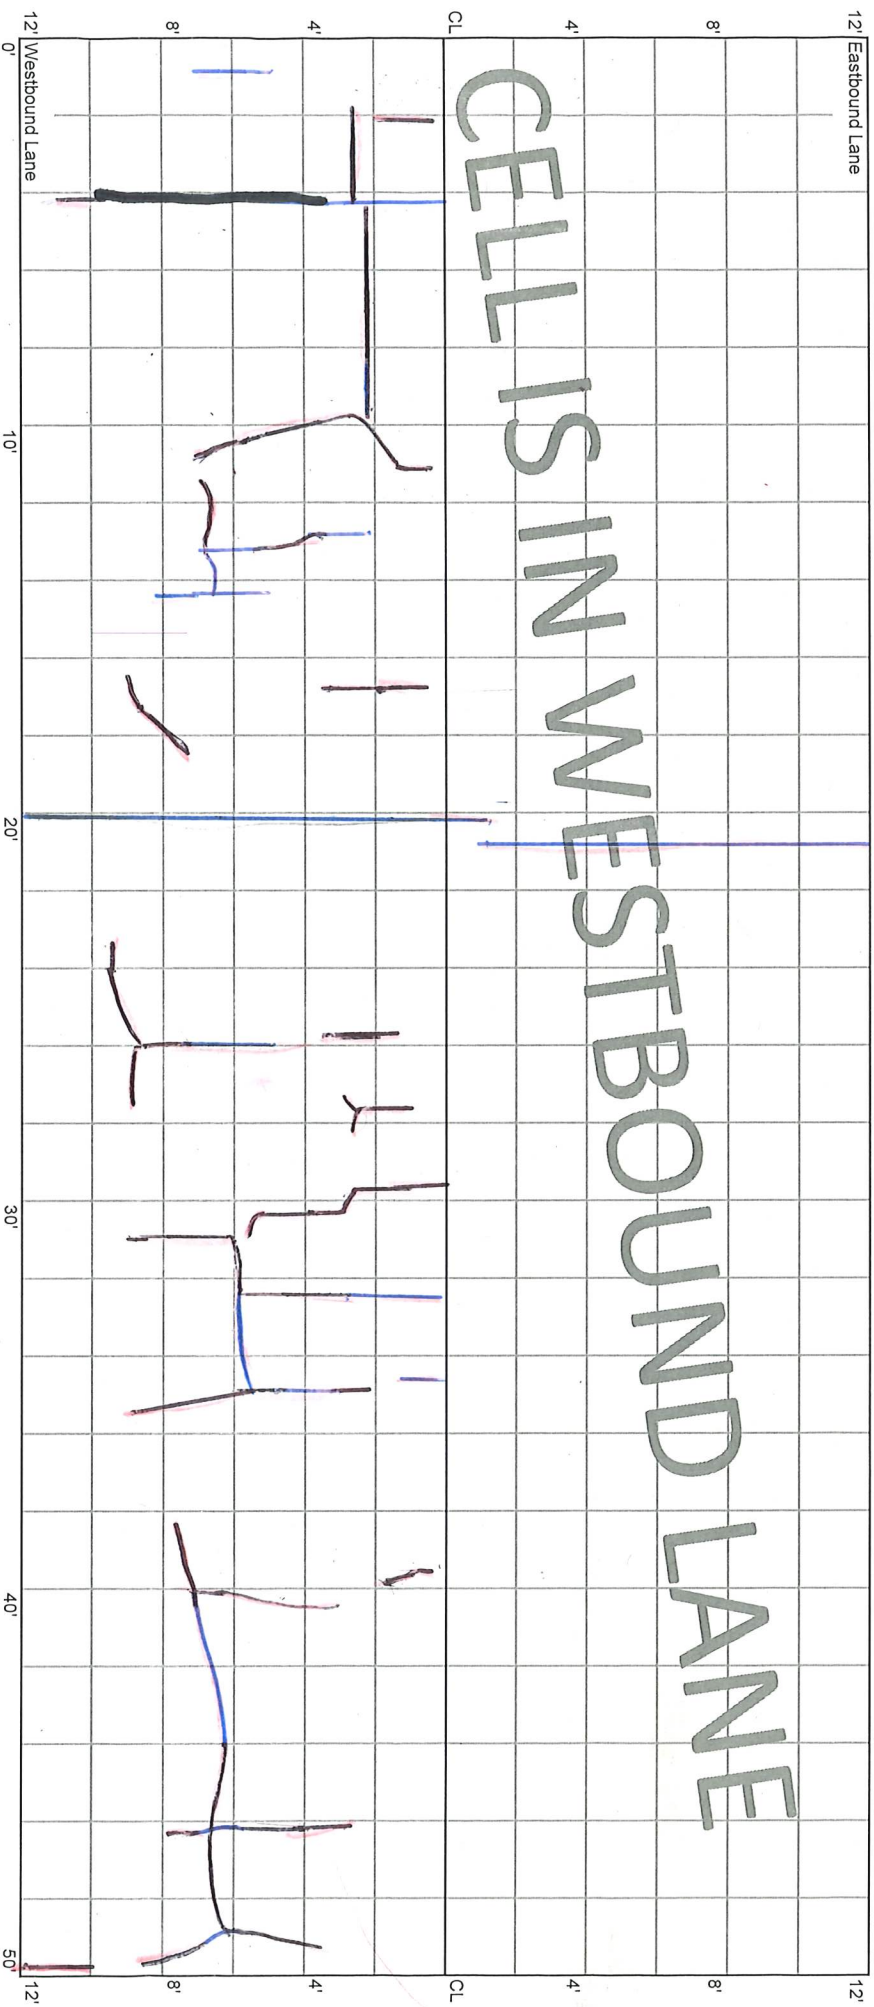

* Scaled

* AF.


lost
6" seal BWP

CELL 7003W
250 - 300 ft

13+50

13+00

CELLS IN WESTBOUND LANE

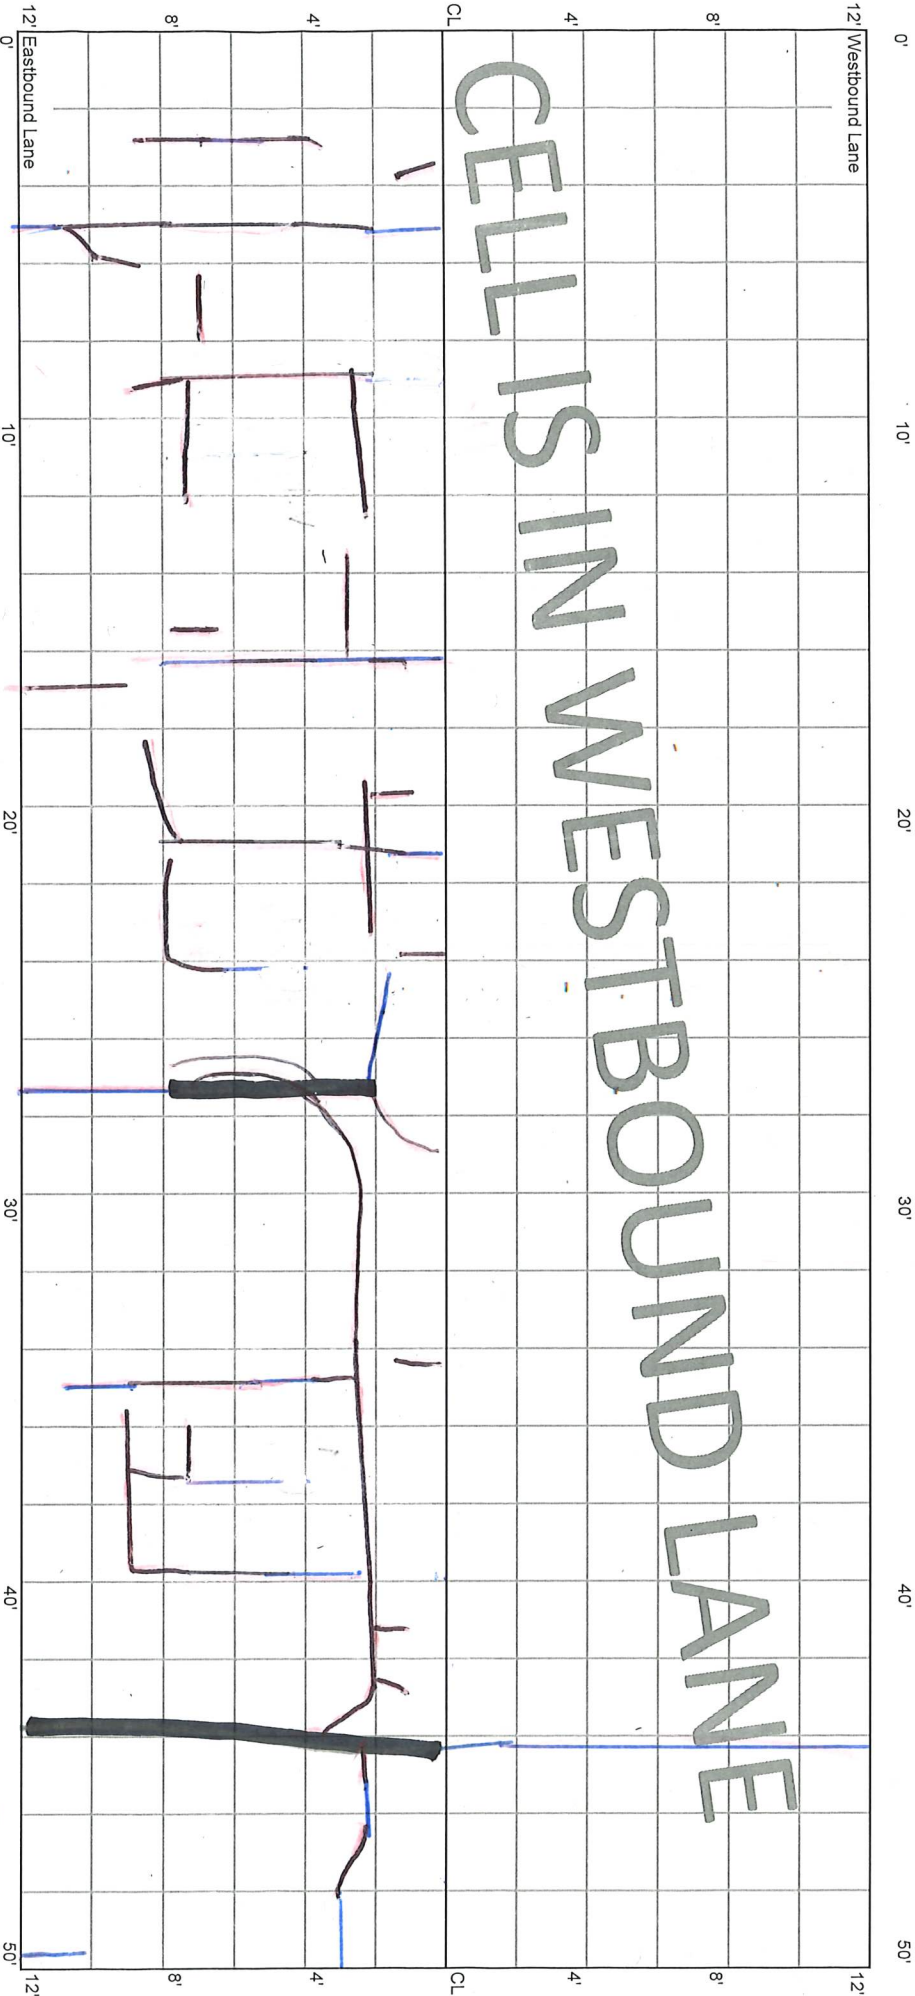

* M

* AF

6/2/99

CELL 7003W
300 - 350 ft

13+00

12+50

12' Eastbound Lane

12'

12' Westbound Lane


12'

CELLS IN WESTBOUND LANE

* N.S.

*

* N.S.
M

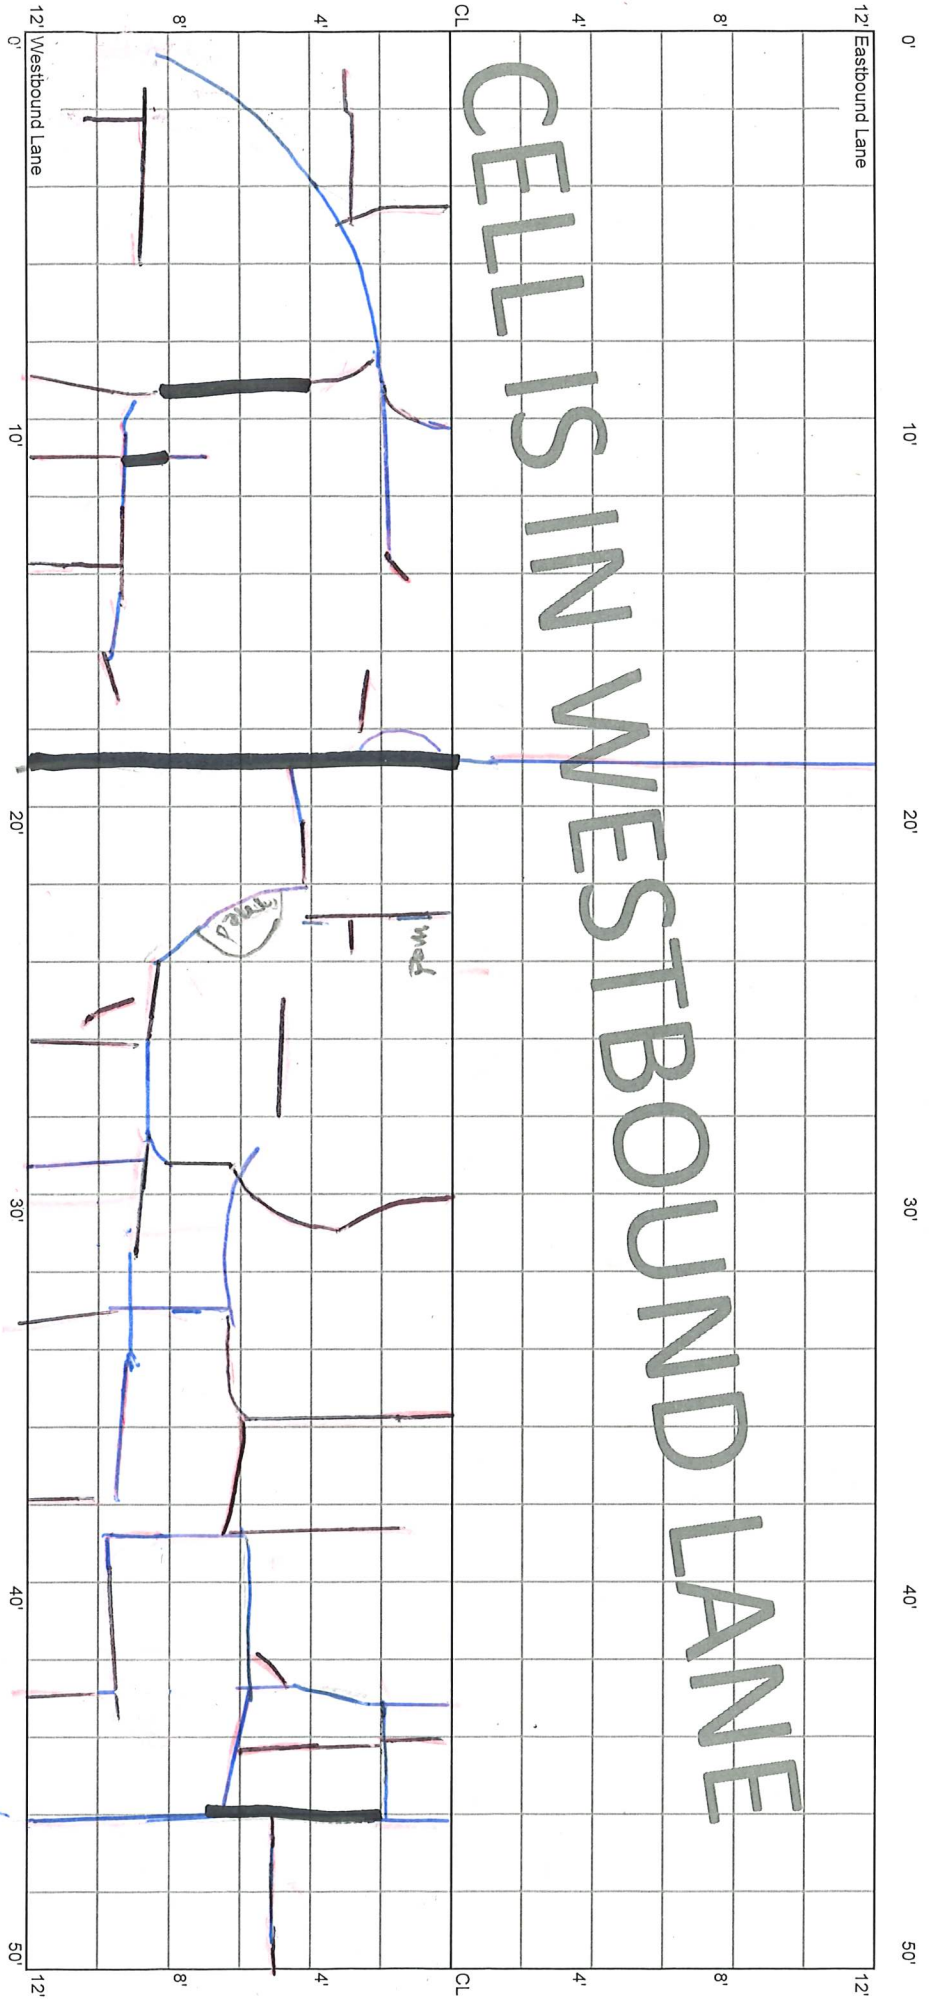

CELL 7003W
350 - 400 ft

12+50

12+00


12' Westbound Lane

12'

CELLS IN WESTBOUND LANE

12' Eastbound Lane

12'

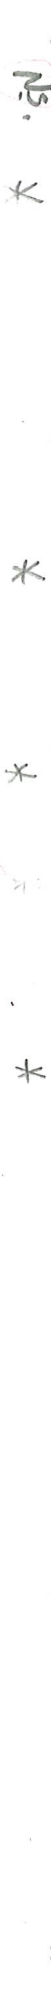

N.S.

M

N.S.


lost seal
6" BWP

CELL 7003W
400 - 450 ft

12+00

11+50

CELLS IN WESTBOUND LANE

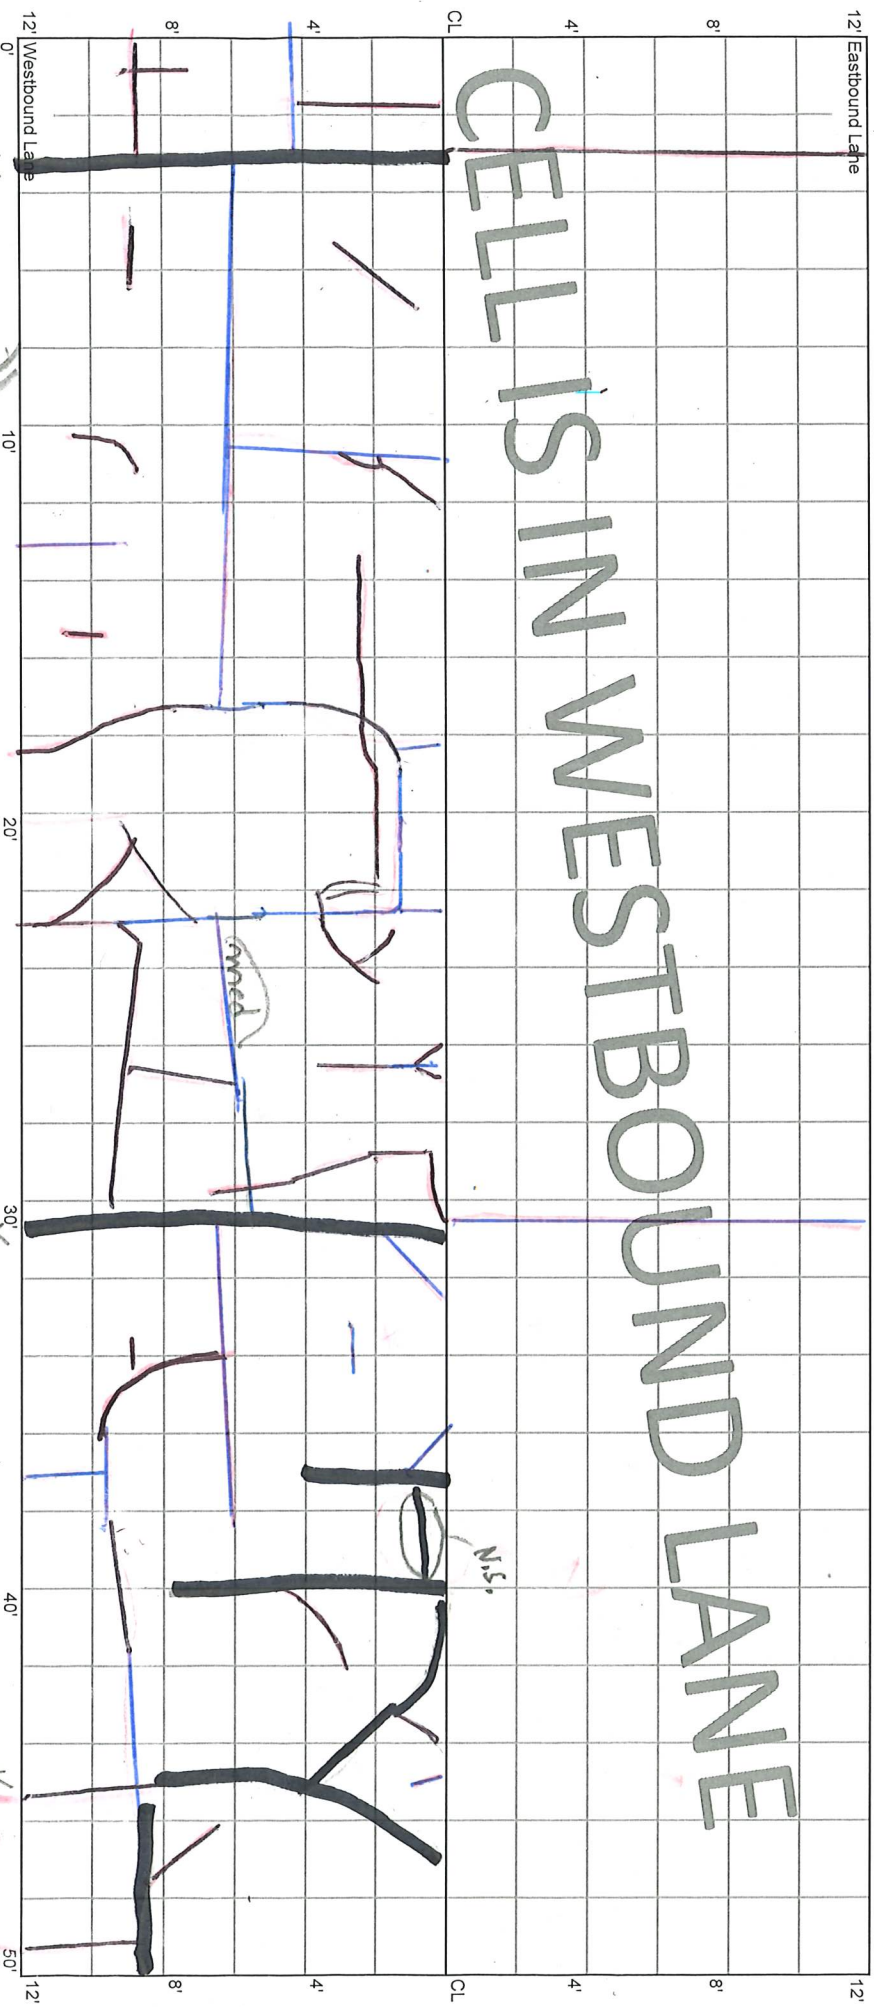

M *

Water Tower

Caved

N.S.

Lost Seal
6" BWP

L.S. 6" BWP

L.S. 6" LWP

M *

- LS 6" BWP
- (2) LS 3" LWP

CELL 7003W
450 - 500 ft


11+50

11+00

12' Eastbound Lane

12'

CELLS IN WESTBOUND LANE

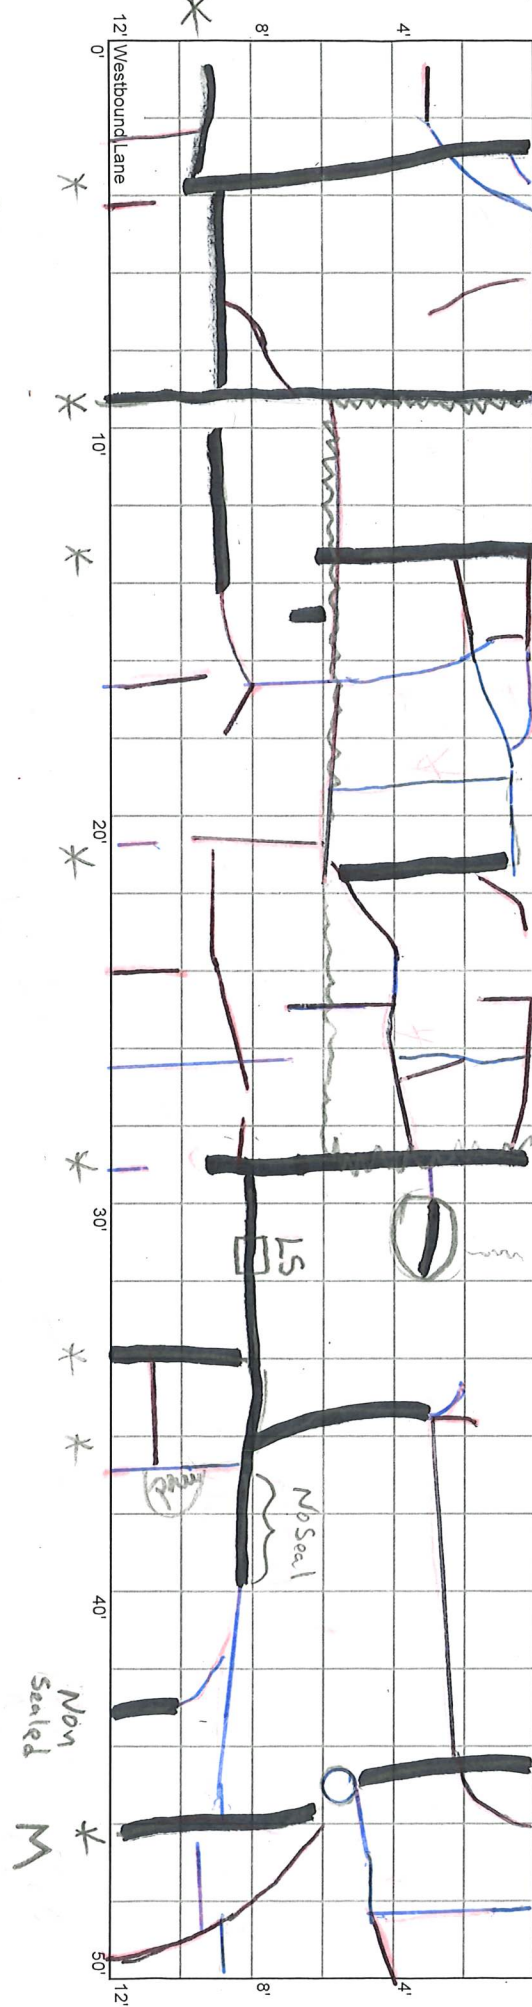

12' Westbound Lane

12'

SP

LS
12" RW P

LS
12" RW P

Long
LS (2) x 36" RW P

LS, 6" RW P
Core hole

Non Sealed

M

No Seal

N.S.

Block Crack C/W

11+00

CELL 7003W
500 - 550 ft

11+00

10+75

10+50

