


5.28.20 E.J.

10.14.22
1.14.21
File 70TH ST
9.15.21

CELL 7005W
0 - 50 ft

27+00 26+58 CL KITTRIDGE 26+50

CELLS IN WESTBOUND LANE

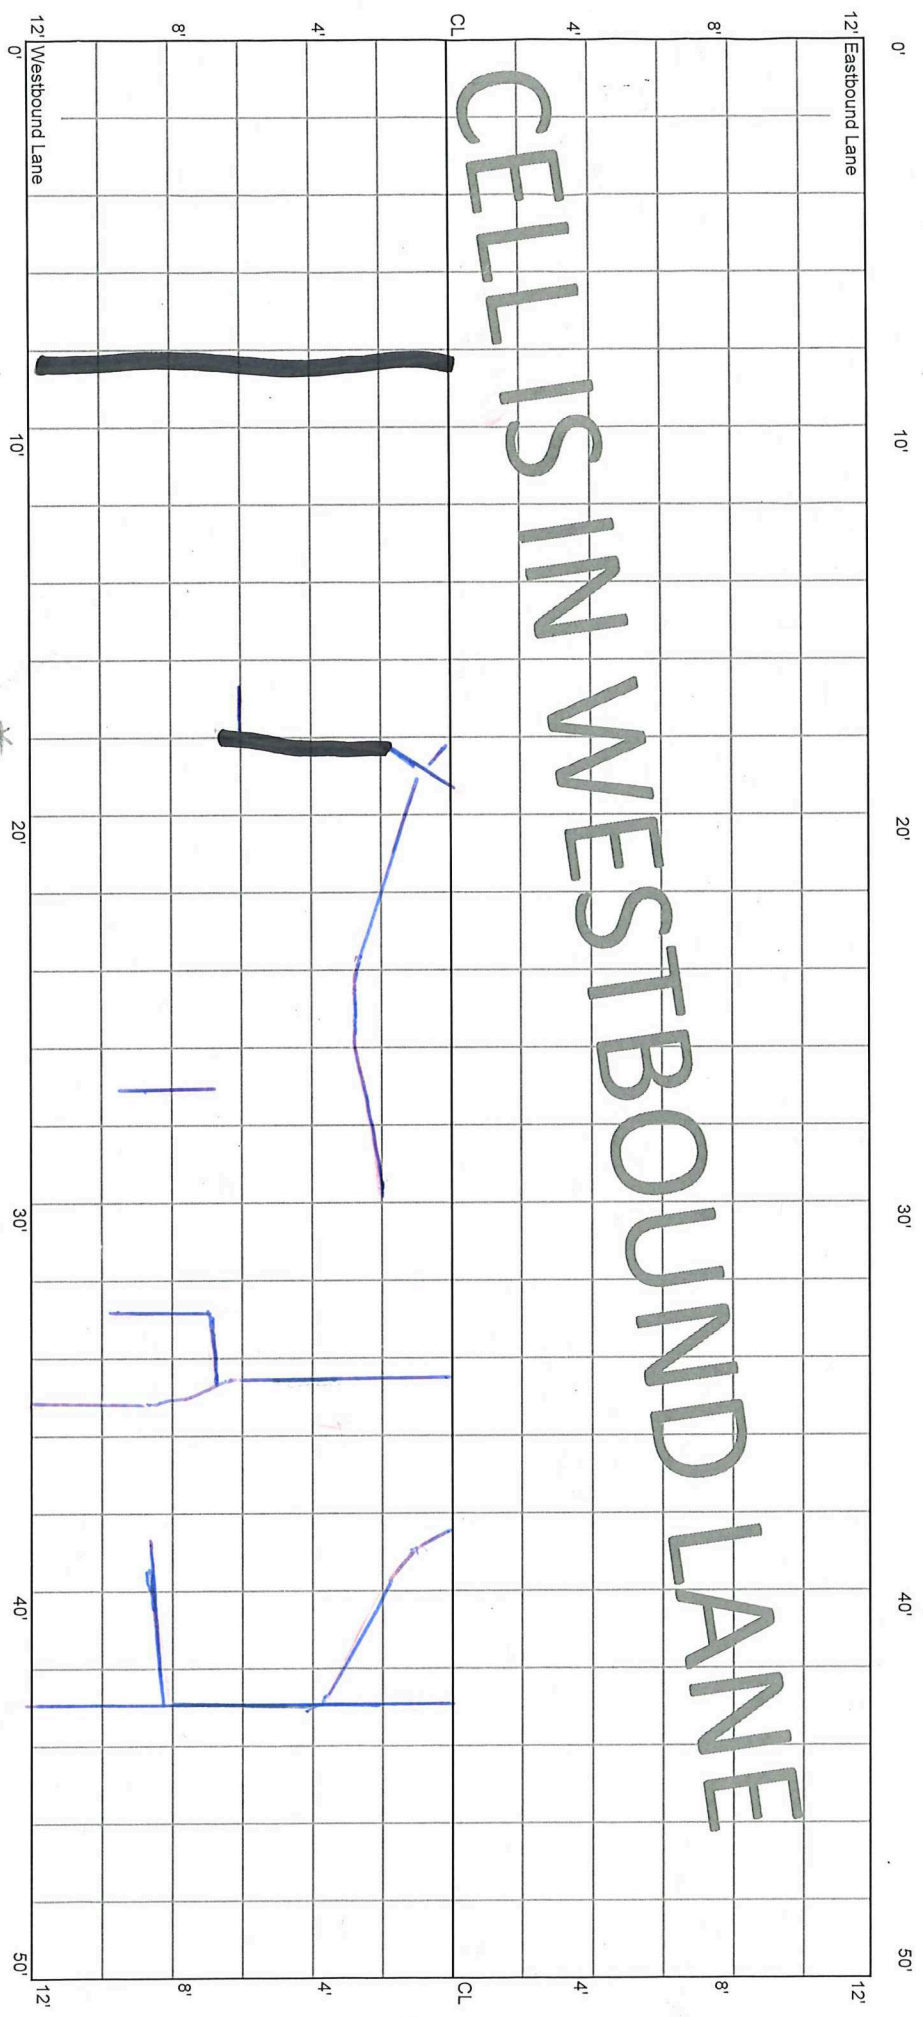


*ROADS SEAL

CELL 7005W
50 - 100 ft

26+50


26+00

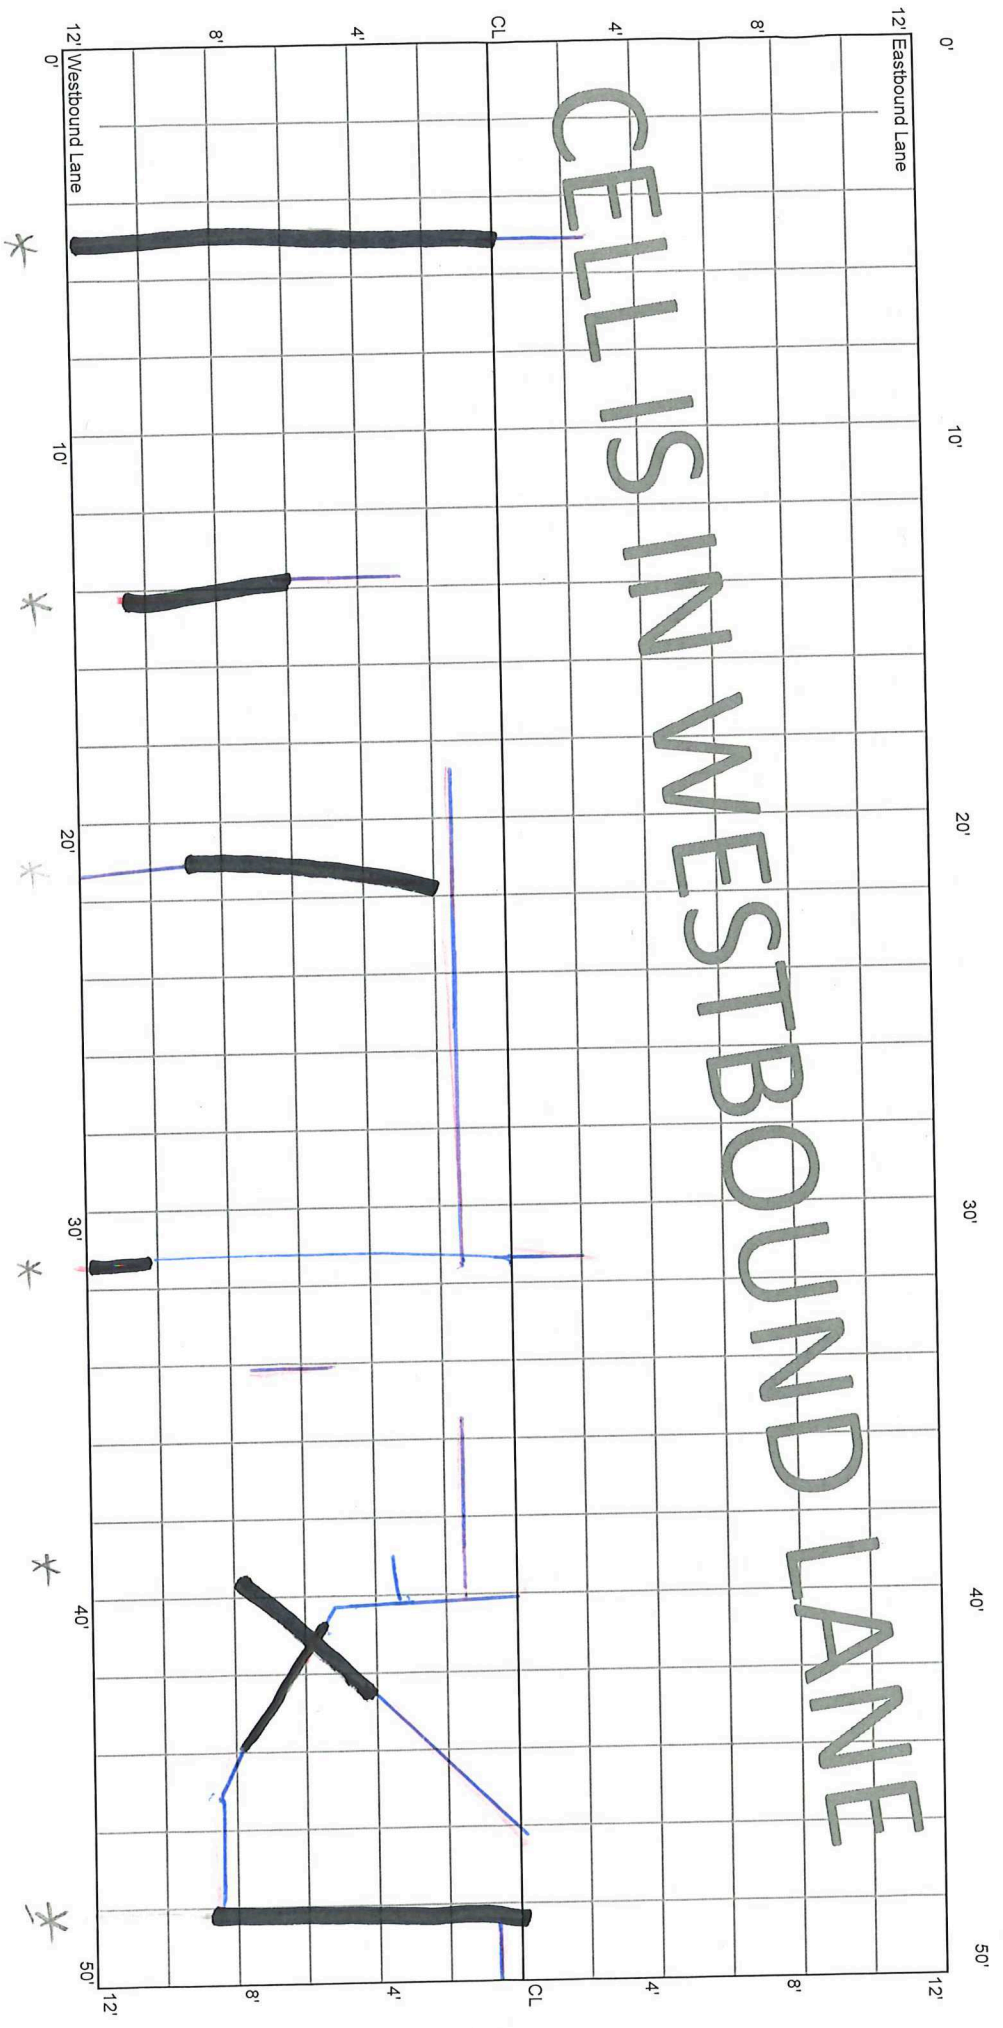


CELL 7005W
100 - 150 ft

26+00

25+50

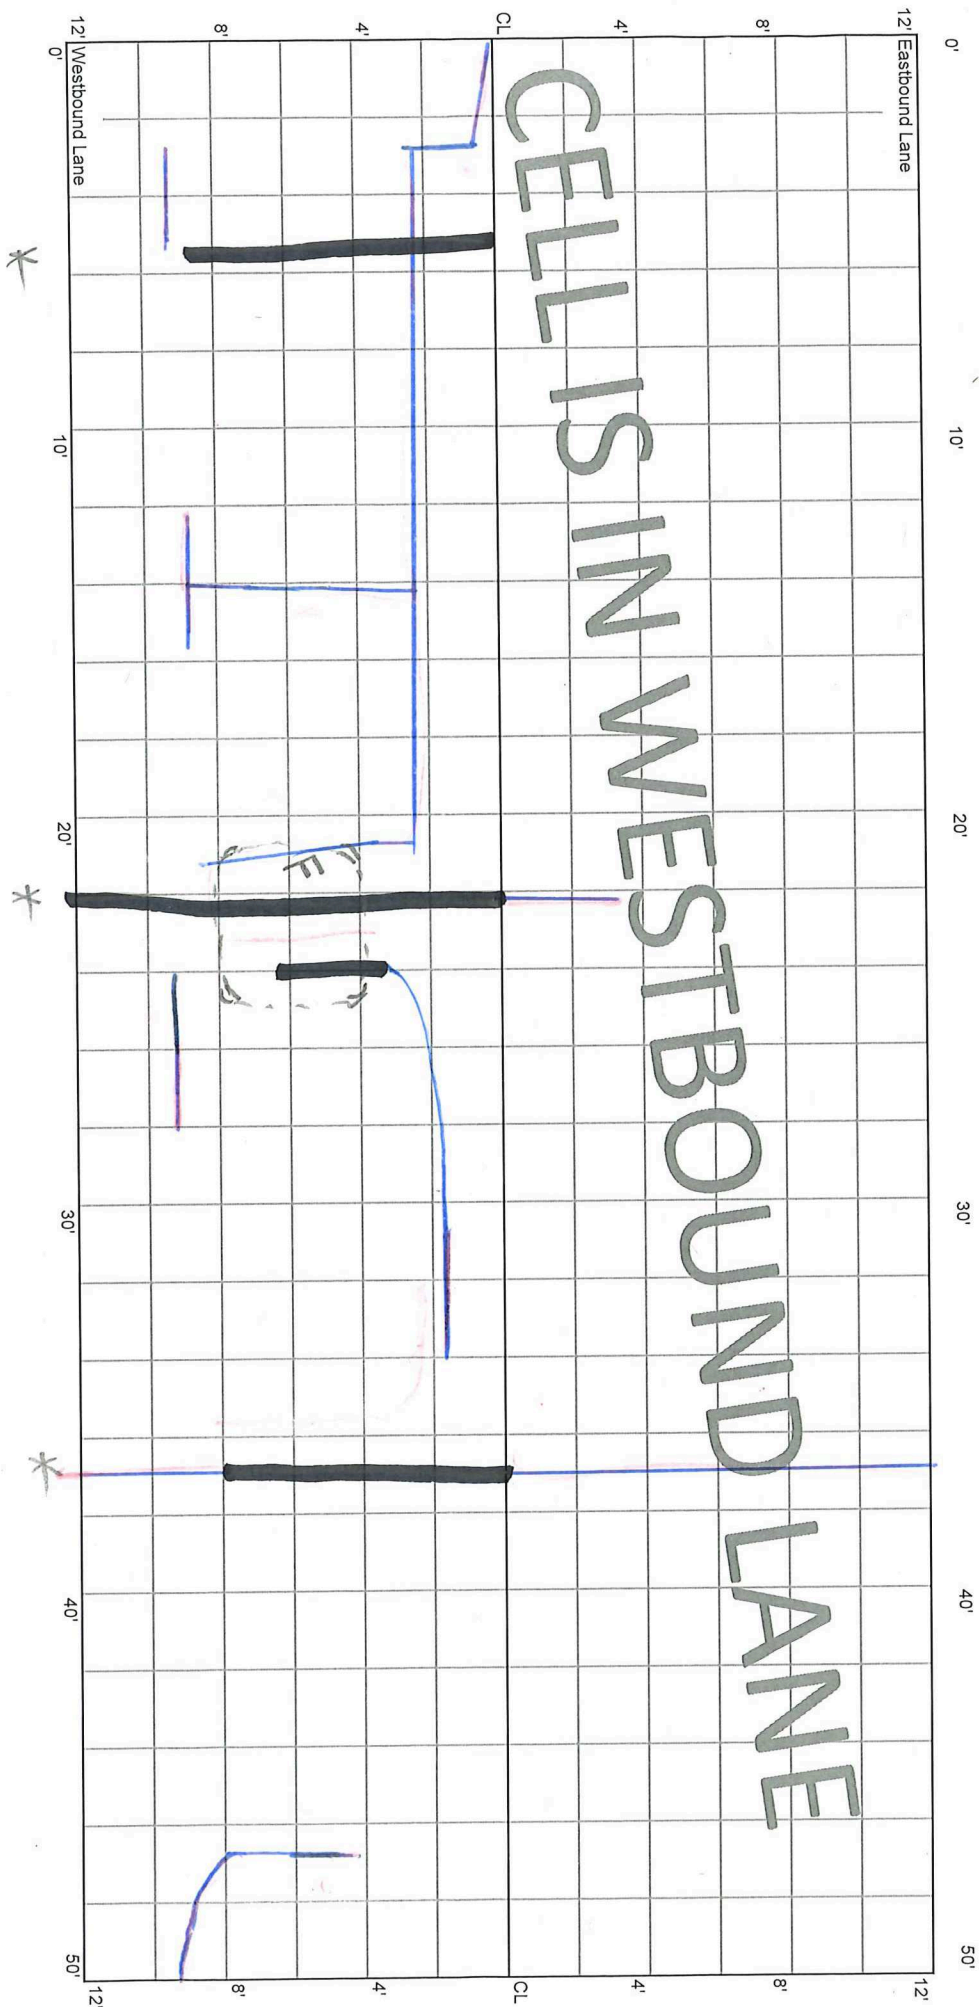


CELL 7005W
150 - 200 ft

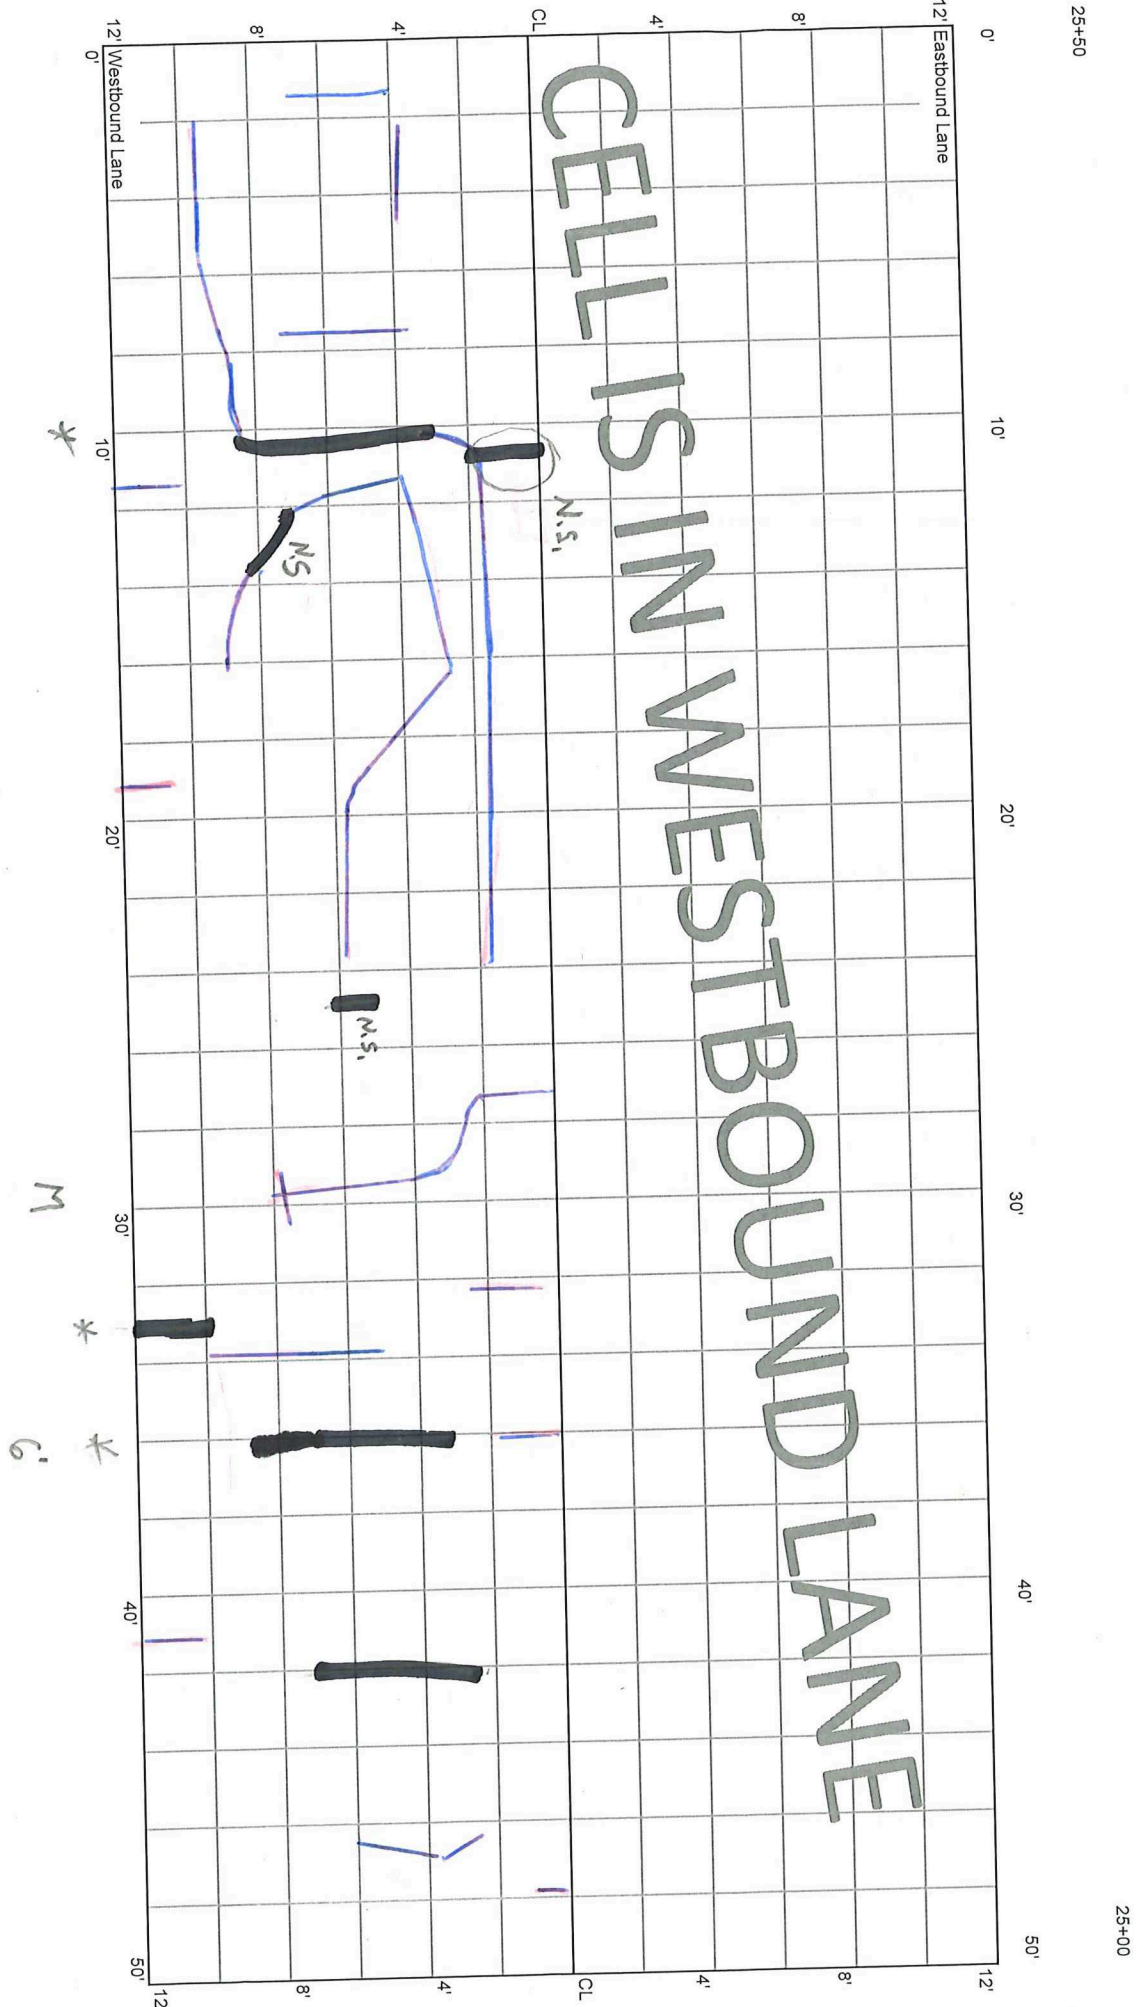

CELL 7005W
200 - 250 ft

25+00

24+50

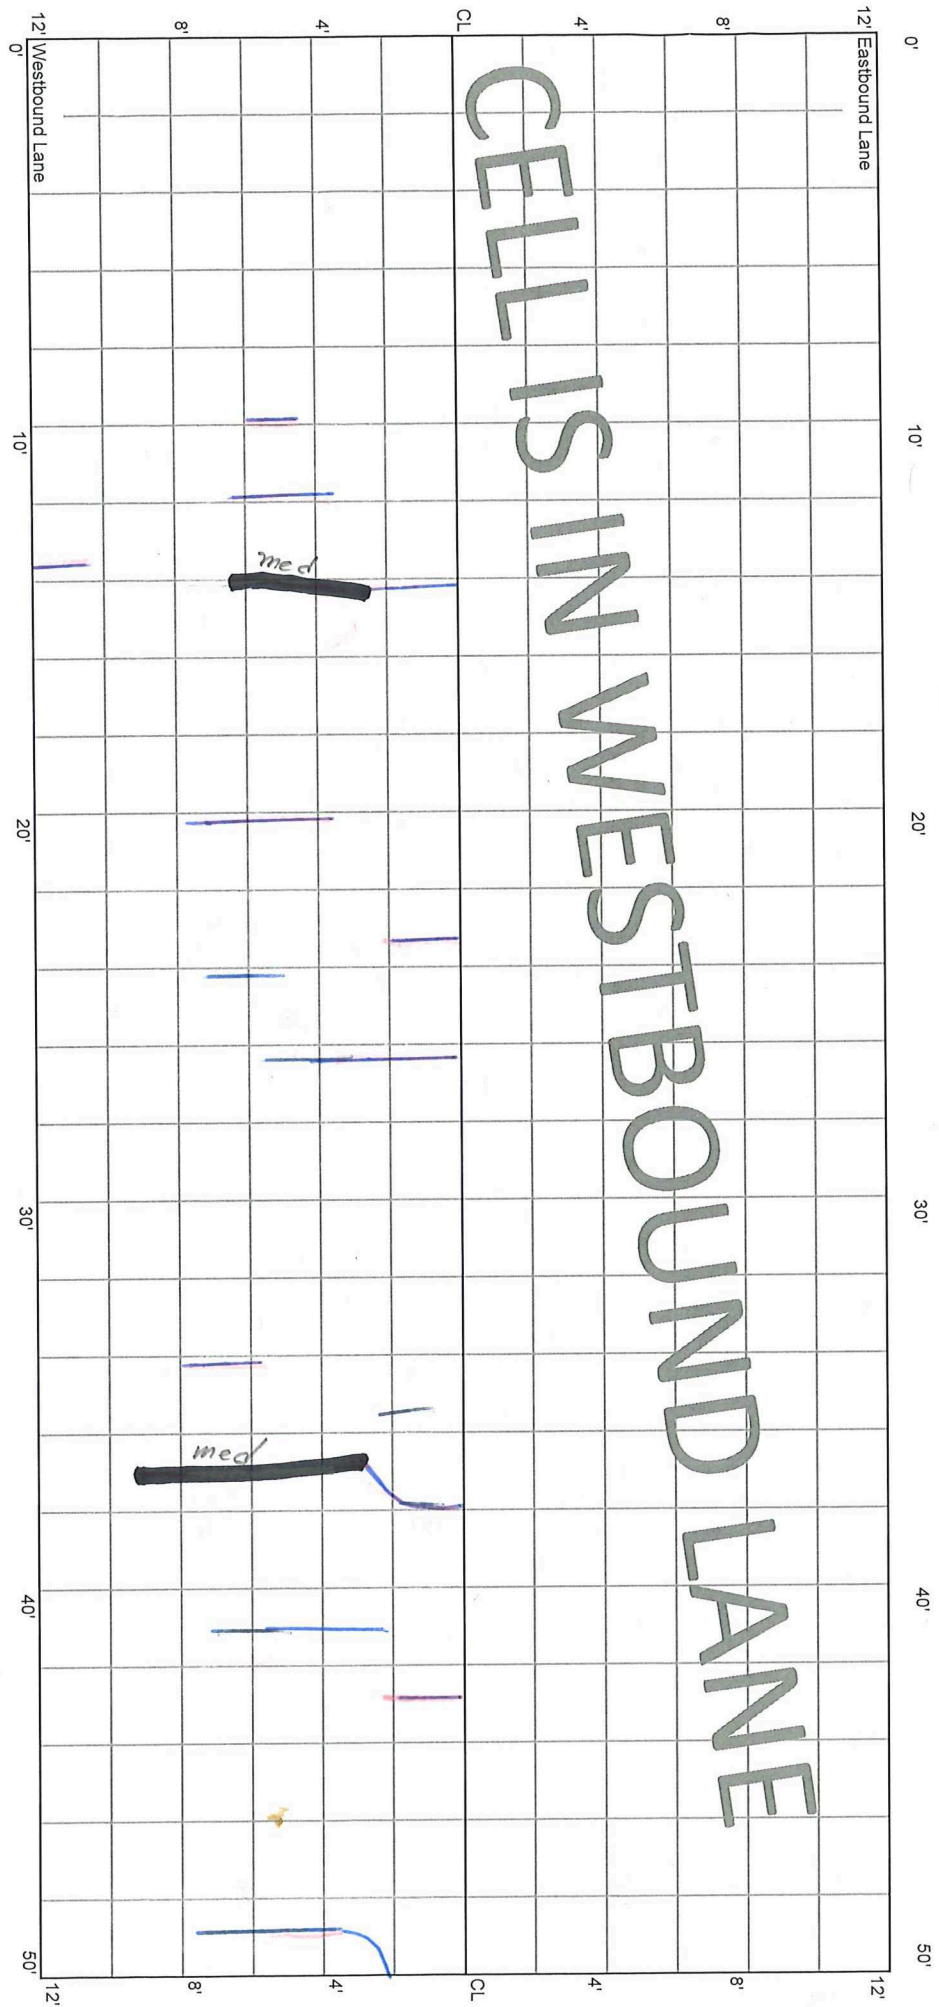


12' Eastbound Lane

12' Westbound Lane

CELL 7005W
250 - 300 ft

24+50

24+00

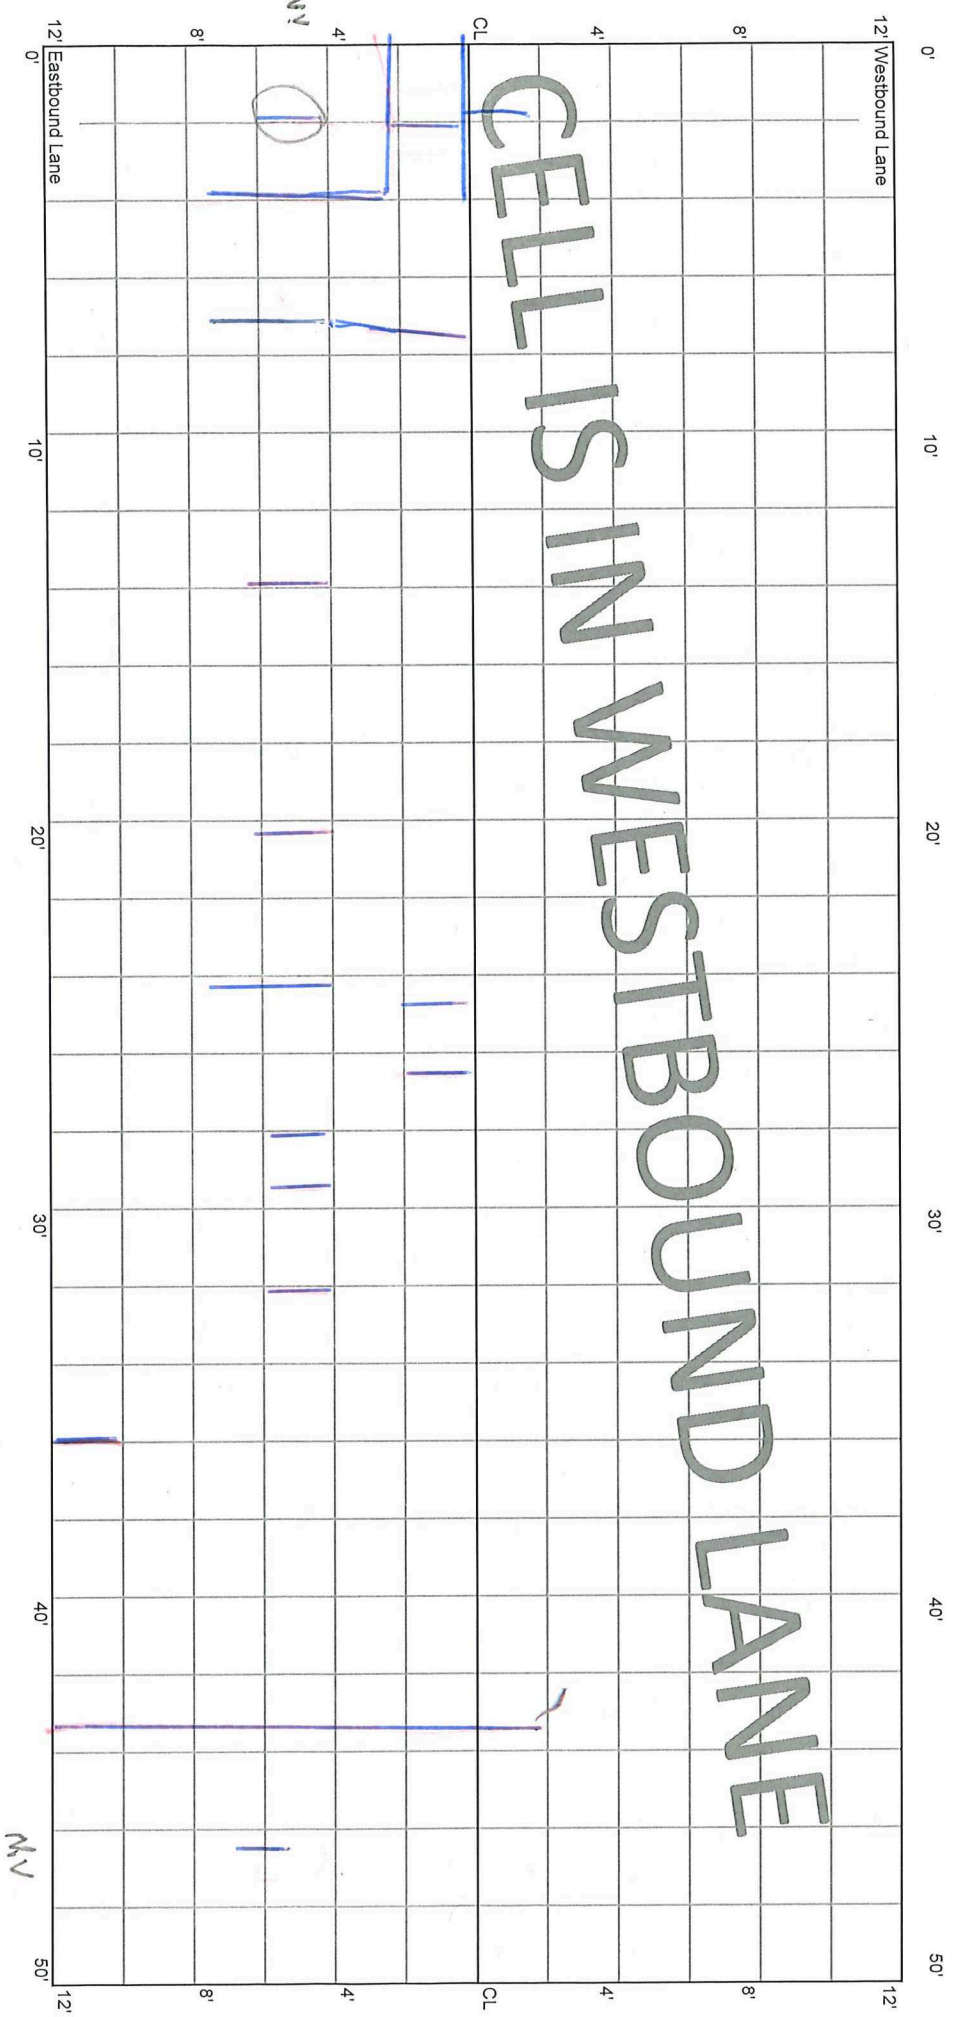

CELL 7005W
300 - 350 ft


24+00

23+50

12' Eastbound Lane

12' Westbound Lane

CELLS IN WESTBOUND LANE

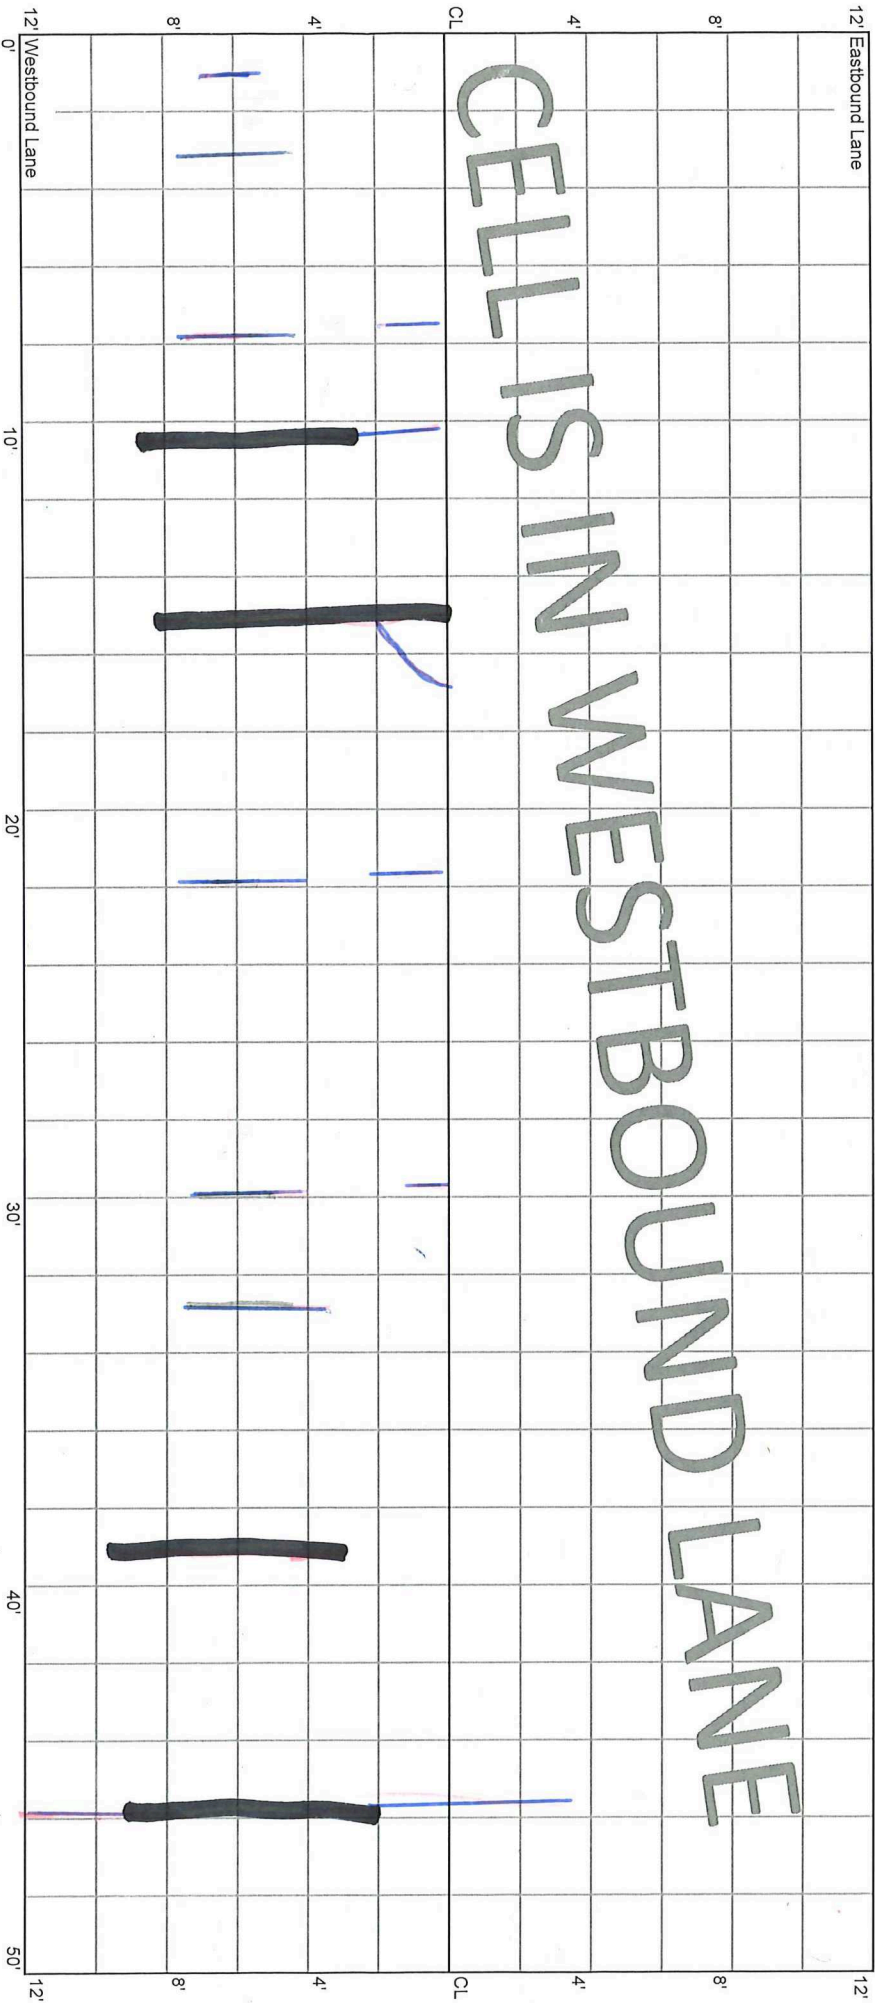

314'

319'


355'

CELL 7005W
350 - 400 ft

23+50

23+00

CELLS IN WESTBOUND LANE

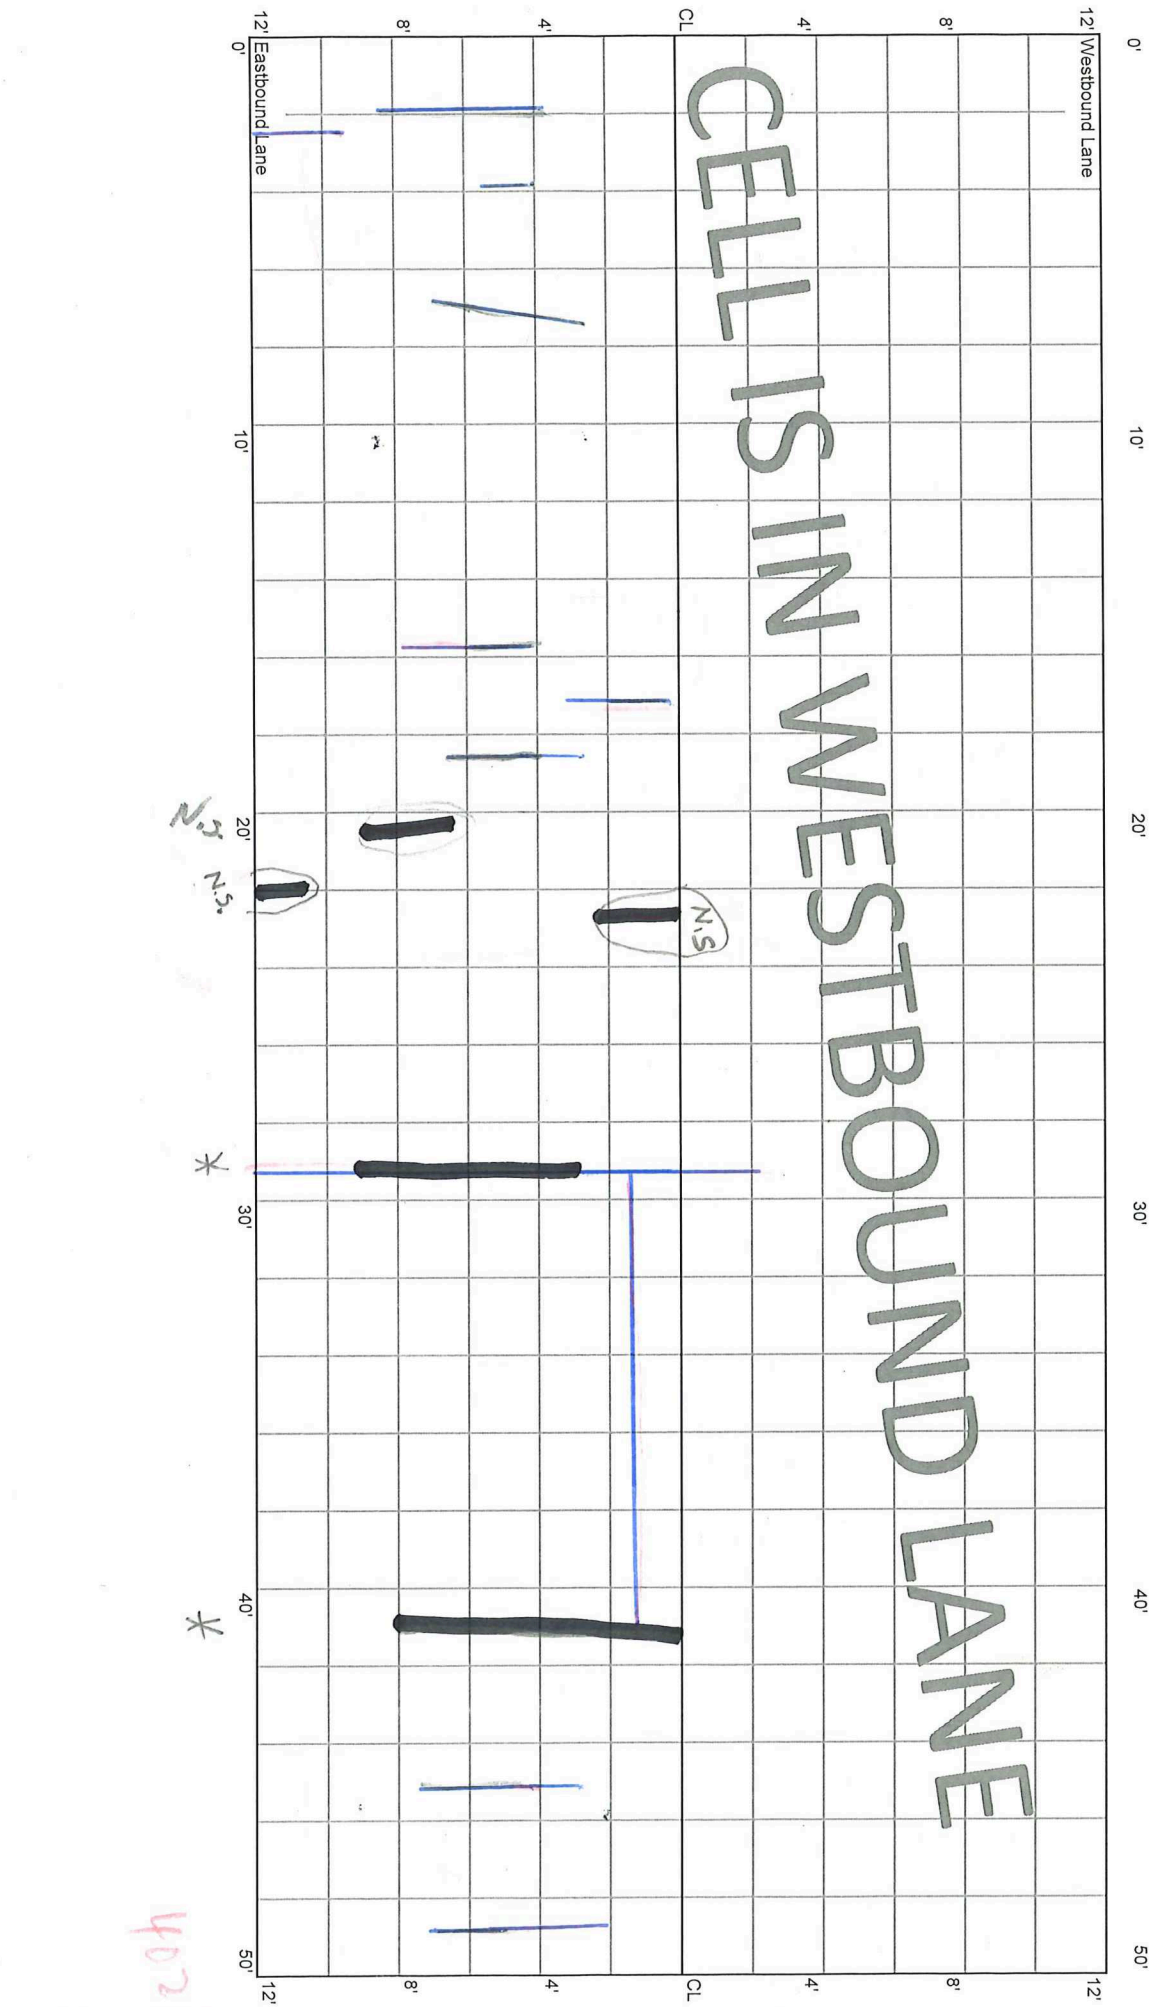

N.S.
N.S.

*


*

402

CELL 7005W
400 - 450 ft

23+00


22+50

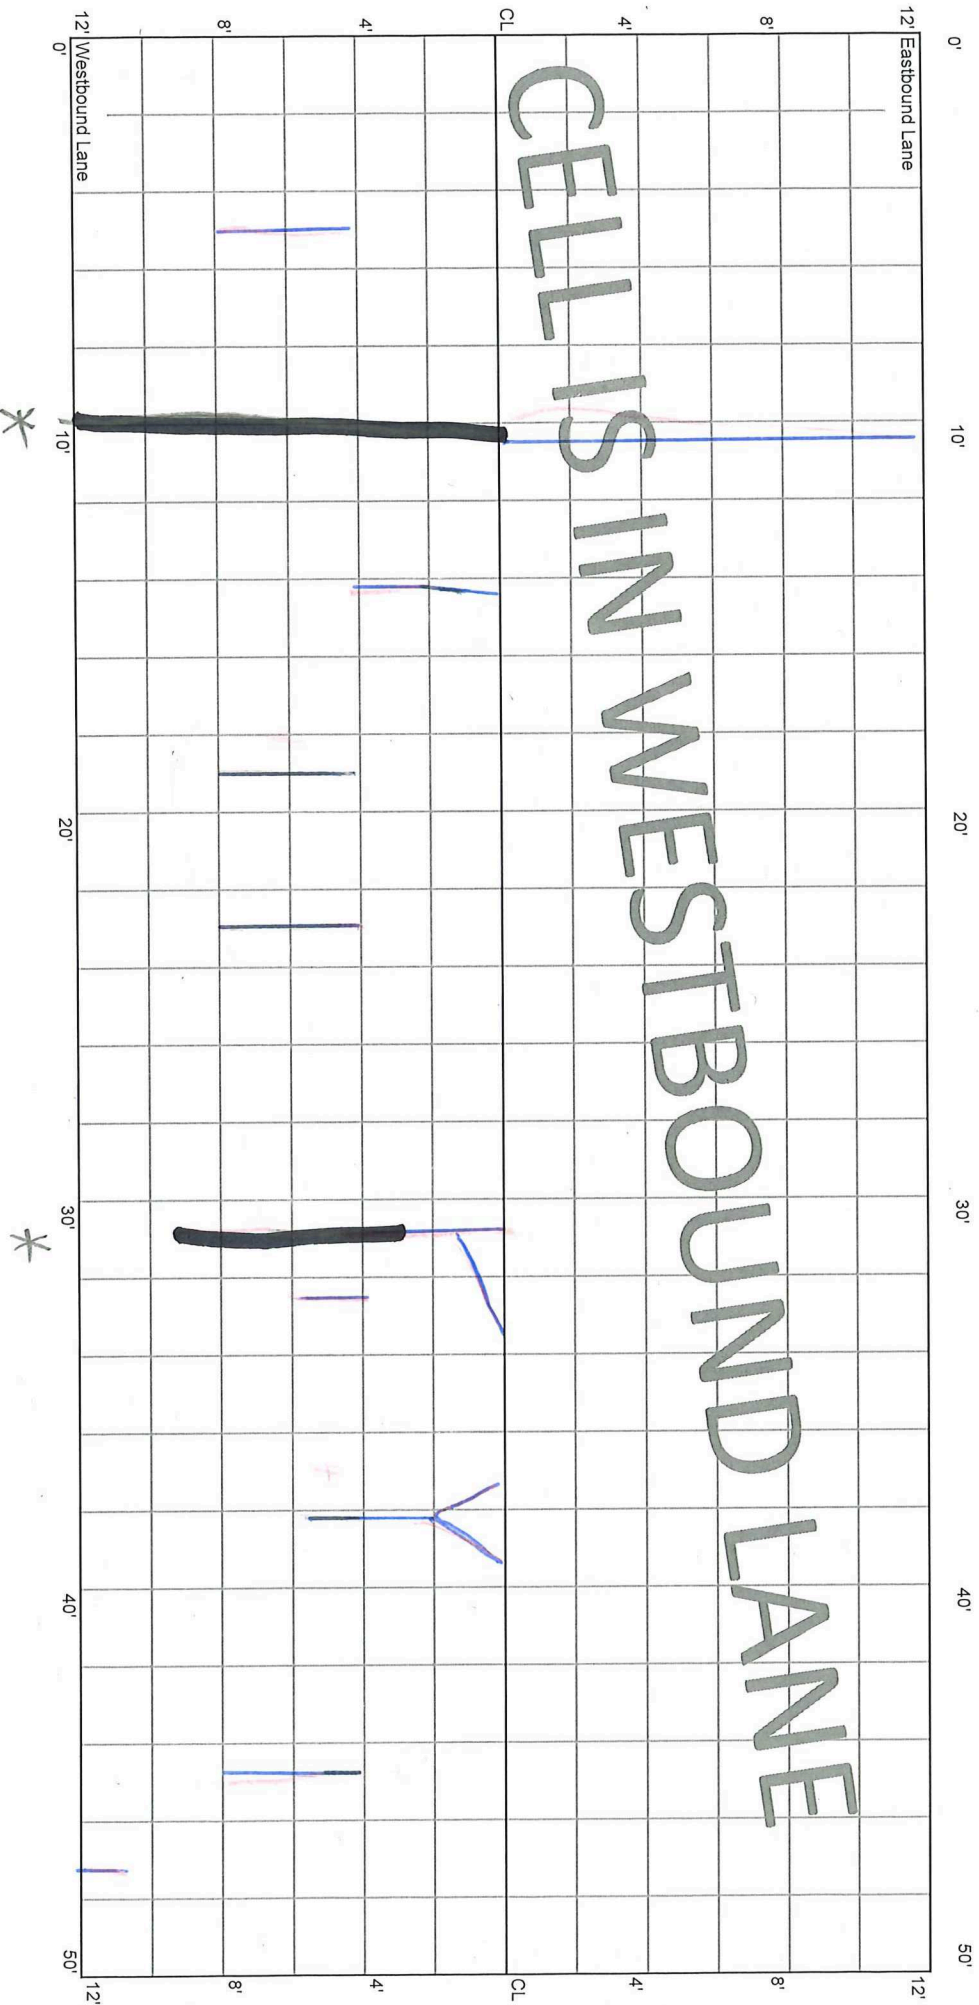

CELL 7005W
450 - 500 ft

22+50

22+00

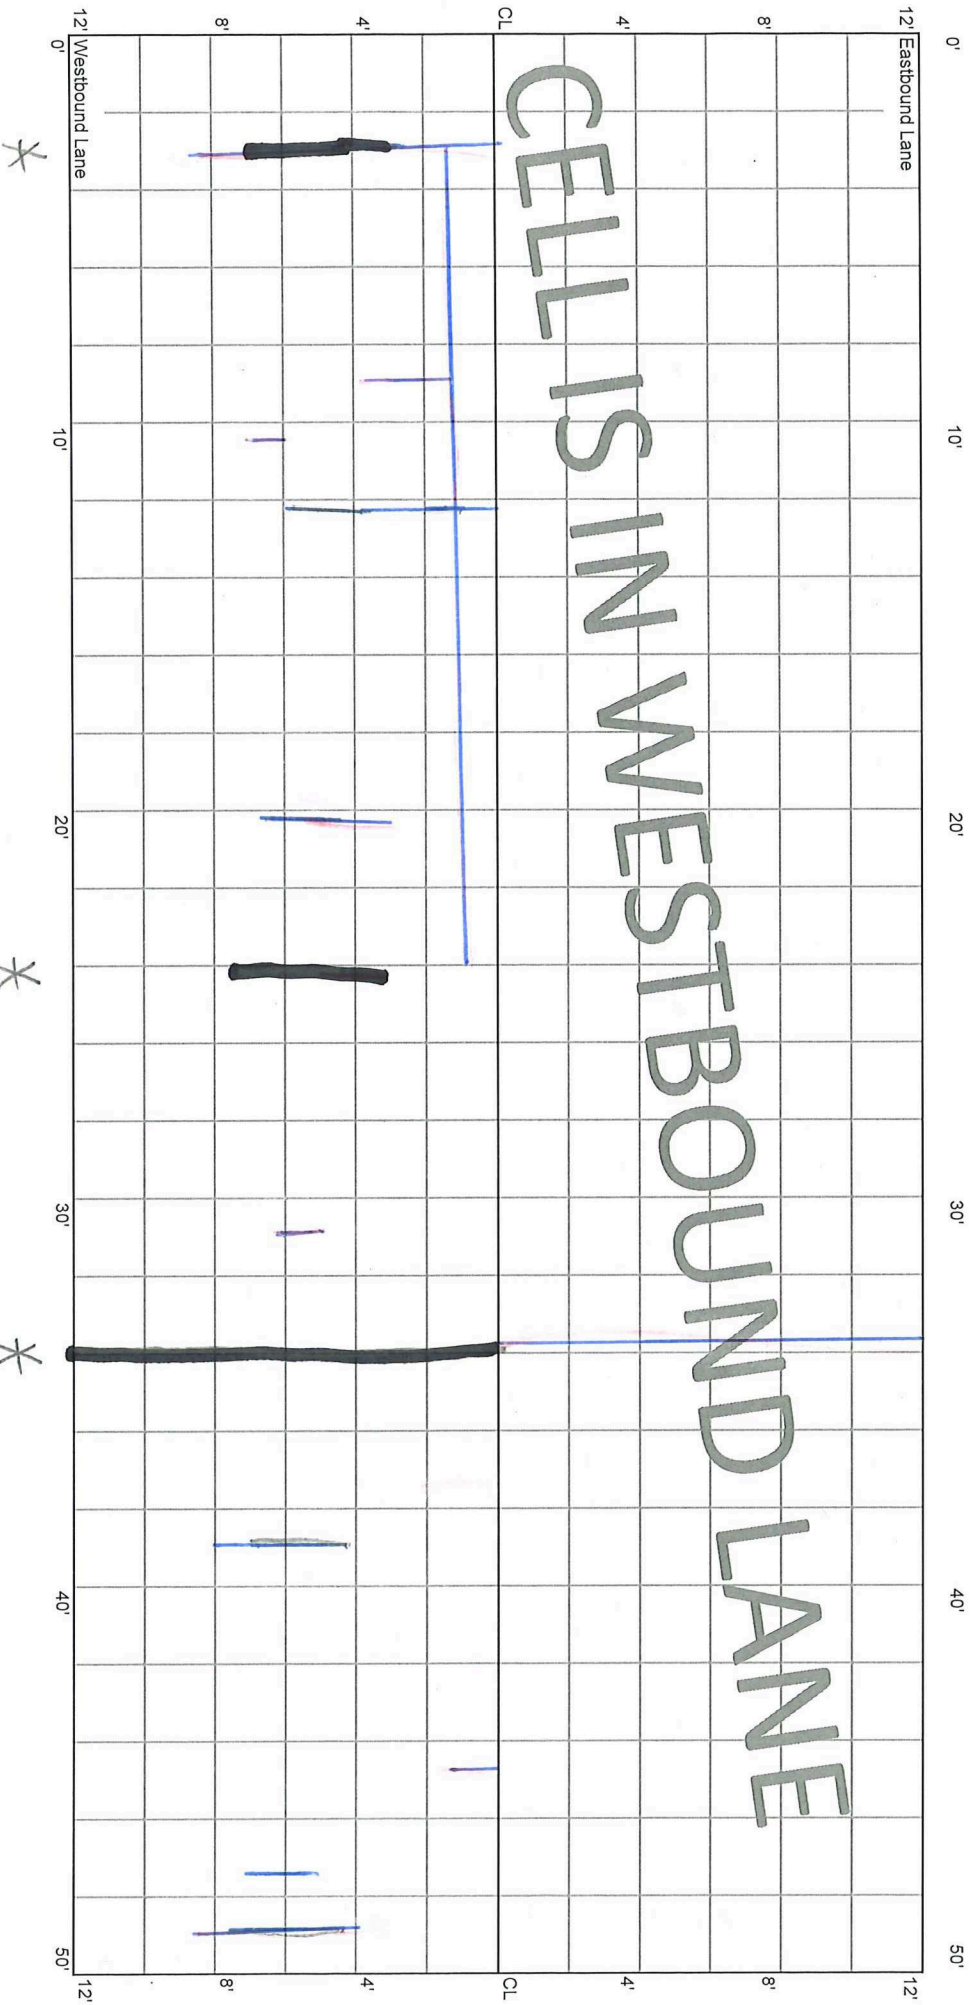

Handwritten note: 14' sand

CELL 7005W
500 - 550 ft

22+00

21+75

21+50

