

5.28.20 E.T.


10.14.22 | 1.12.22
1.4.21 | 8.31.22
File 70TH ST | 9.15.21

CELL 7015 W
CELL 7005W
0 - 50 ft

27+00

26+58
CL KITTRIDGE

26+50

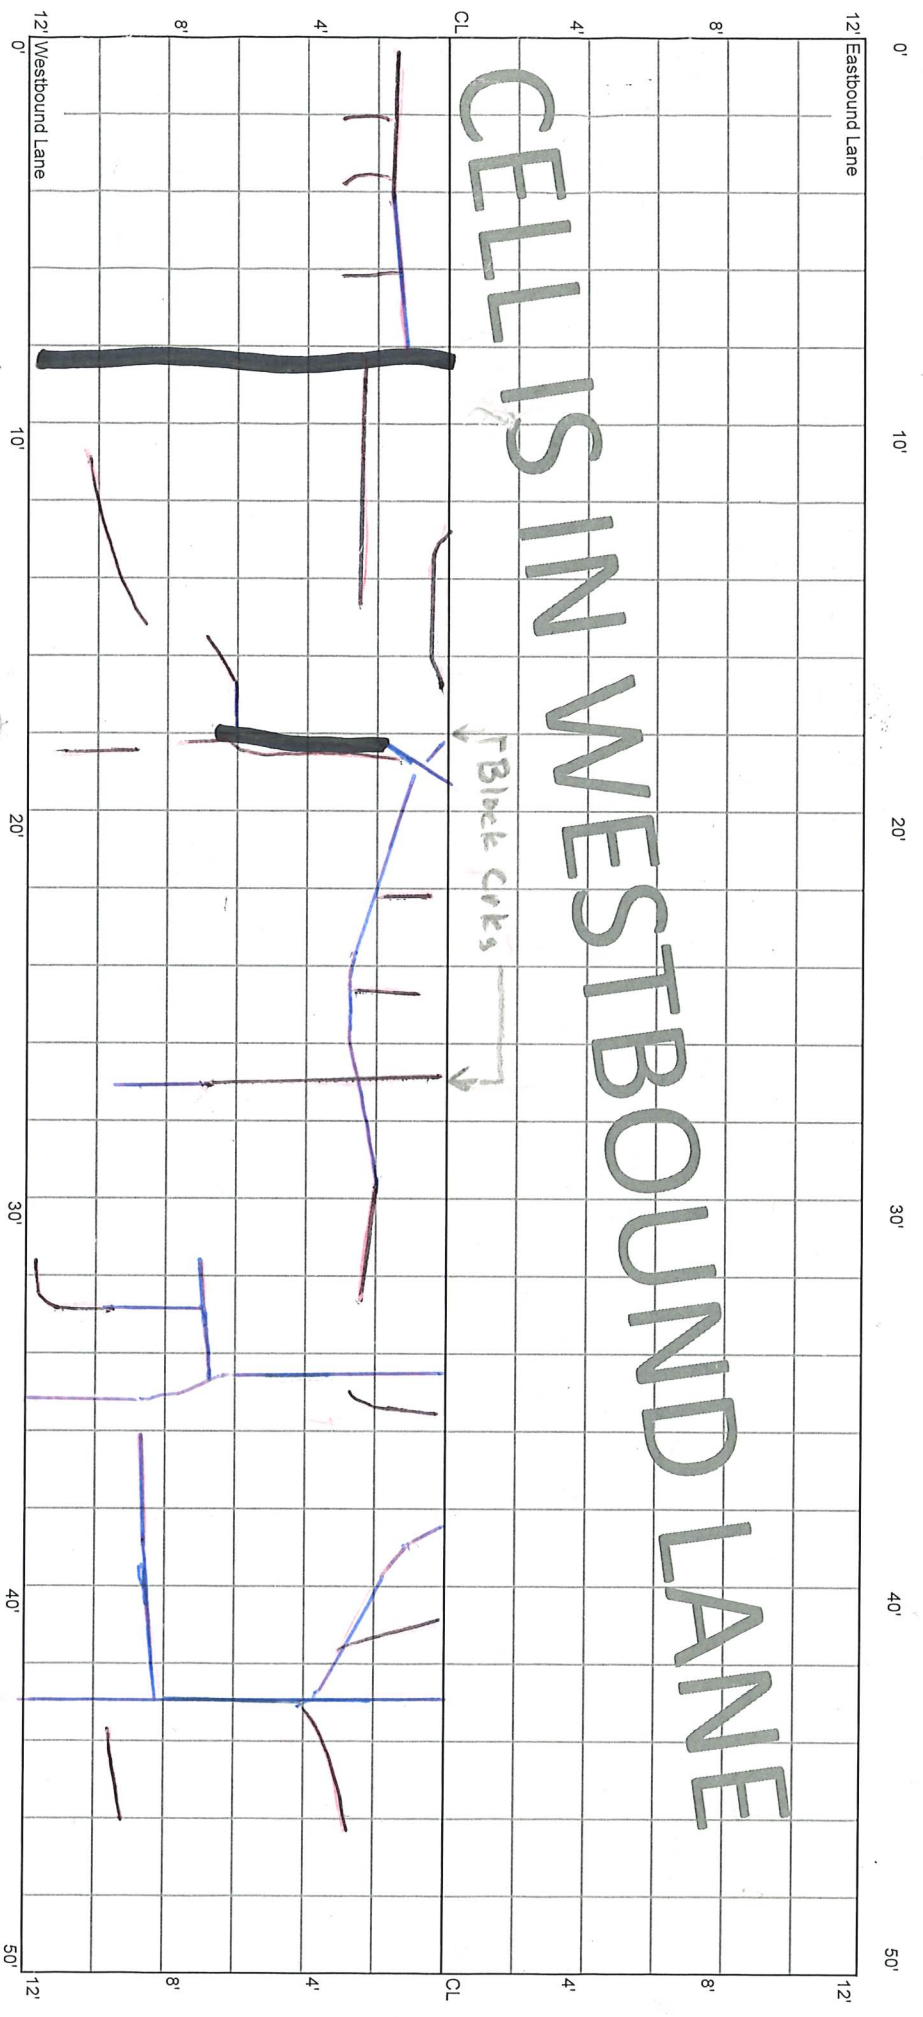

* ROUTE SEAL


* M SPAR

CELL 7005W
50 - 100 ft

26+50

26+00


CELLS IN WESTBOUND LANE

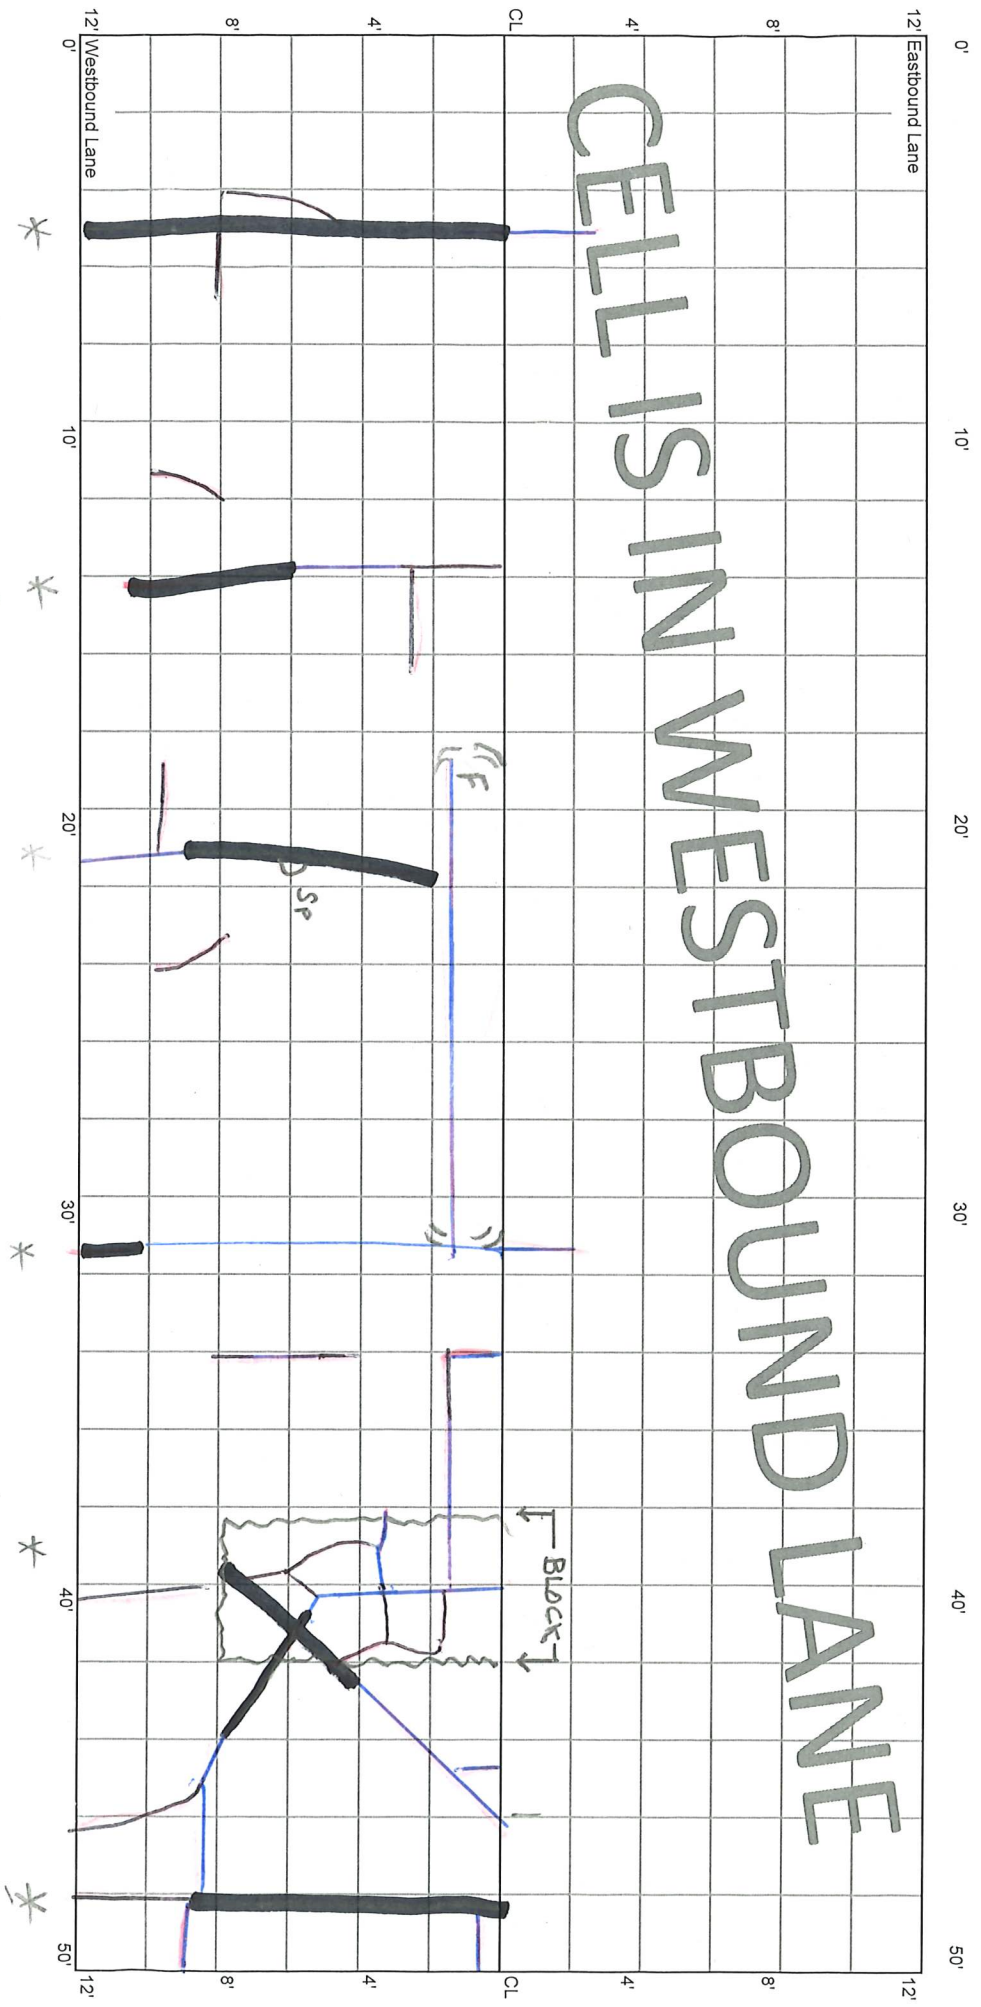

CELL 7005W
100 - 150 ft

26+00

25+50

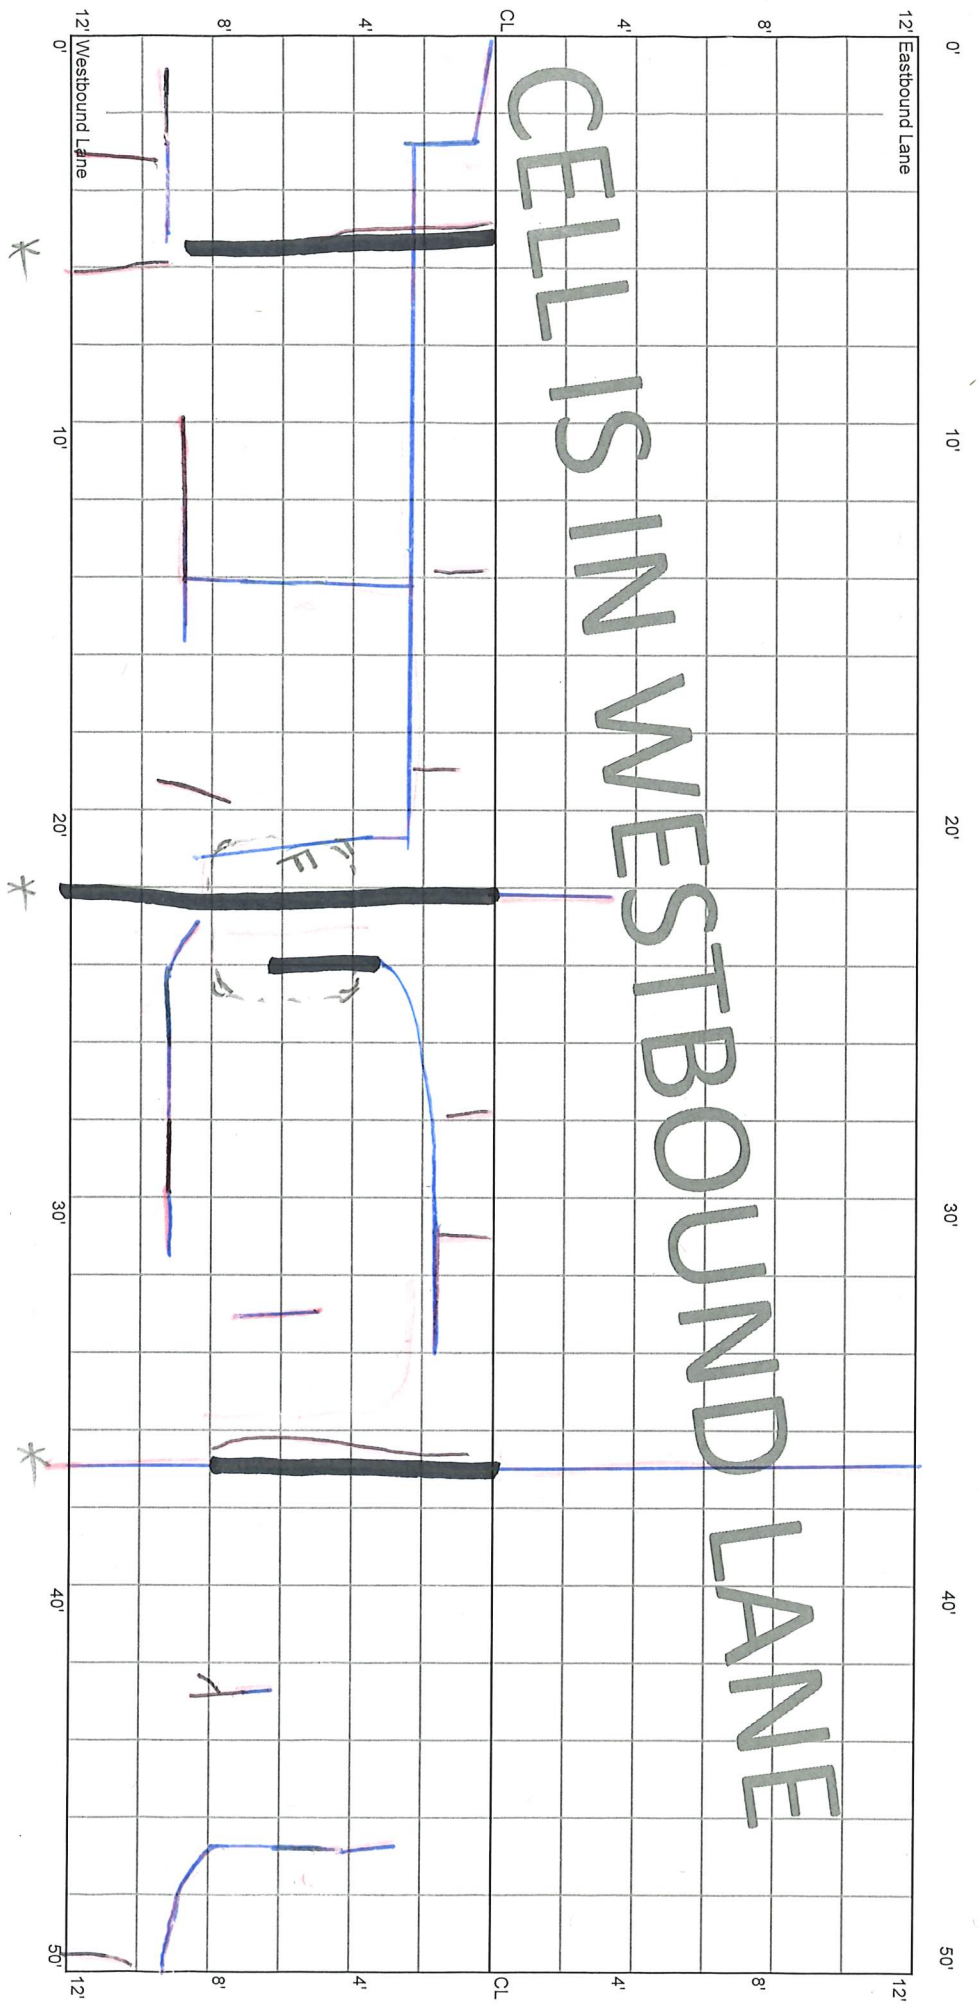

CELL 7005W
150 - 200 ft

25+50

25+00

12' Eastbound Lane

0' 10' 20' 30' 40' 50'

CELL IS IN WESTBOUND LANE

Block 8' WIDE

12' Westbound Lane

0' 10' 20' 30' 40' 50'


*

M

*

* SP


G

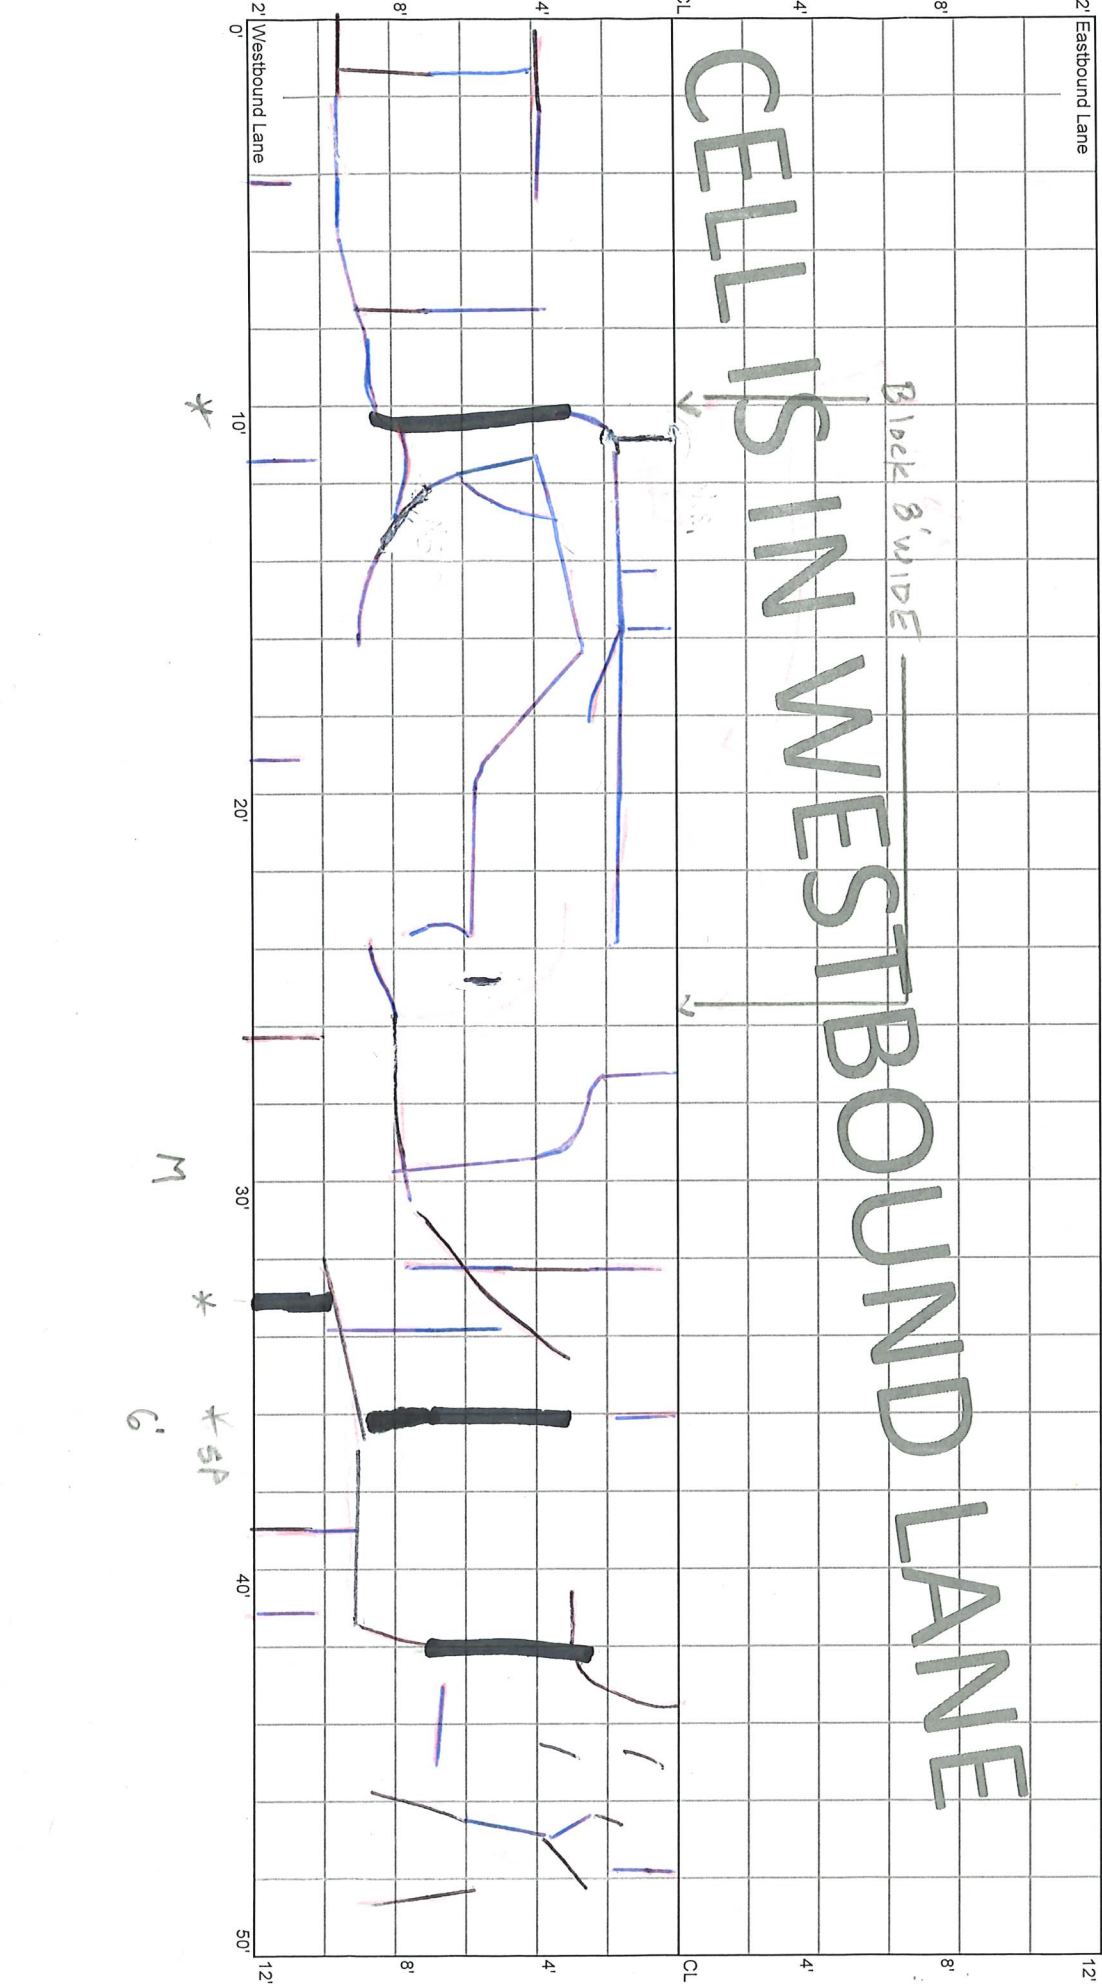

CELL 7005W
200 - 250 ft

25+00


24+50

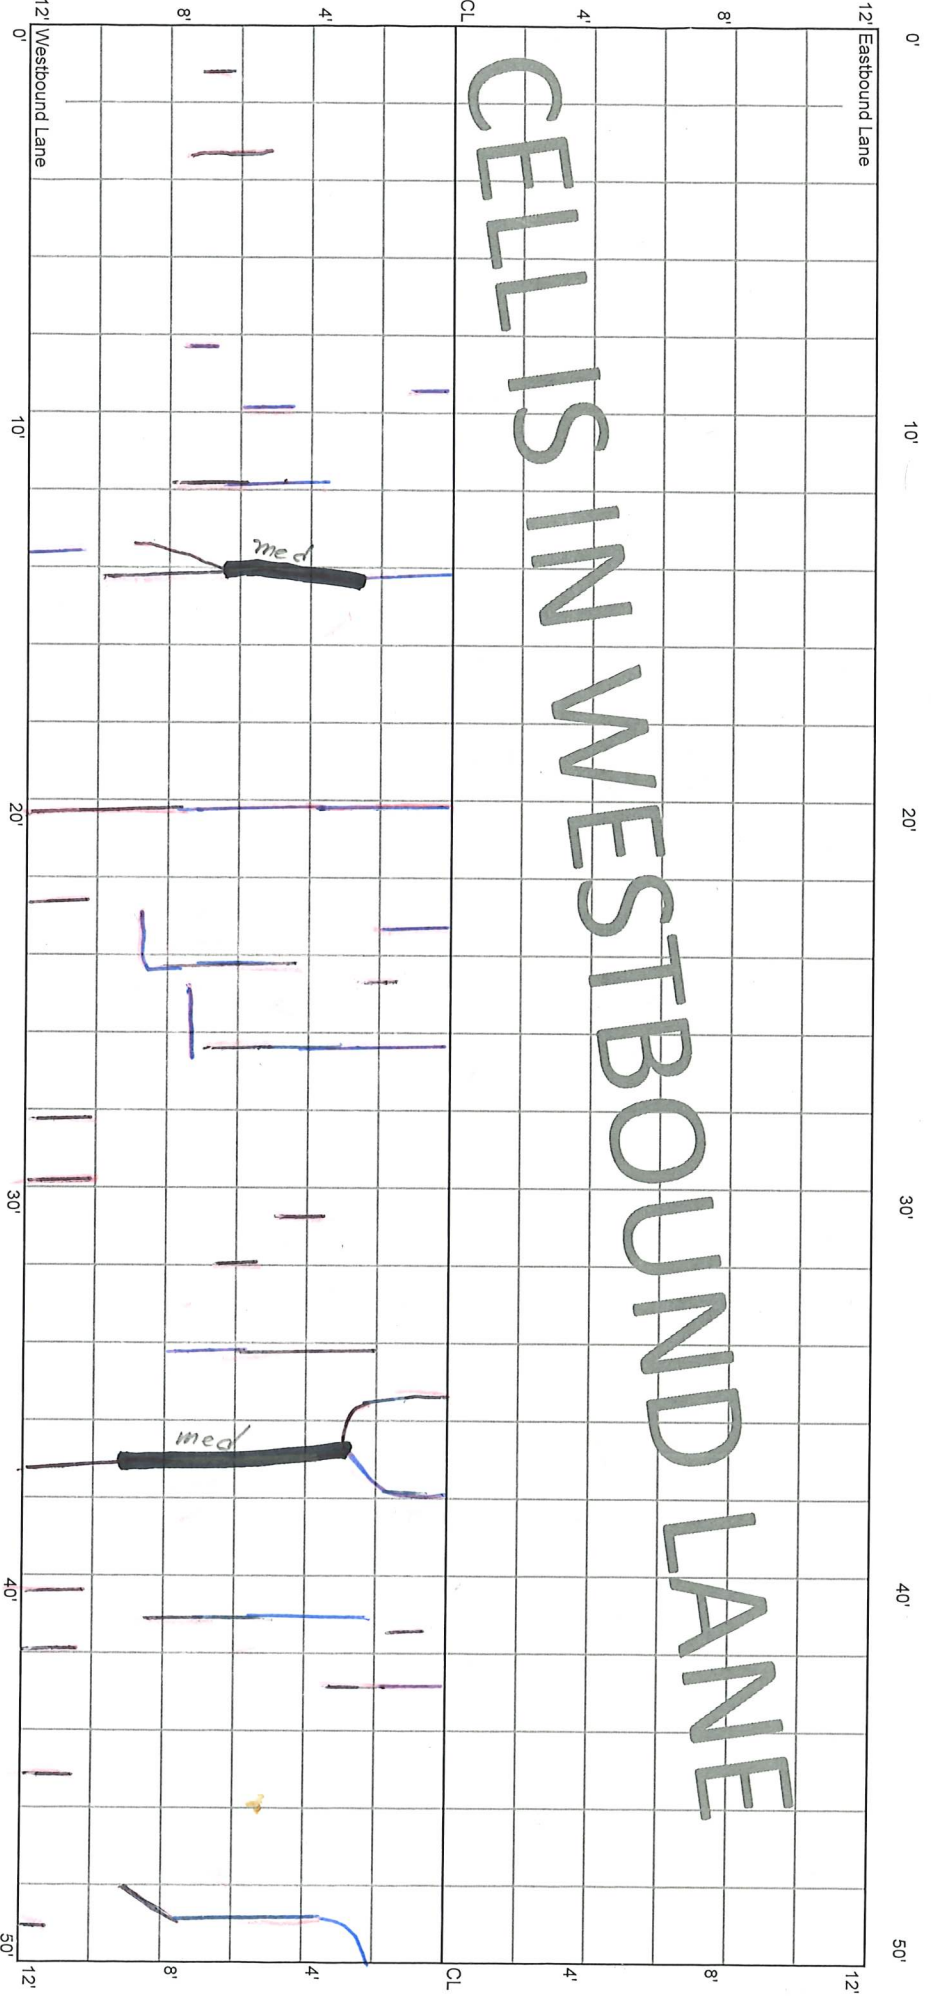

CELL 7005W
250 - 300 ft

24+50

24+00

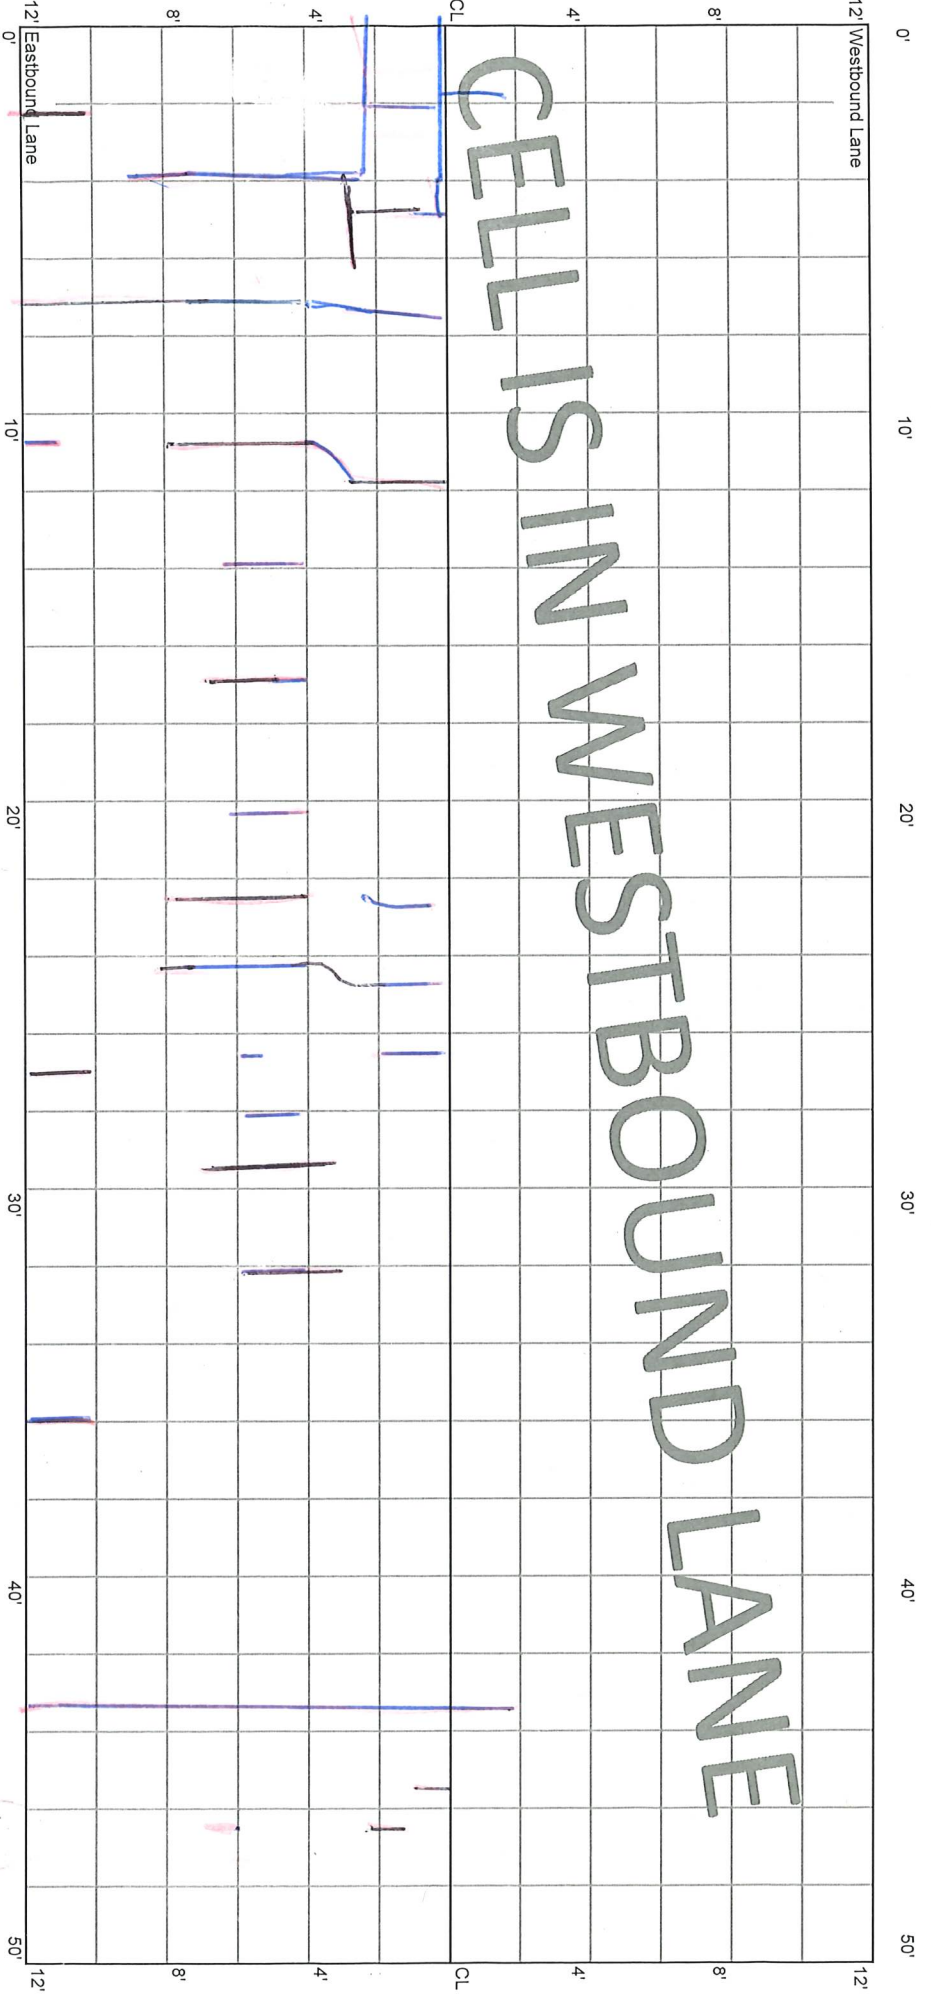

CELL 7005W
300 - 350 ft

24+00

23+50

12' Eastbound Lane

12'

12' Westbound Lane

12'

CL

CL


CELLS IN WESTBOUND LANE

314'

319'

355'


* A.F.

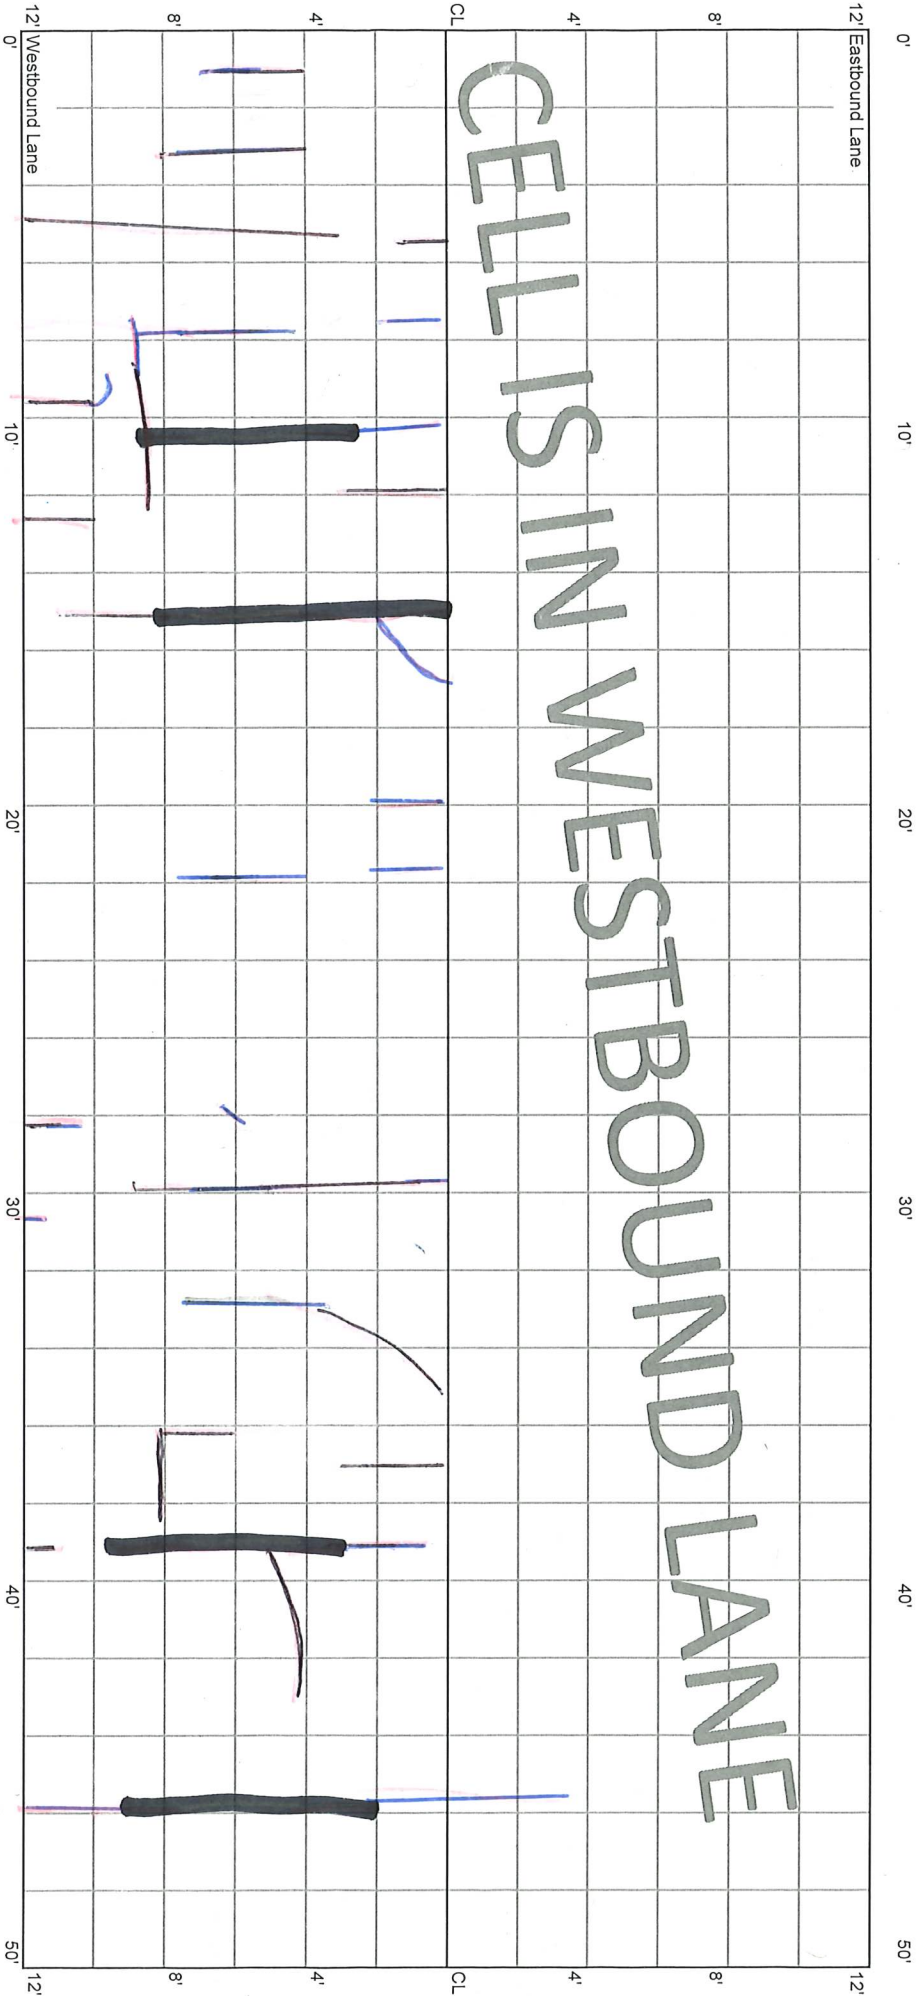

CELL 7005W
350 - 400 ft

23+50

23+00

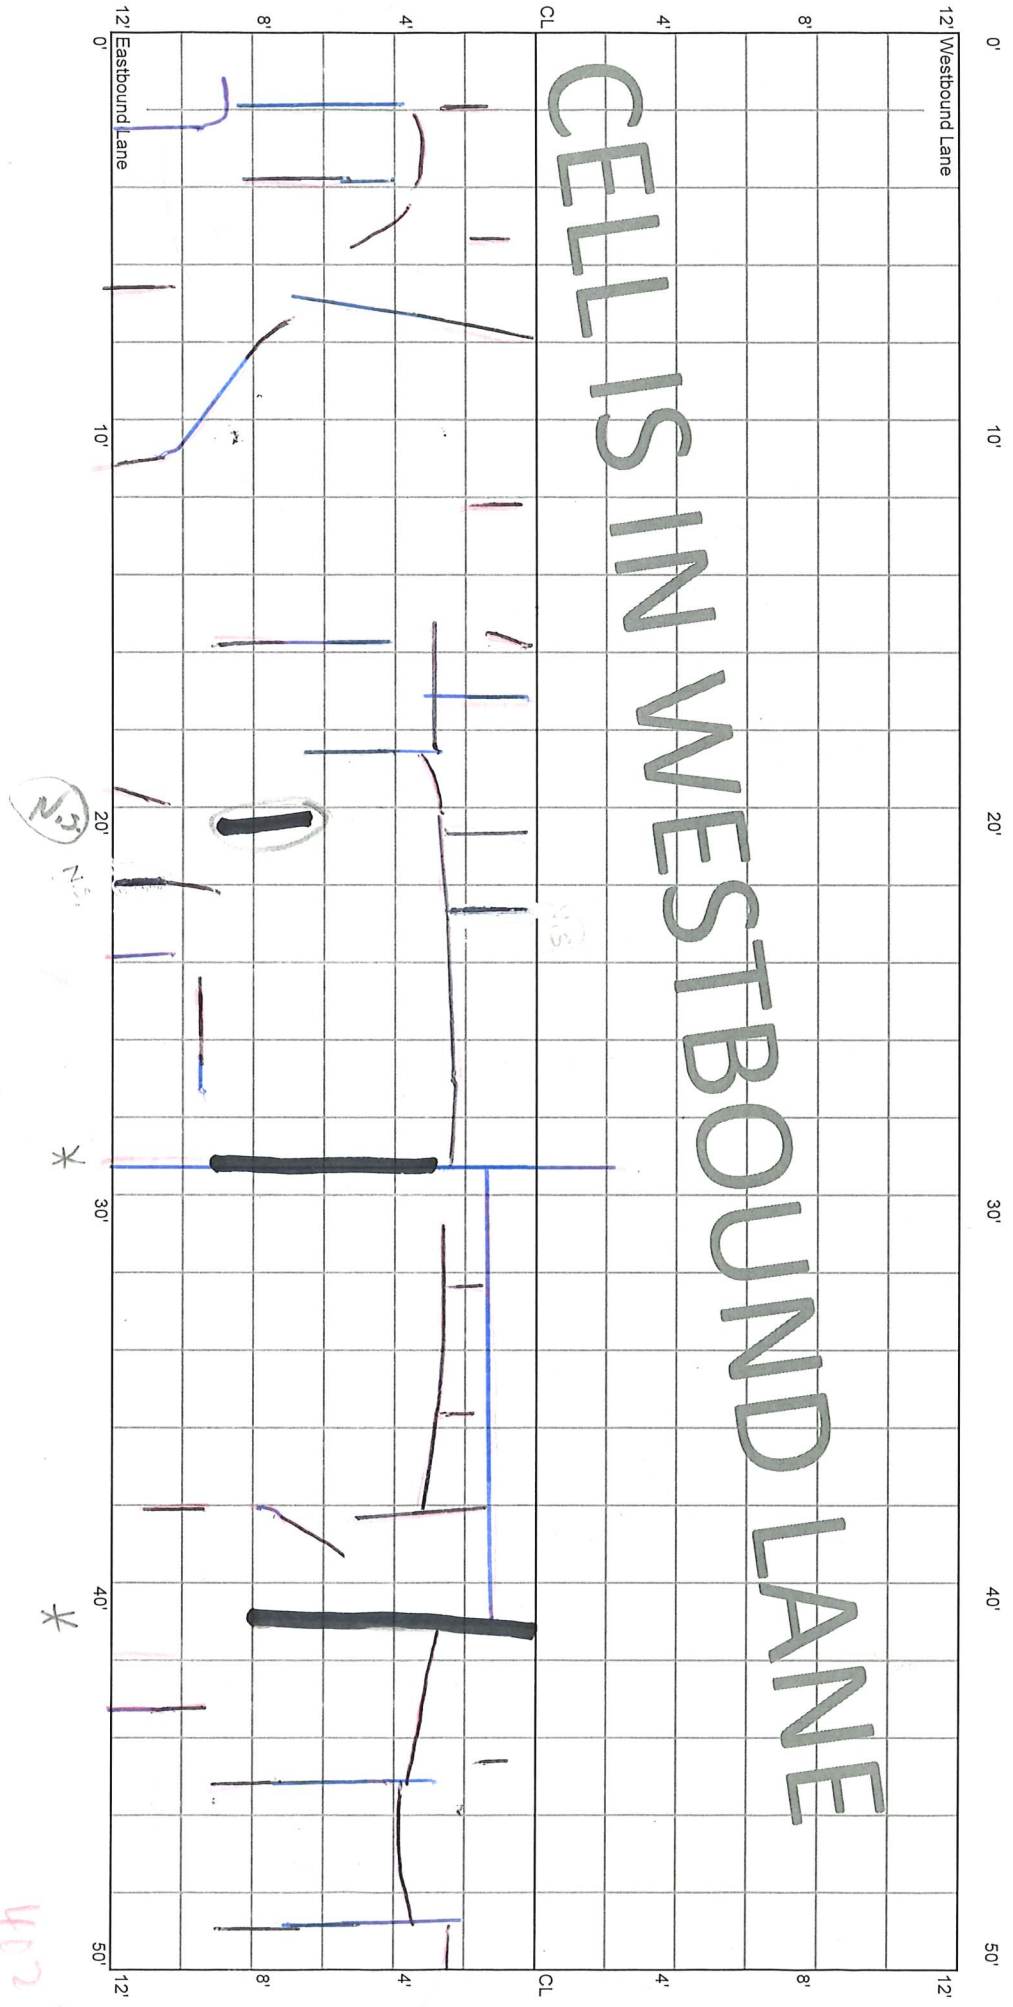

CELLS IN WESTBOUND LANE

N2

402

CELL 7005W
400 - 450 ft

23+00


22+50

12' Eastbound Lane

12'

0' 10' 20' 30' 40' 50'

CELLS IN WESTBOUND LANE

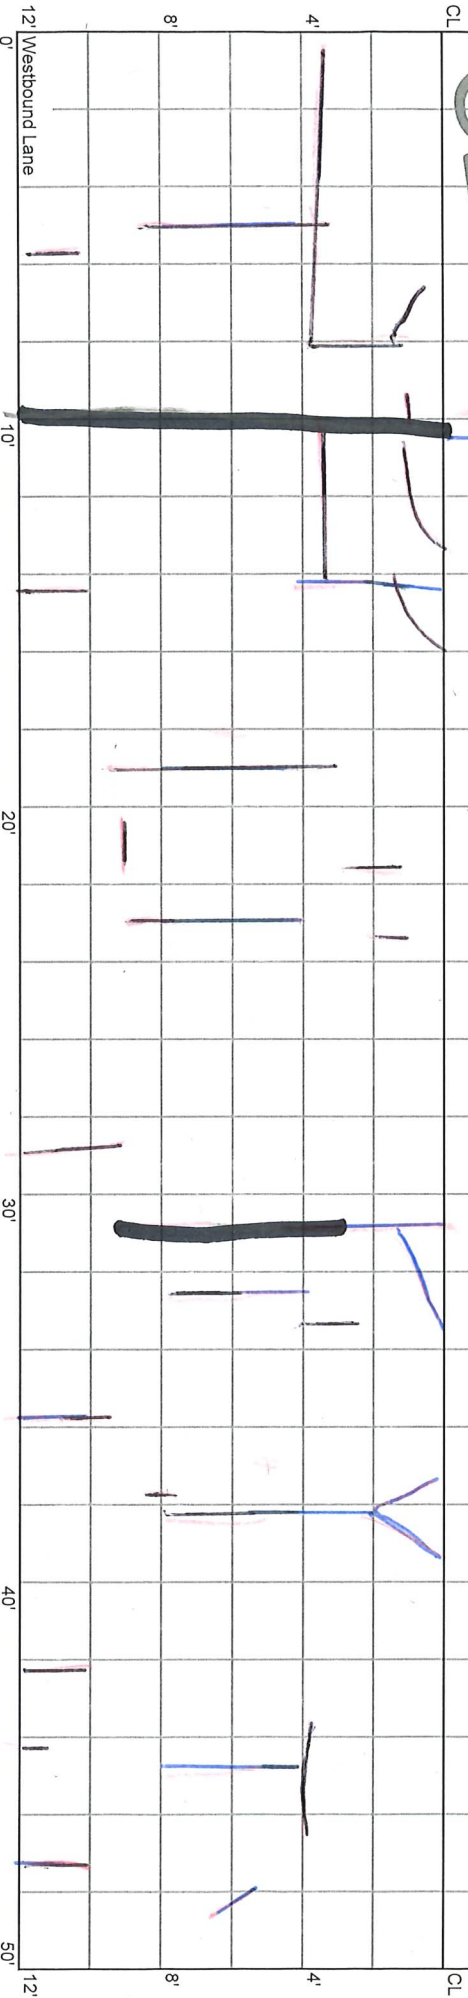

12' Westbound Lane

12'

* A.F.


*

CELL 7005W
450 - 500 ft

22+50

22+00

0' 10' 20' 30' 40' 50'

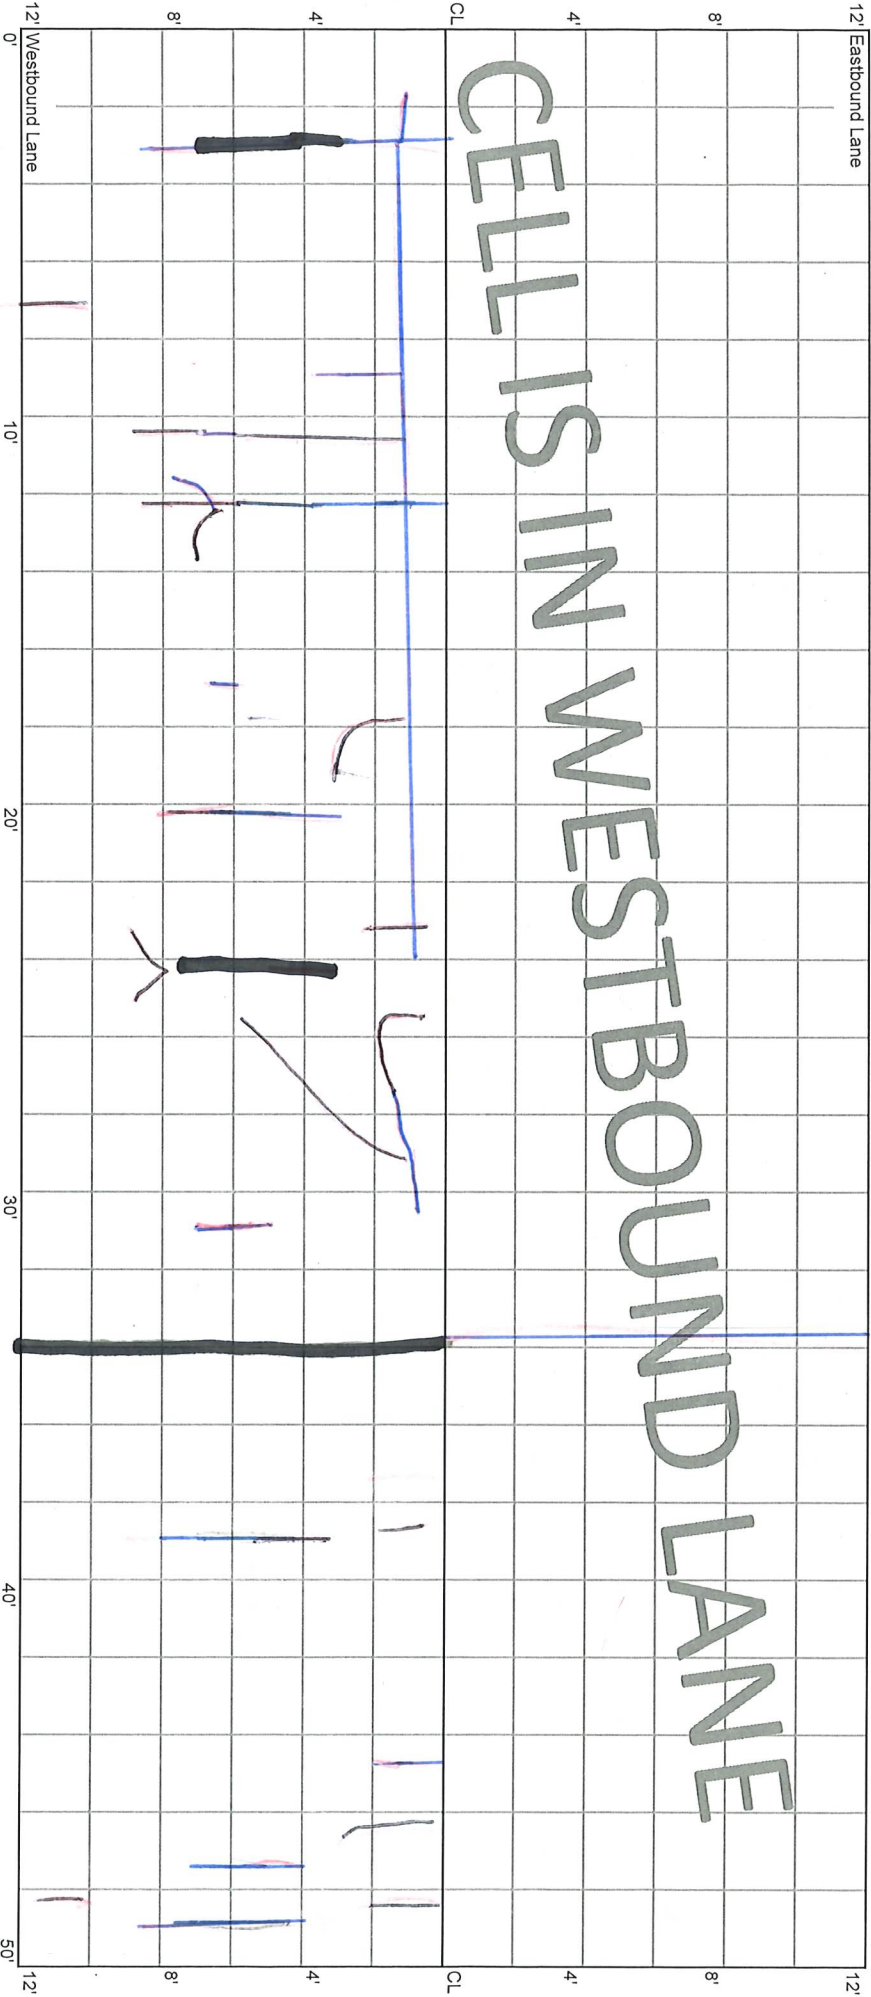

CELLS IN WESTBOUND LANE

N' road

AF.

M

CELL 7005W
500 - 550 ft

22+00

21+75

21+50

0' 10' 20' 25' 30' 40' 50'

12' Eastbound Lane

8' 4' CL 4' 8'

CELLS IN WESTBOUND LANE

4' CL 4' 8'

END RATING: BEGIN TRANSITION TO
NEXT CELL

12' Westbound Lane 0' 10' 20' 25' 30' 40' 50'