

5.28.20 E.J.

10.14.20 | 1.12.22
1.4.21 | 8.31.22
File 70TH ST | 1.26.23
9.15.21


CELL 7015 W
CELL 7005W
0 - 50 ft

27+00

26+58
CL KITTRIDGE

26+50

0' 10' 20' 30' 40' 50'

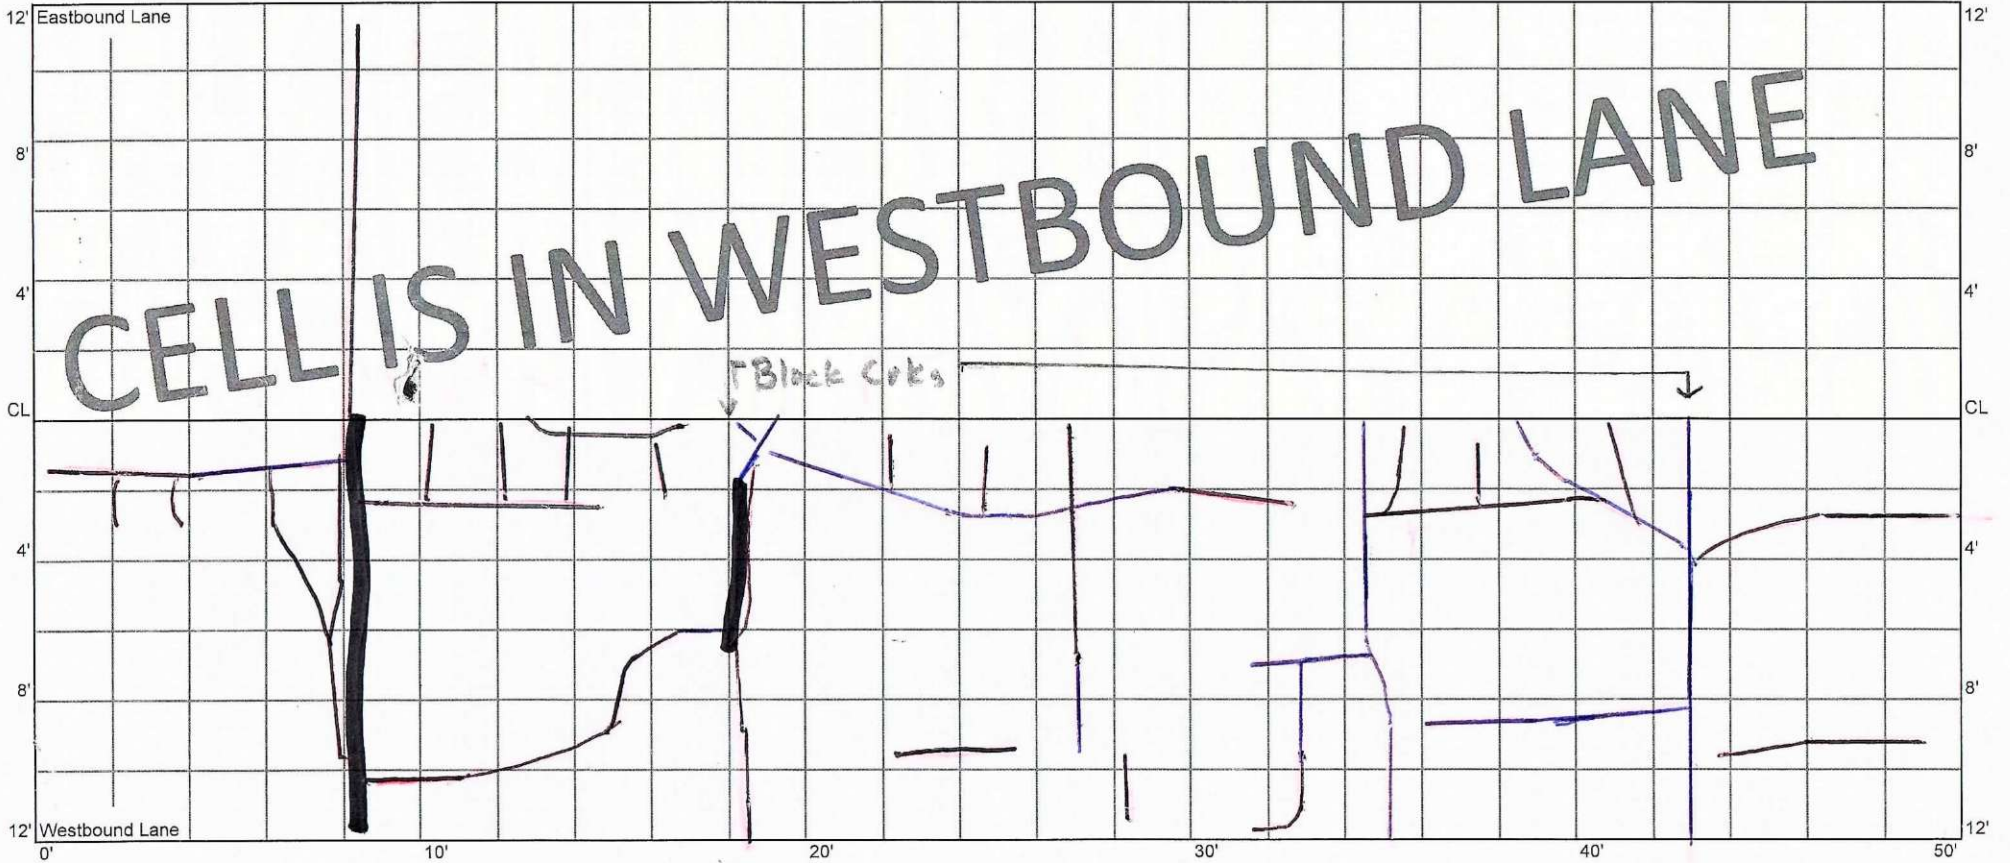


* ROUTE SEAL
* M SP. AF.

CL inside 50'

CELL 7005W
50 - 100 ft

26+50


26+00

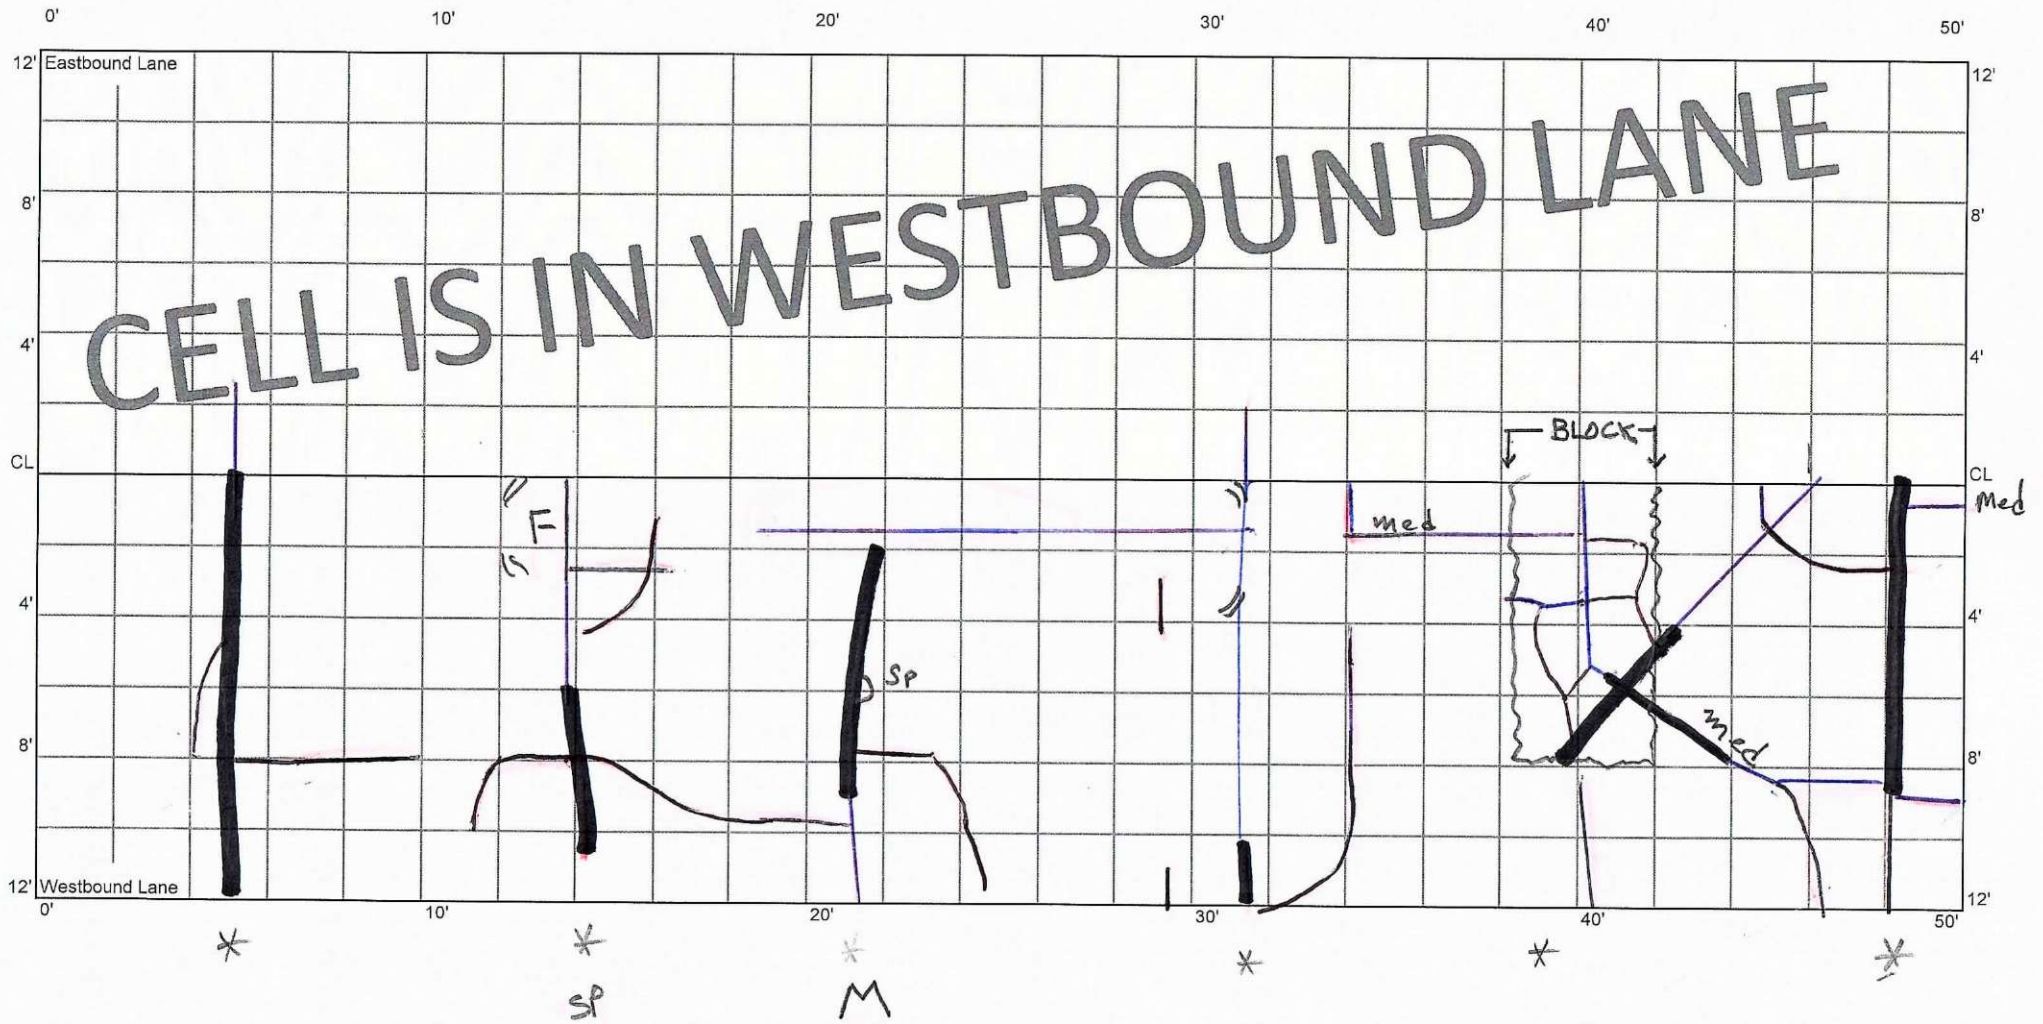

CELL 7005W
100 - 150 ft

26+00


25+50

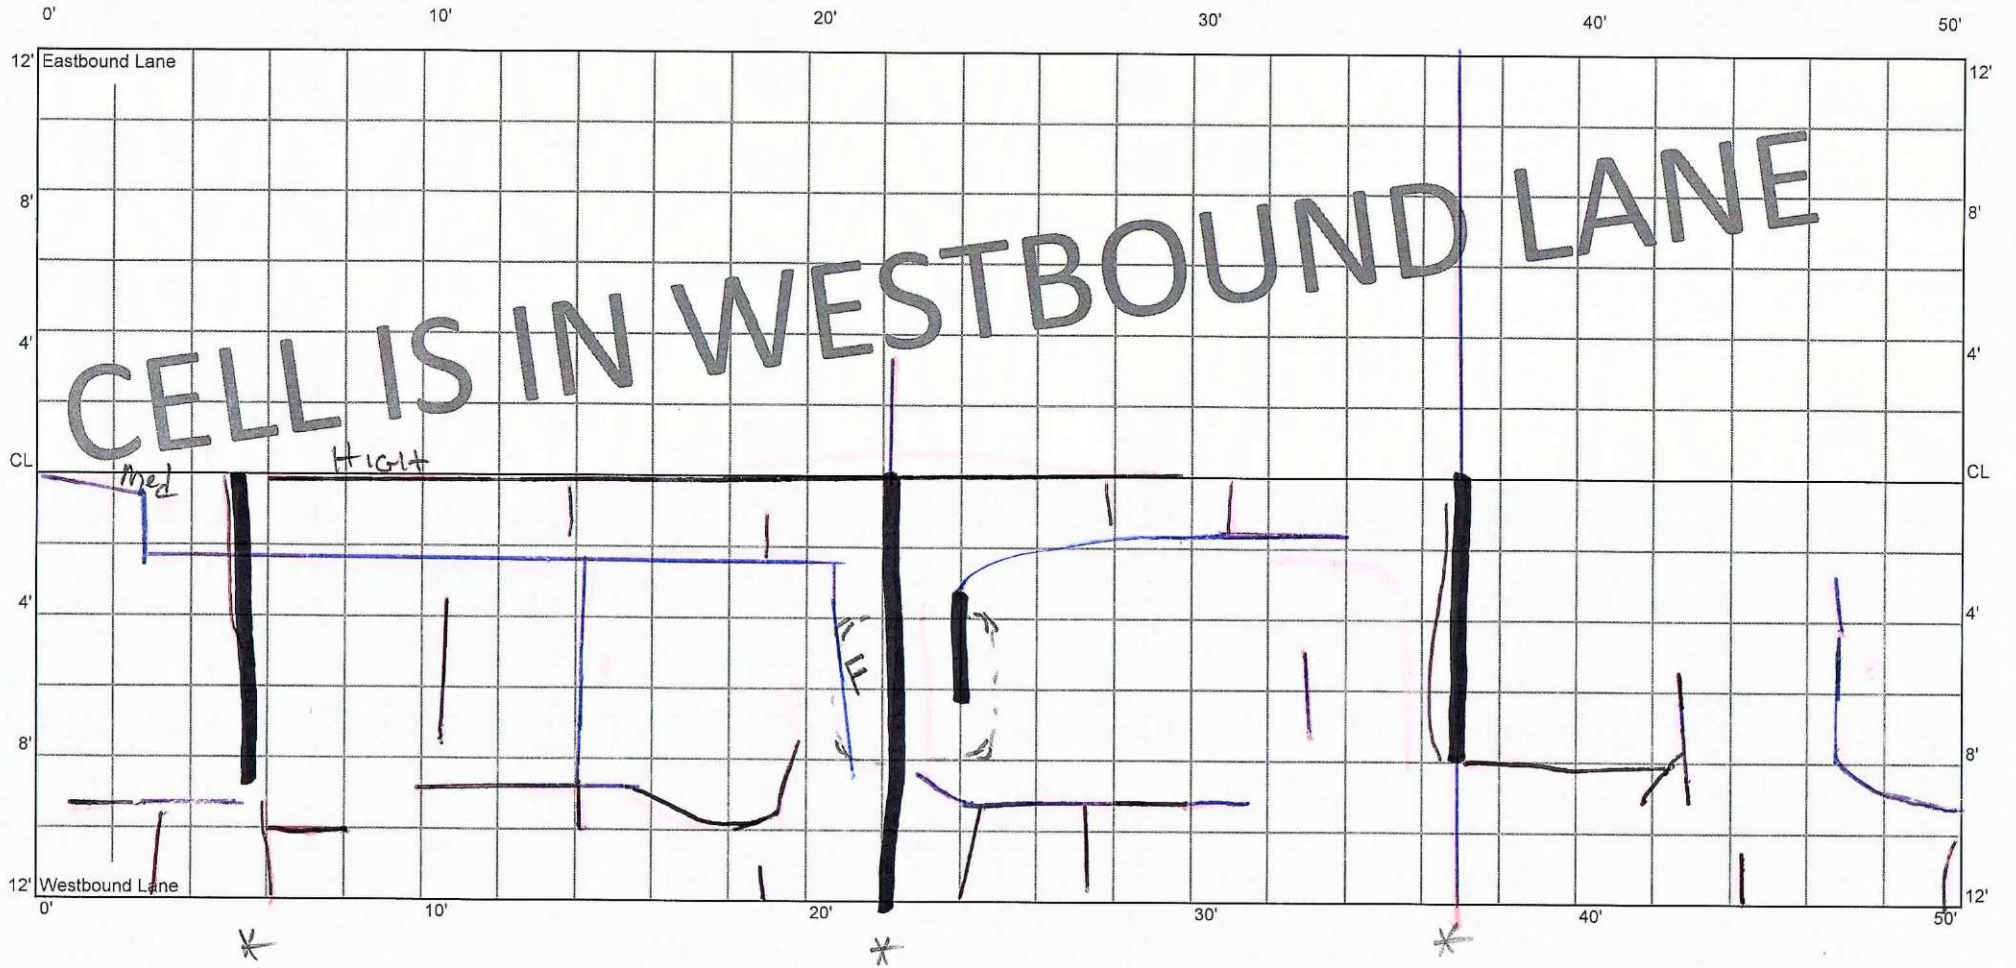

CELL 7005W
150 - 200 ft

25+50


25+00

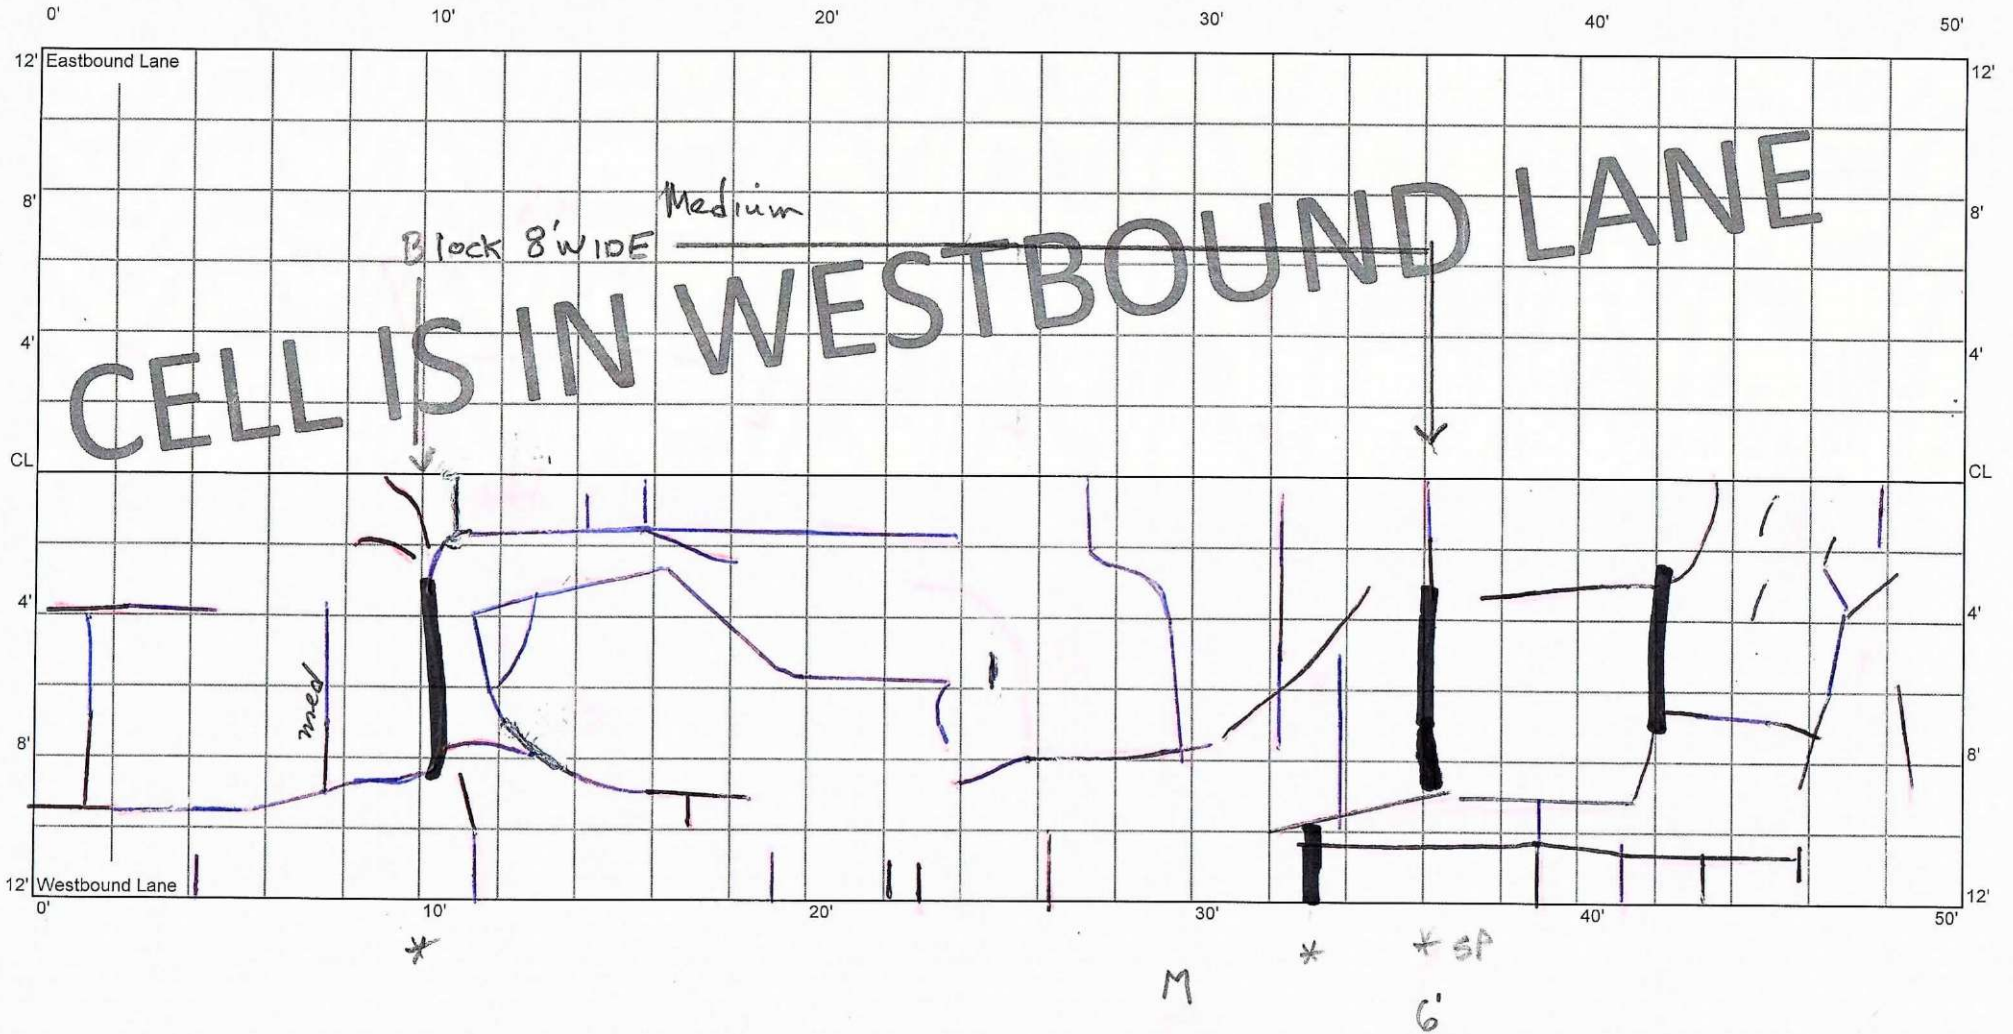

CELL 7005W
200 - 250 ft

25+00


24+50

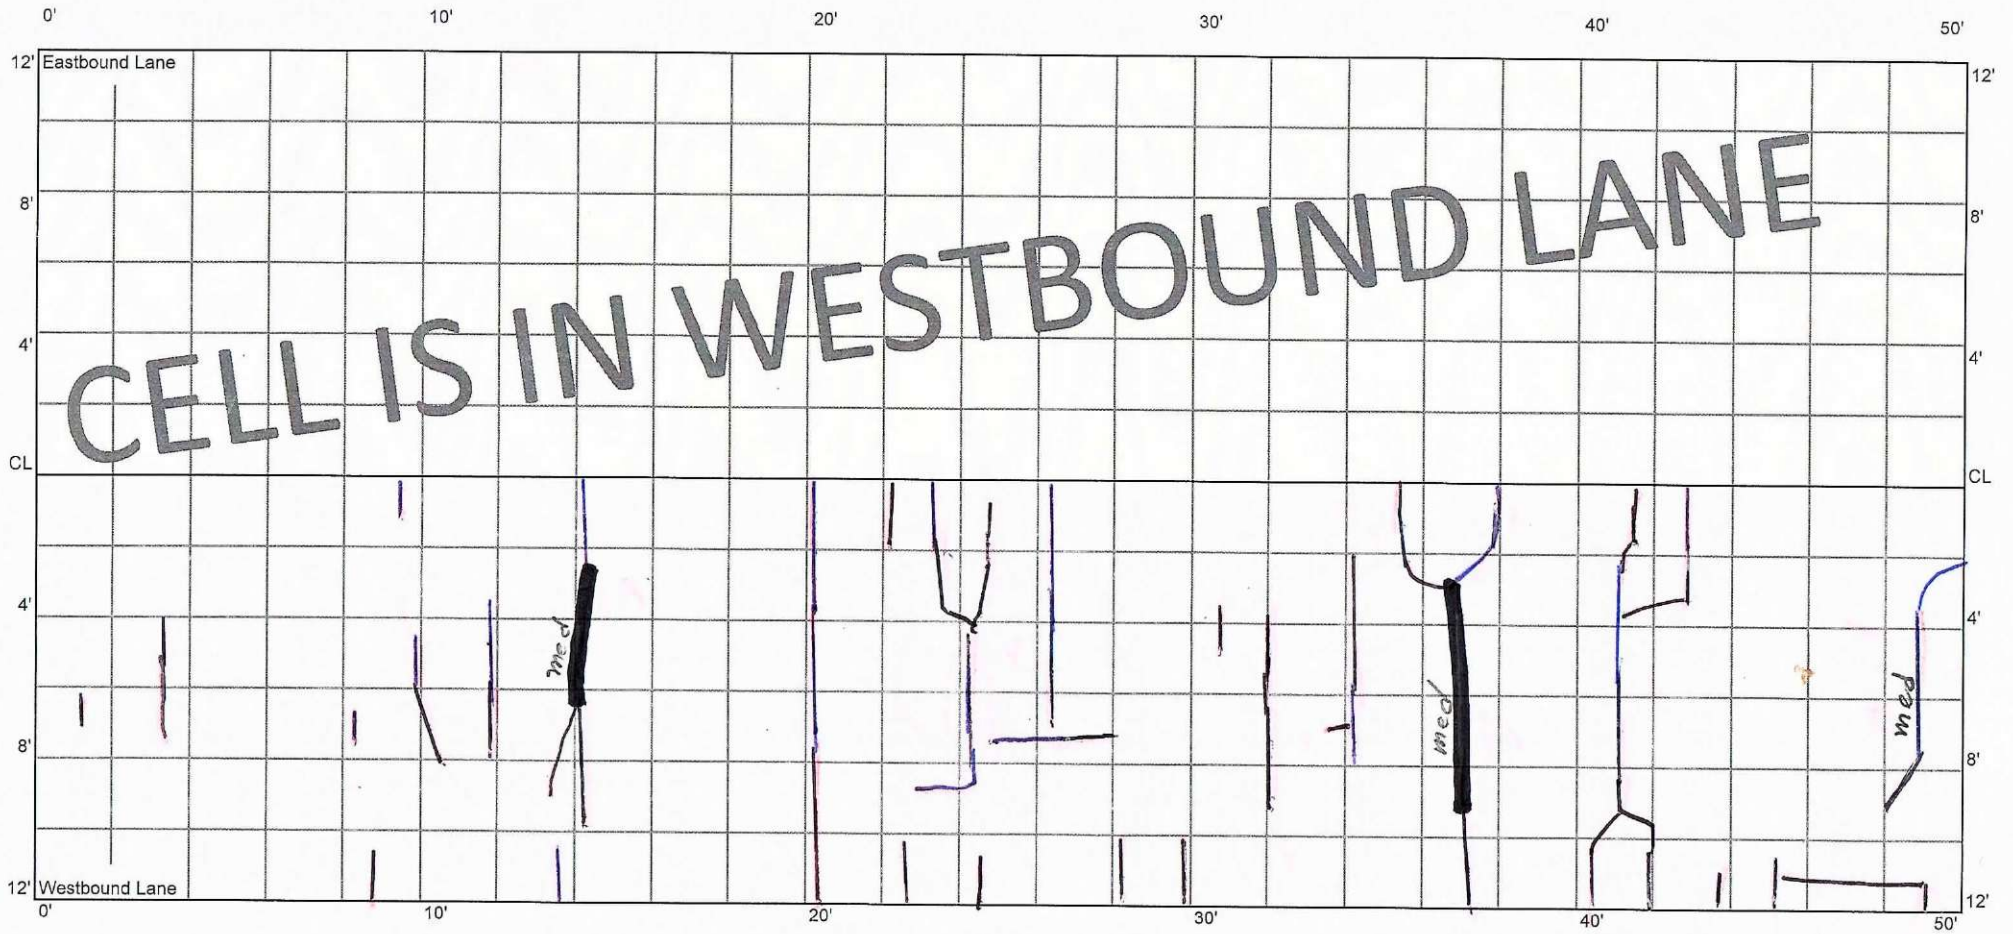

CELL 7005W
250 - 300 ft

24+50

24+00

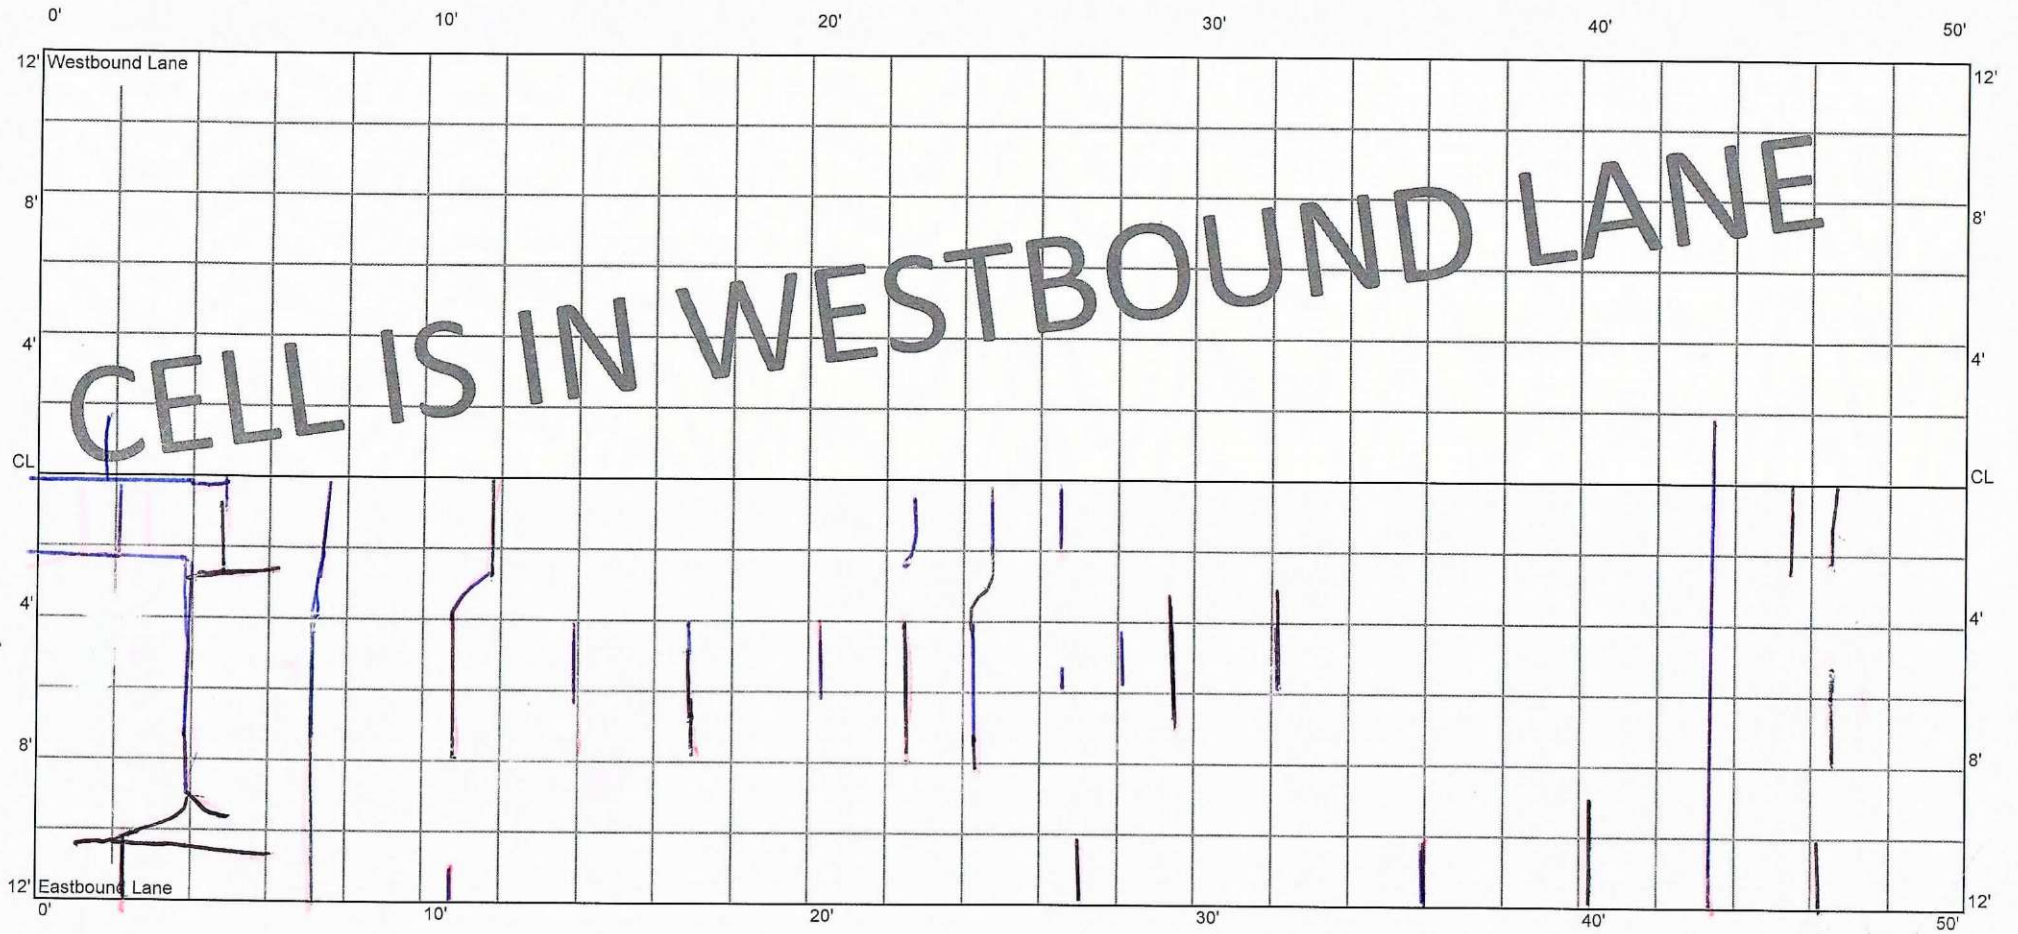

M

CELL 7005W
300 - 350 ft

24+00

23+50

0' 10' 20' 30' 40' 50'



314'

319'


M

* A.F.
350'

CELL 7005W
350 - 400 ft

23+50

23+00

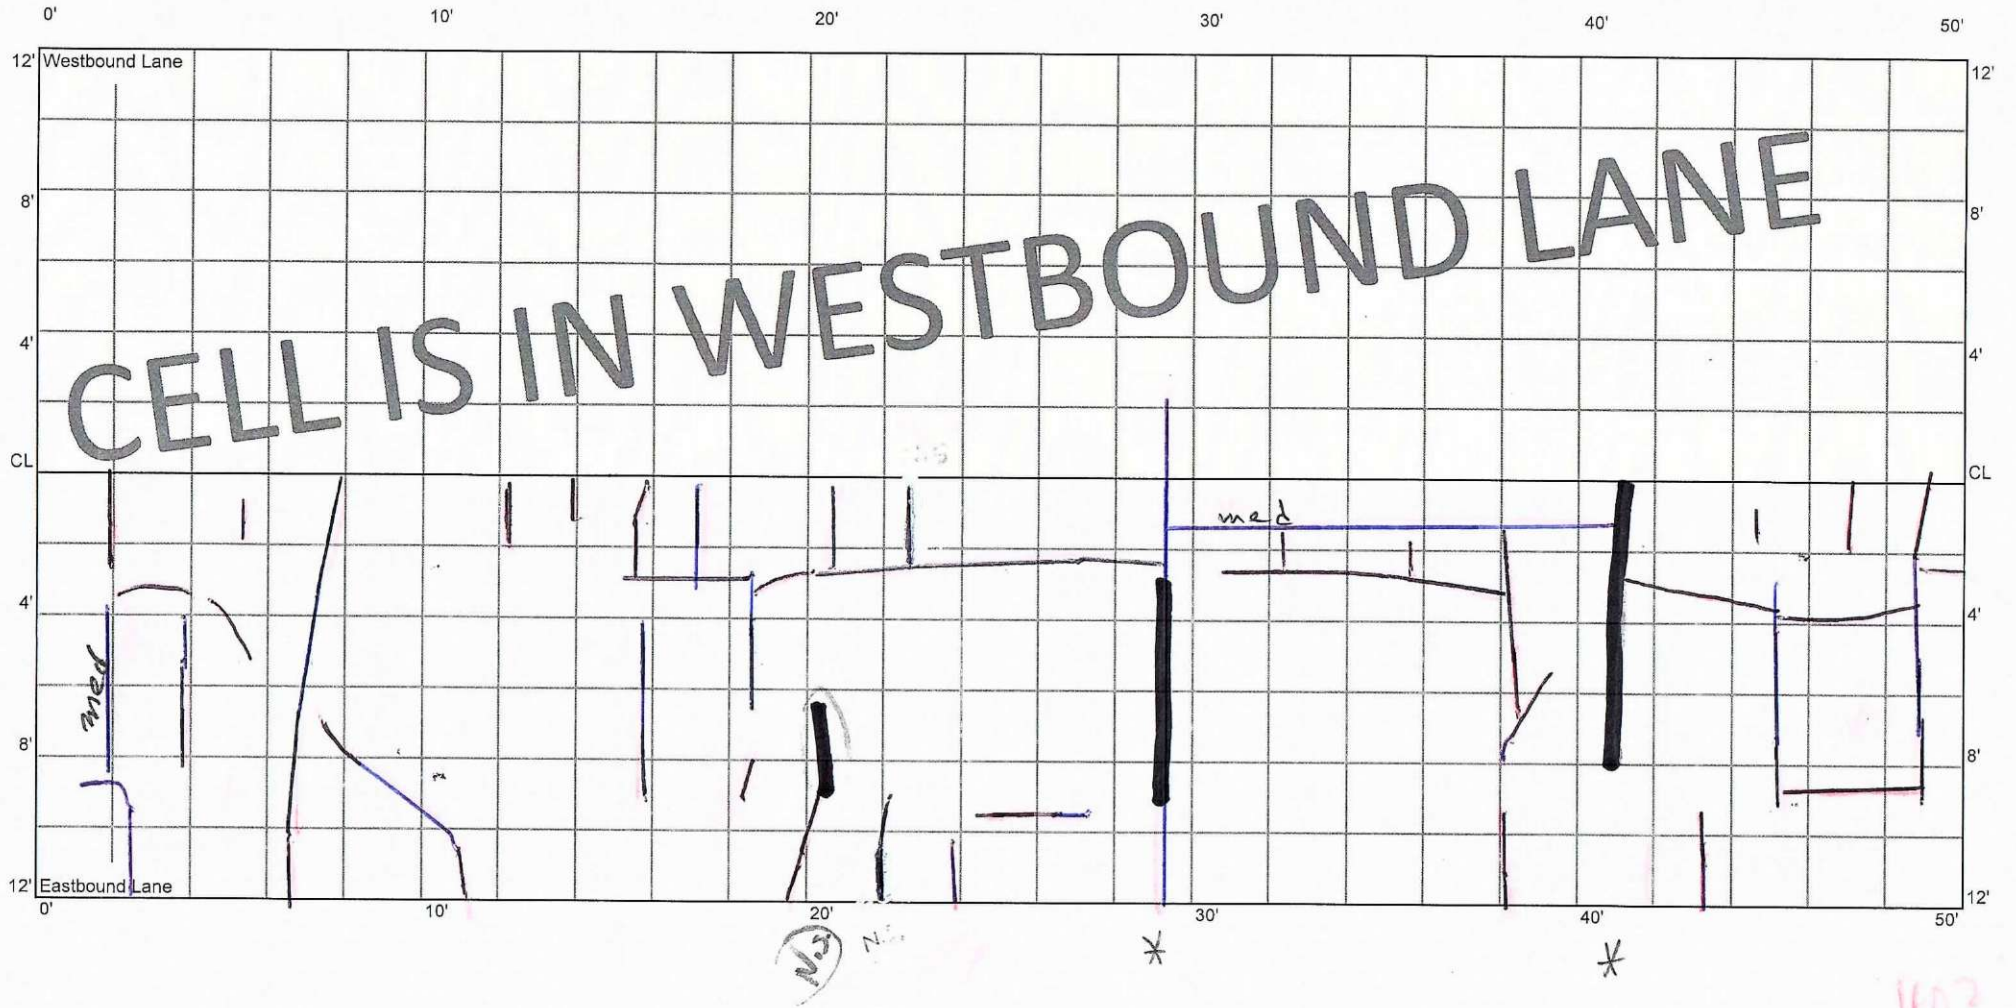


402

CELL 7005W
400 - 450 ft

23+00


22+50

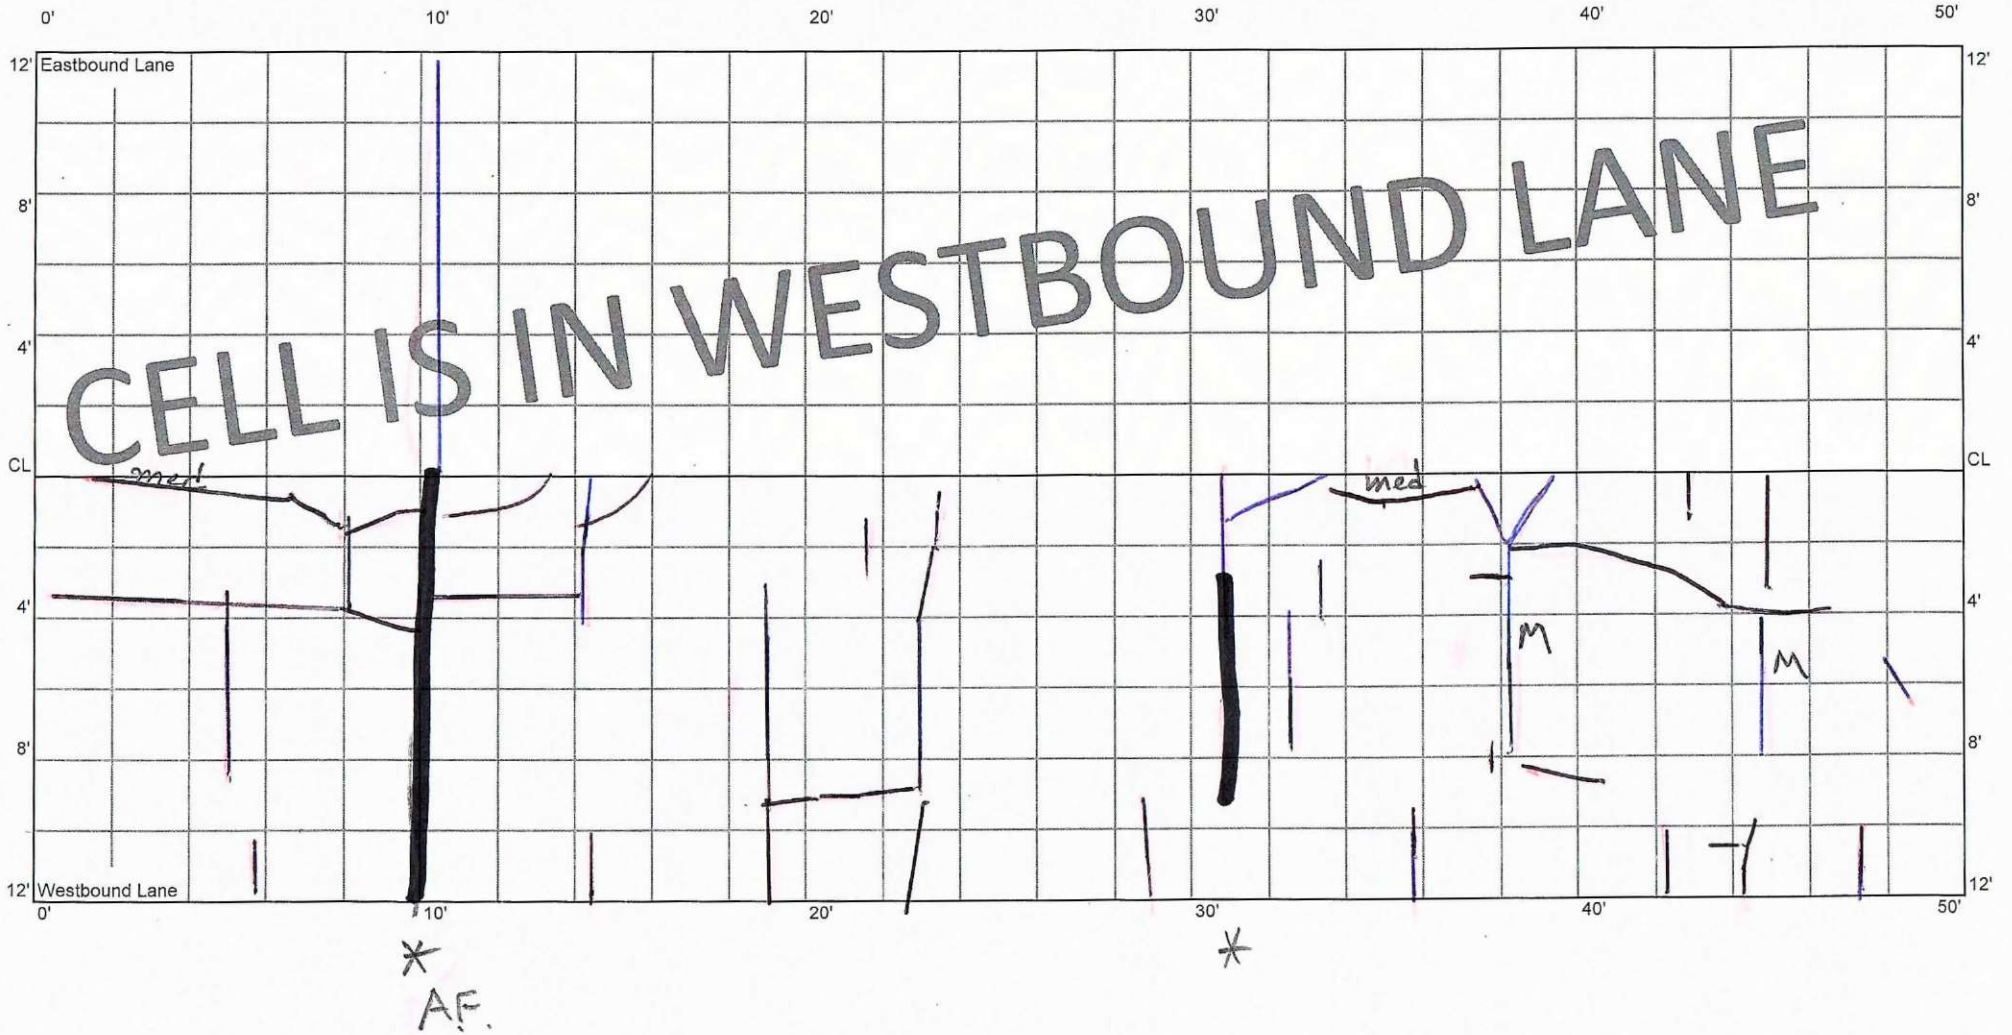

CELL 7005W
450 - 500 ft

22+50

22+00

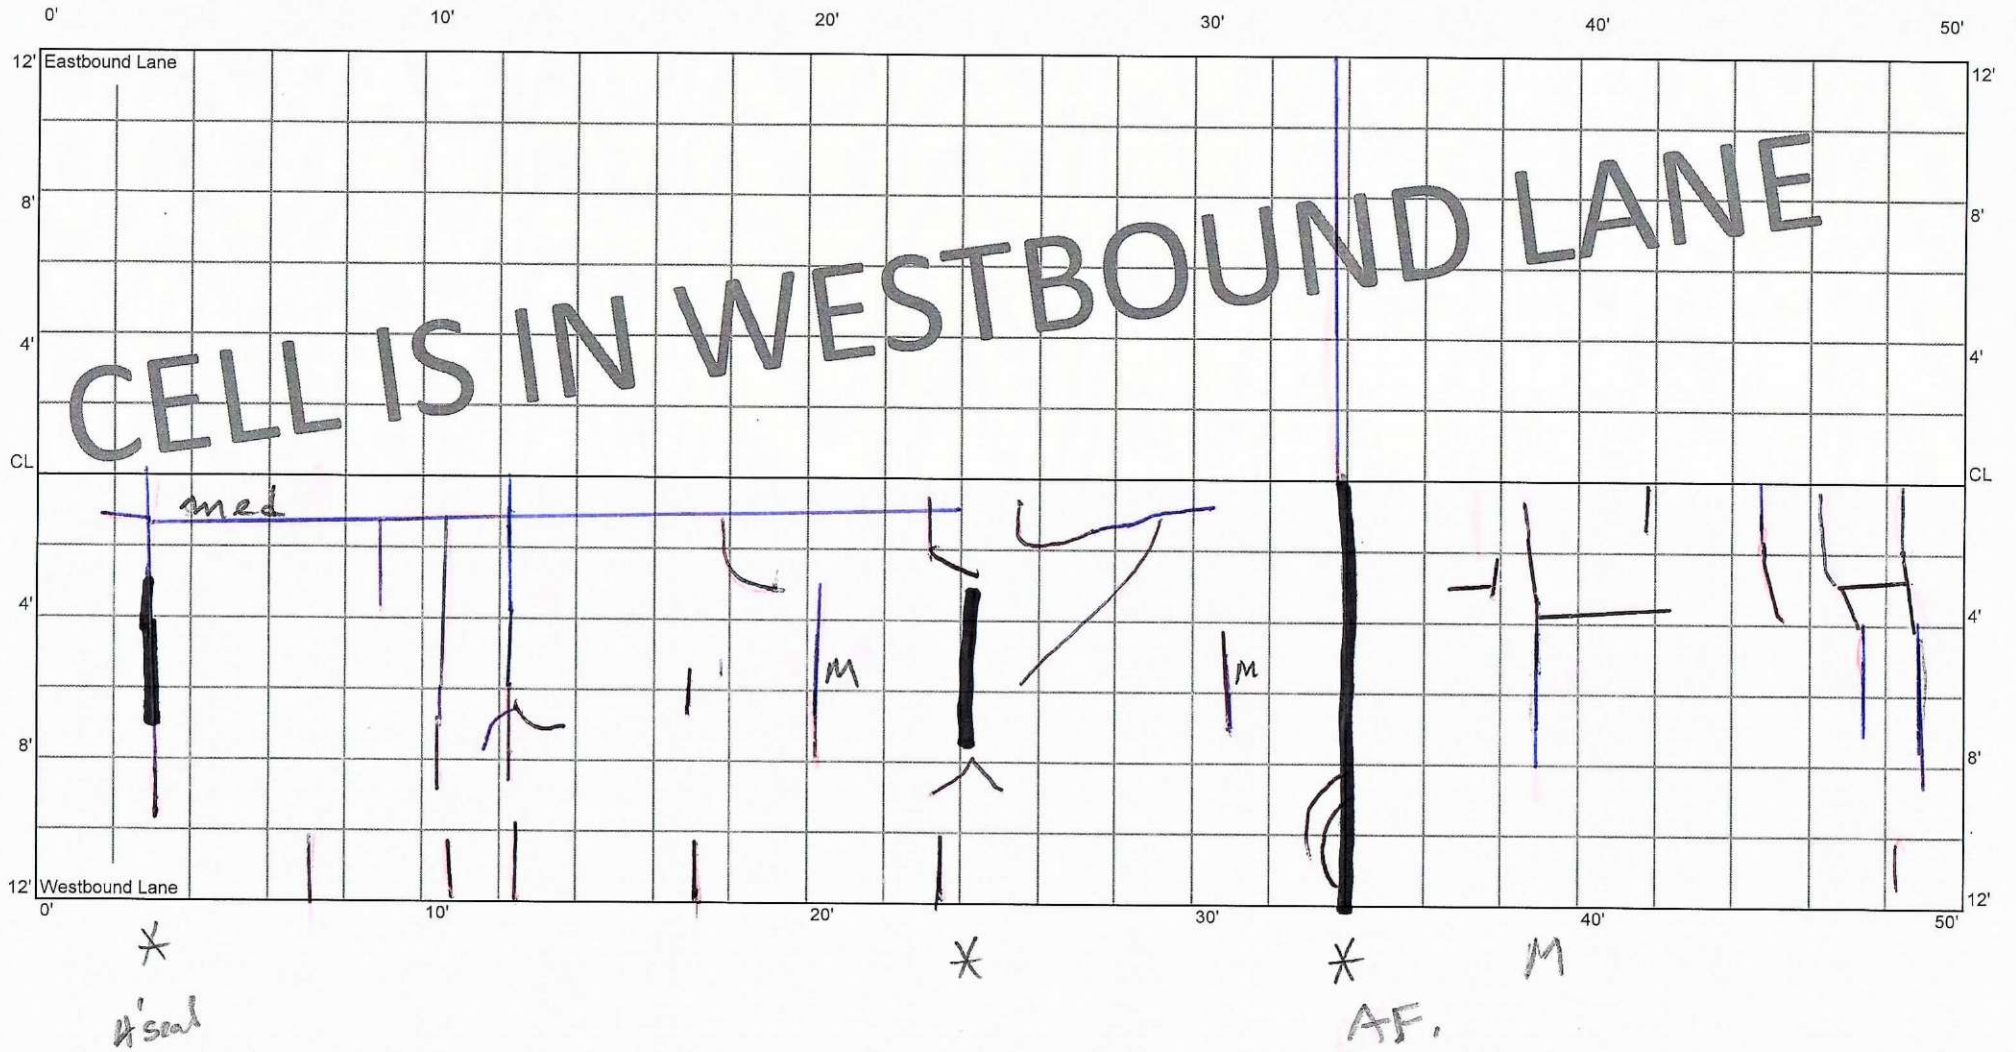

CELL 7005W
500 - 550 ft

22+00

21+75

21+50

0'

10'

20'

25'

30'

40'

50'

12' Eastbound Lane

12'

8'

8'

4'

4'

CL

CL

4'

4'

8'

8'

12' Westbound Lane

12'

0'

10'

20'

25'

30'

40'

50'

END RATING: BEGIN TRANSITION TO
NEXT CELL

CELL IS IN WESTBOUND LANE