


8.25.21 - 35 Trans. cracks outside
Fog line.

5.28.20 E.J. - No Distress
10.14.20 - No Distress
1.14.21 - No Distress
8.25.21 | 1.13.22

CELL 7006W
0 - 50 ft

32+50


32+00

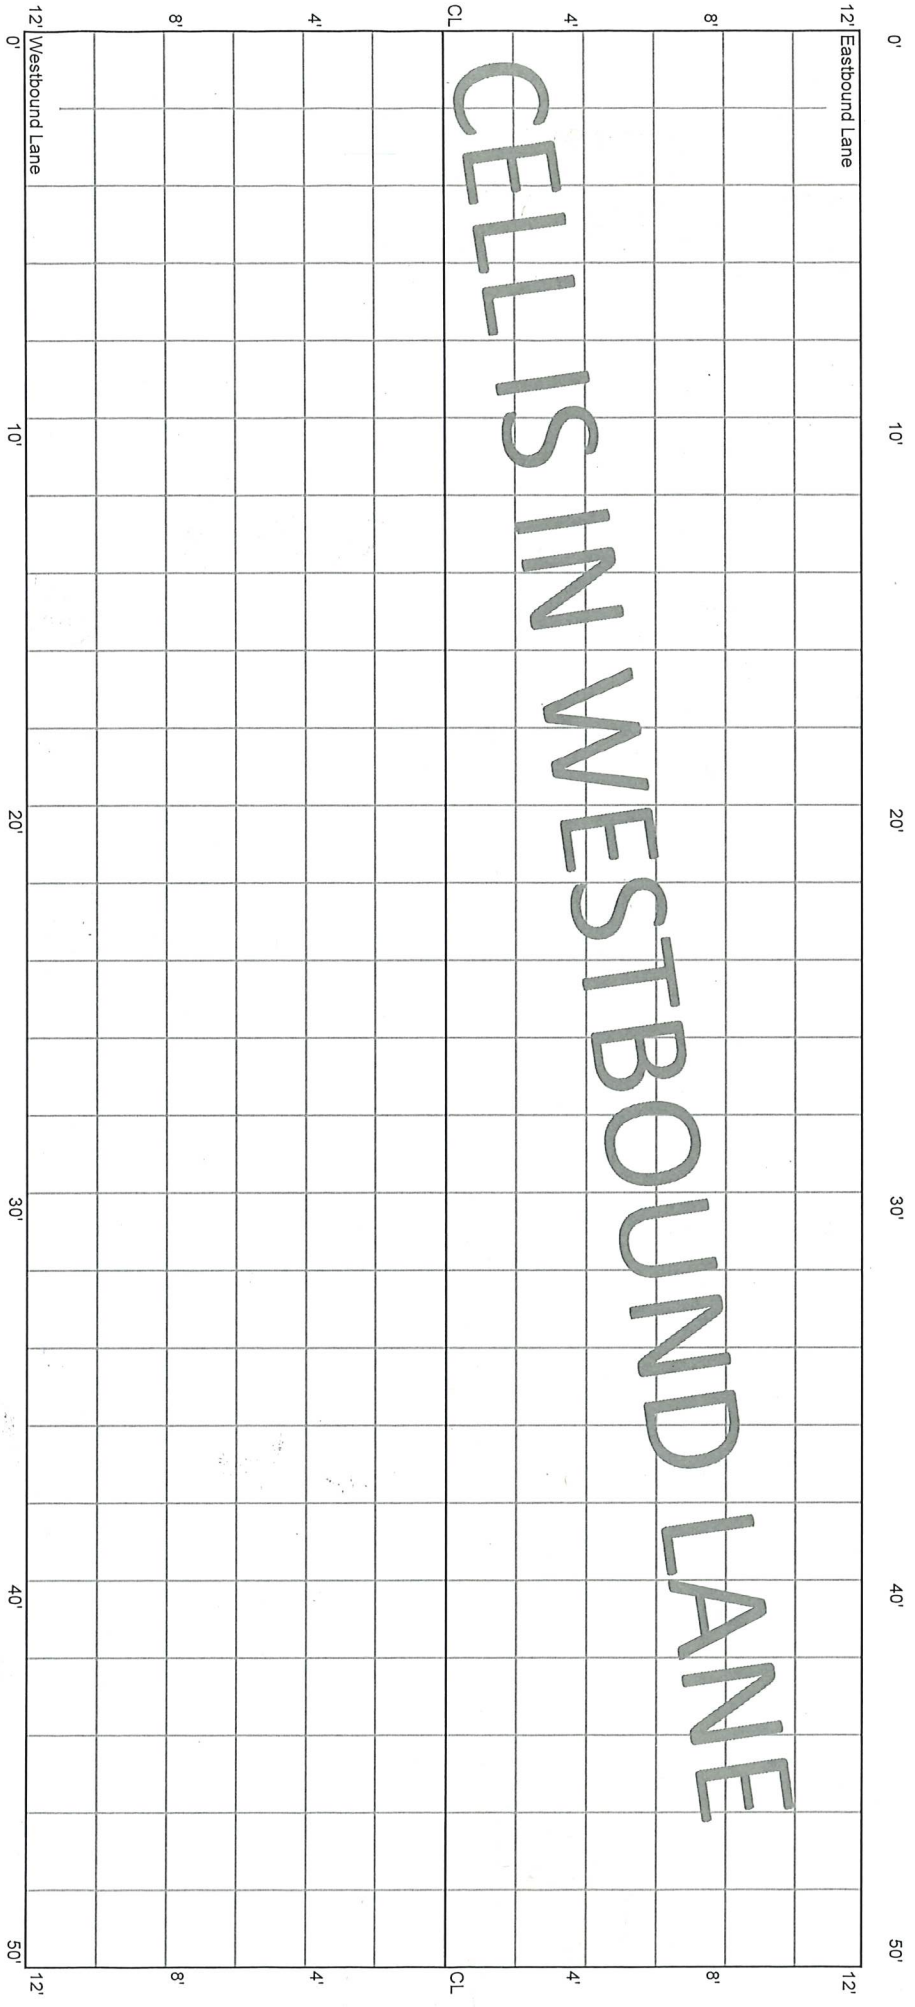

CELL 7006W
50 - 100 ft

32+00


31+50

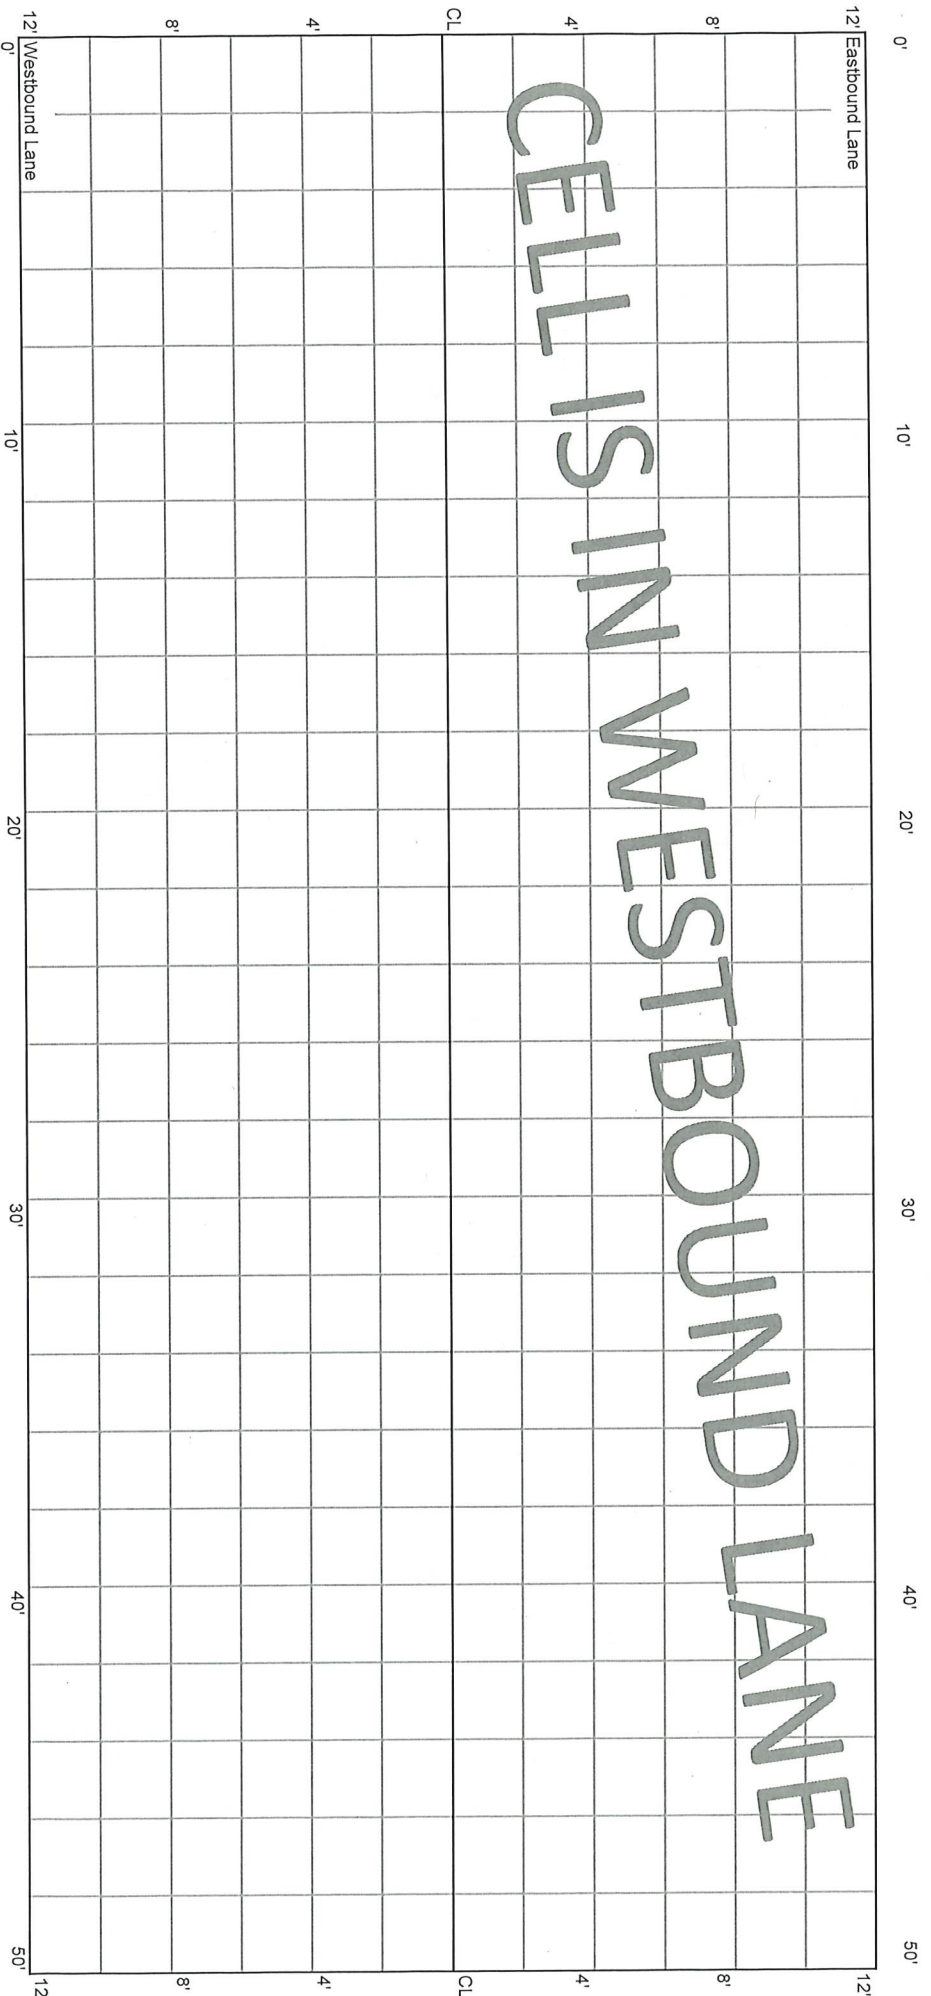

CELL 7006W
100 - 150 ft

31+50

31+00

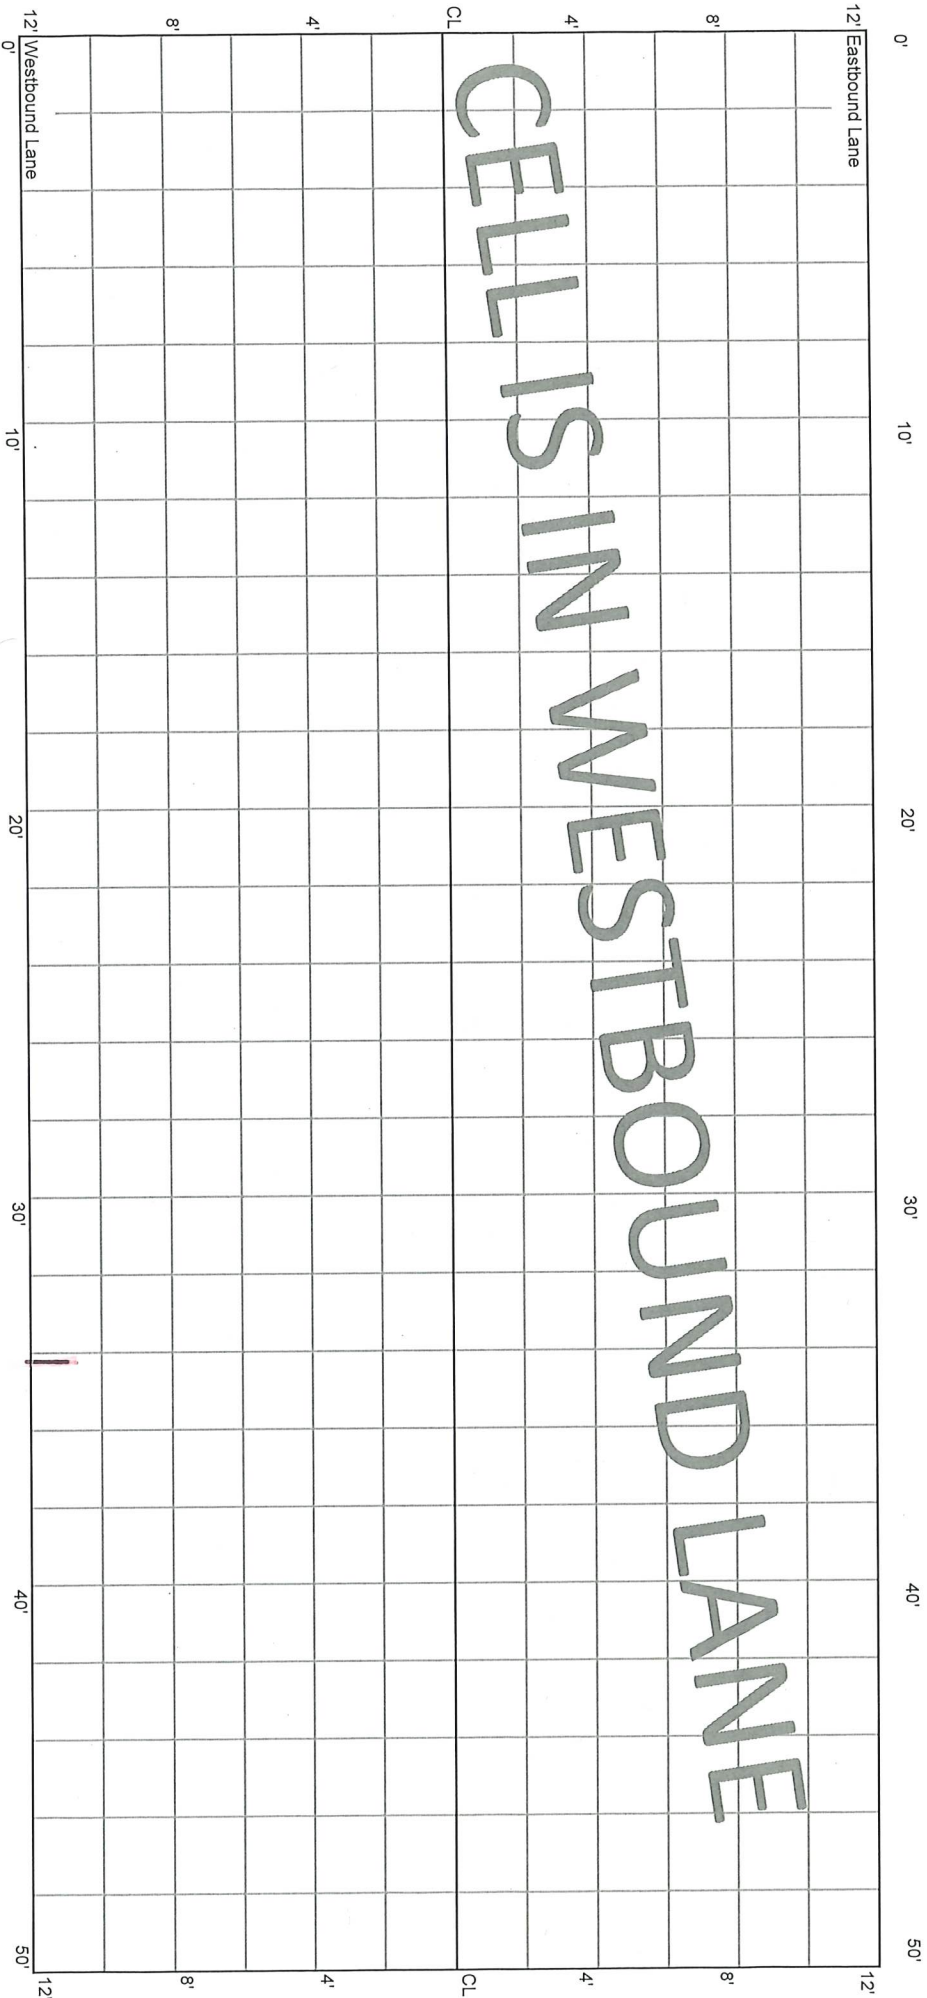


CELLS IN WESTBOUND LANE

CELL 7006W
150 - 200 ft

31+00

30+50

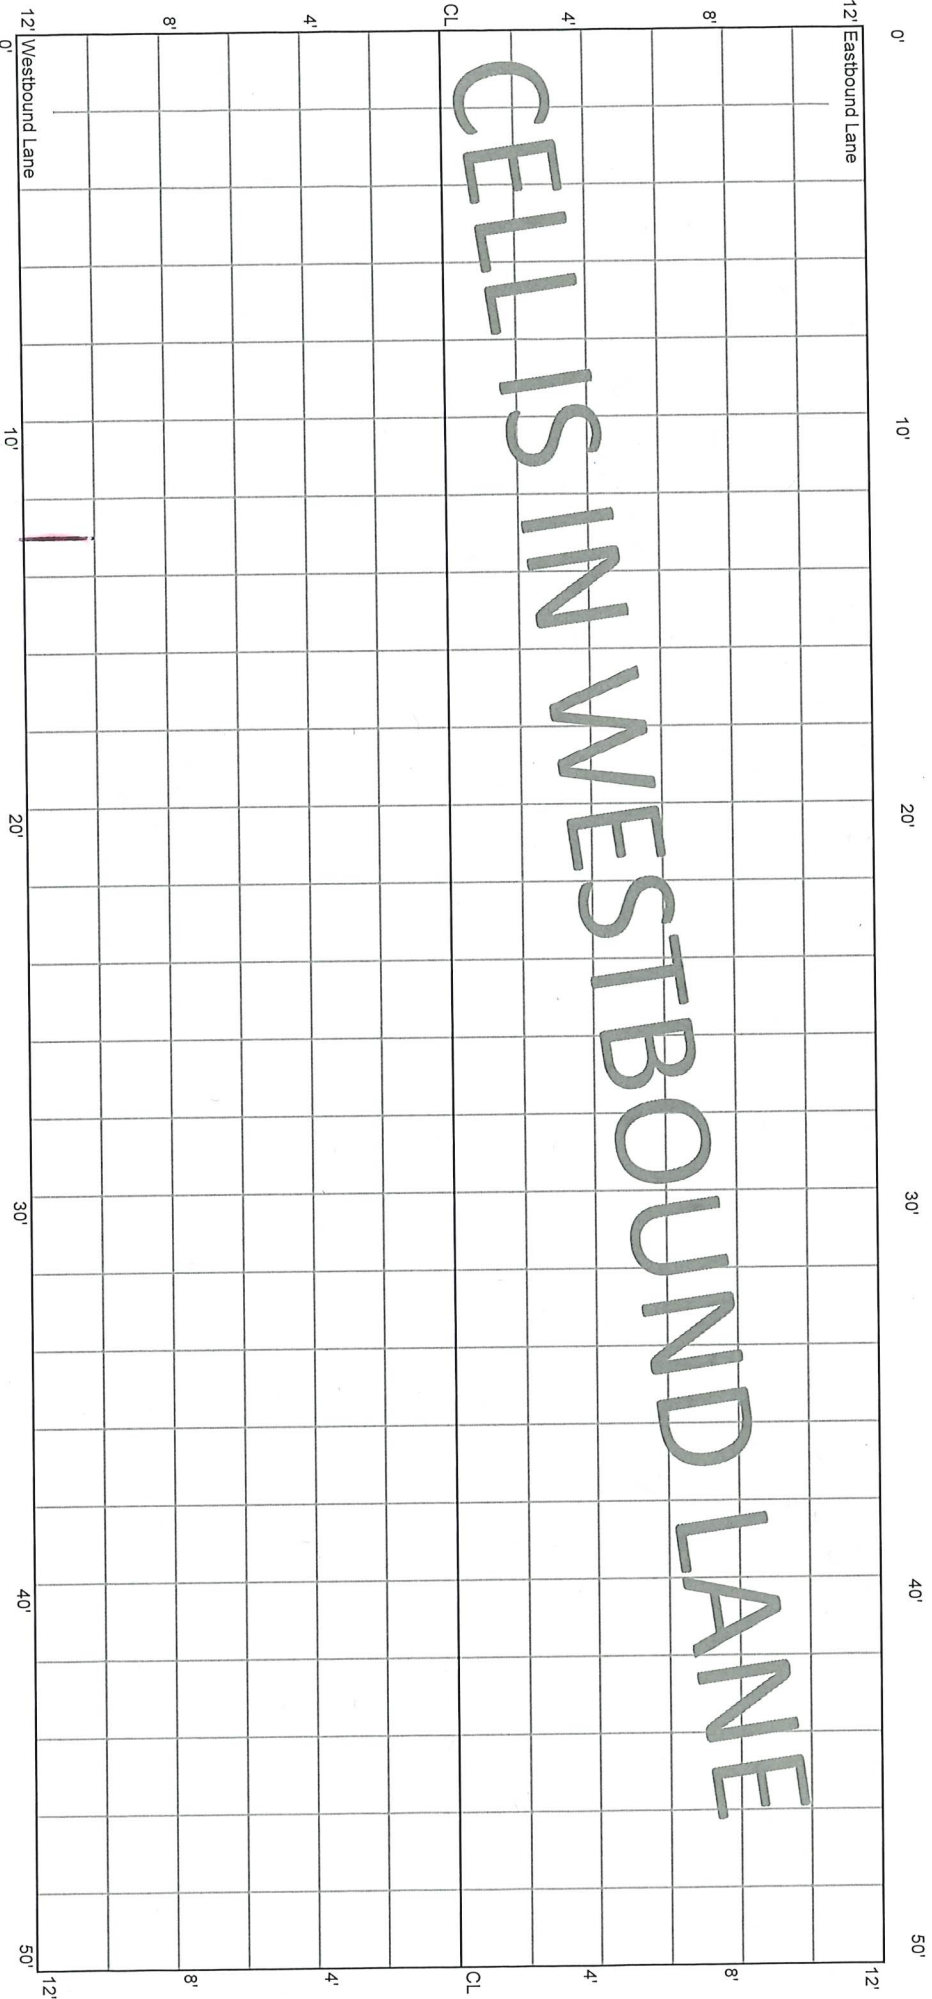


CELLS IN WESTBOUND LANE

CELL 7006W
200 - 250 ft

30+50


30+00

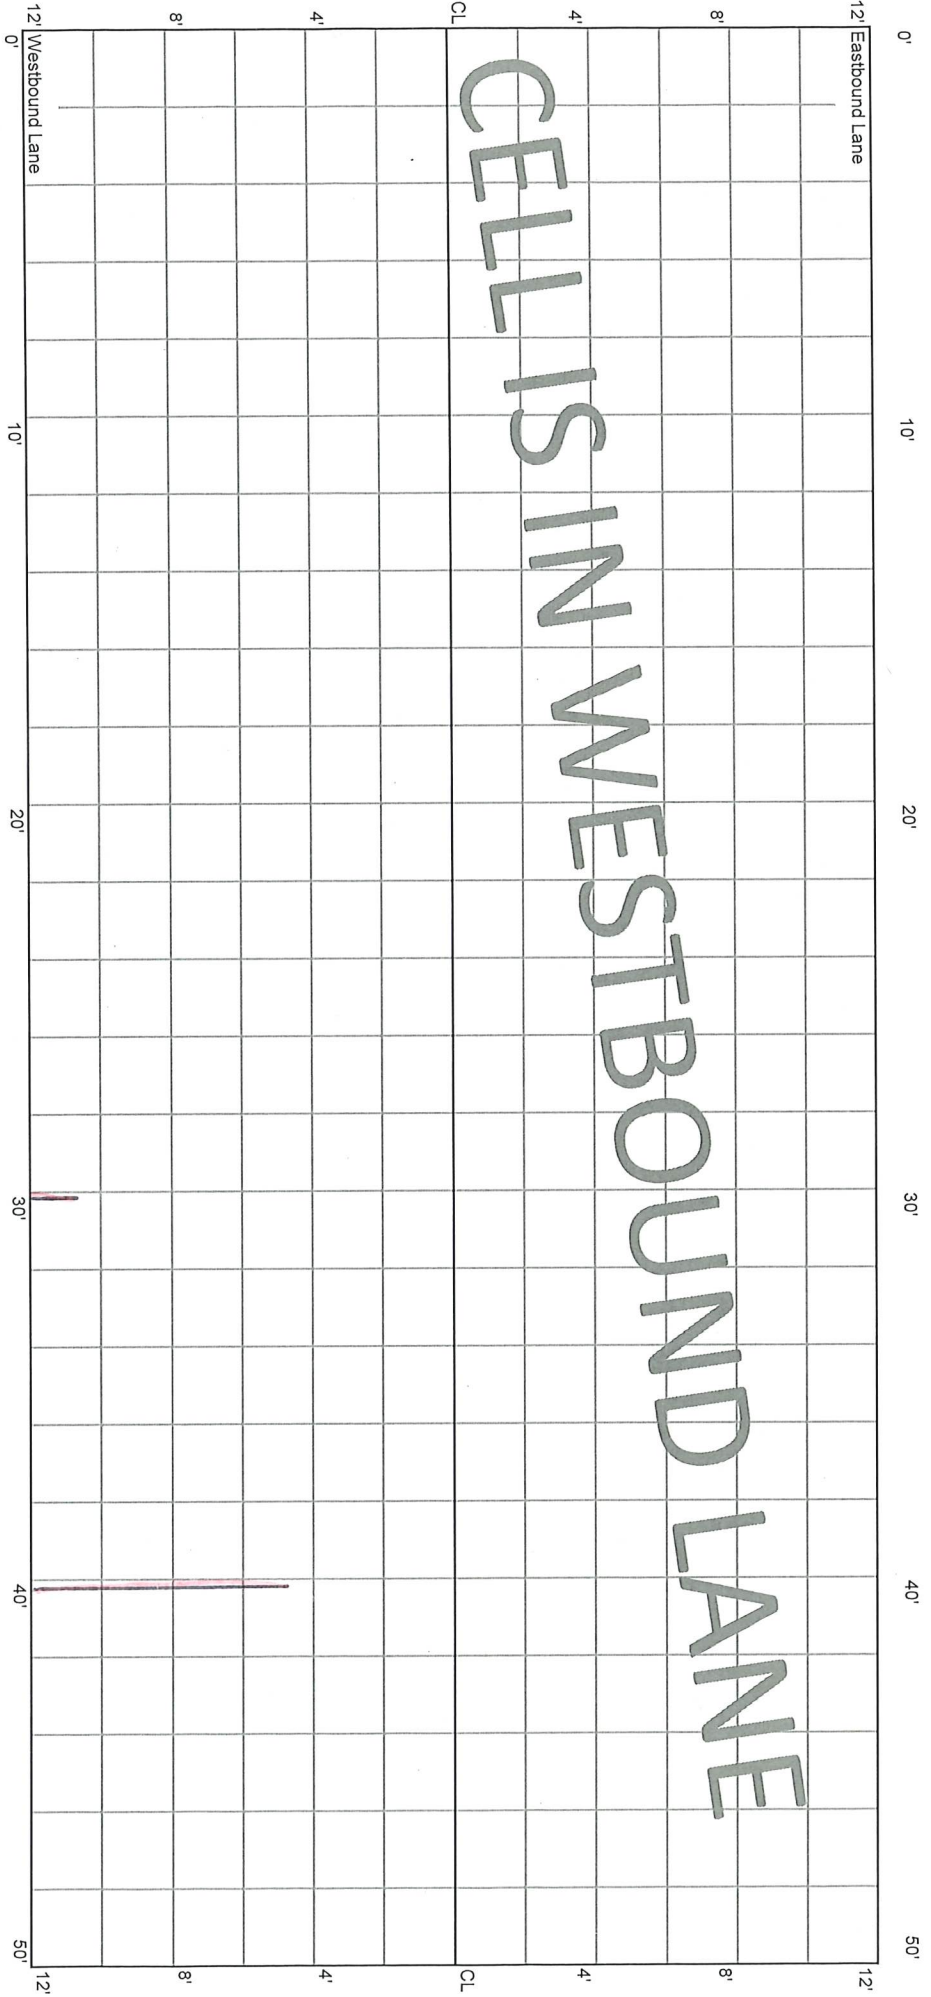

CELL 7006W
250 - 300 ft

30+00


29+50

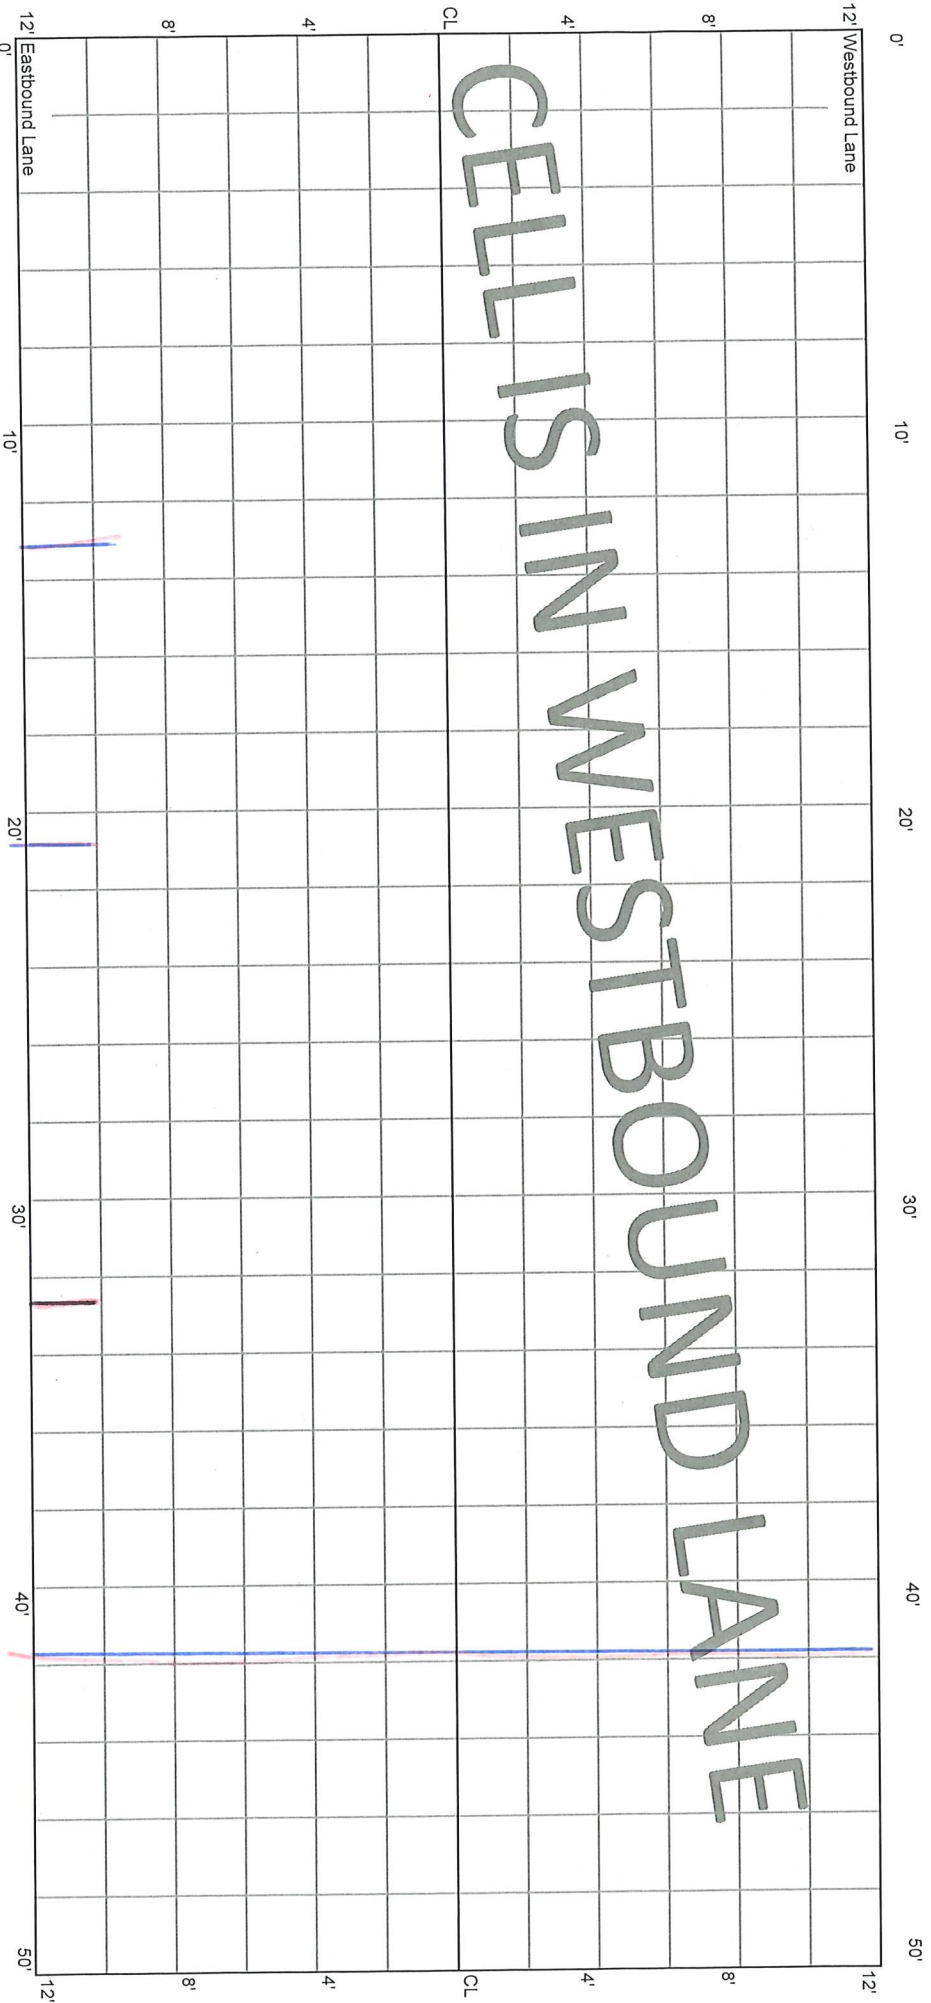

CELL 7006W
300 - 350 ft

29+50


29+00

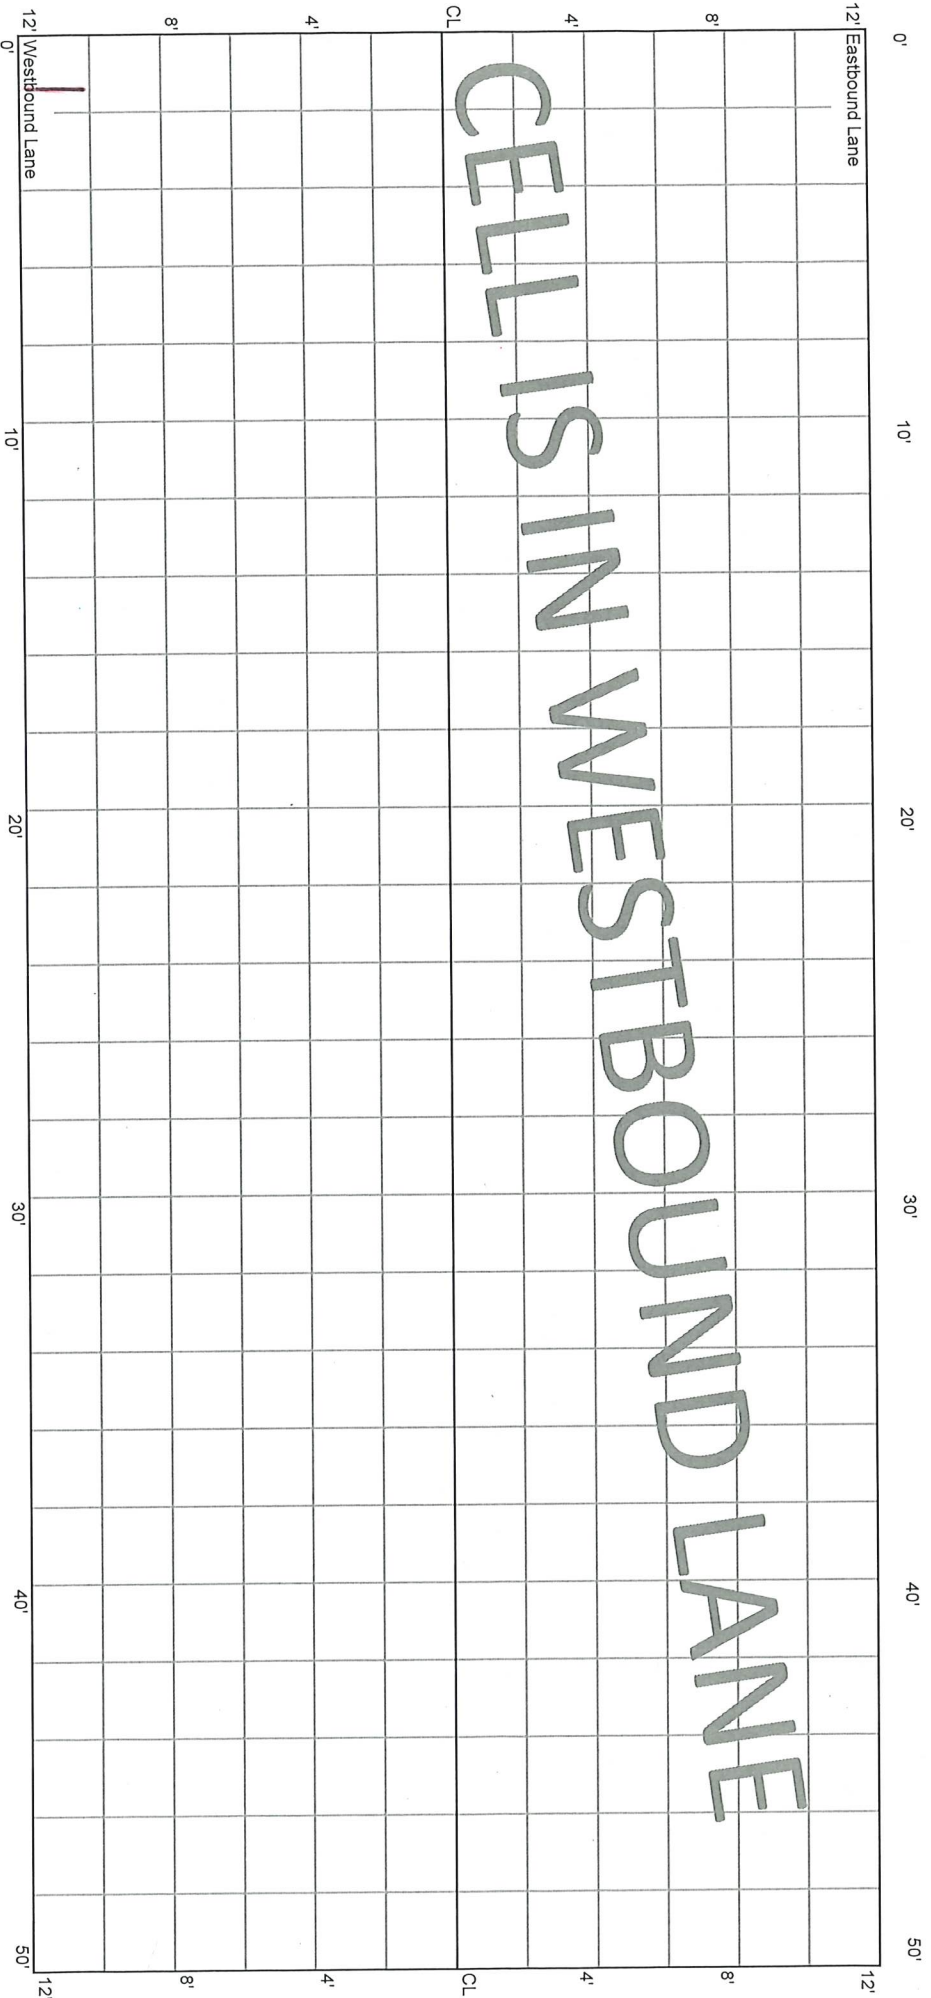

CELL 7006W
350 - 400 ft

29+00


28+50

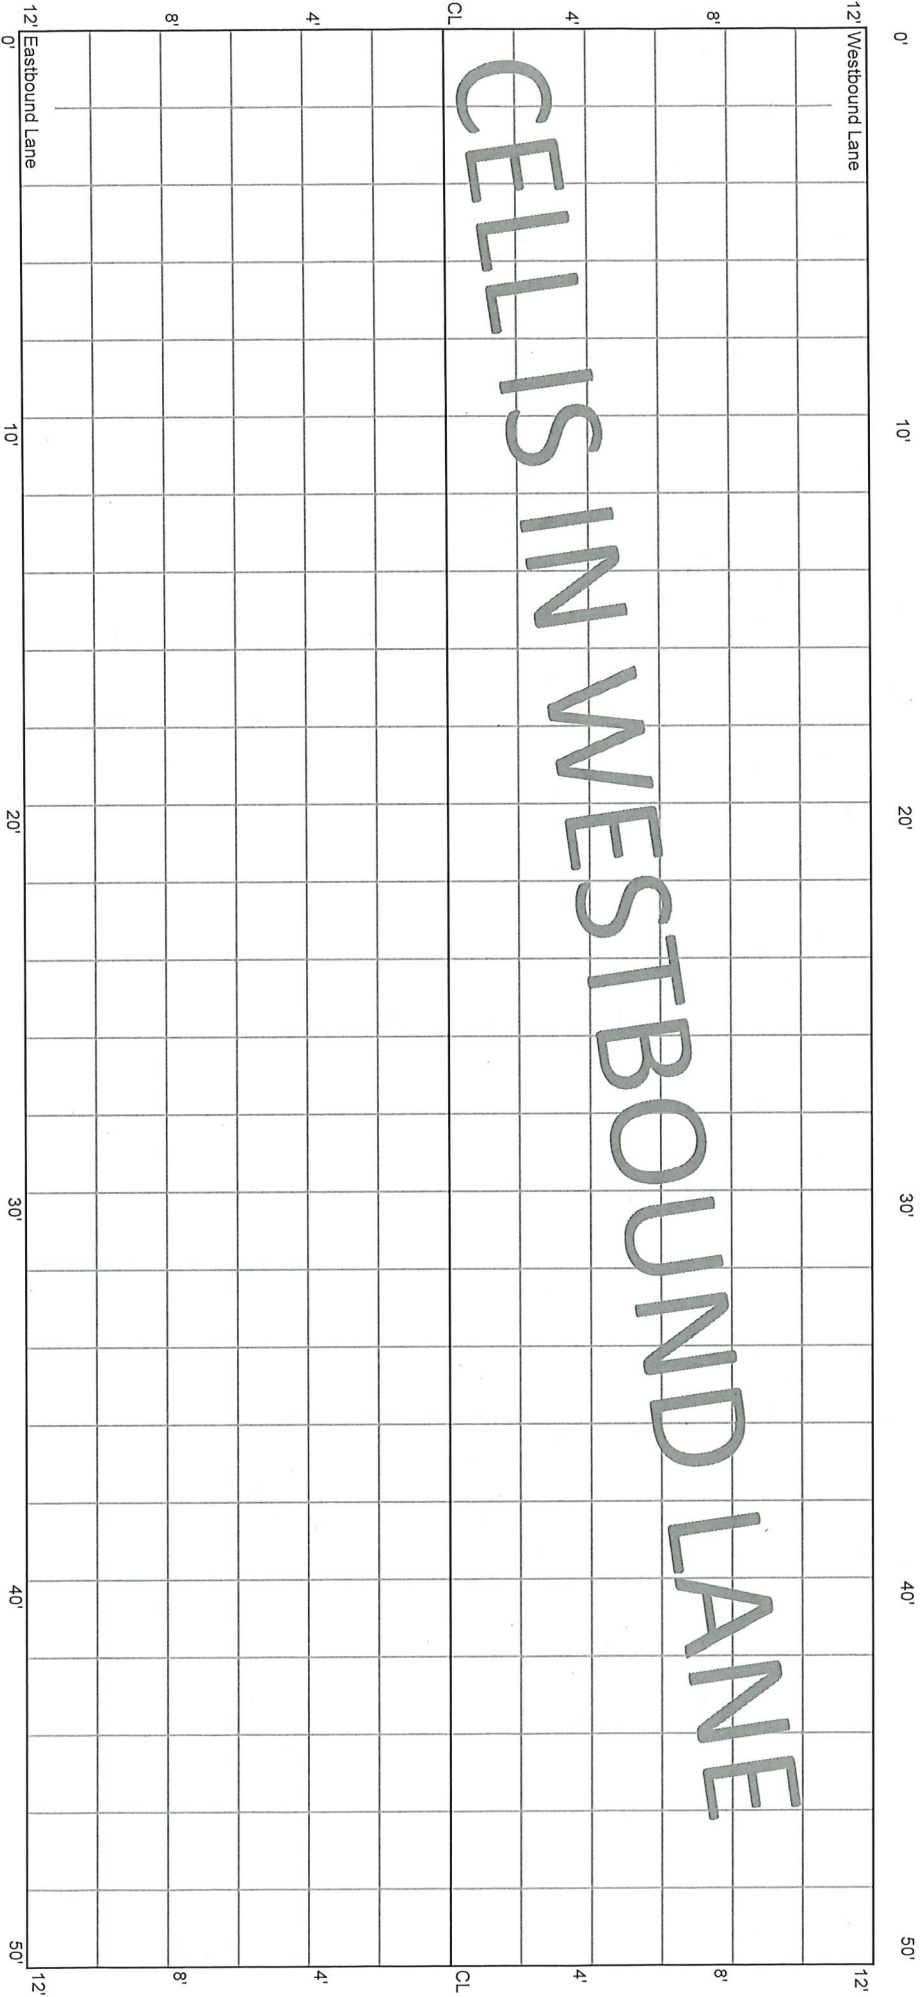

CELL 7006W
400 - 450 ft

28+50


28+00

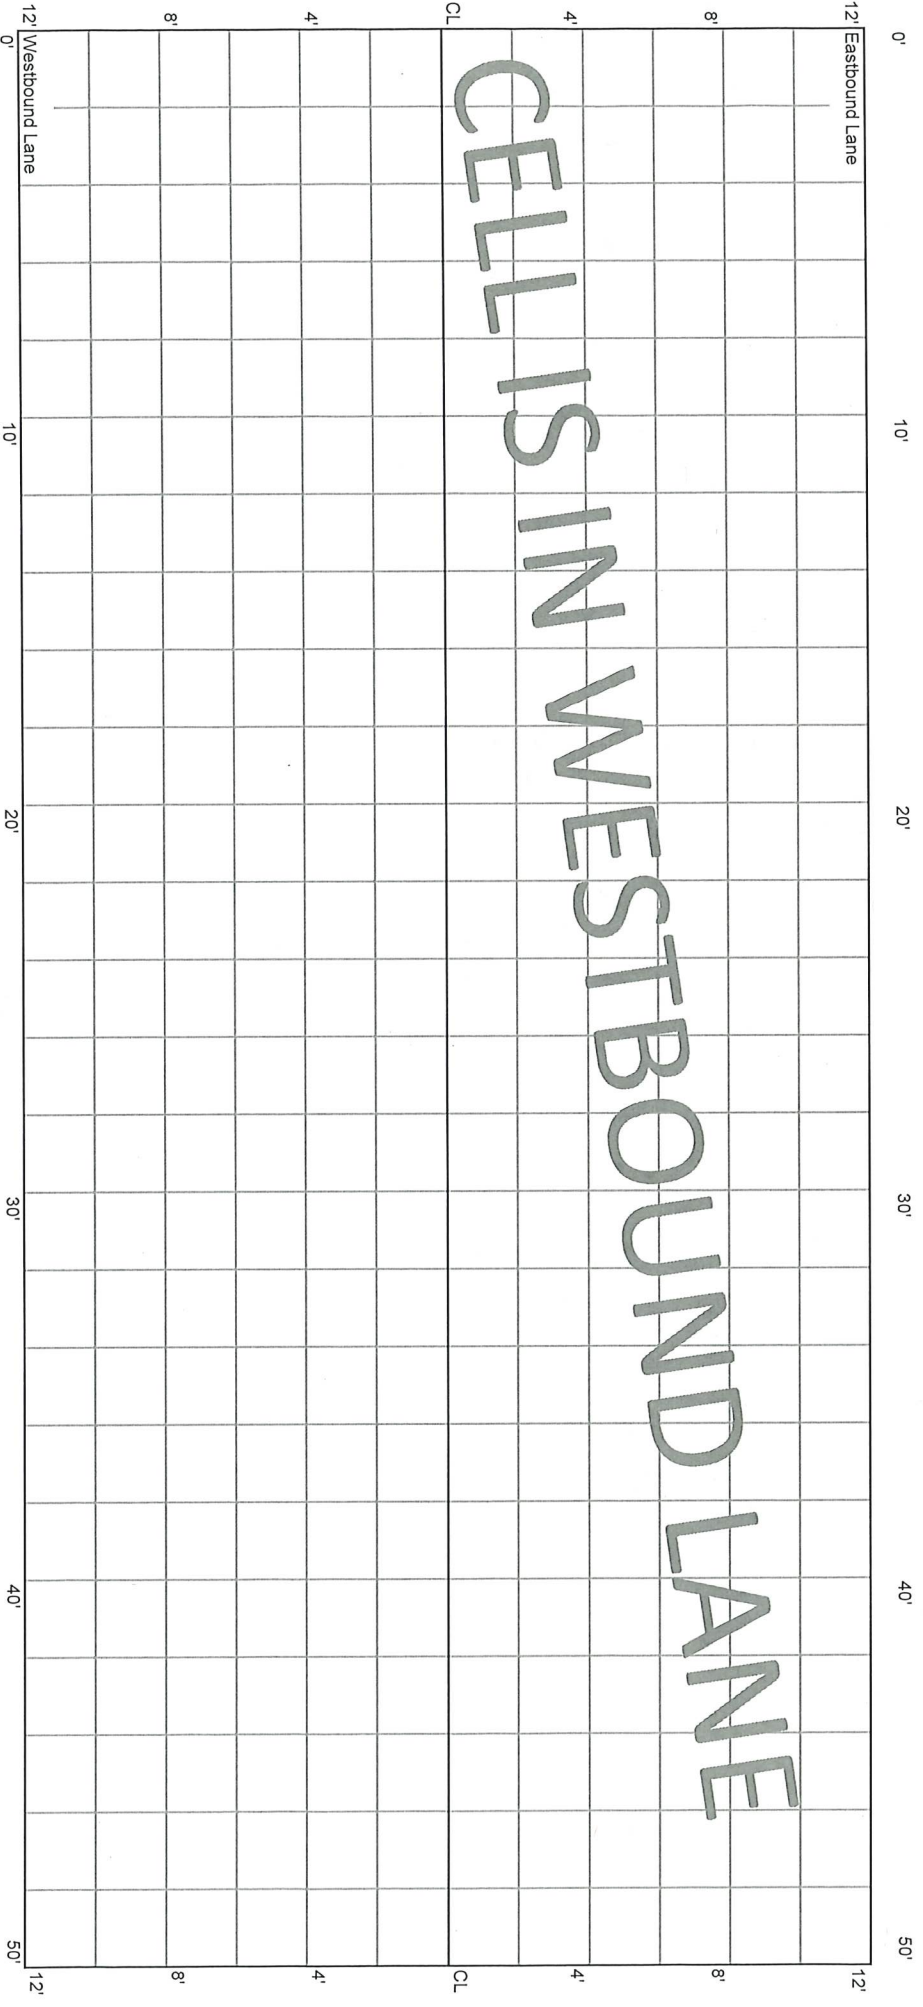

CELL 7006W
450 - 500 ft

28+00

27+50

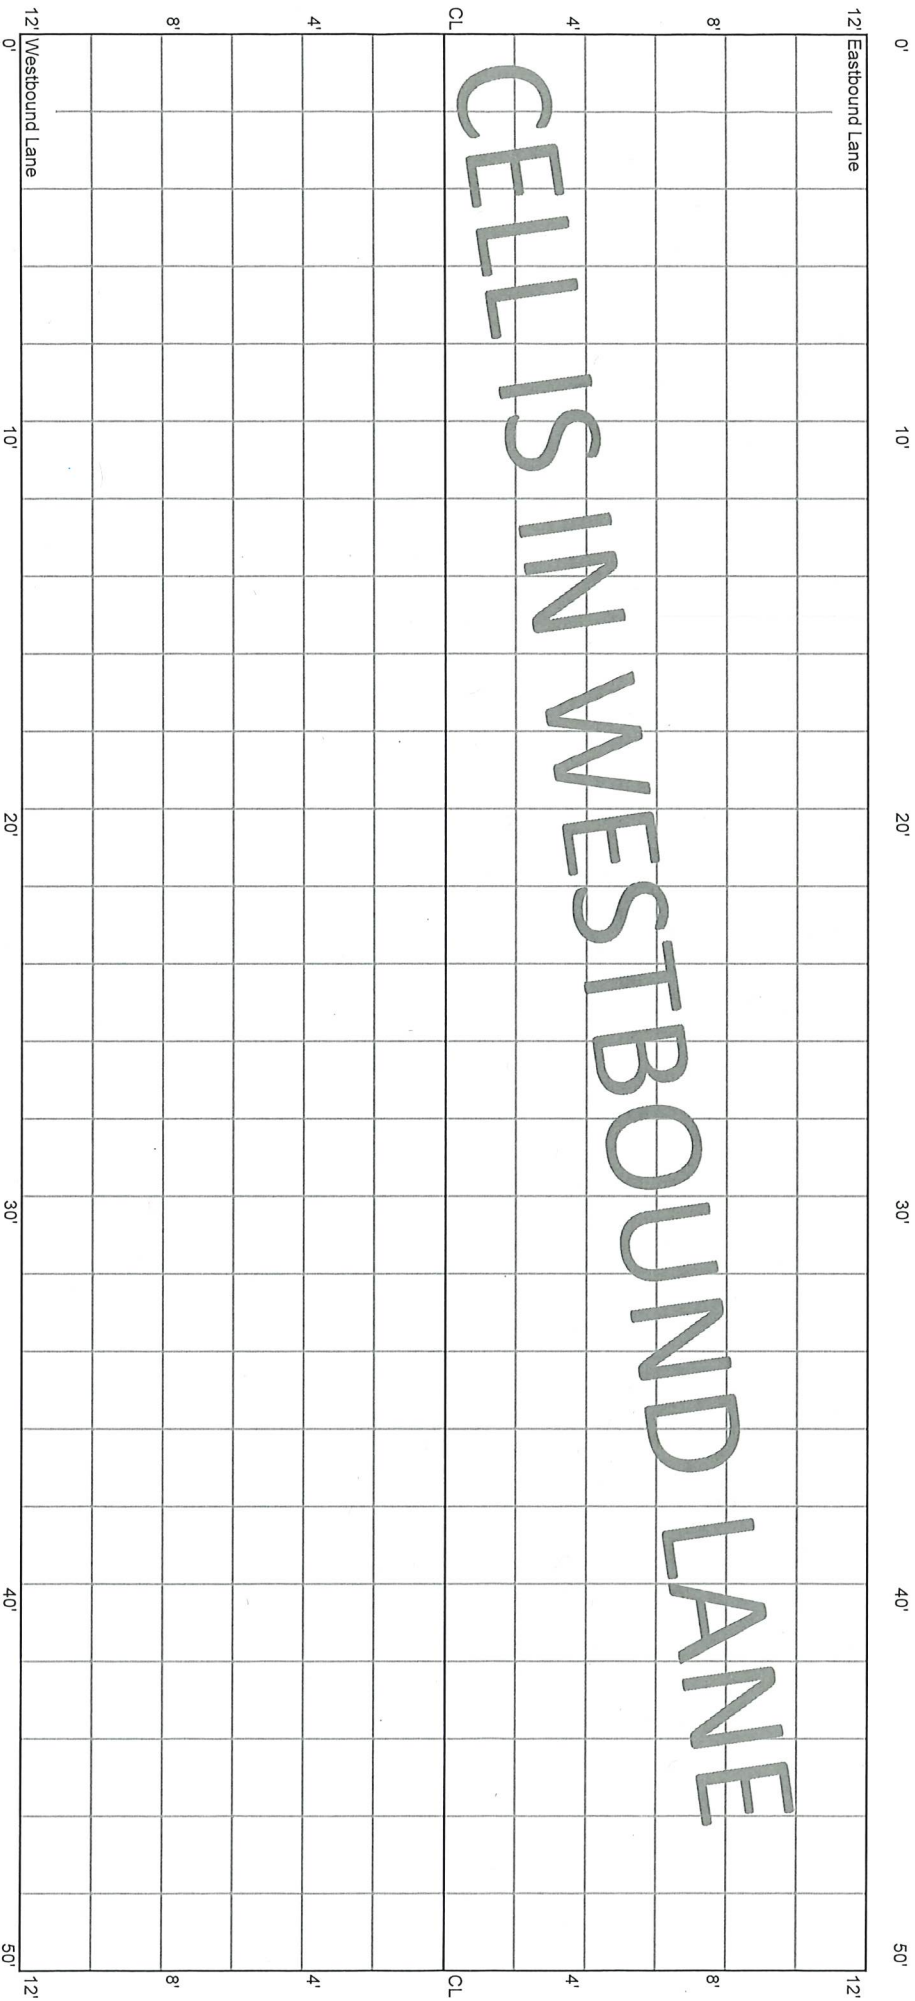


CELL 7006W
500 - 550 ft

27+50

27+25

27+00

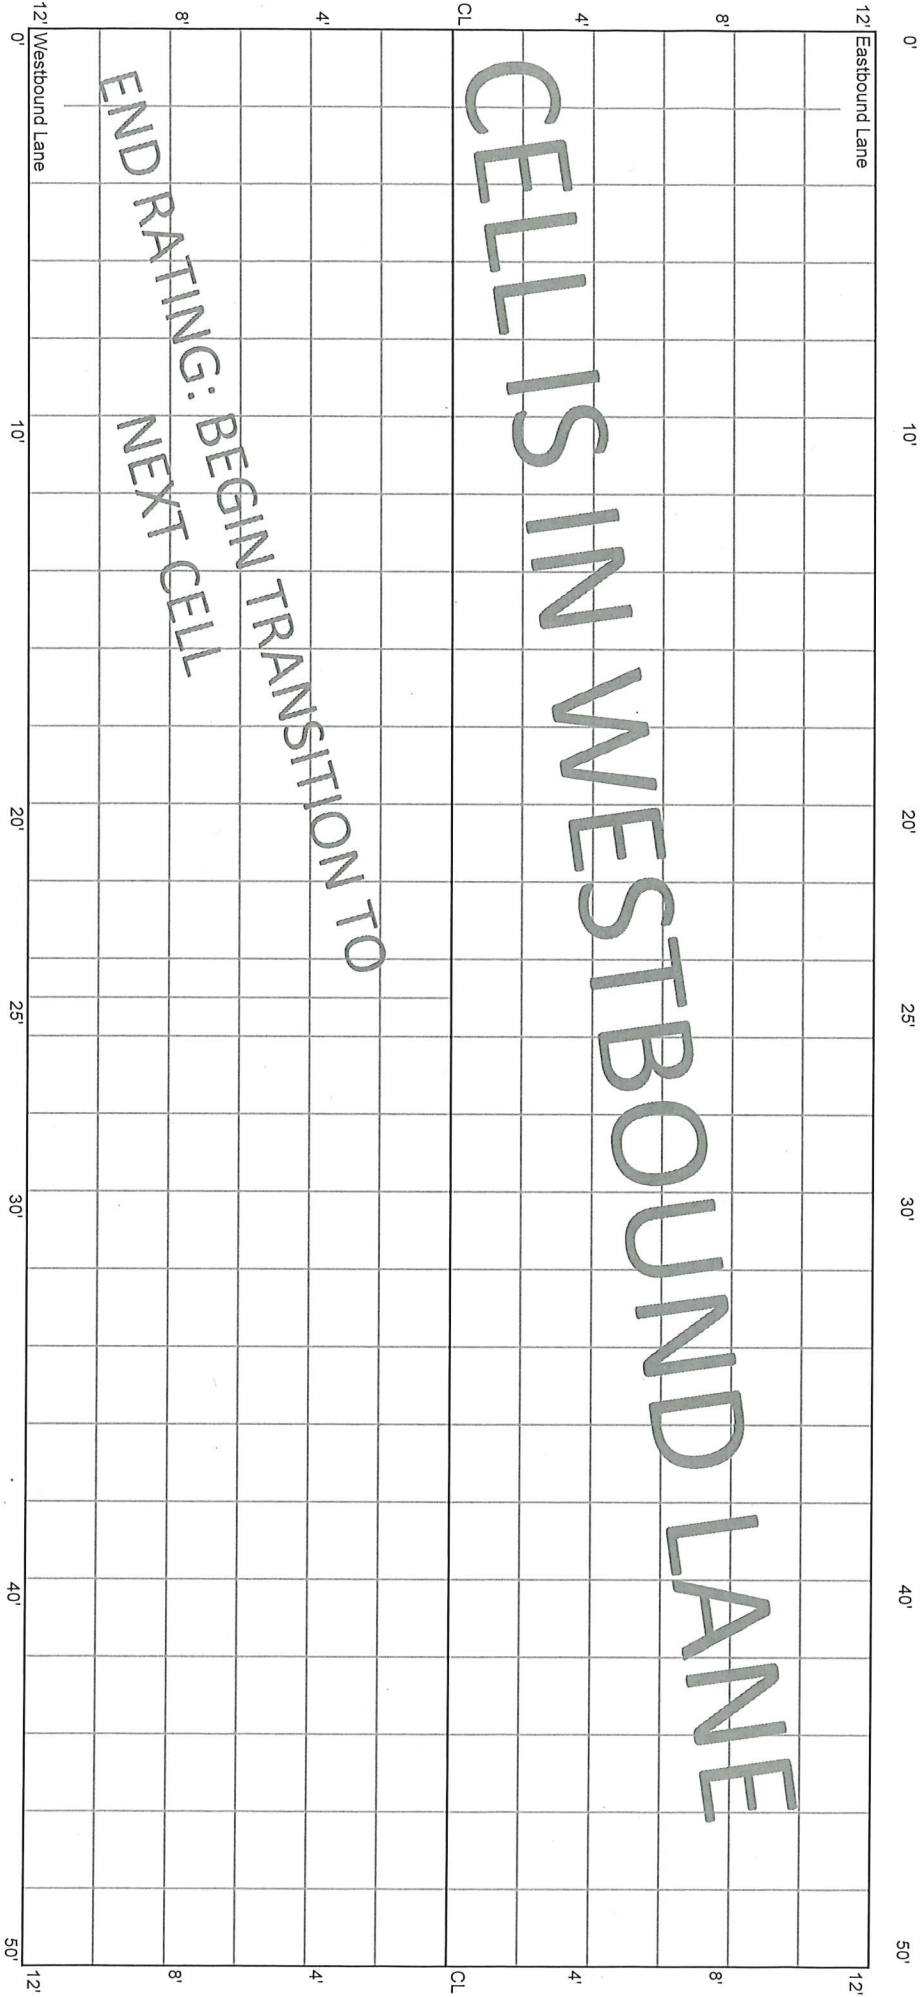

12' Eastbound Lane

12' Westbound Lane

CELLS IN WESTBOUND LANE

END RATING: BEGIN TRANSITION TO
NEXT CELL