

8.25.21 - 35 Trans. cracks outside
Fog line.

5.28.20 E.J. - No Distress

10.14.20 - No Distress

1.4.21 - No Distress


File 70TH ST
8.25.21 | 1.13.22
 | 8.31.22
 | 1.26.23

Cell 7016 W

CELL 7006W
0 - 50 ft

32+50


32+00

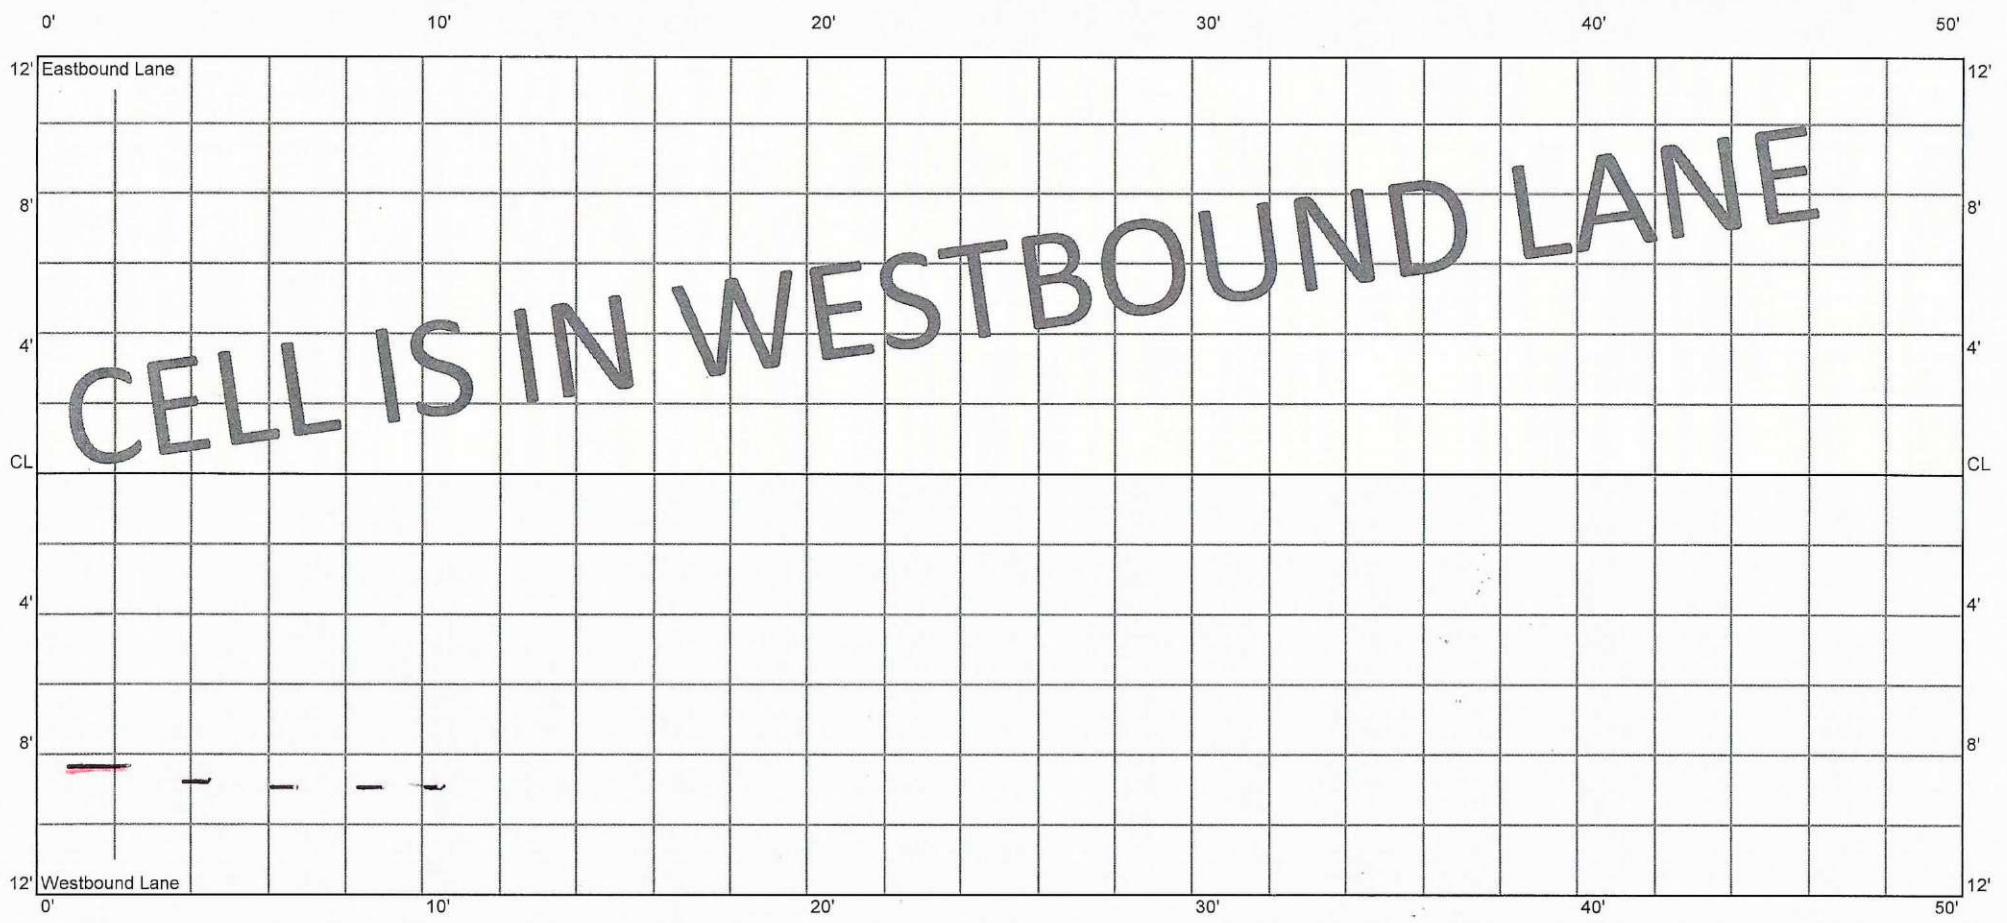

CELL 7006W
50 - 100 ft

32+00

31+50

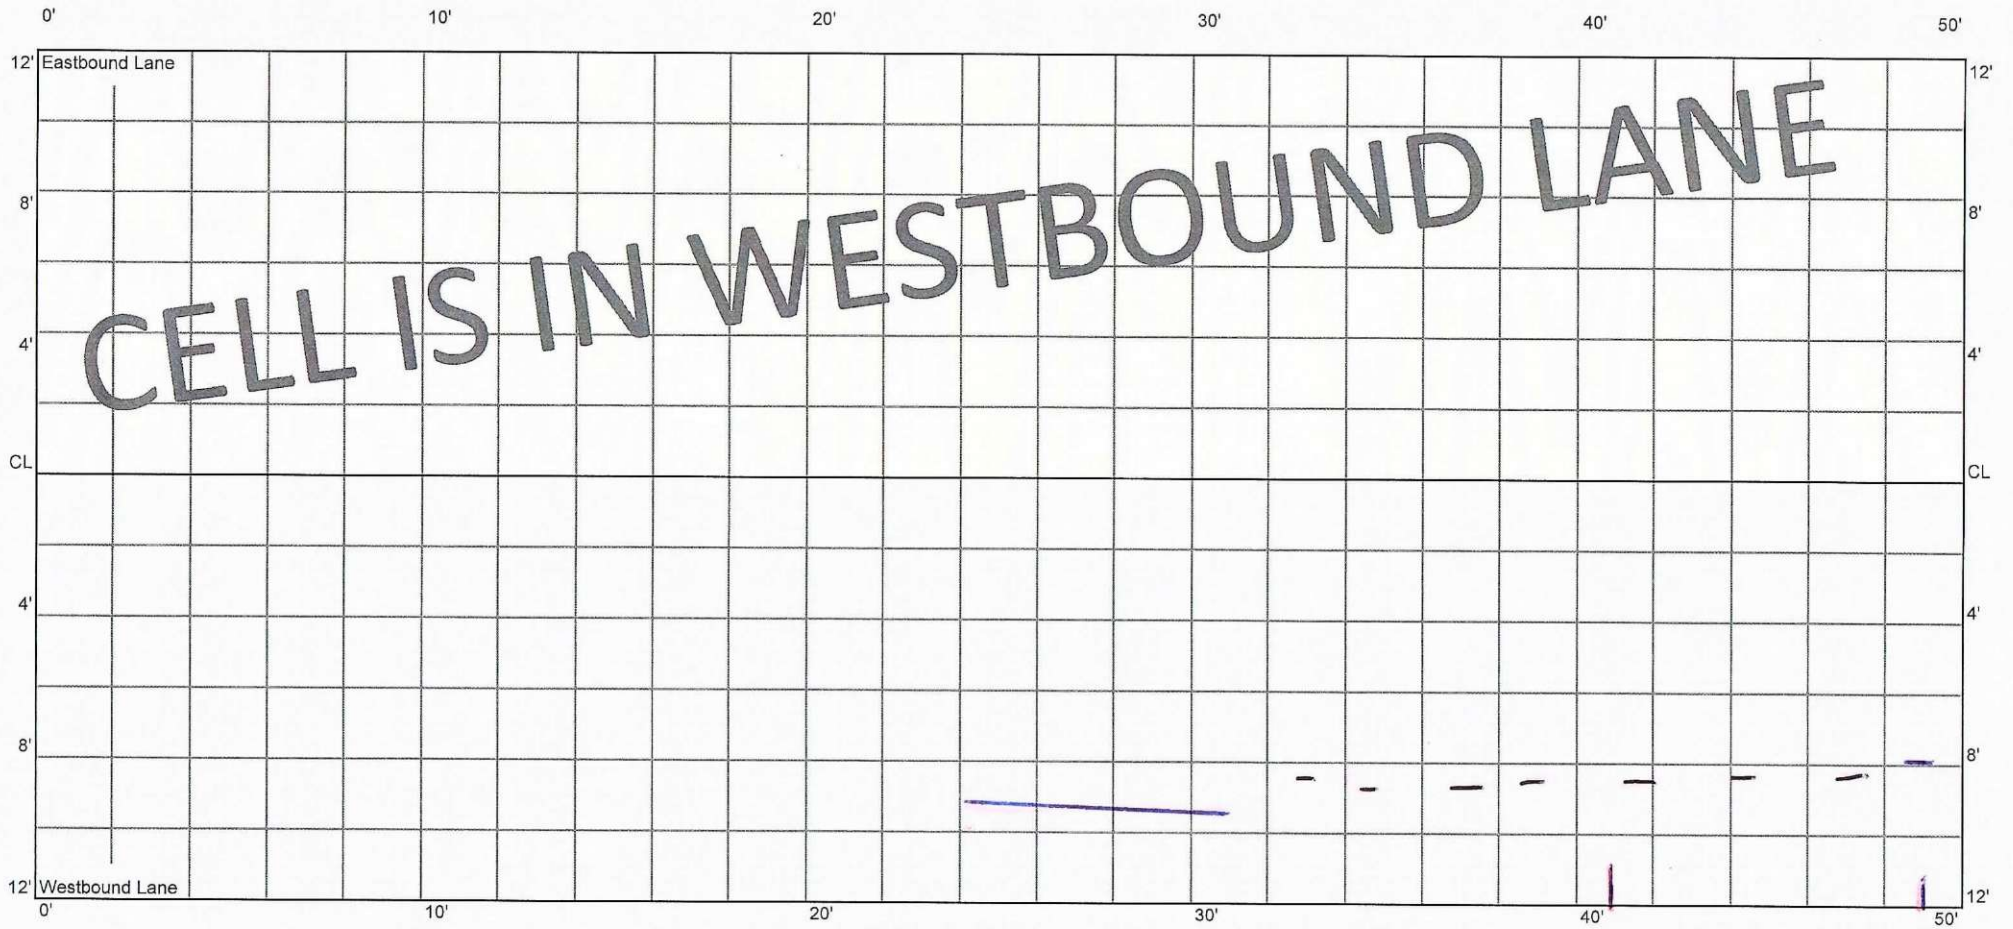

CELL 7006W
100 - 150 ft

31+50

31+00

0'

10'

20'

30'

40'

50'

12' Eastbound Lane

12'

8'

8'

4'

4'

CL

CL

4'

4'

8'

8'

12' Westbound Lane

12'

0'

10'


20'

30'

40'

50'


CELL IS IN WESTBOUND LANE

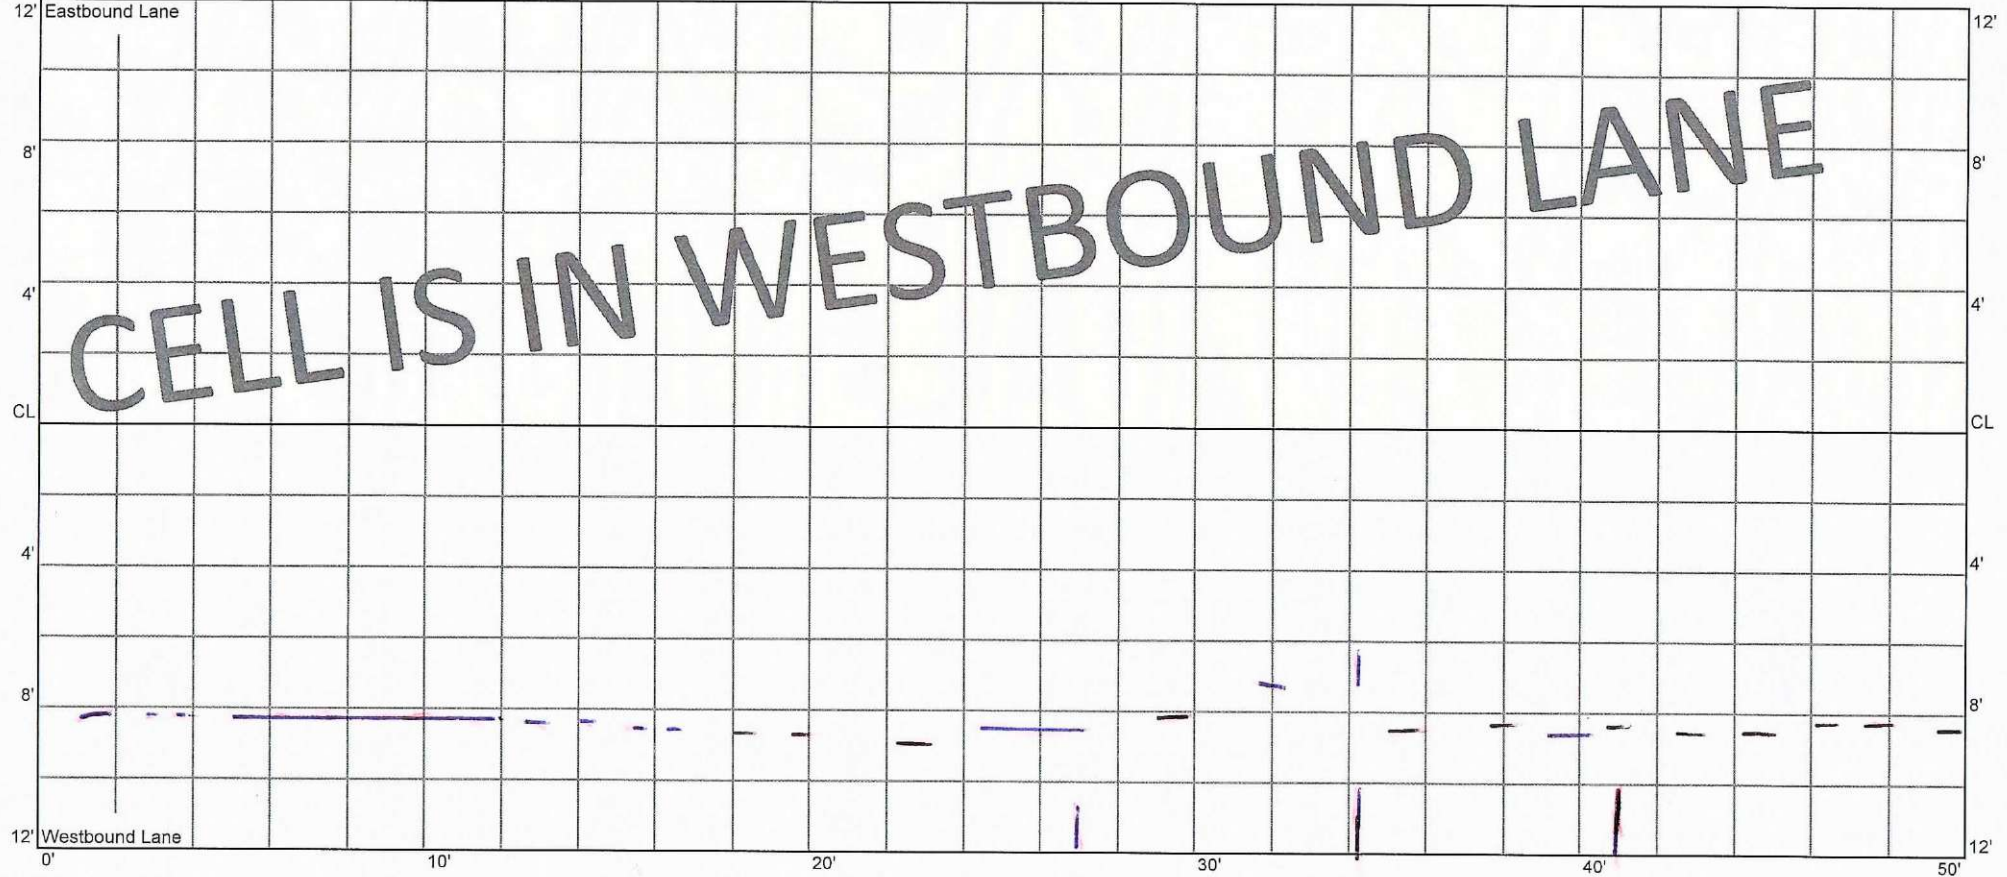

CELL 7006W
150 - 200 ft

31+00

30+50

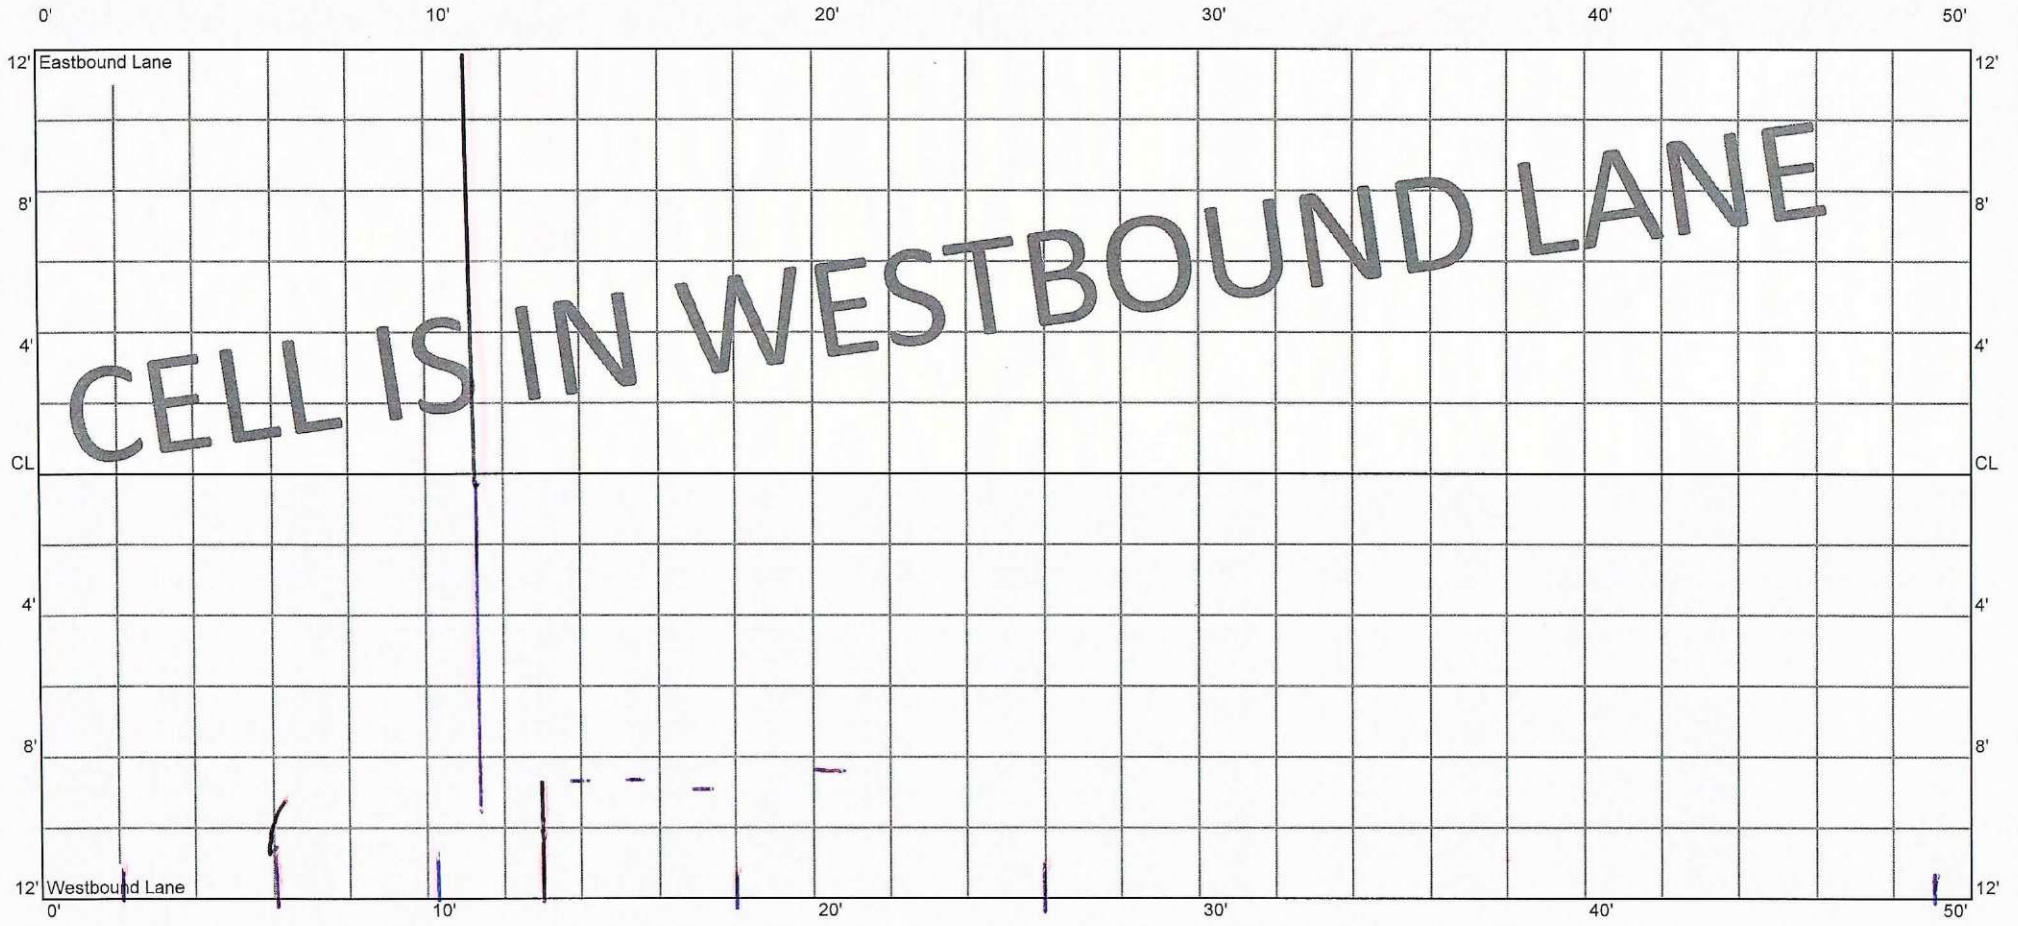

CELL 7006W
200 - 250 ft

30+50

30+00

0'


10'

20'

30'

40'

50'

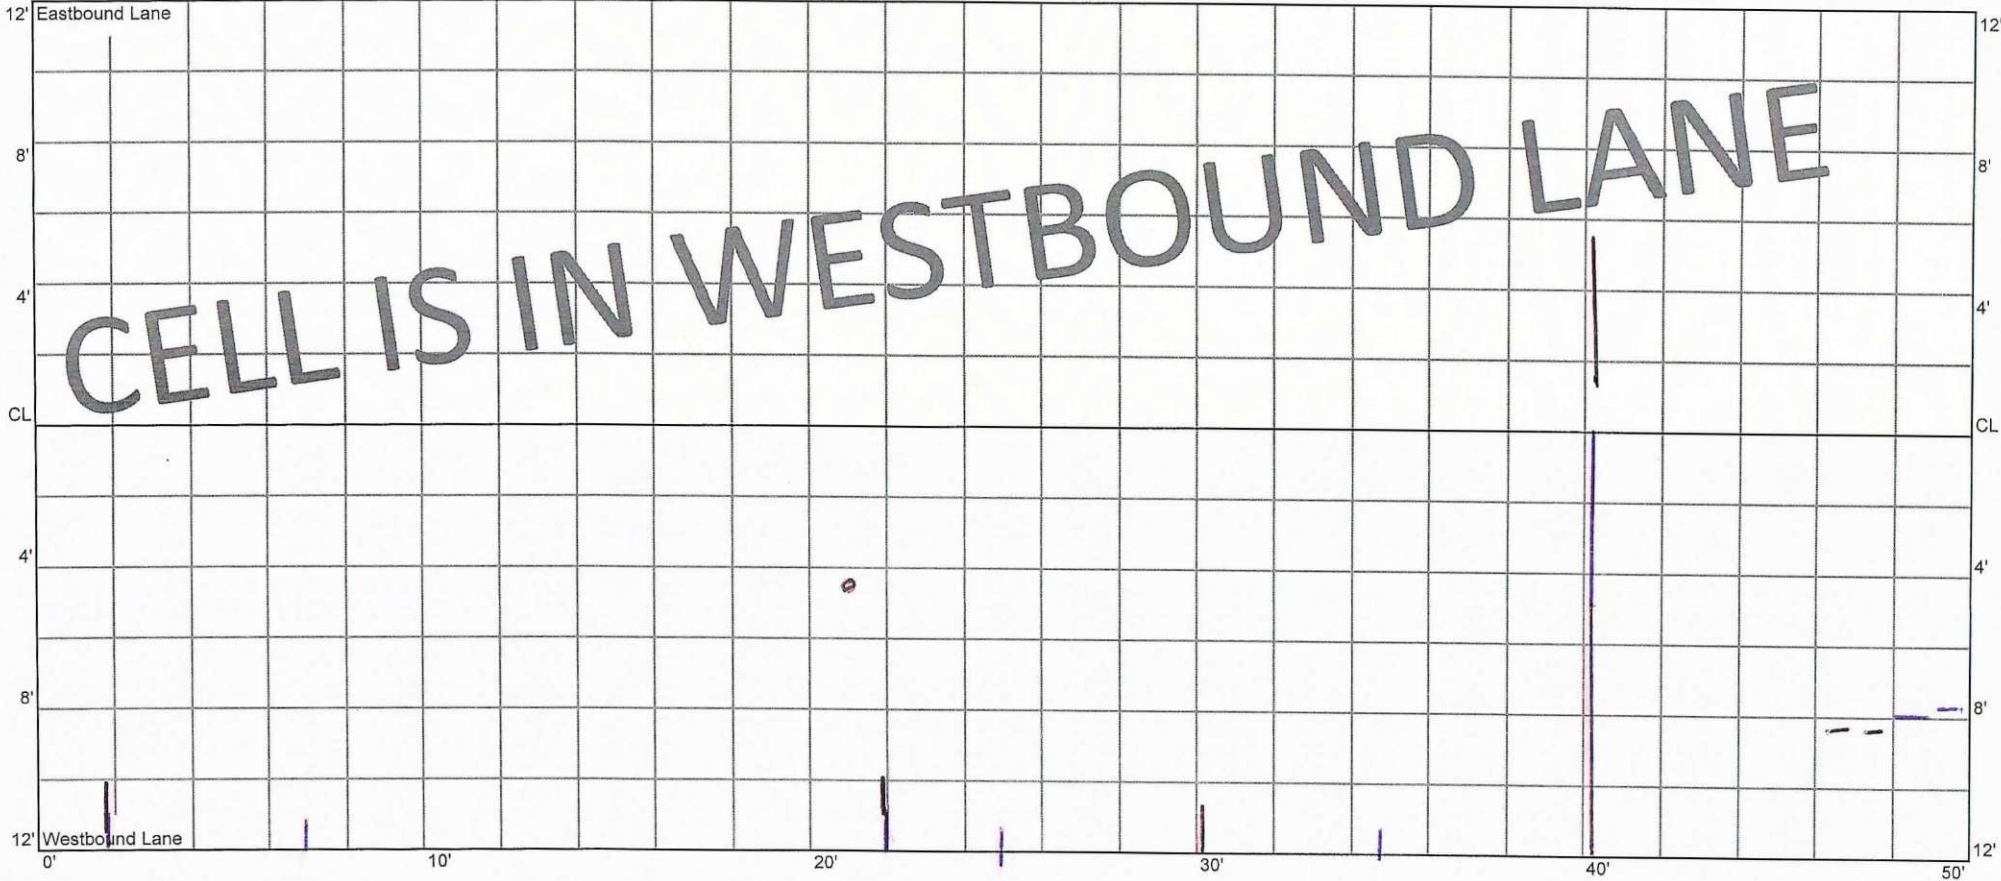

M

CELL 7006W
250 - 300 ft

30+00

29+50

0'

10'

20'

30'

40'

50'




M

CELL 7006W
300 - 350 ft

29+50

29+00

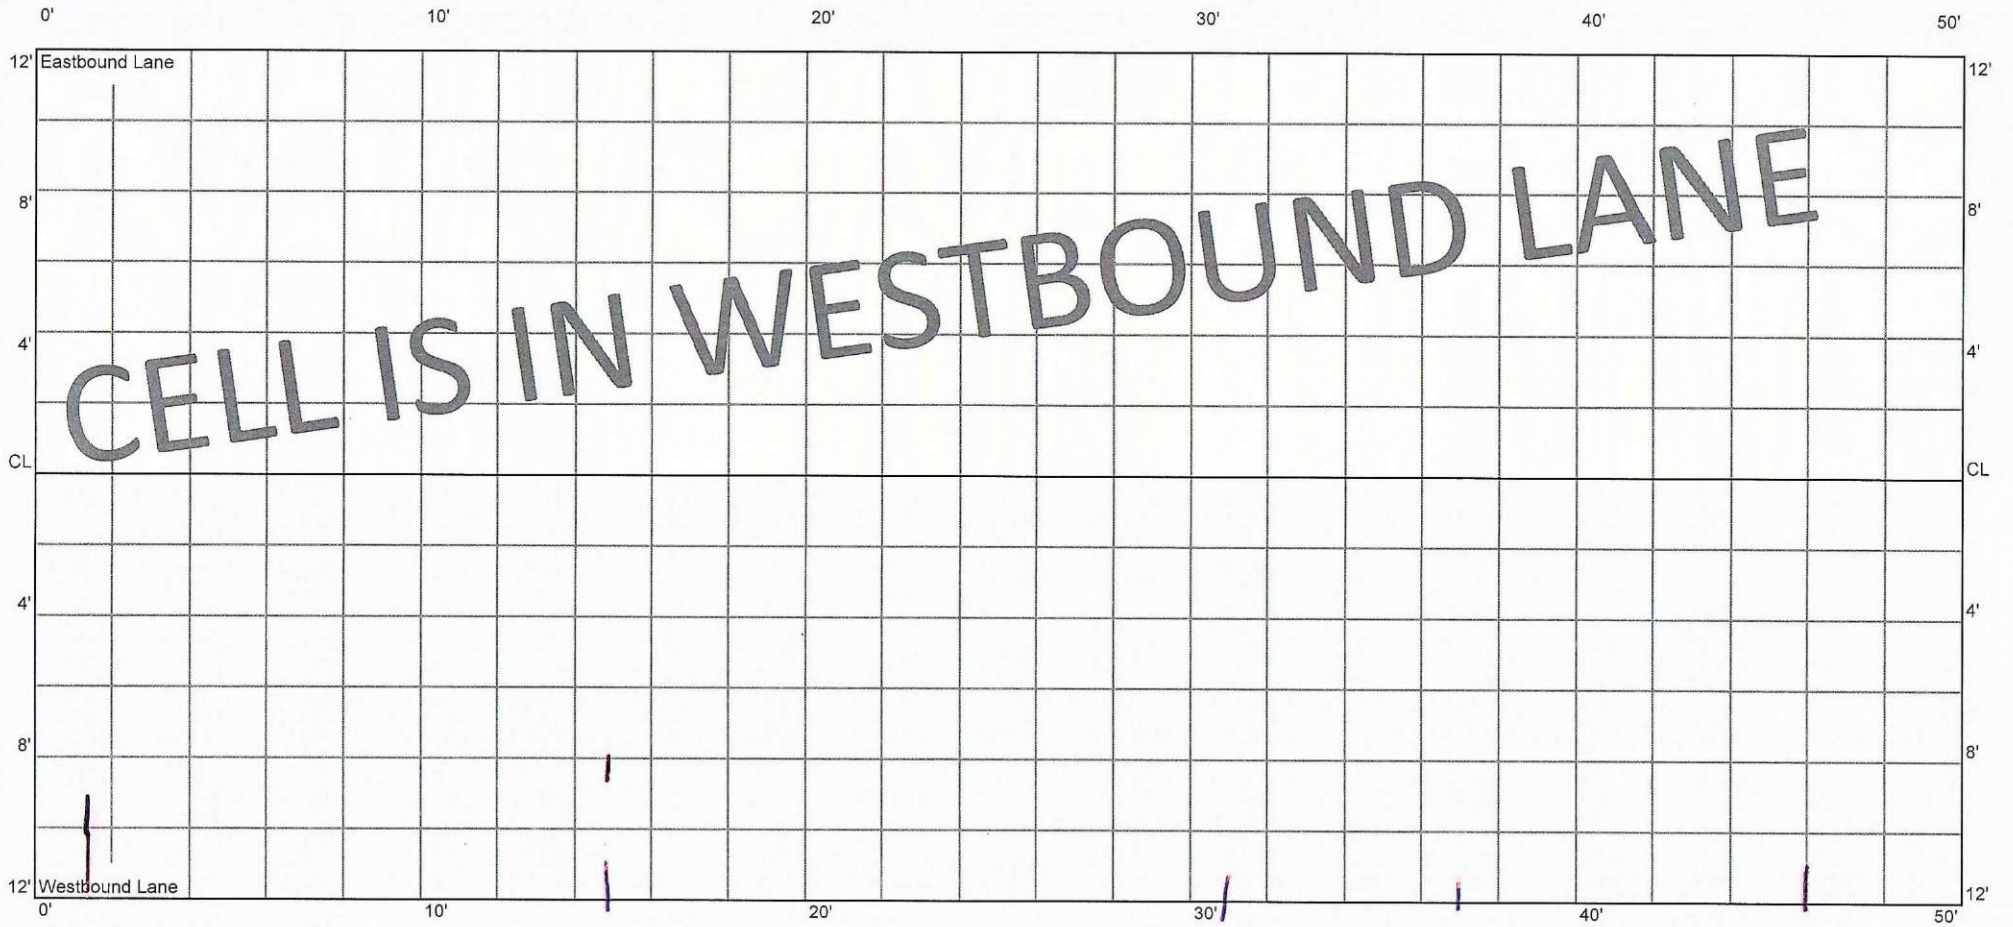


CELL 7006W
350 - 400 ft

29+00

28+50

0' 10' 20' 30' 40' 50'

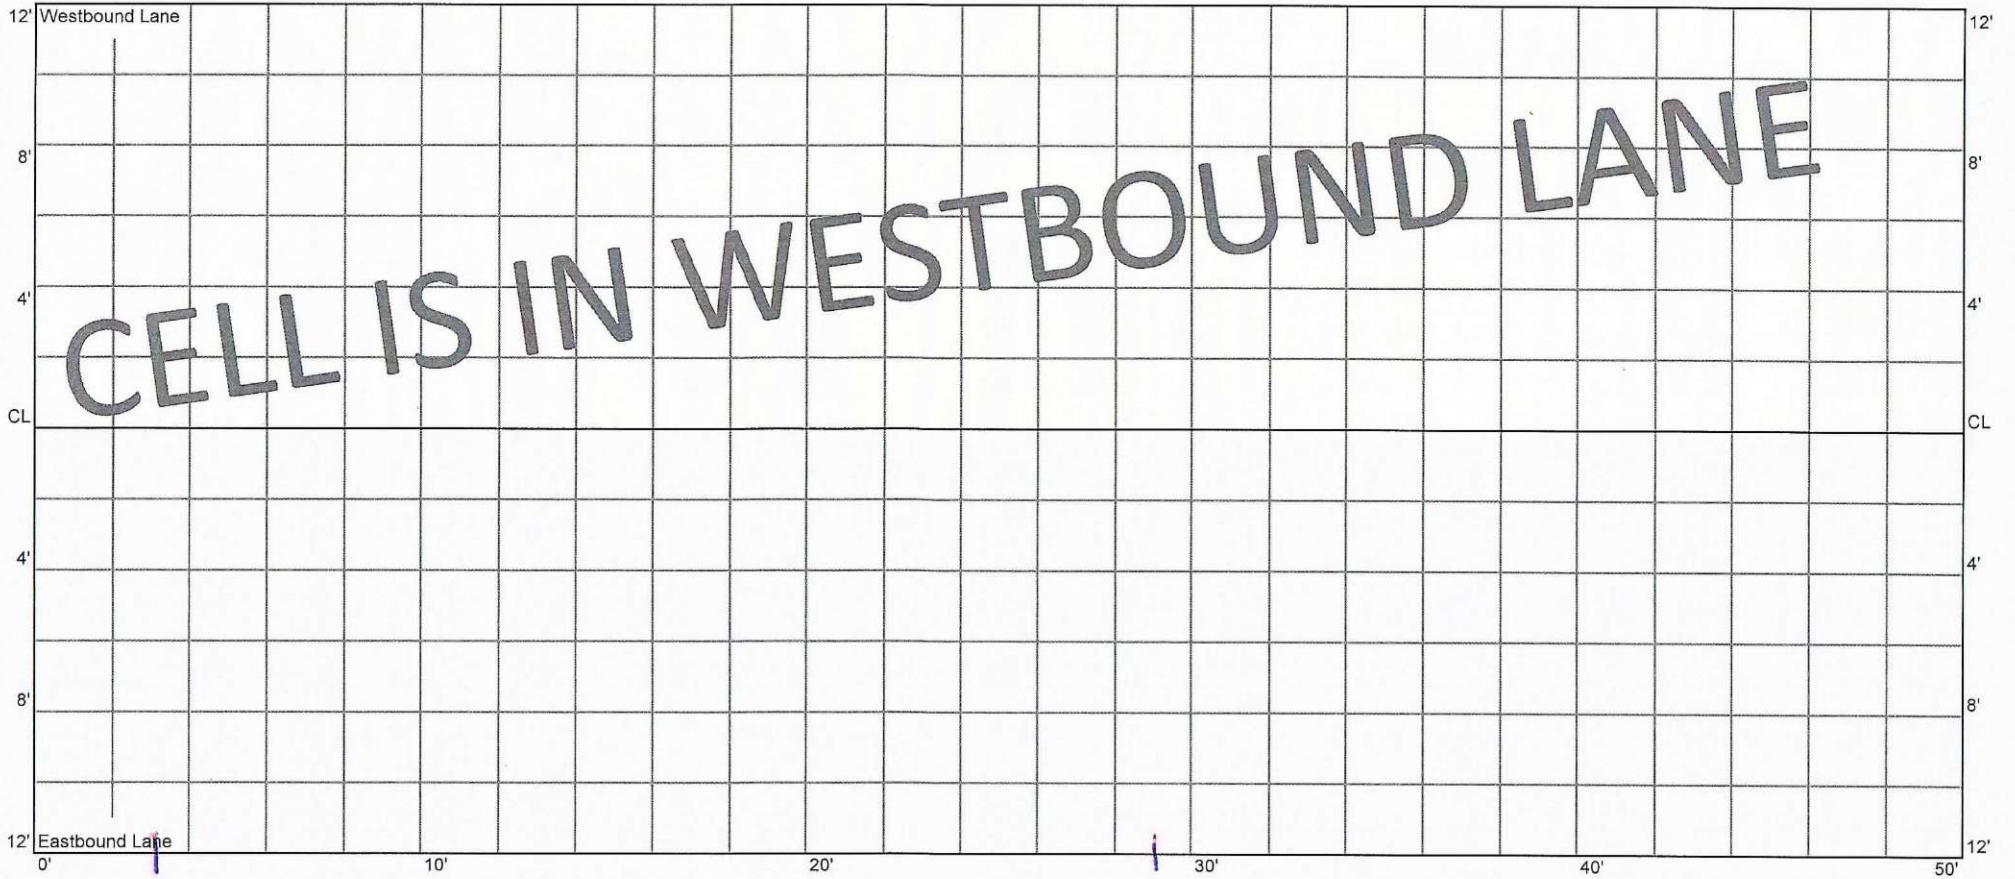

12' Westbound Lane

12'

8'

8'

4'

4'

CL

CL

4'

4'

8'

8'

12' Eastbound Lane


12'

0' 10' 20' 30' 40' 50'

CELL 7006W
400 - 450 ft

28+50


28+00

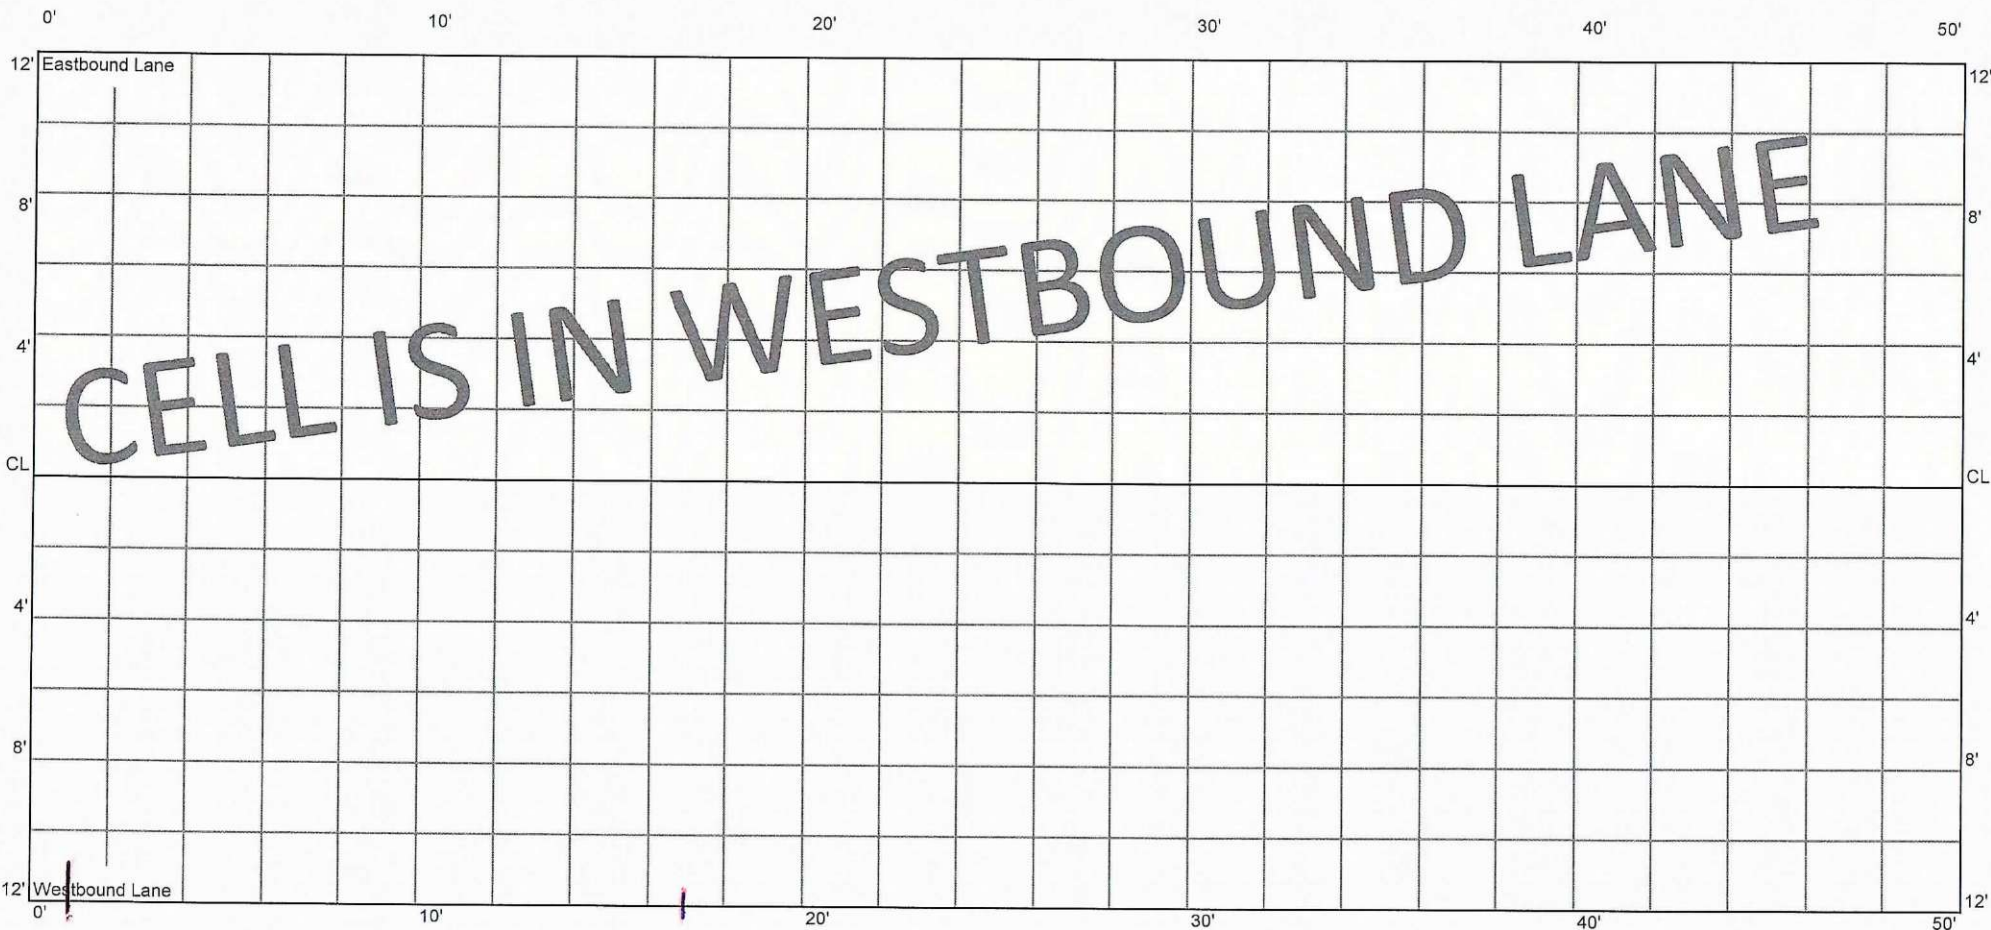

CELL 7006W
450 - 500 ft

28+00

27+50

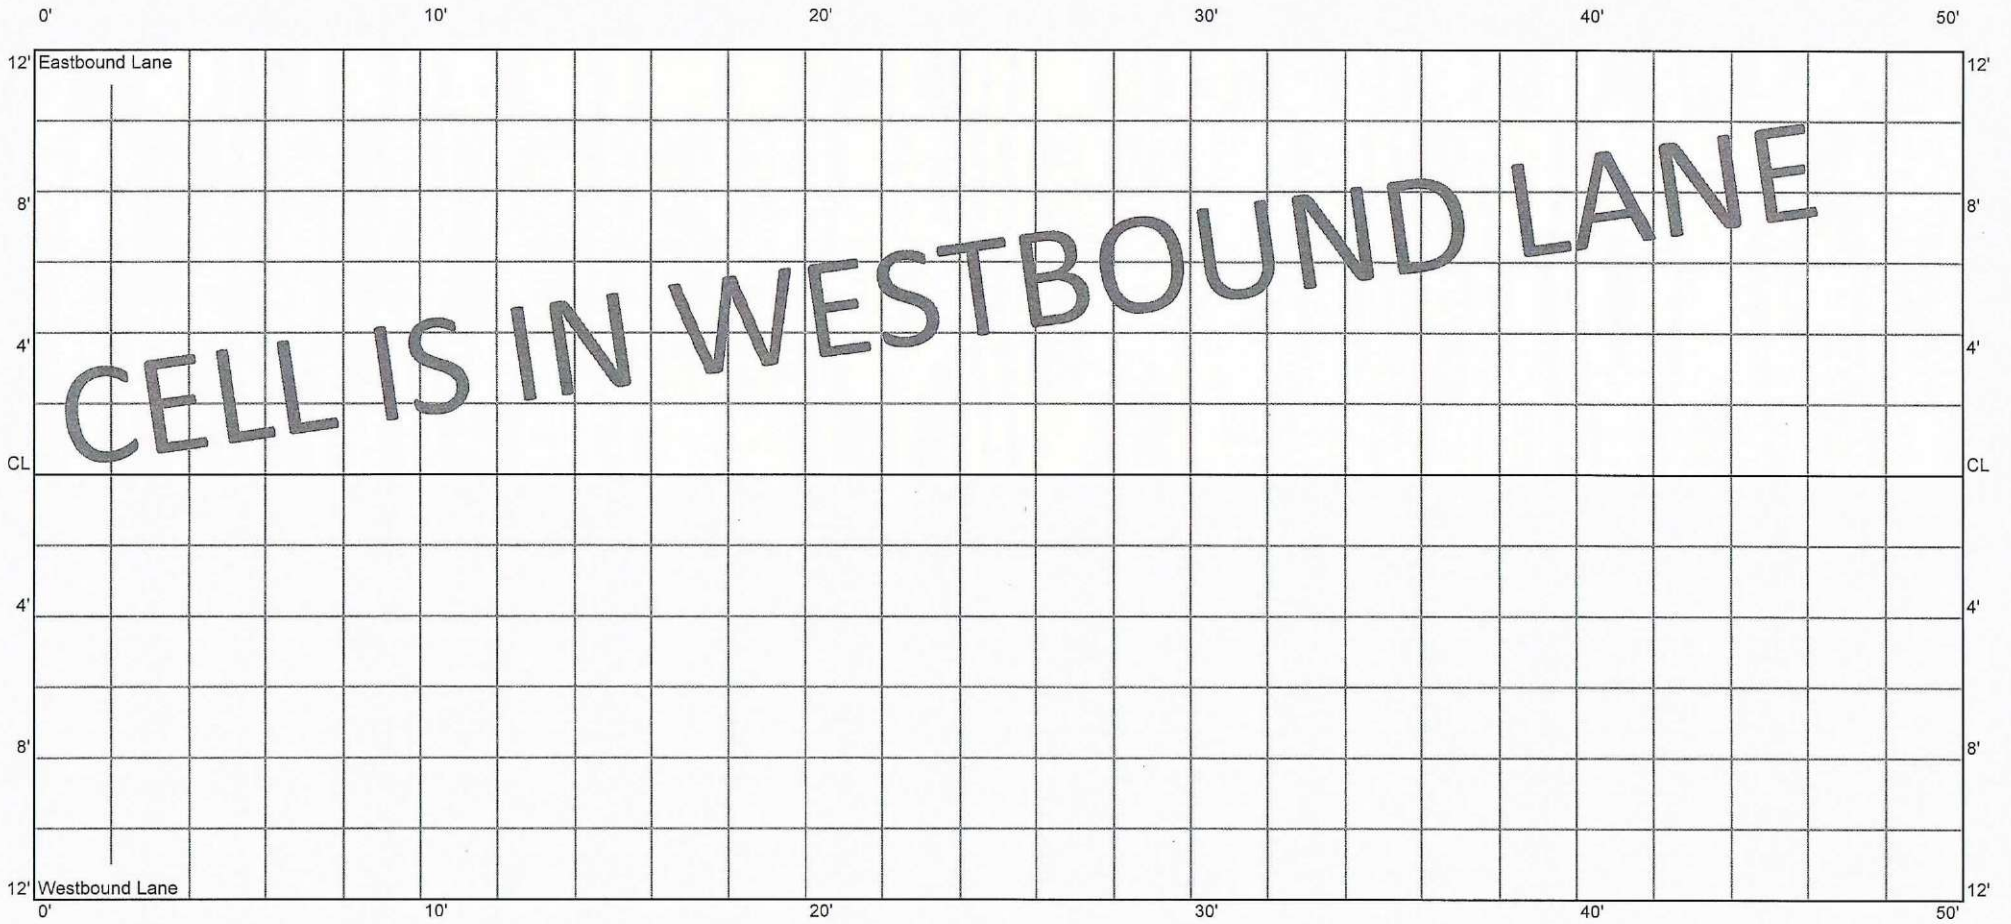

CELL 7006W
500 - 550 ft

27+50

27+25

27+00

0' 10' 20' 25' 30' 40' 50'

