


5.28.20 E.J. - No Distress
10.14.20 - No Distress
1.4.21 - No Distress

File 707H ST
8.25.21

CELL 7007W
0 - 50 ft


2021 - Est. 30 SHAR CRTS

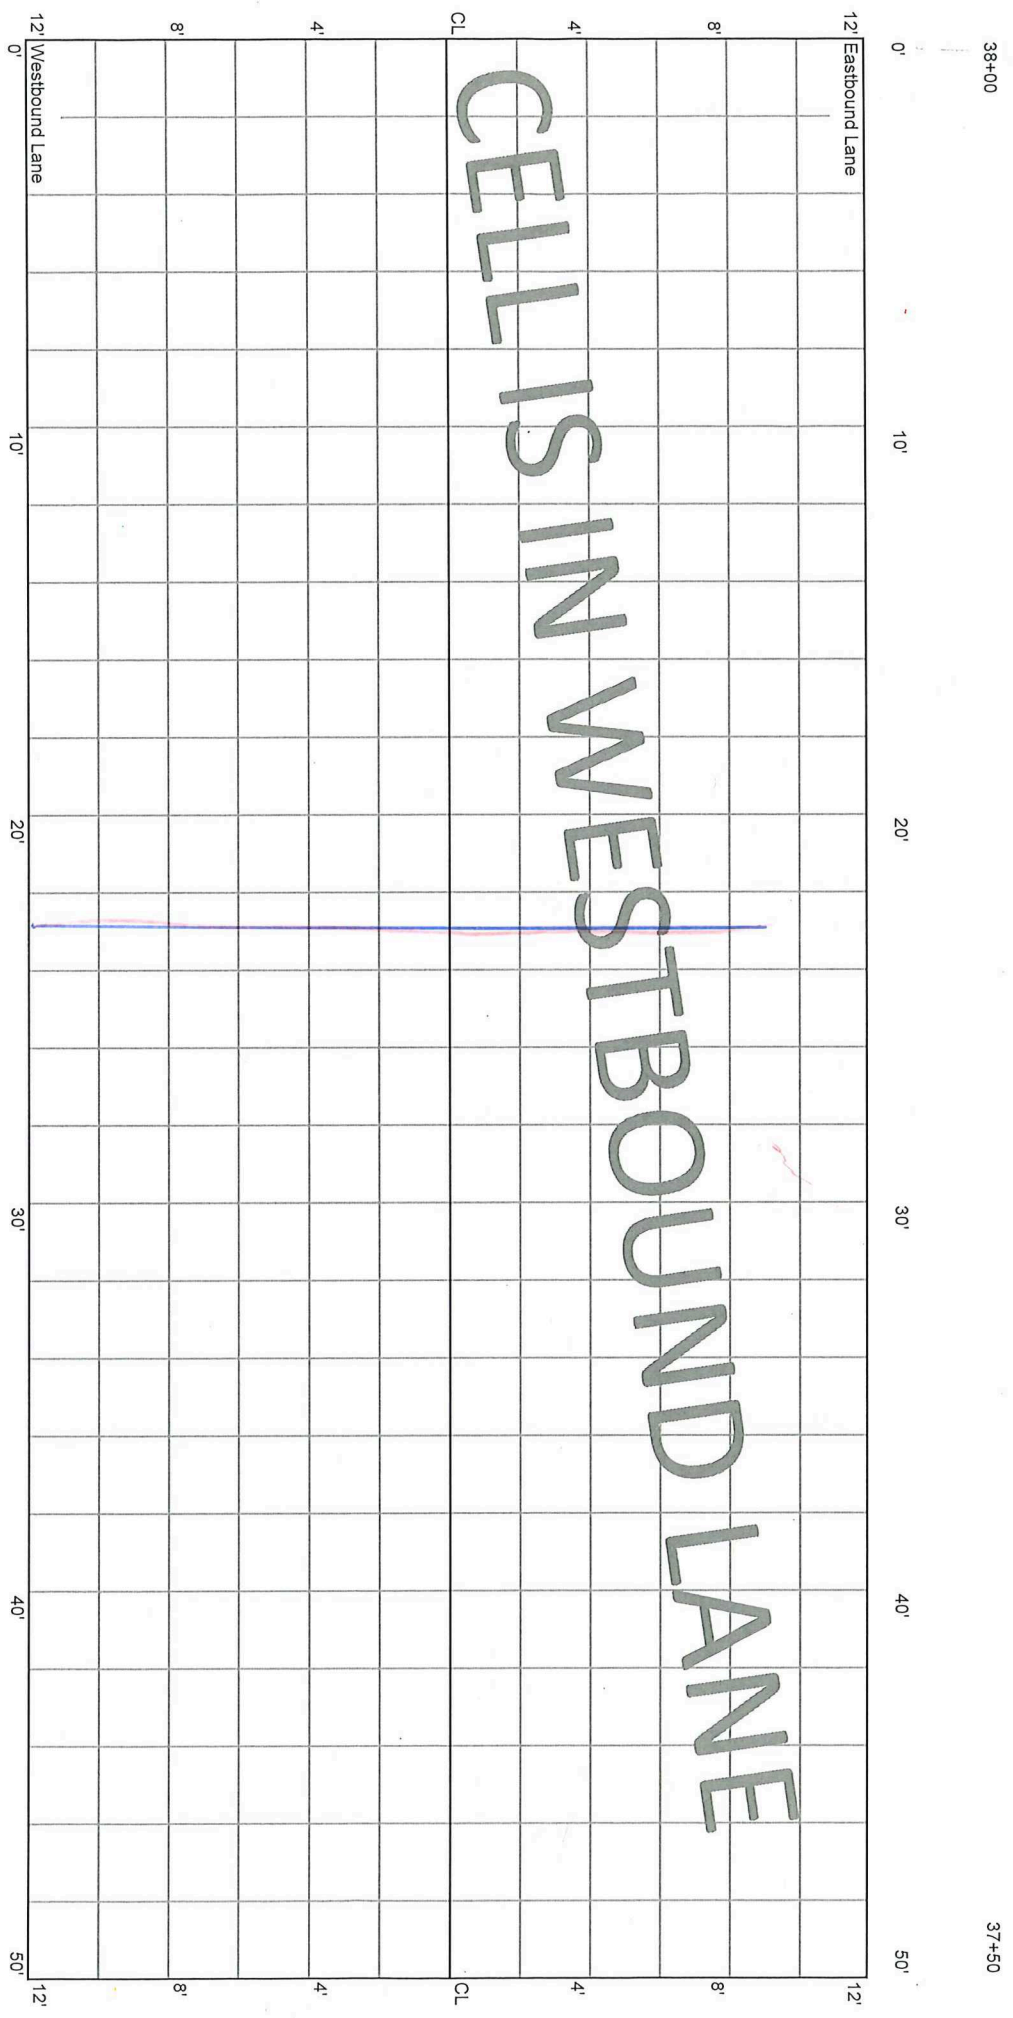

CELL 7007W
50 - 100 ft

37+50

37+00

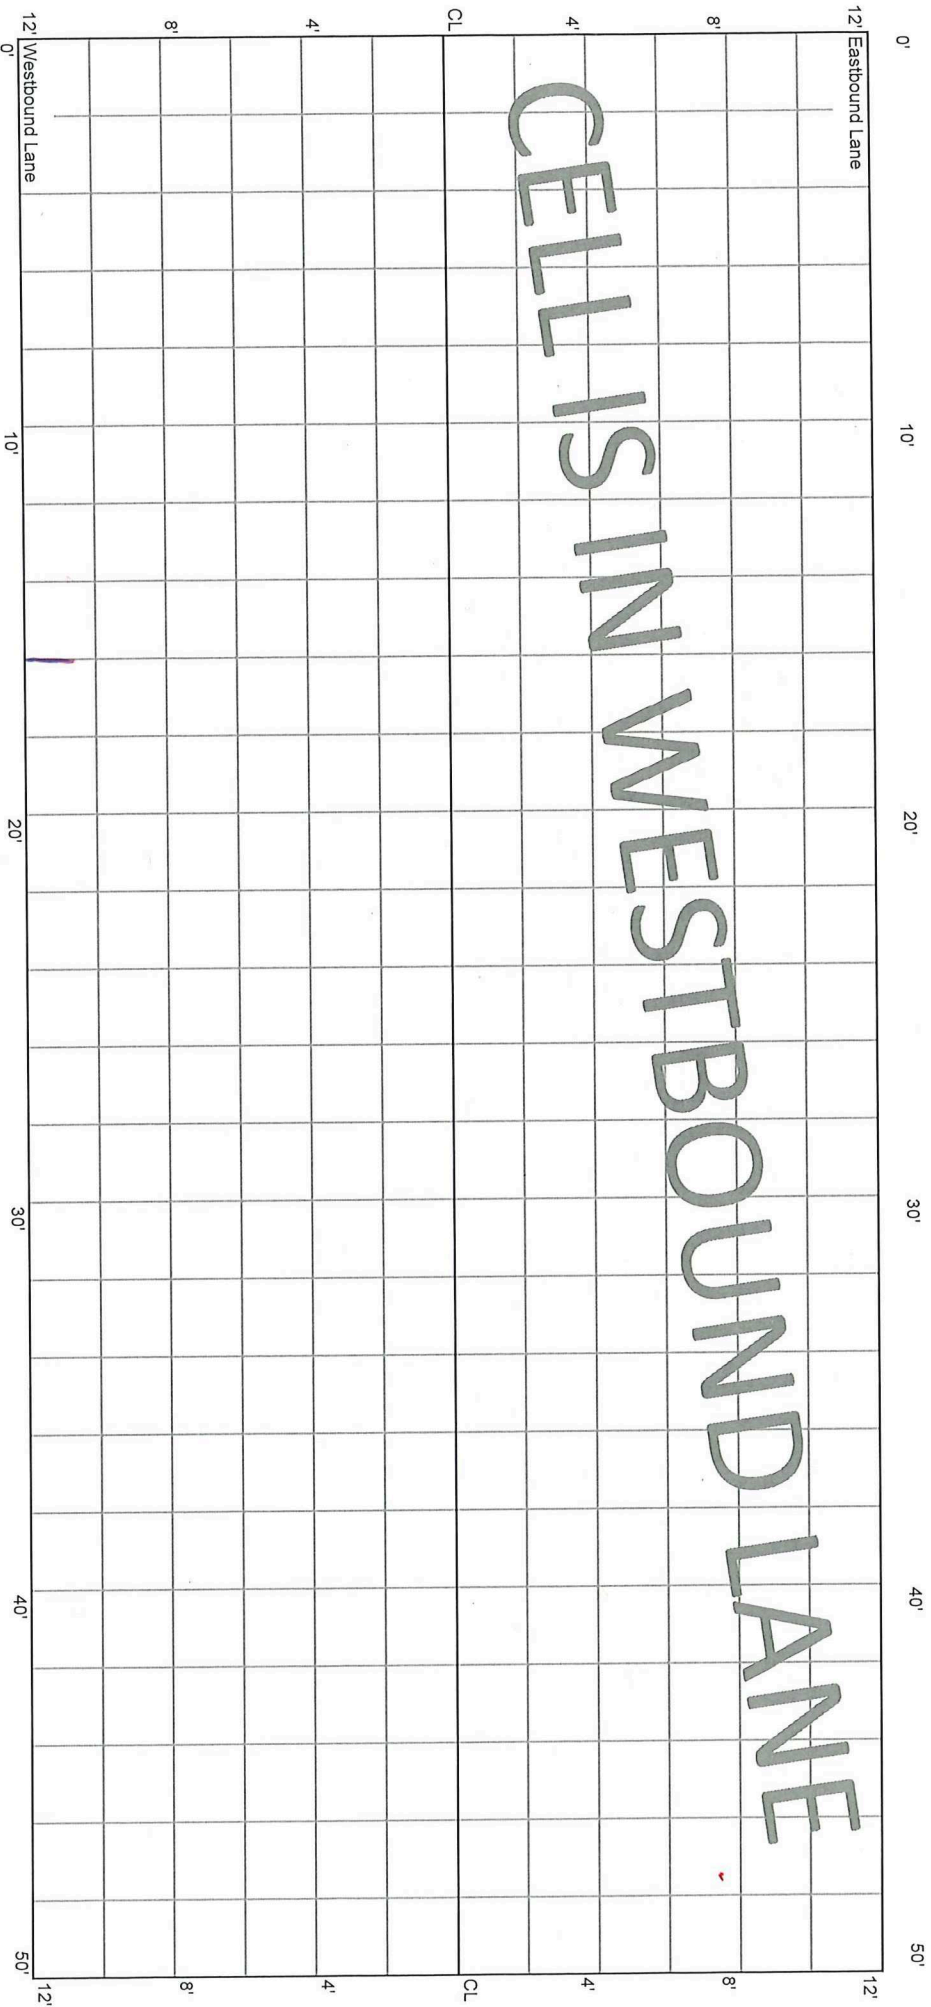


CELLS IN WESTBOUND LANE

CELL 7007W
100 - 150 ft

37+00

36+50

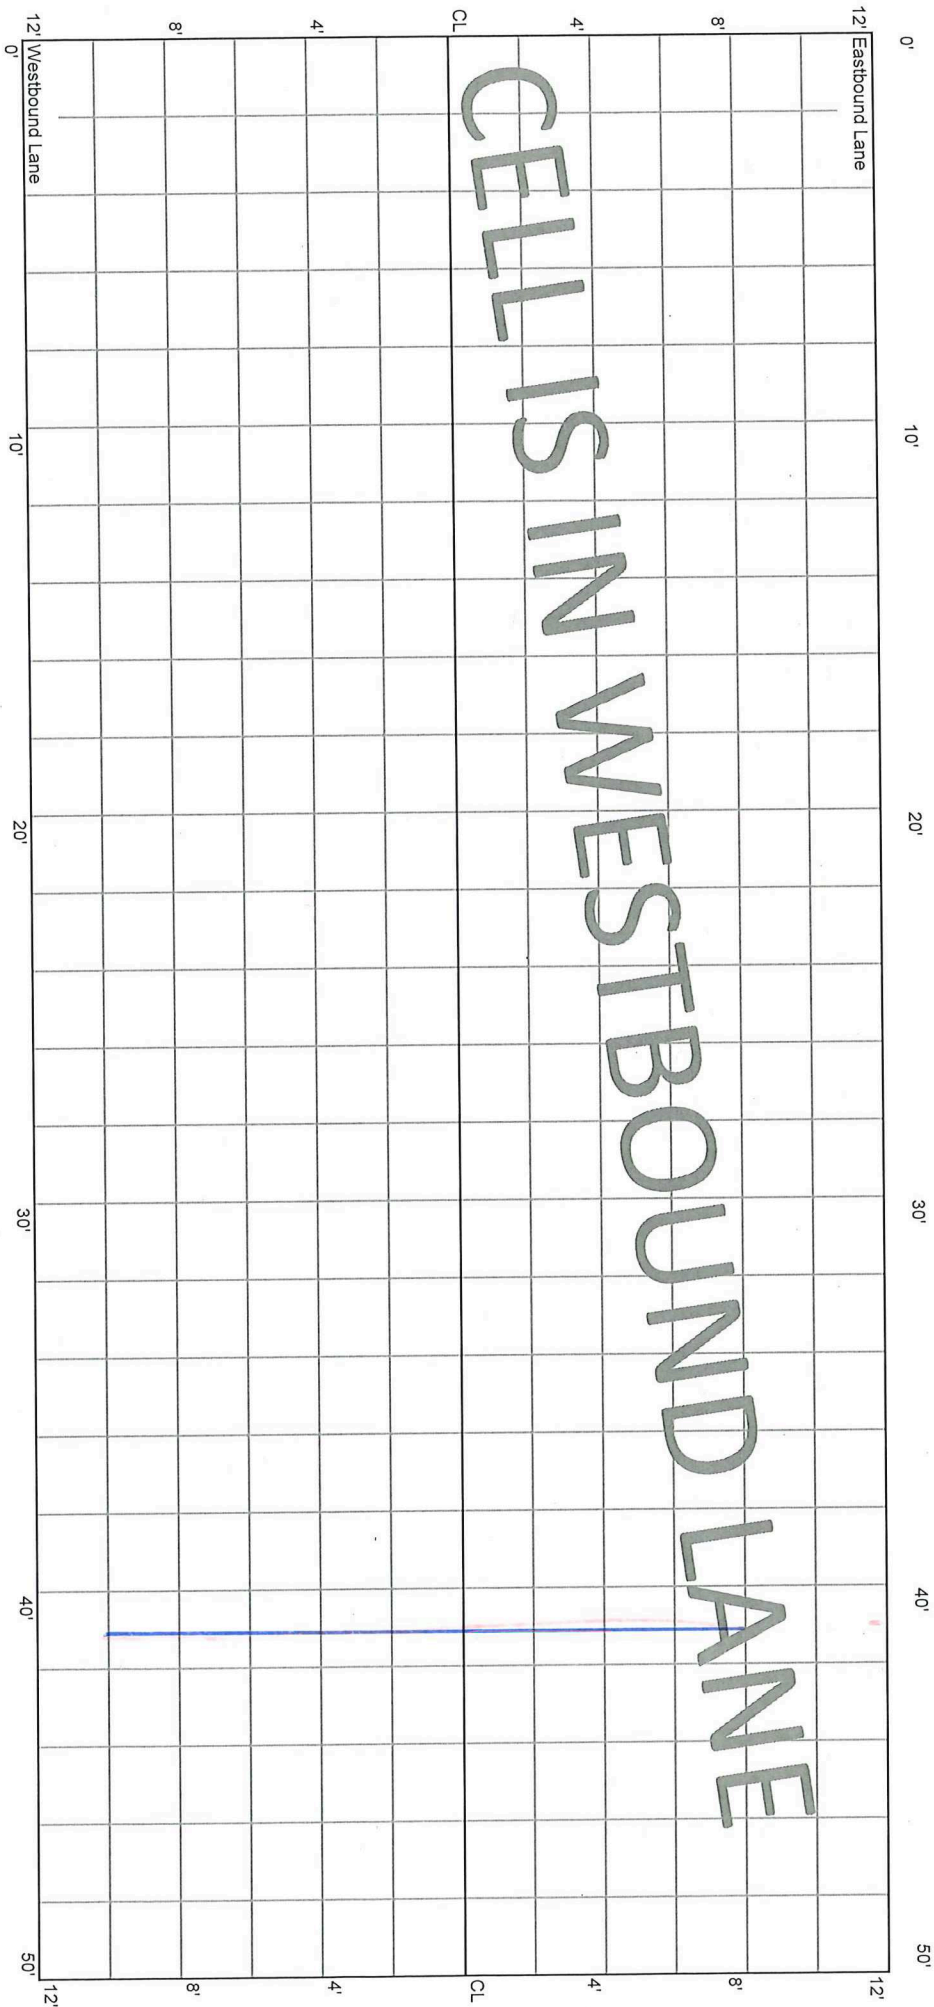

12' Eastbound Lane

12' Westbound Lane

CL


CELL IS IN WESTBOUND LANE

CL

CELL 7007W
150 - 200 ft

36+50


36+00

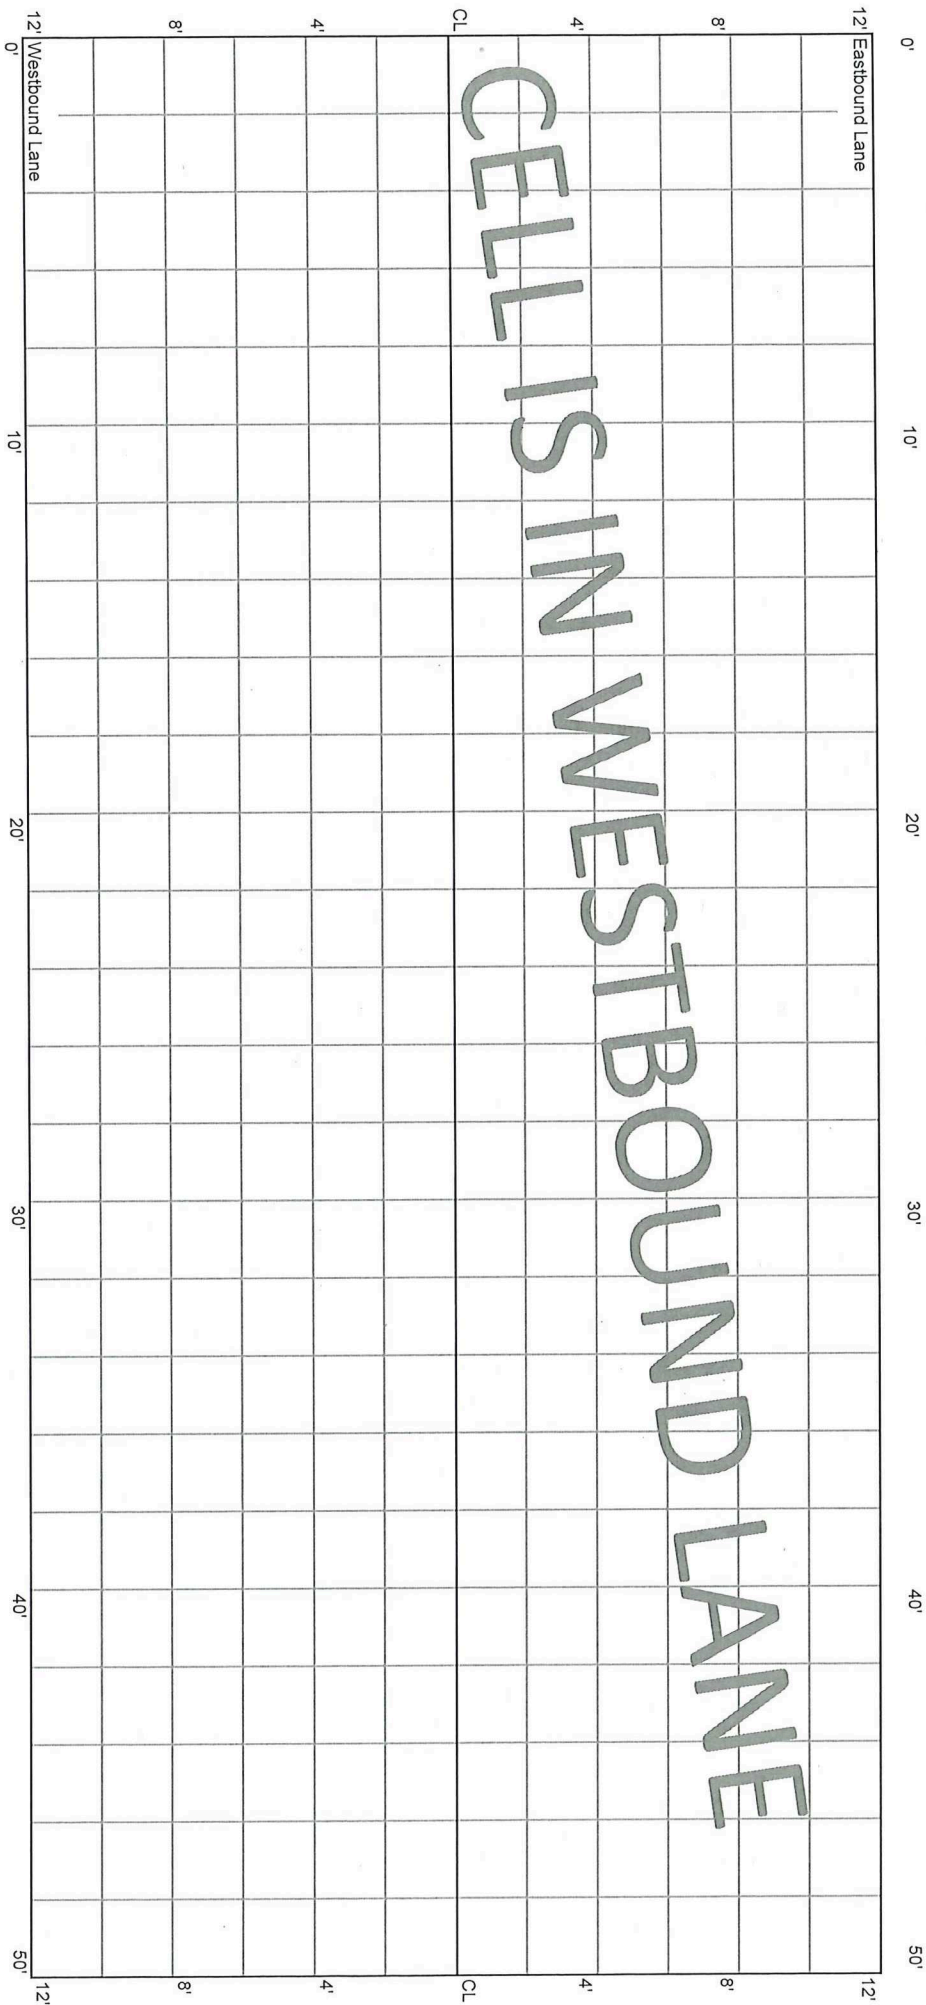

CELL 7007W
200 - 250 ft

36+00

35+50

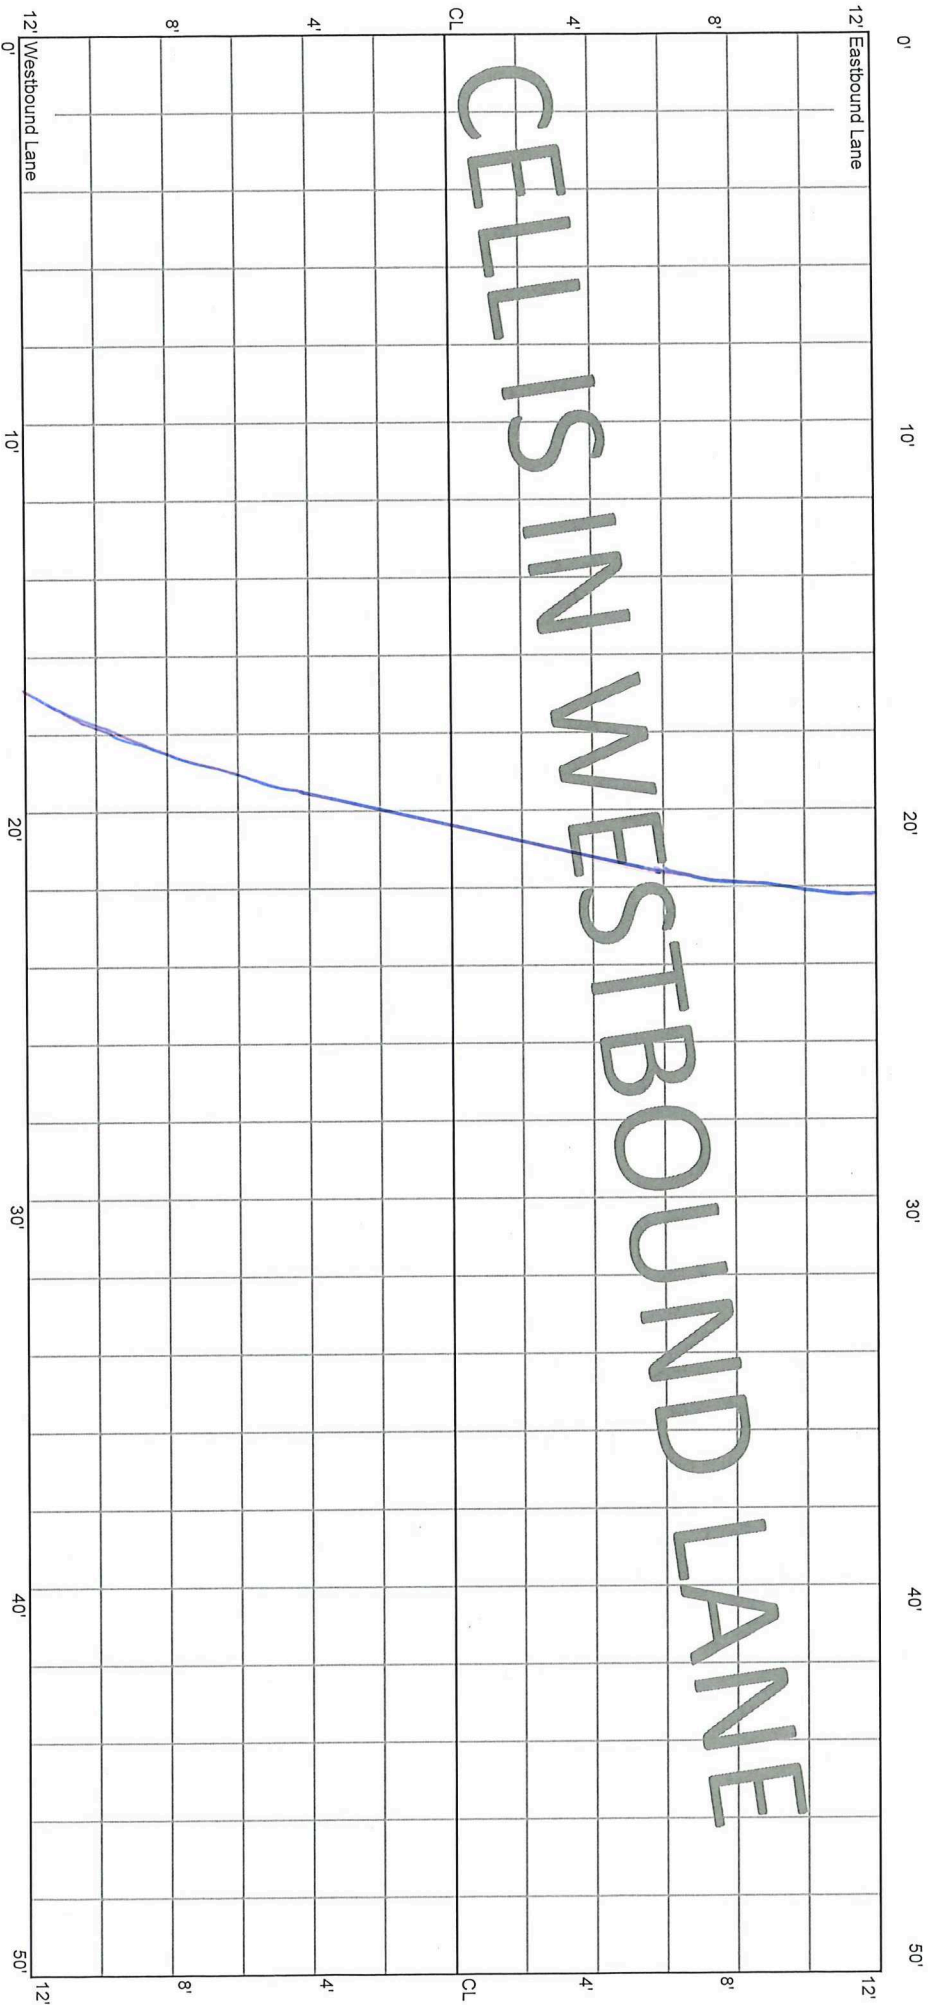


CELL 7007W
250 - 300 ft

35+50

35+30
CL KALLAND


35+00

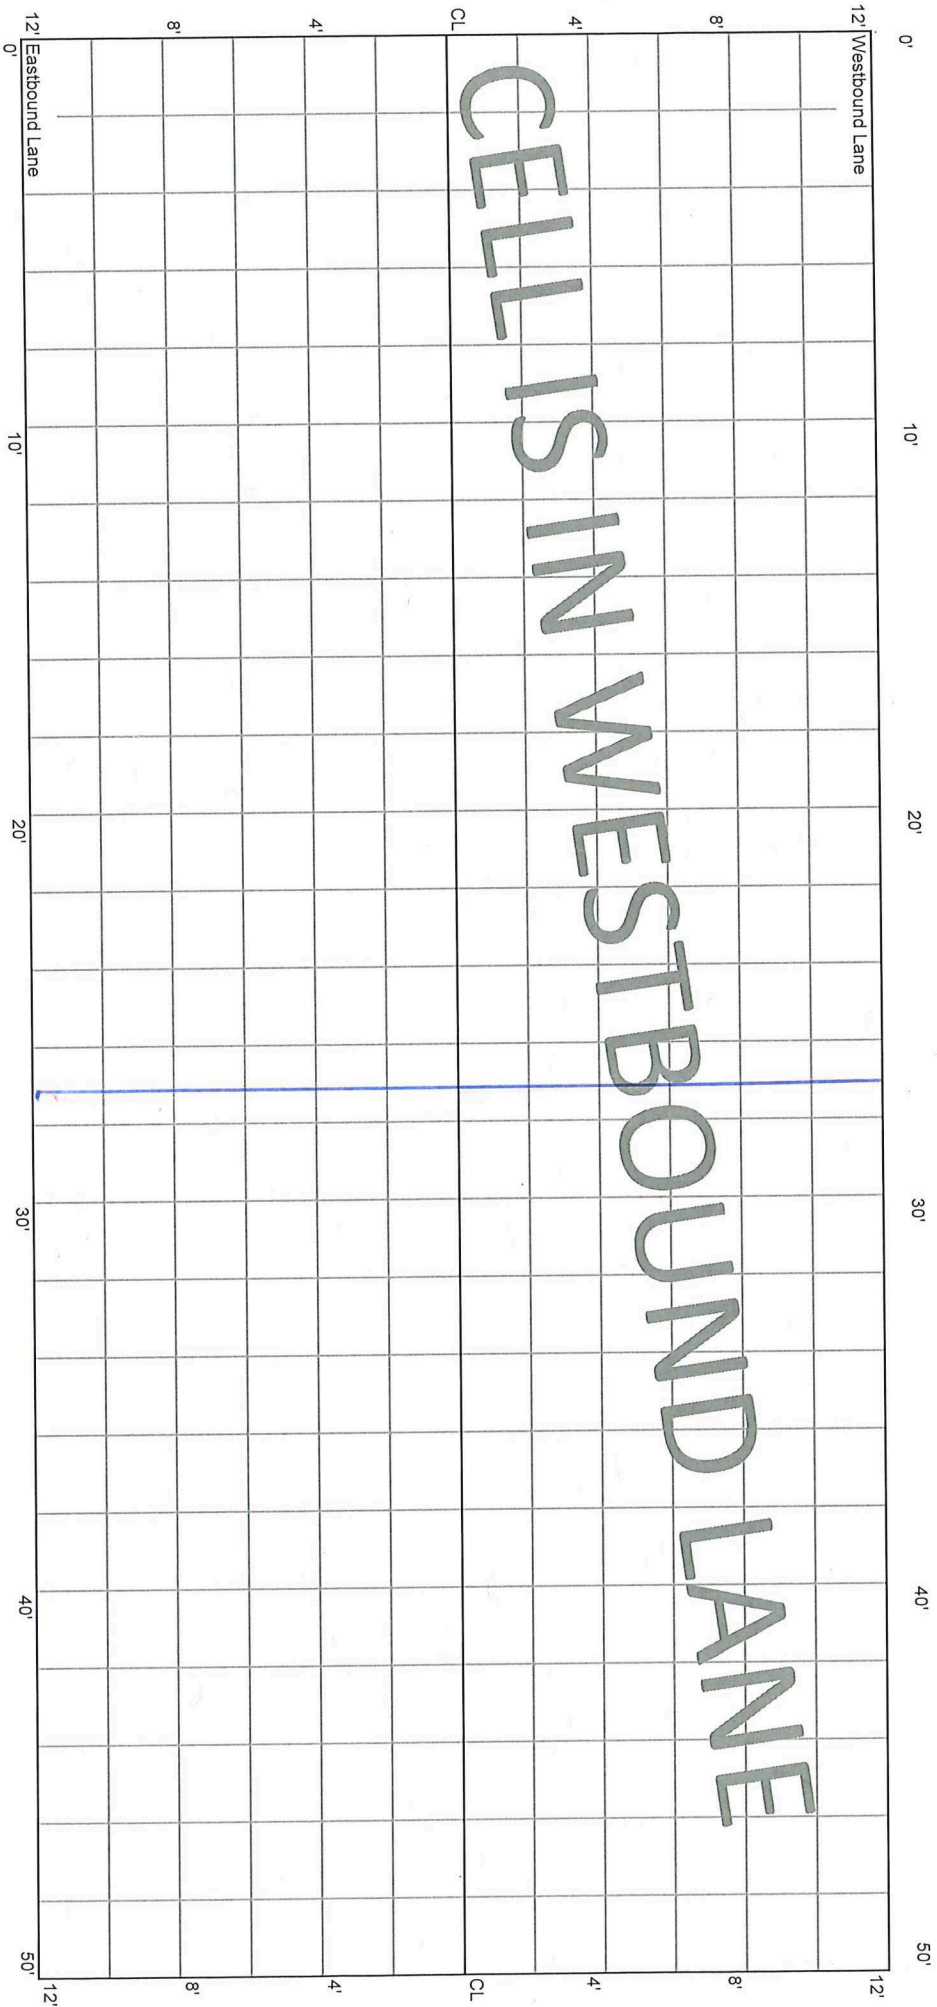

CELL 7007W
300 - 350 ft

35+00


34+50

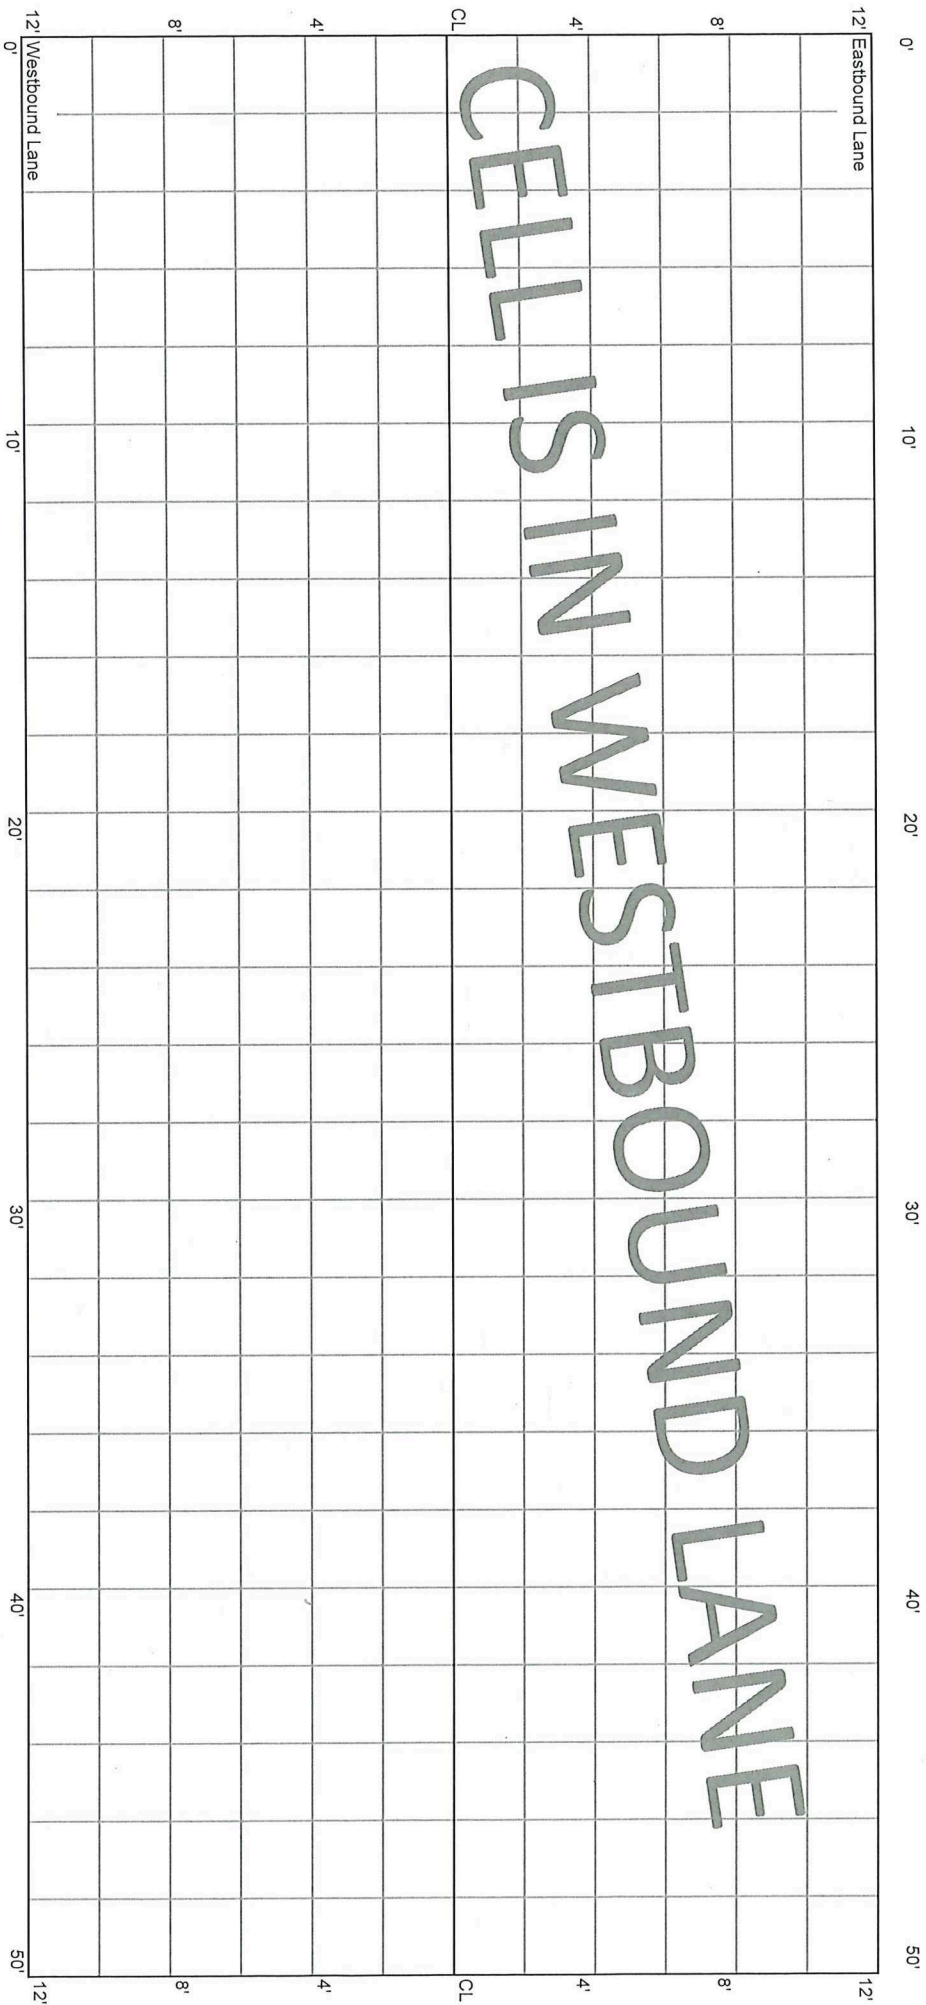

CELL 7007W
350 - 400 ft

34+50


34+00

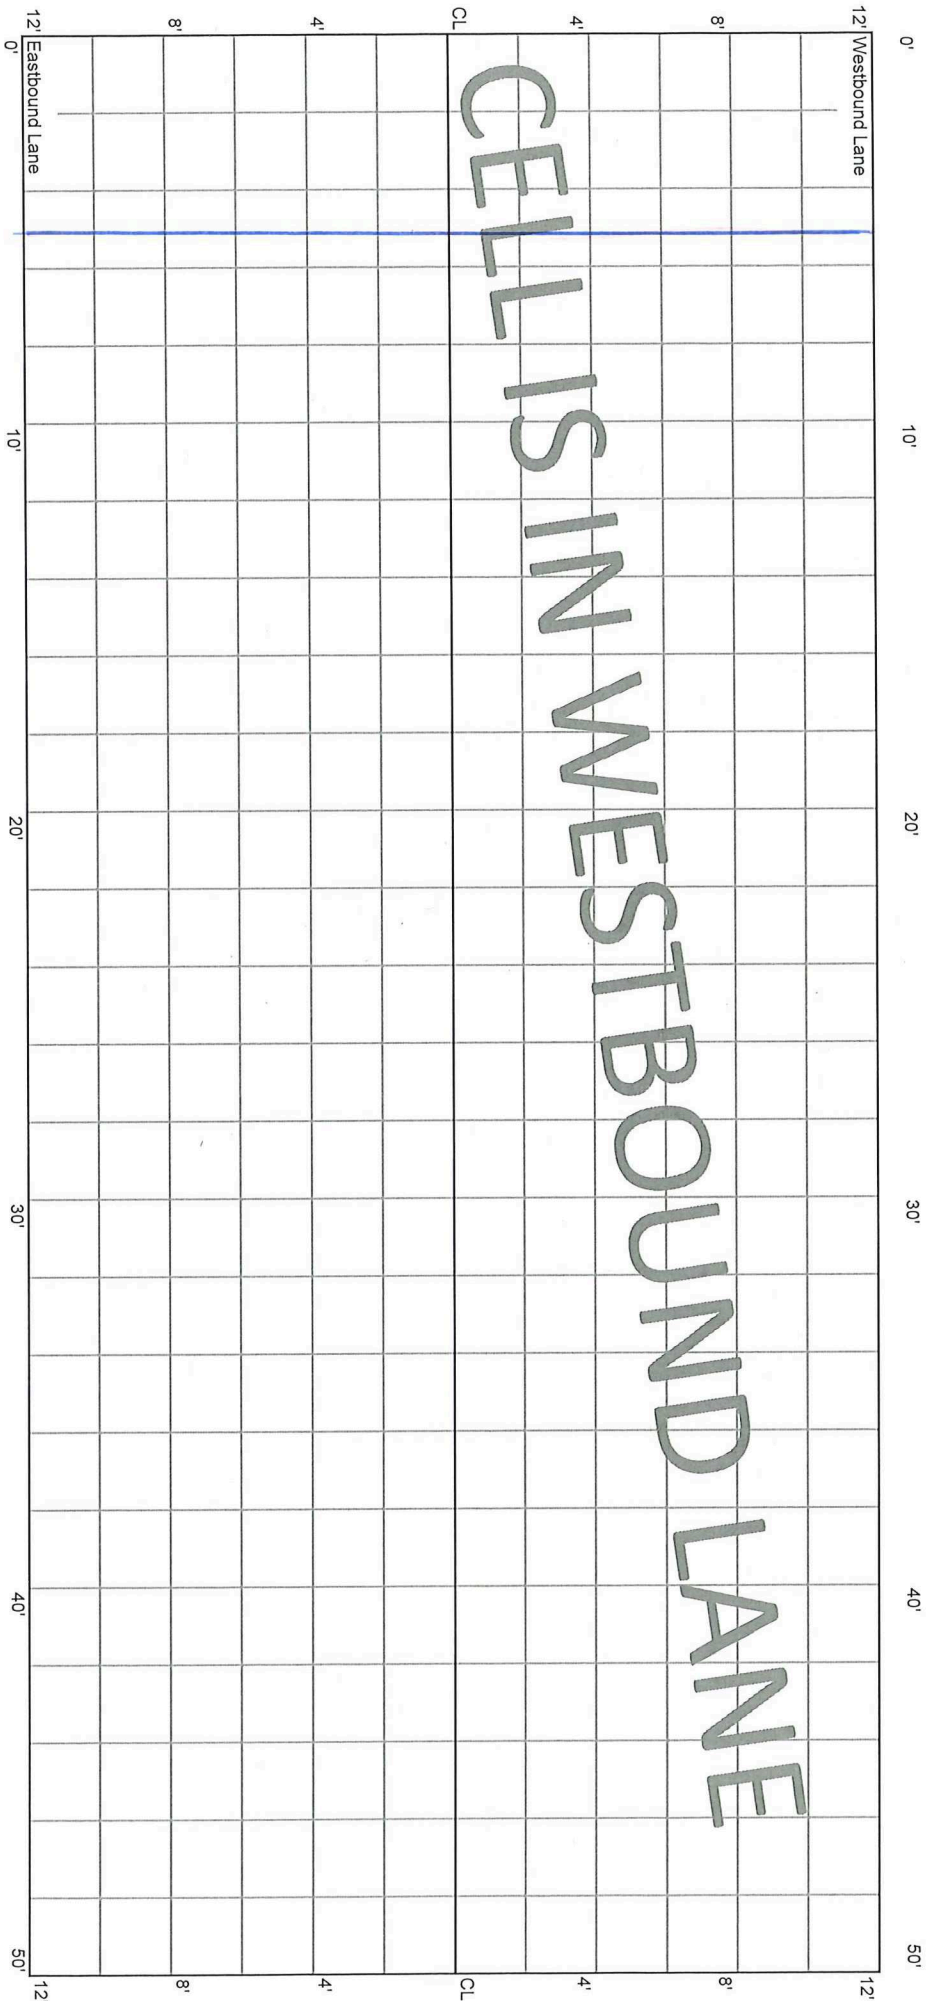

CELL 7007W
400 - 450 ft

34+00


33+50

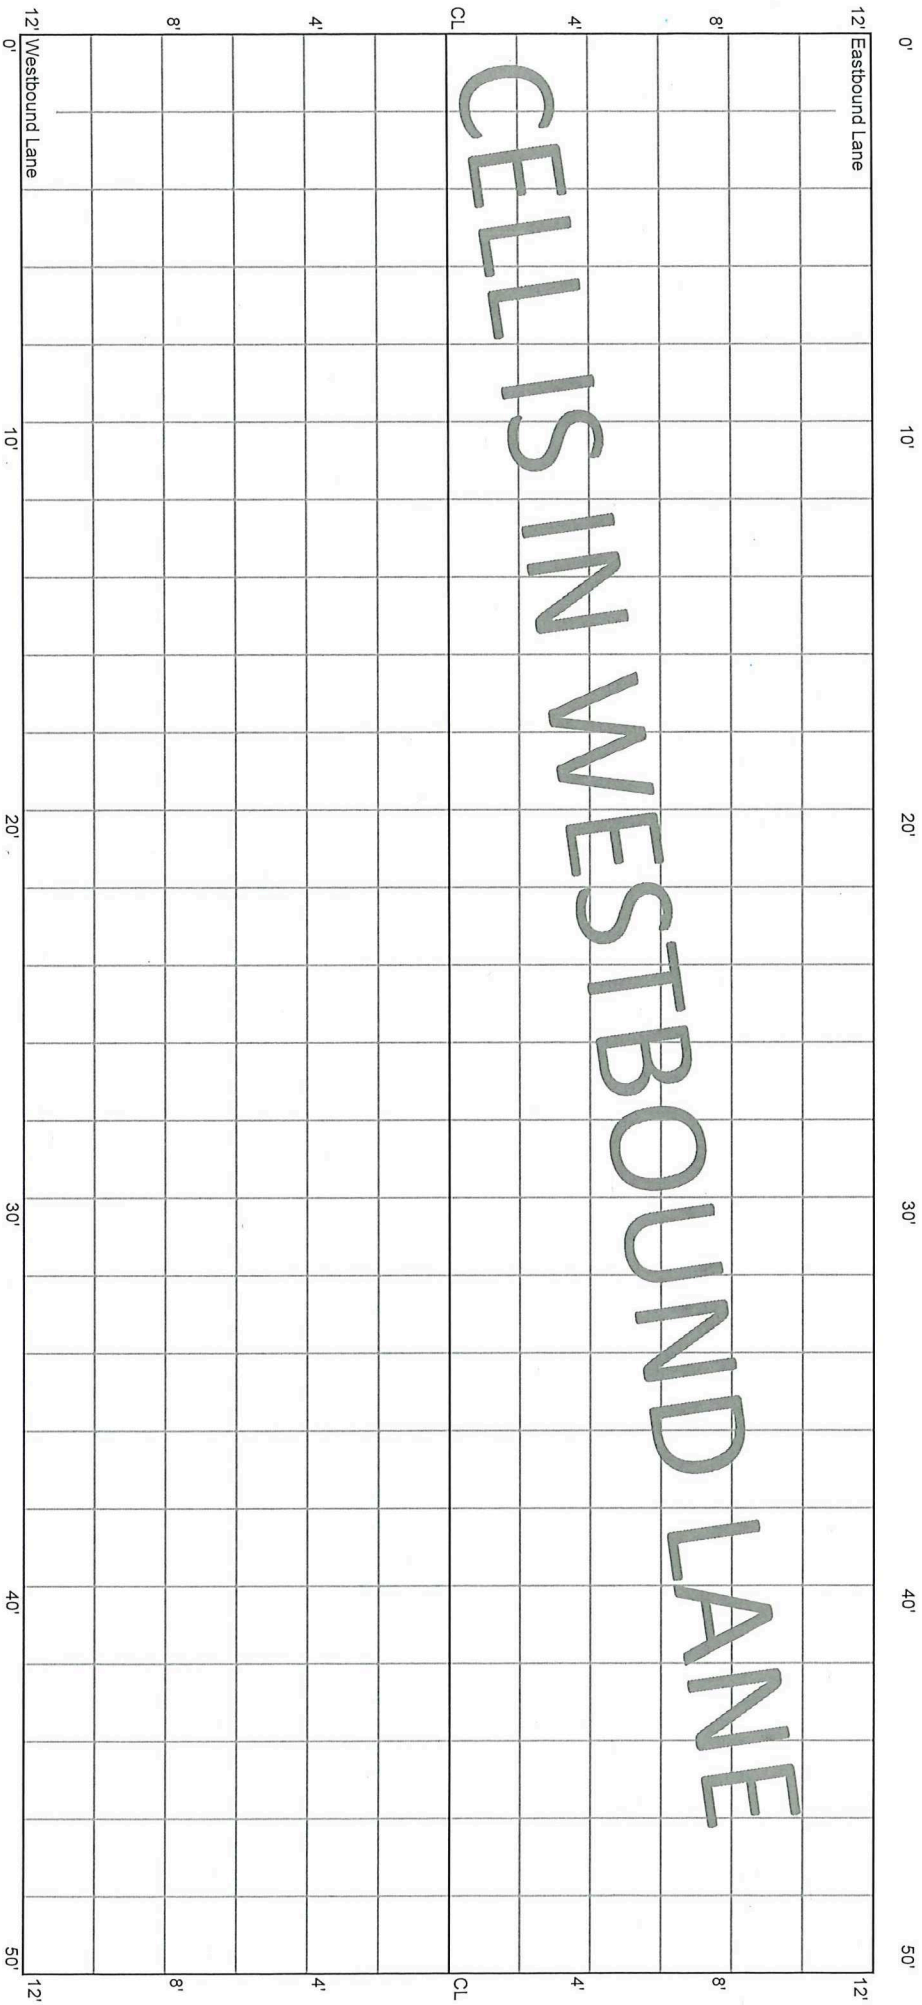

CELL 7007W
450 - 500 ft

33+50

33+00

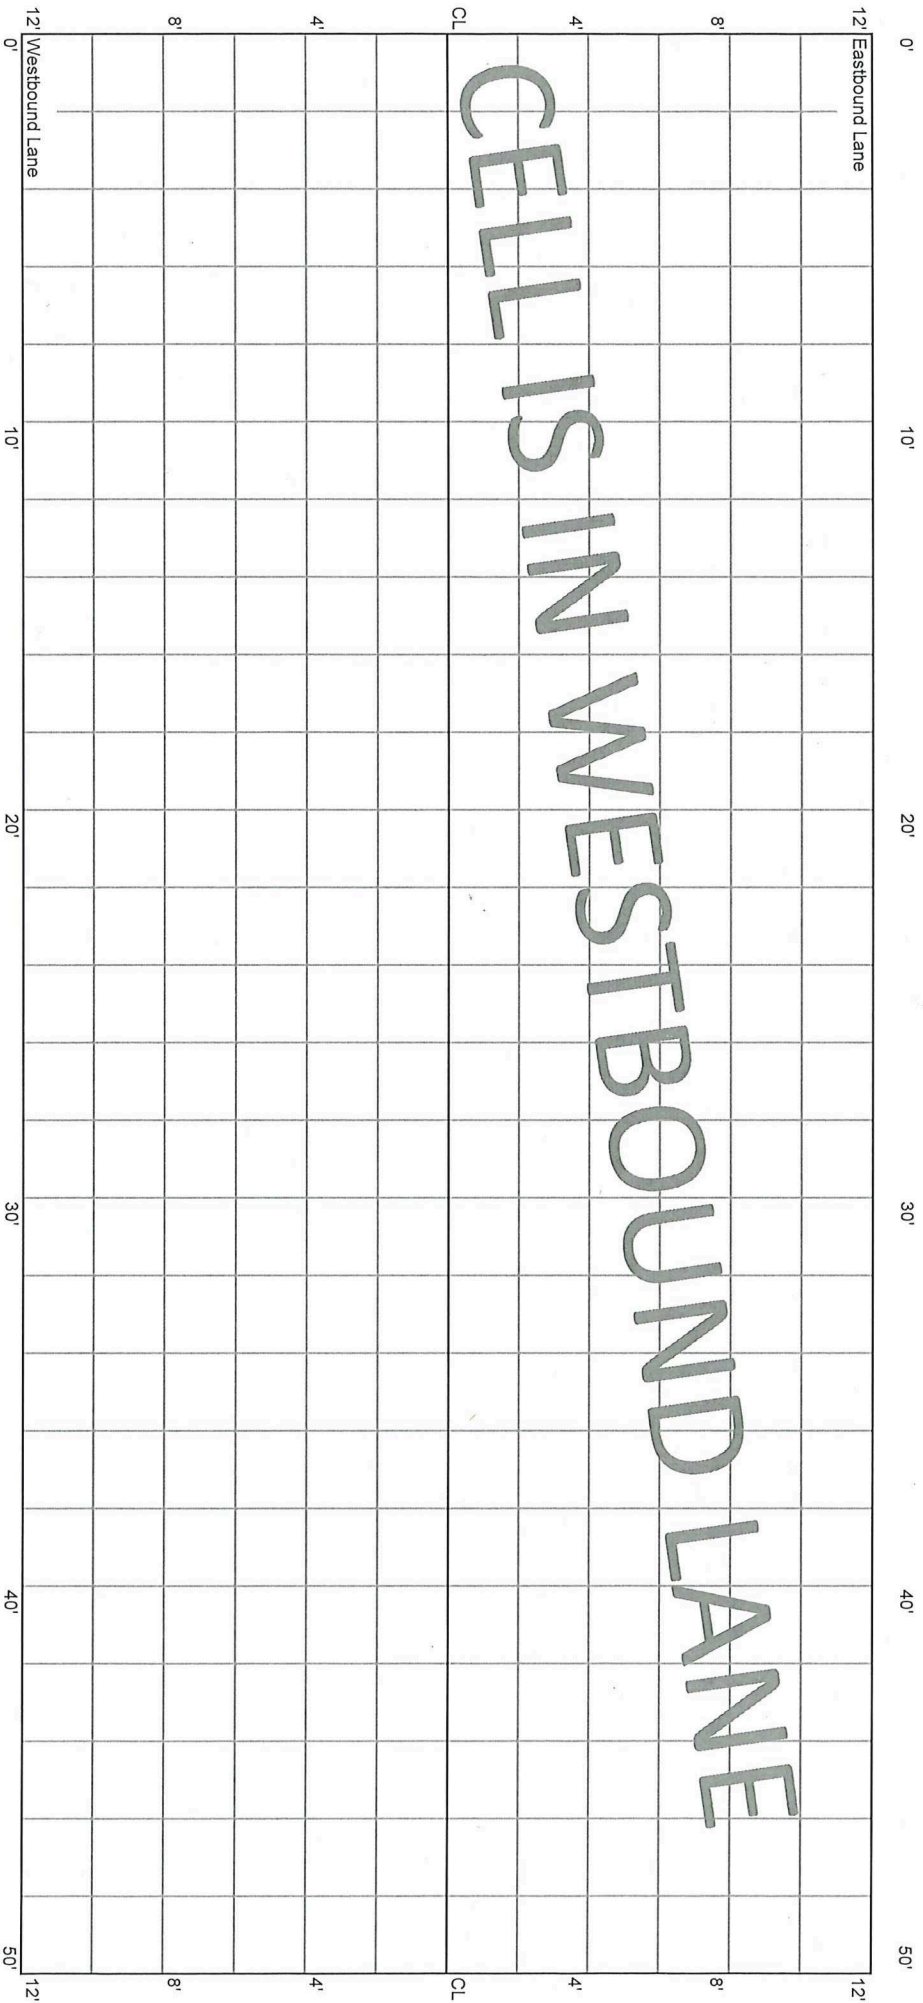

CELL 7007W
500 - 550 ft

33+00

32+75

32+50

