


5.28.20 E.J. - No Distress
10.14.20 - No Distress
1.4.21 - No Distress
8.25.21
1.13.22
8.31.22
38+00

E.J. - No Distress
- No Distress
- No Distress
8.31.22

CELL 7007W = Cell 7017W
0 - 50 ft

2021 - Est. 3054R CRT3

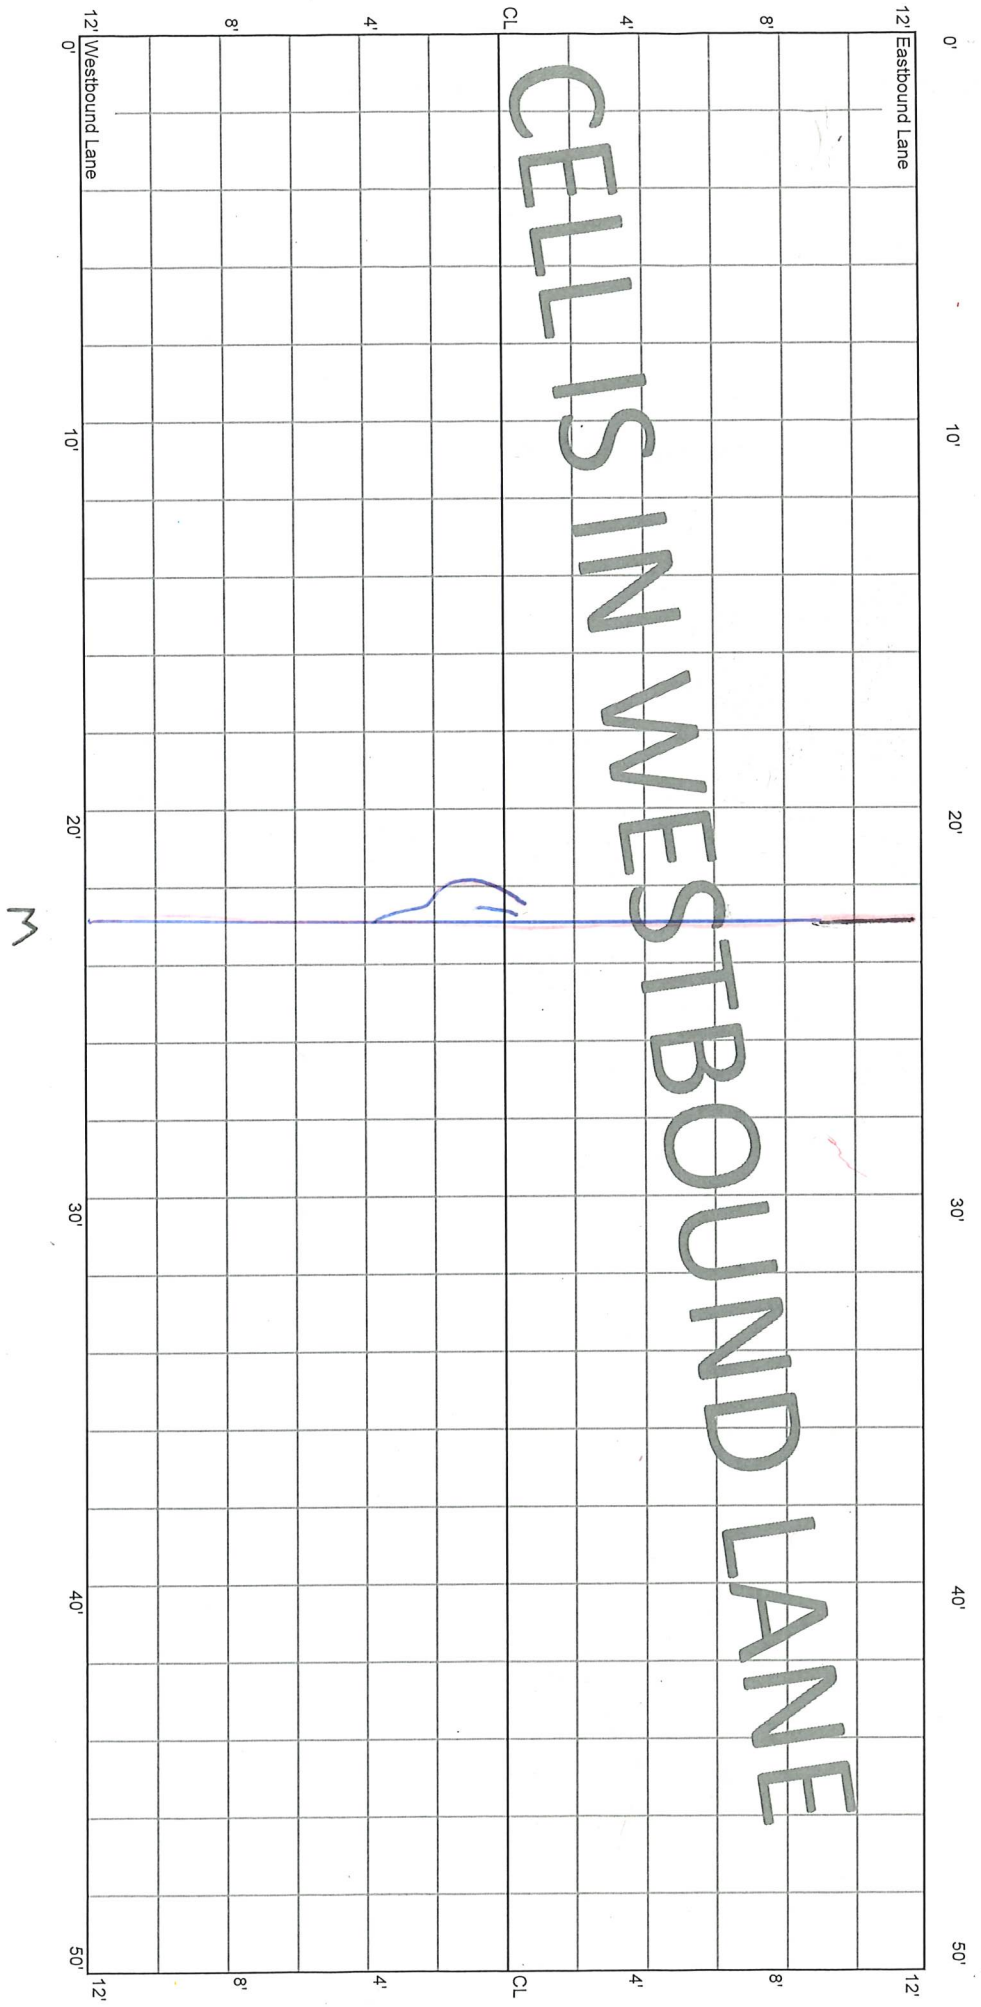


37+50

CELL 7007W
50 - 100 ft

37+50


37+00

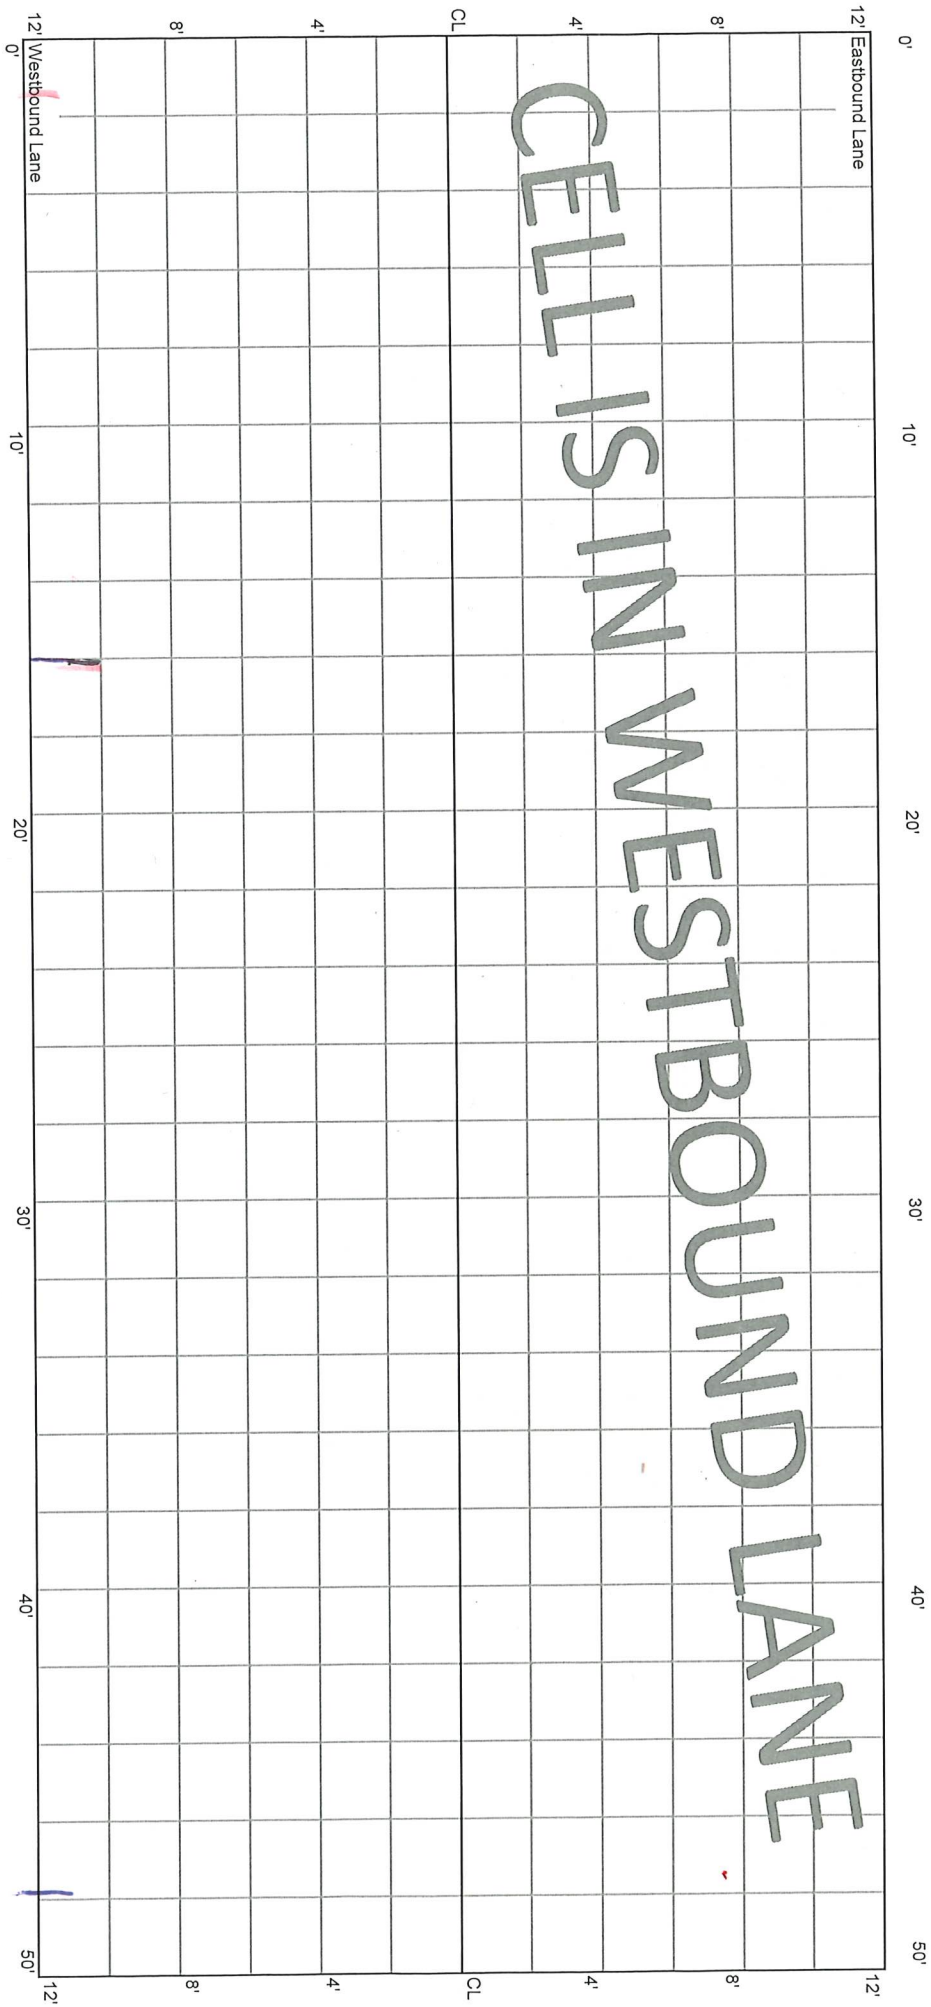

CELL 7007W
100 - 150 ft

37+00

36+50

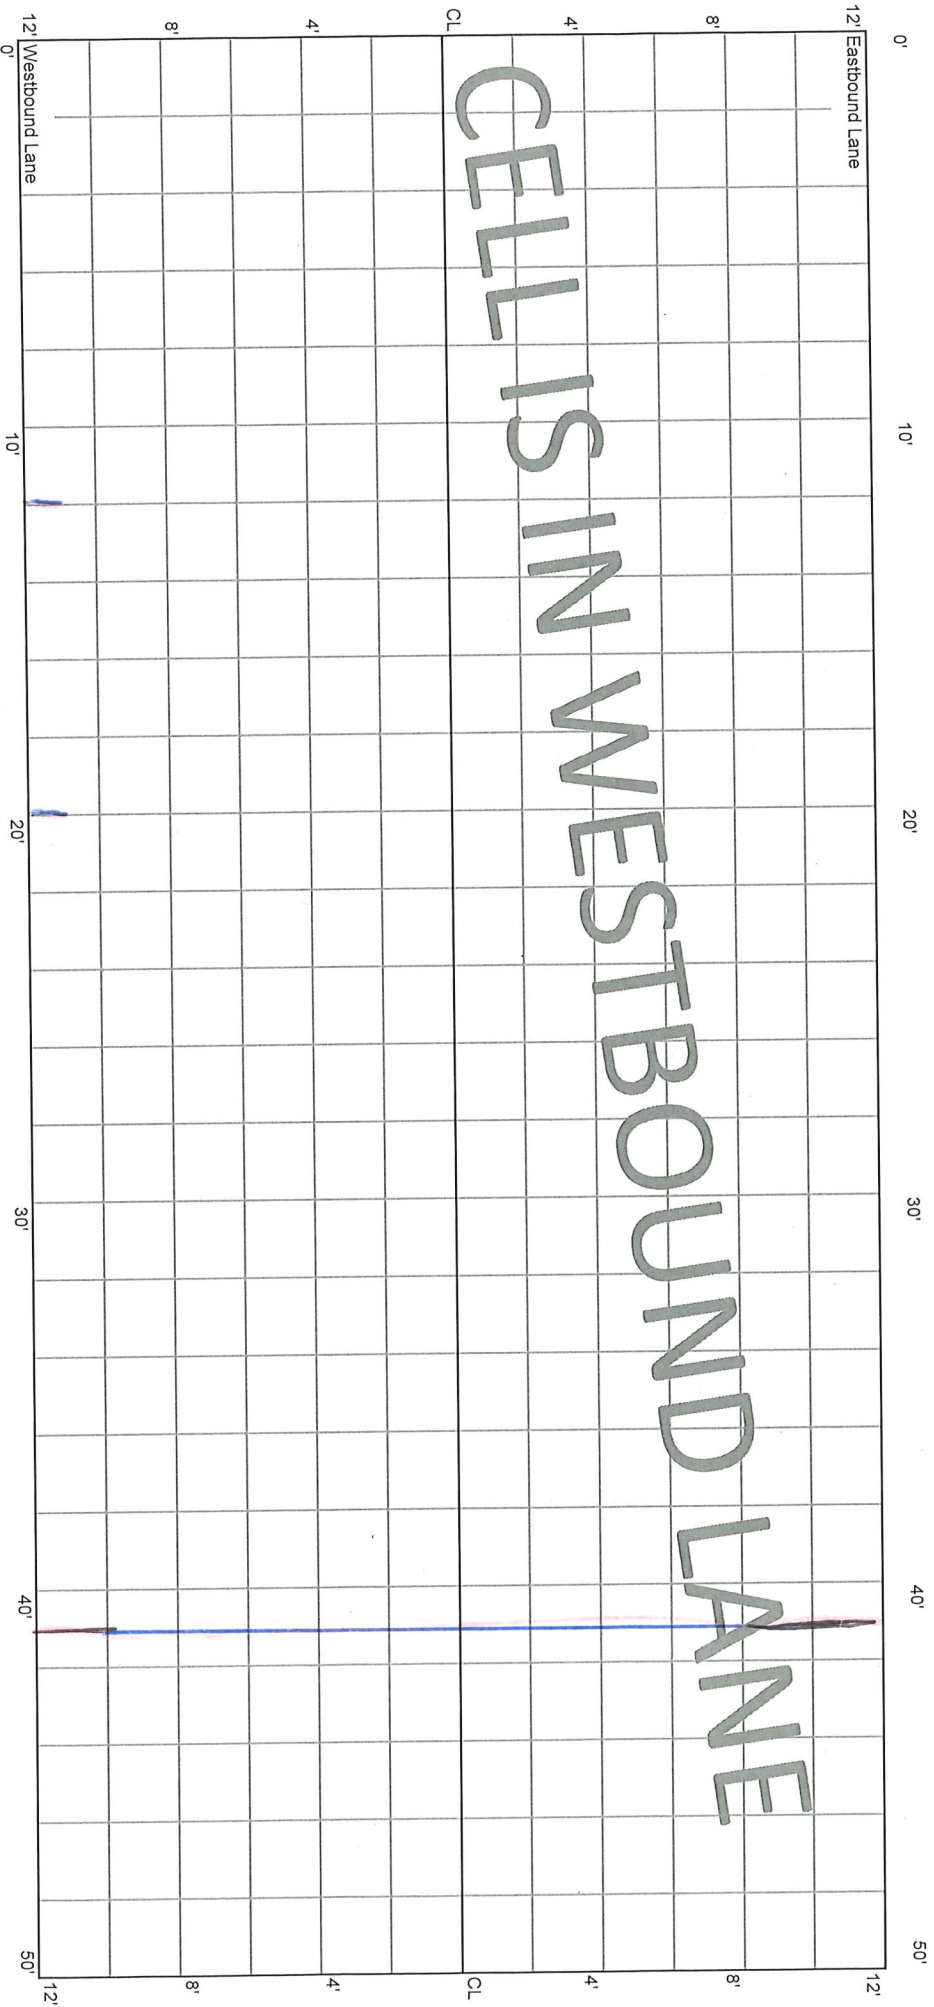


M

CELL 7007W
150 - 200 ft

36+50


36+00

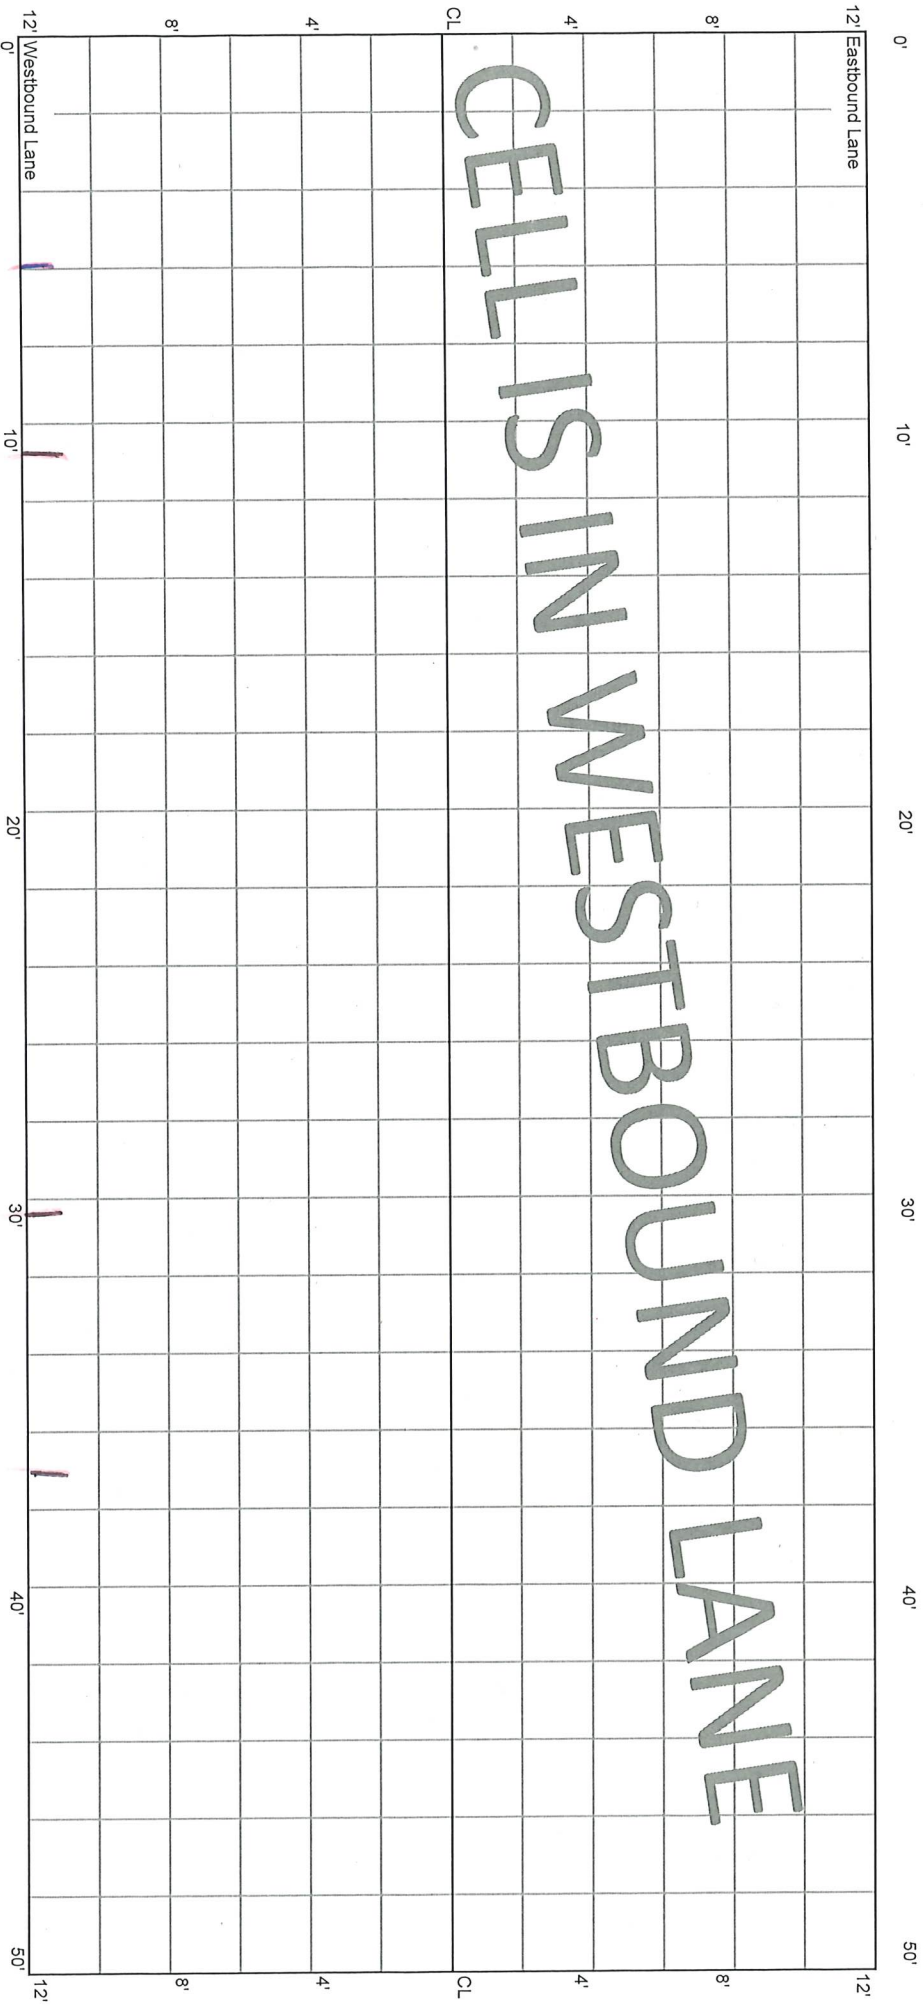

CELL 7007W
200 - 250 ft

36+00


35+50

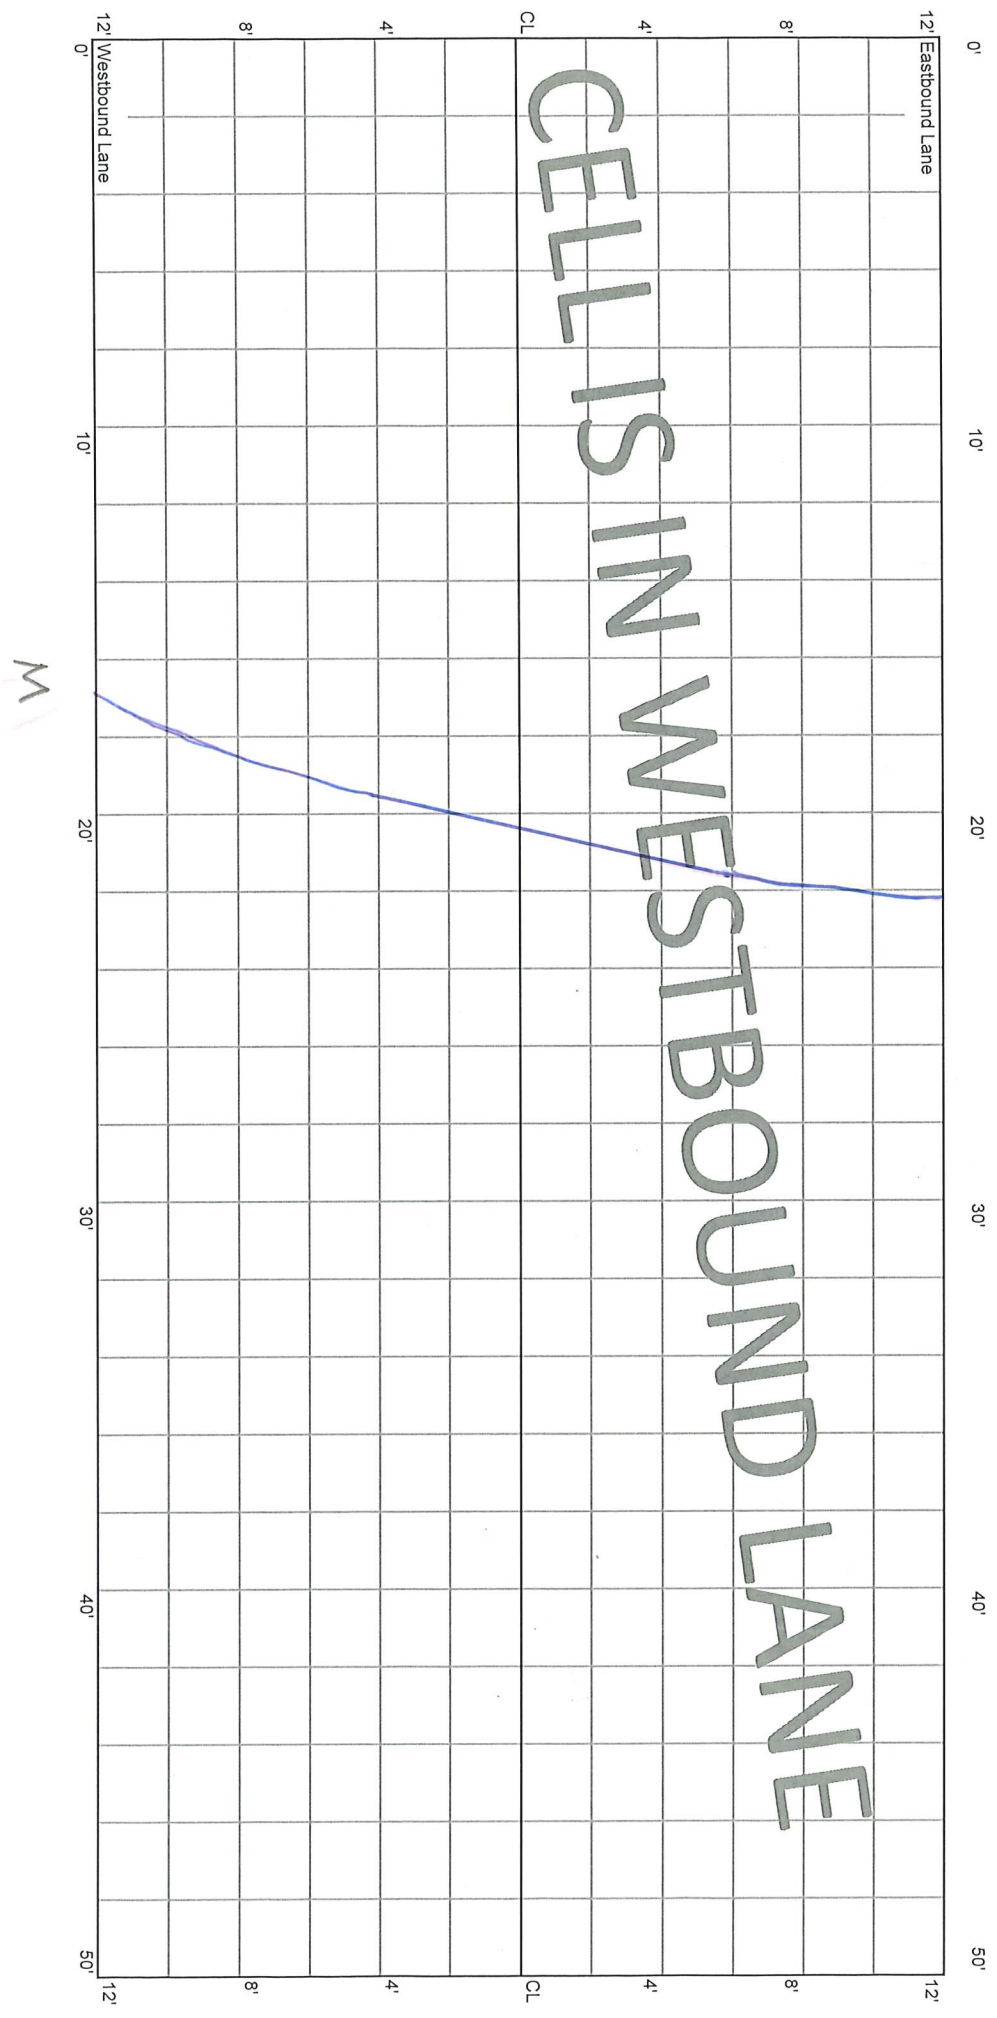

CELL 7007W
250 - 300 ft

35+50
35+30
CL KALLAND

35+00

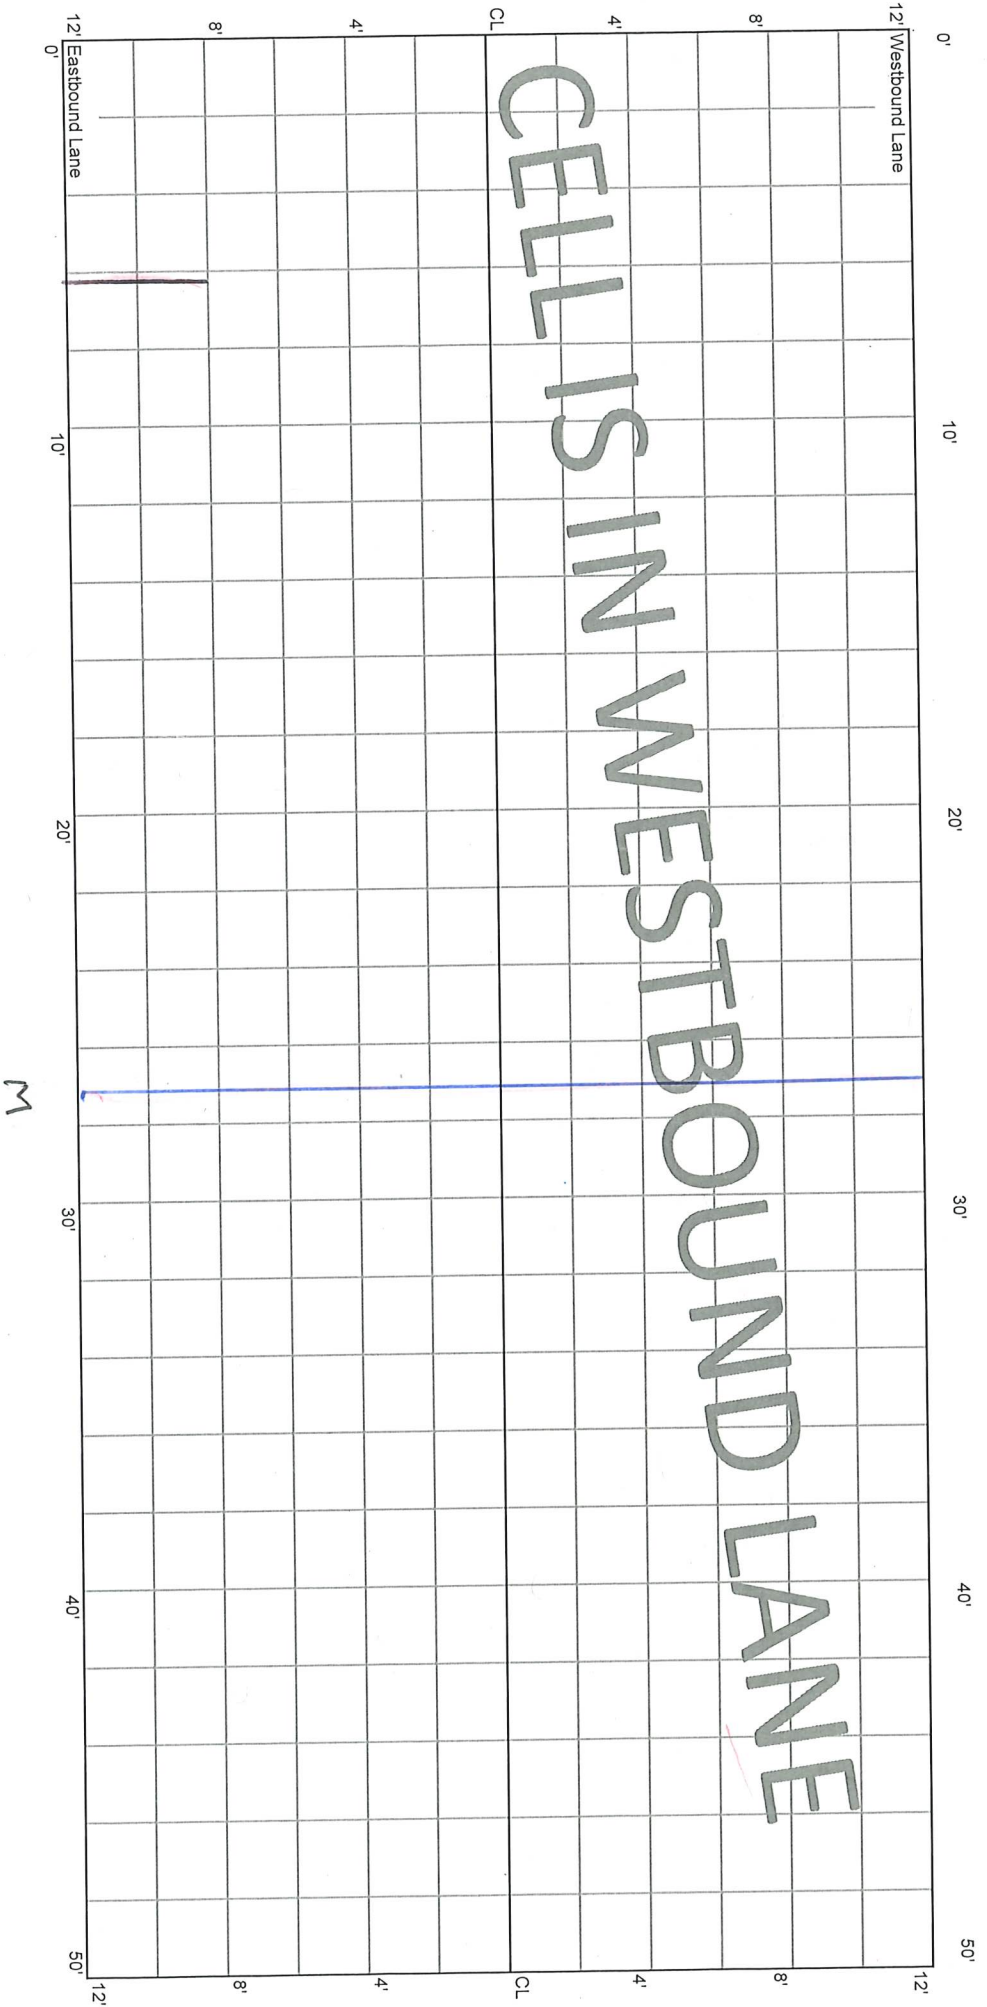


CELLS IN WESTBOUND LANE

M

CELL 7007W
300 - 350 ft

35+00


34+50

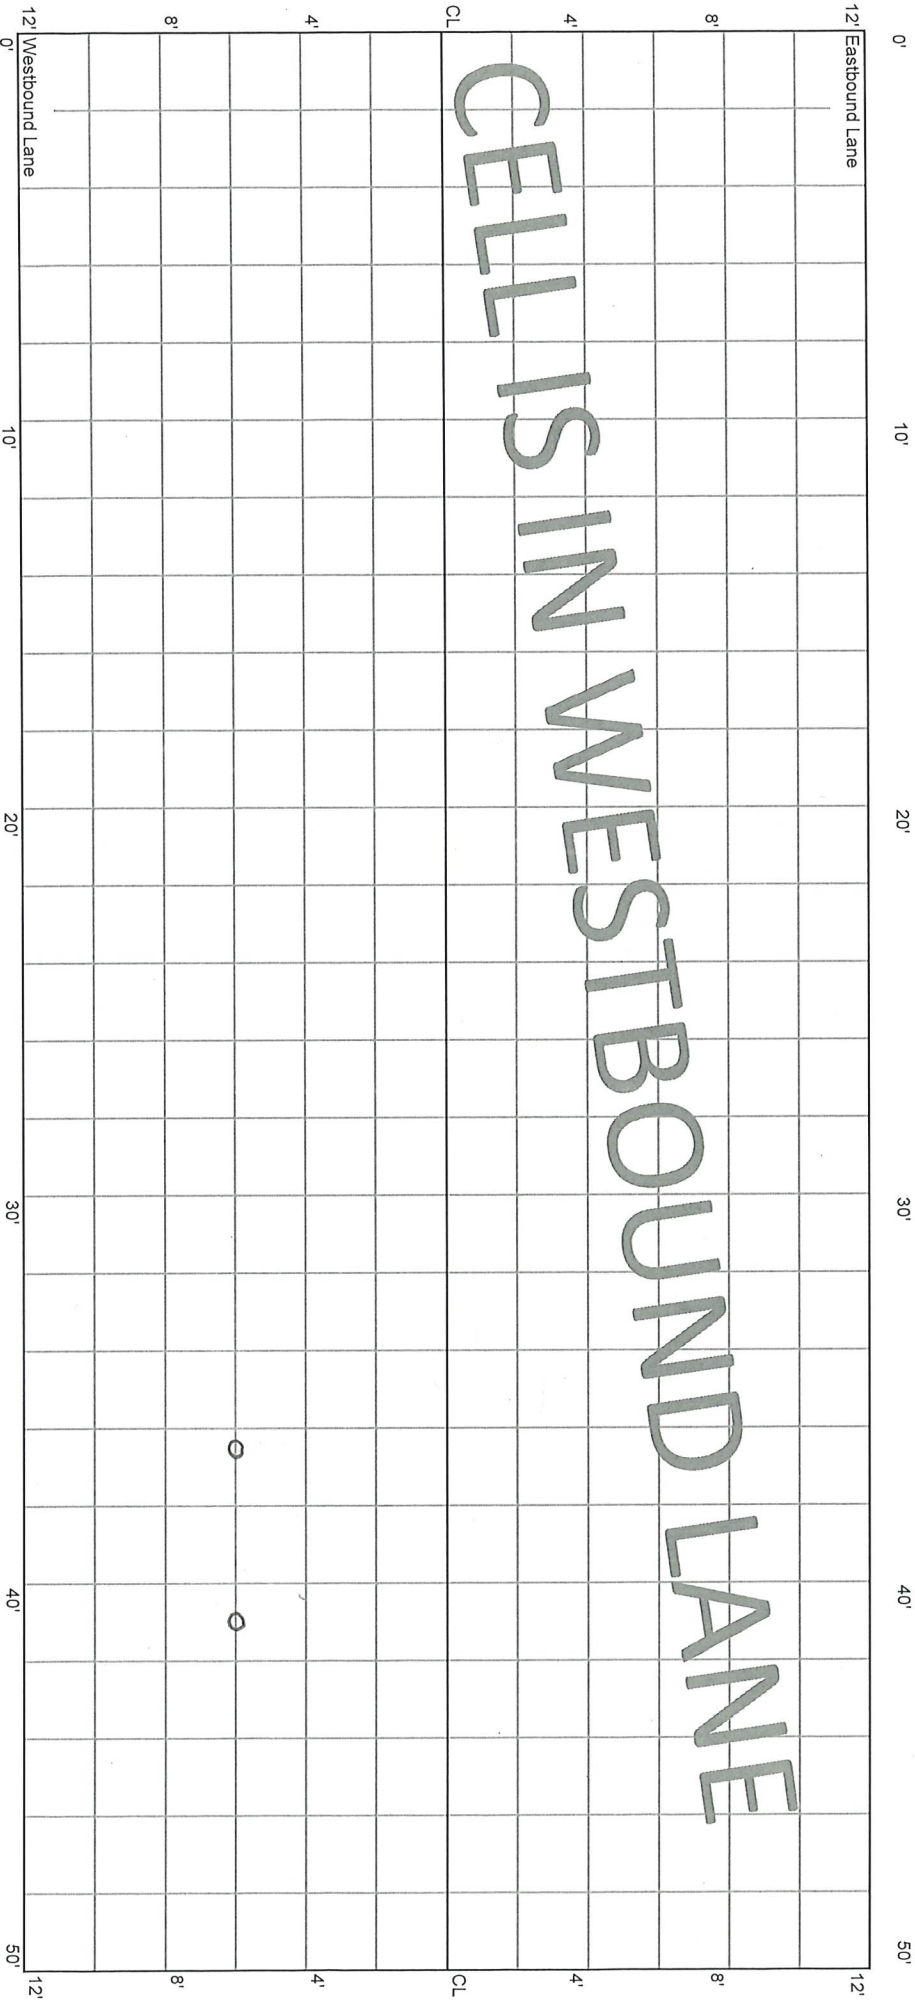

CELL 7007W
350 - 400 ft

34+50


34+00

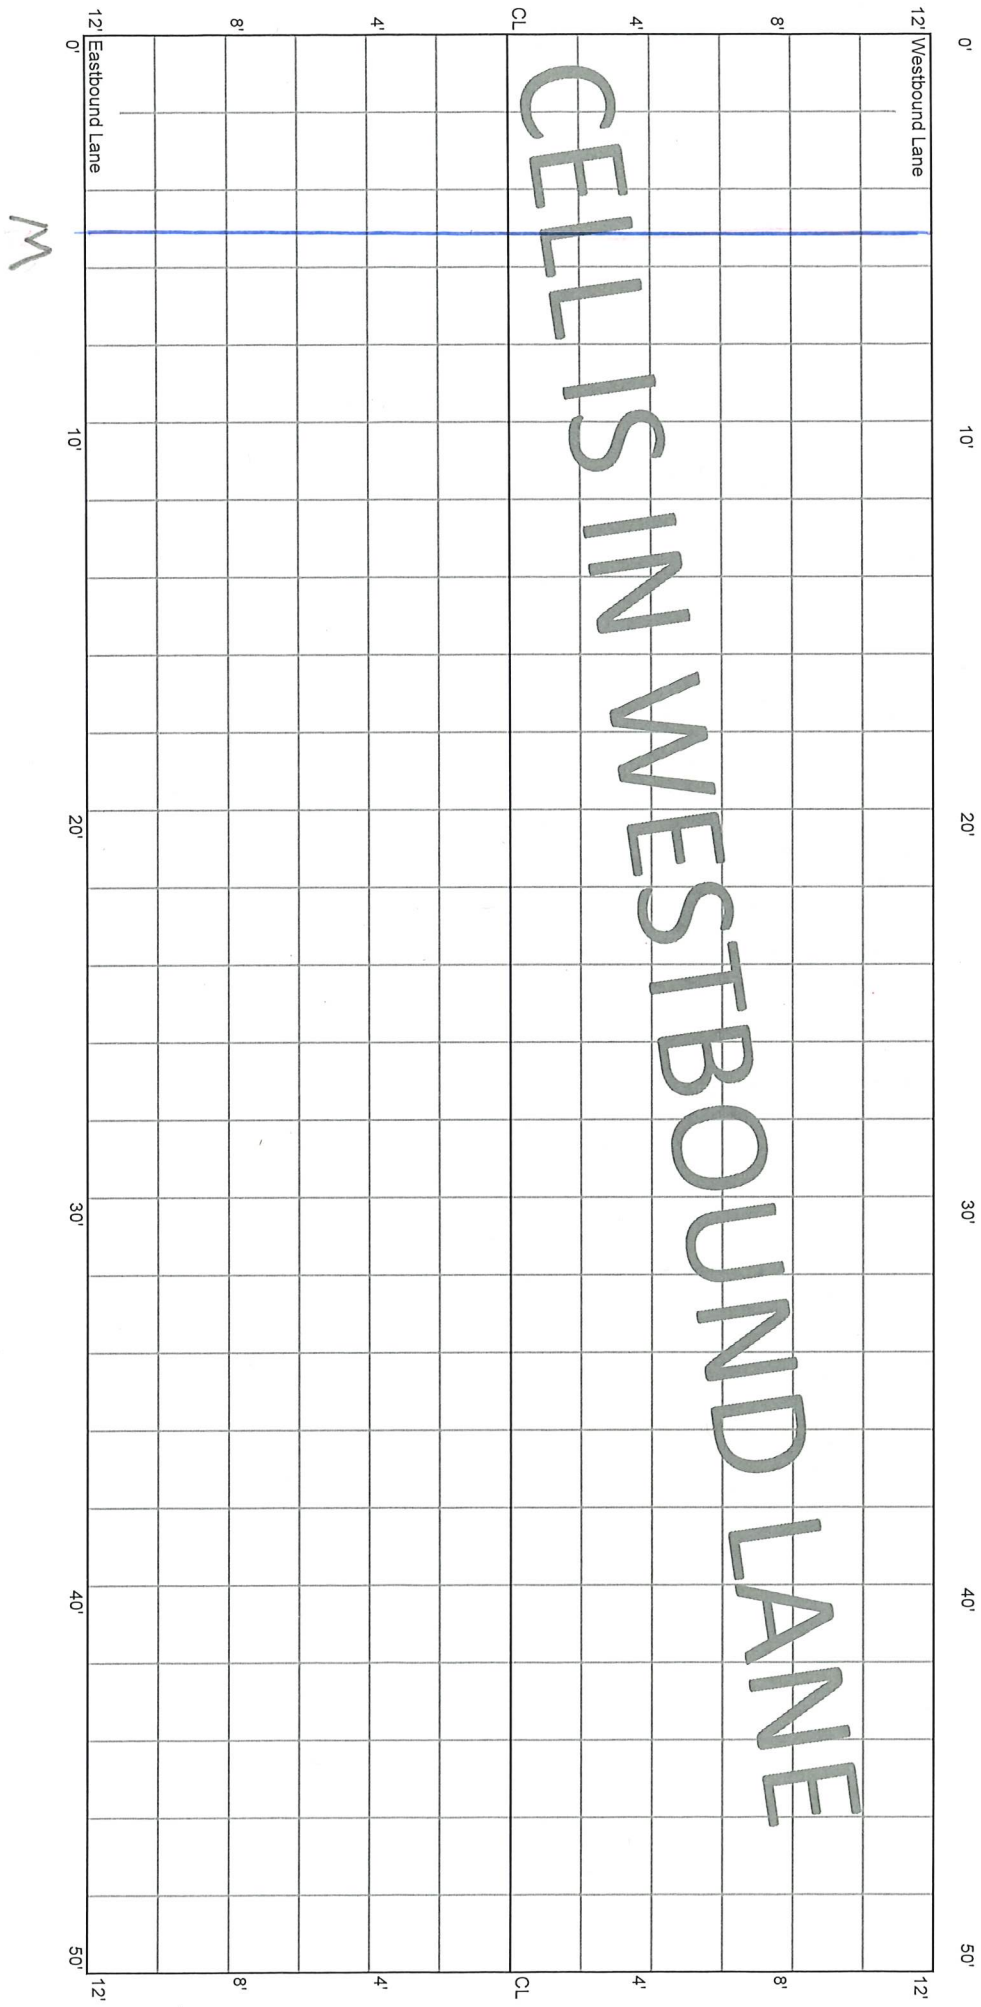

CELL 7007W
400 - 450 ft

34+00

33+50

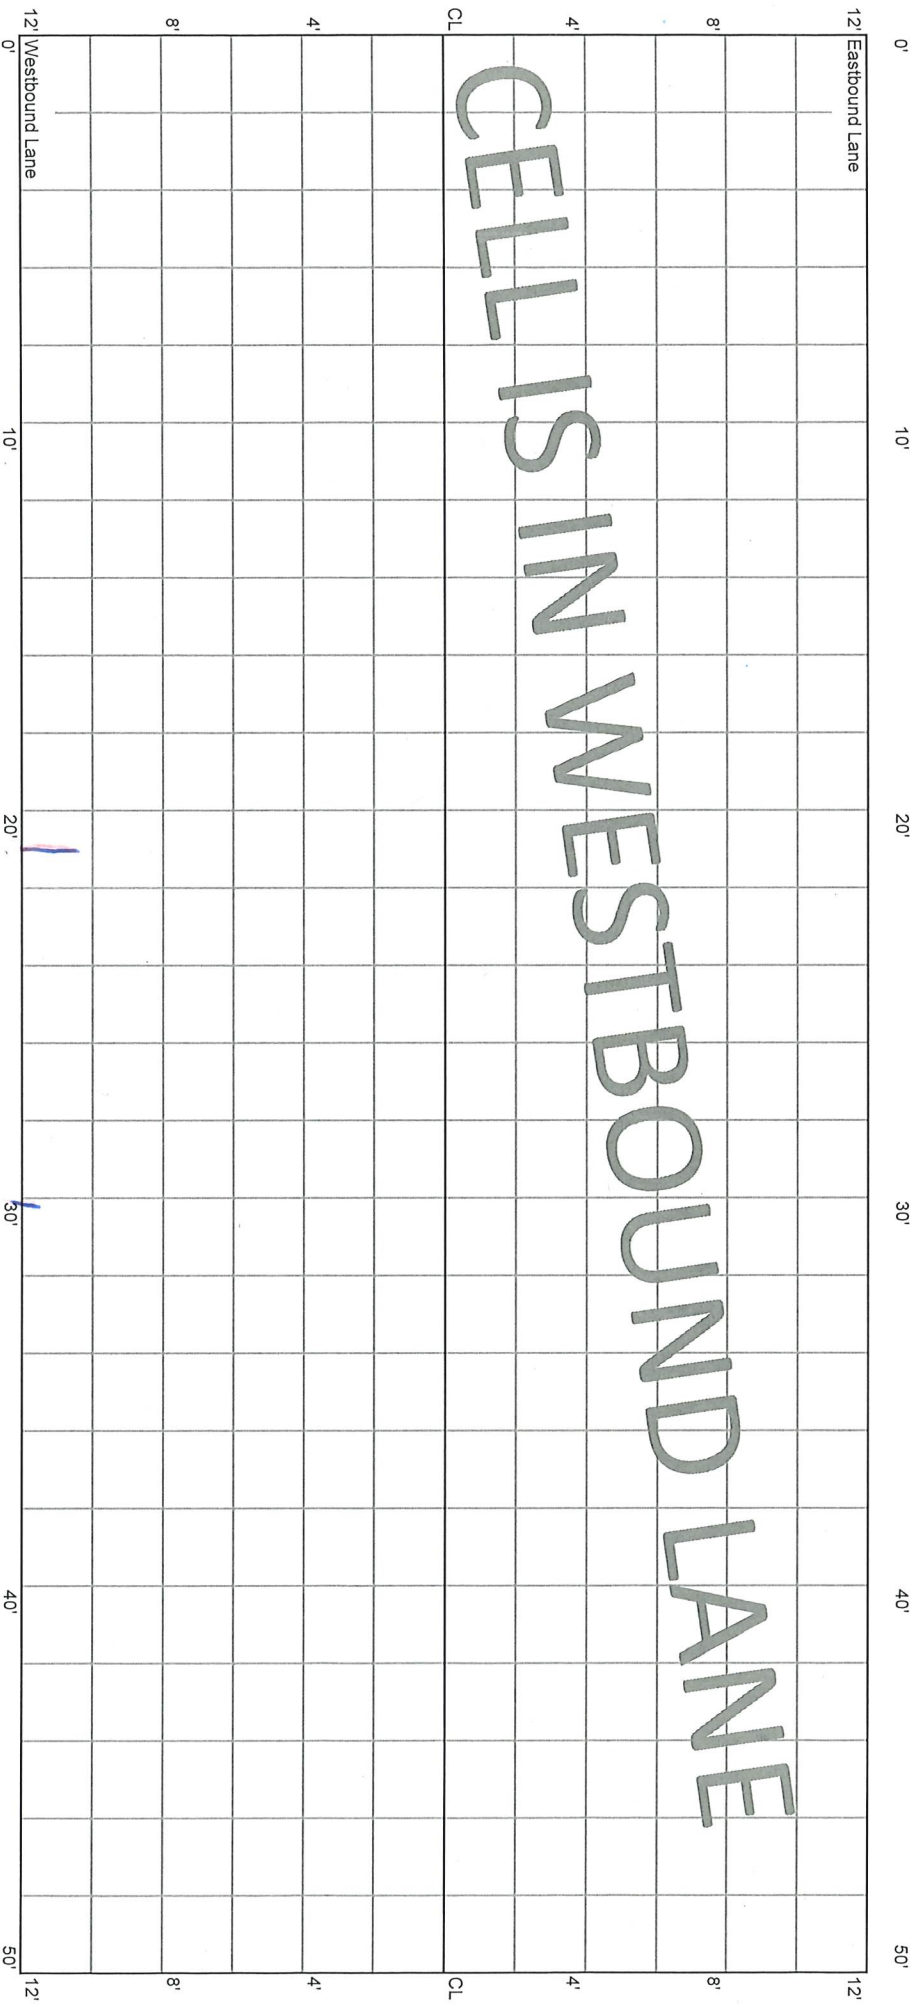

12' Eastbound Lane

12' Westbound Lane

CL

CL

8'

8'

4'

4'

4'

4'

8'

8'

0'

10'

20'

30'

40'

50'

0'

10'

20'

30'


40'

50'

CELL 7007W
450 - 500 ft

33+50

33+00

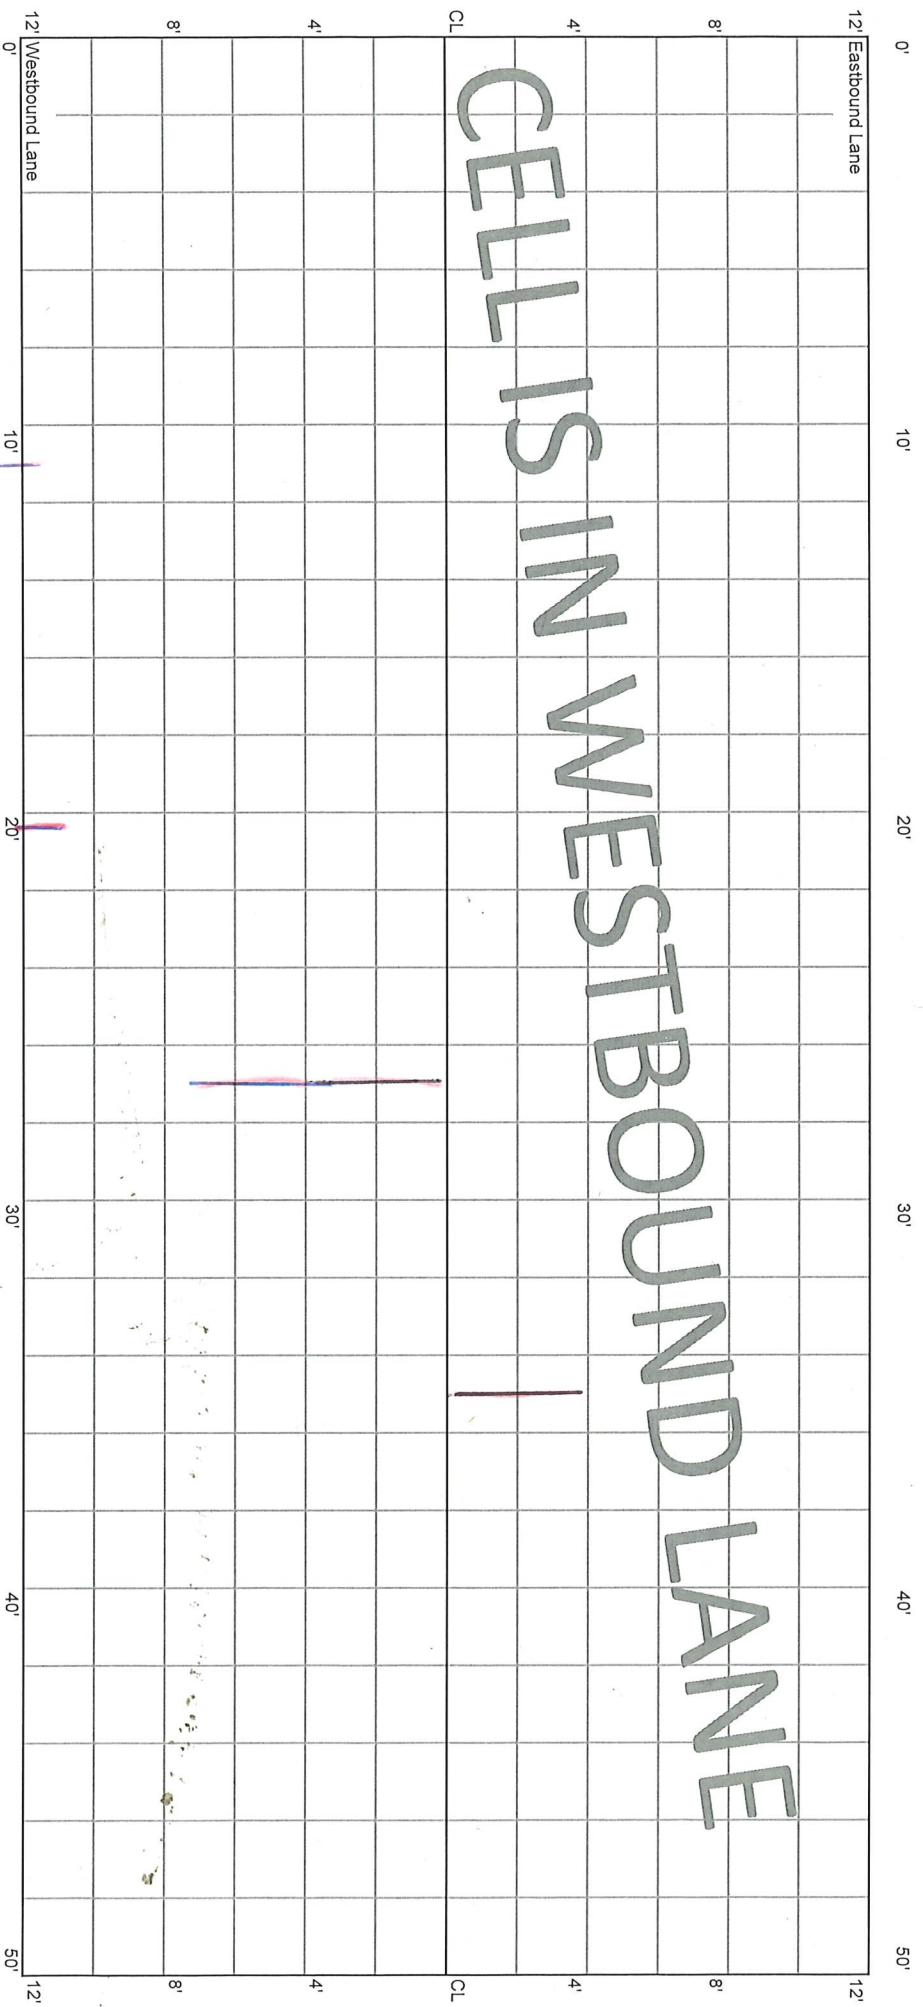

CELL 7007W
500 - 550 ft

33+00

32+75

32+50

0' 10' 20' 25' 30' 40' 50'

12' Eastbound Lane

12'

CELL IS IN WESTBOUND LANE

END RATING: BEGIN TRANSITION TO
NEXT CELL

12' Westbound Lane

12'

0' 10' 20' 25' 30' 40' 50'