

5,28.20 - E.J.

10.14.20 | 1.11.22

File 70TH ST
8.25.21

CELL 7008W
0 - 50 ft

43+50

43+00

12' Eastbound Lane

0' 10' 20' 30' 40' 50'

CELLS IN WESTBOUND LANE


12' Westbound Lane

0' 10' 20' 30' 40' 50'

* AFSP

* AFSP

* ROUT & SEAL

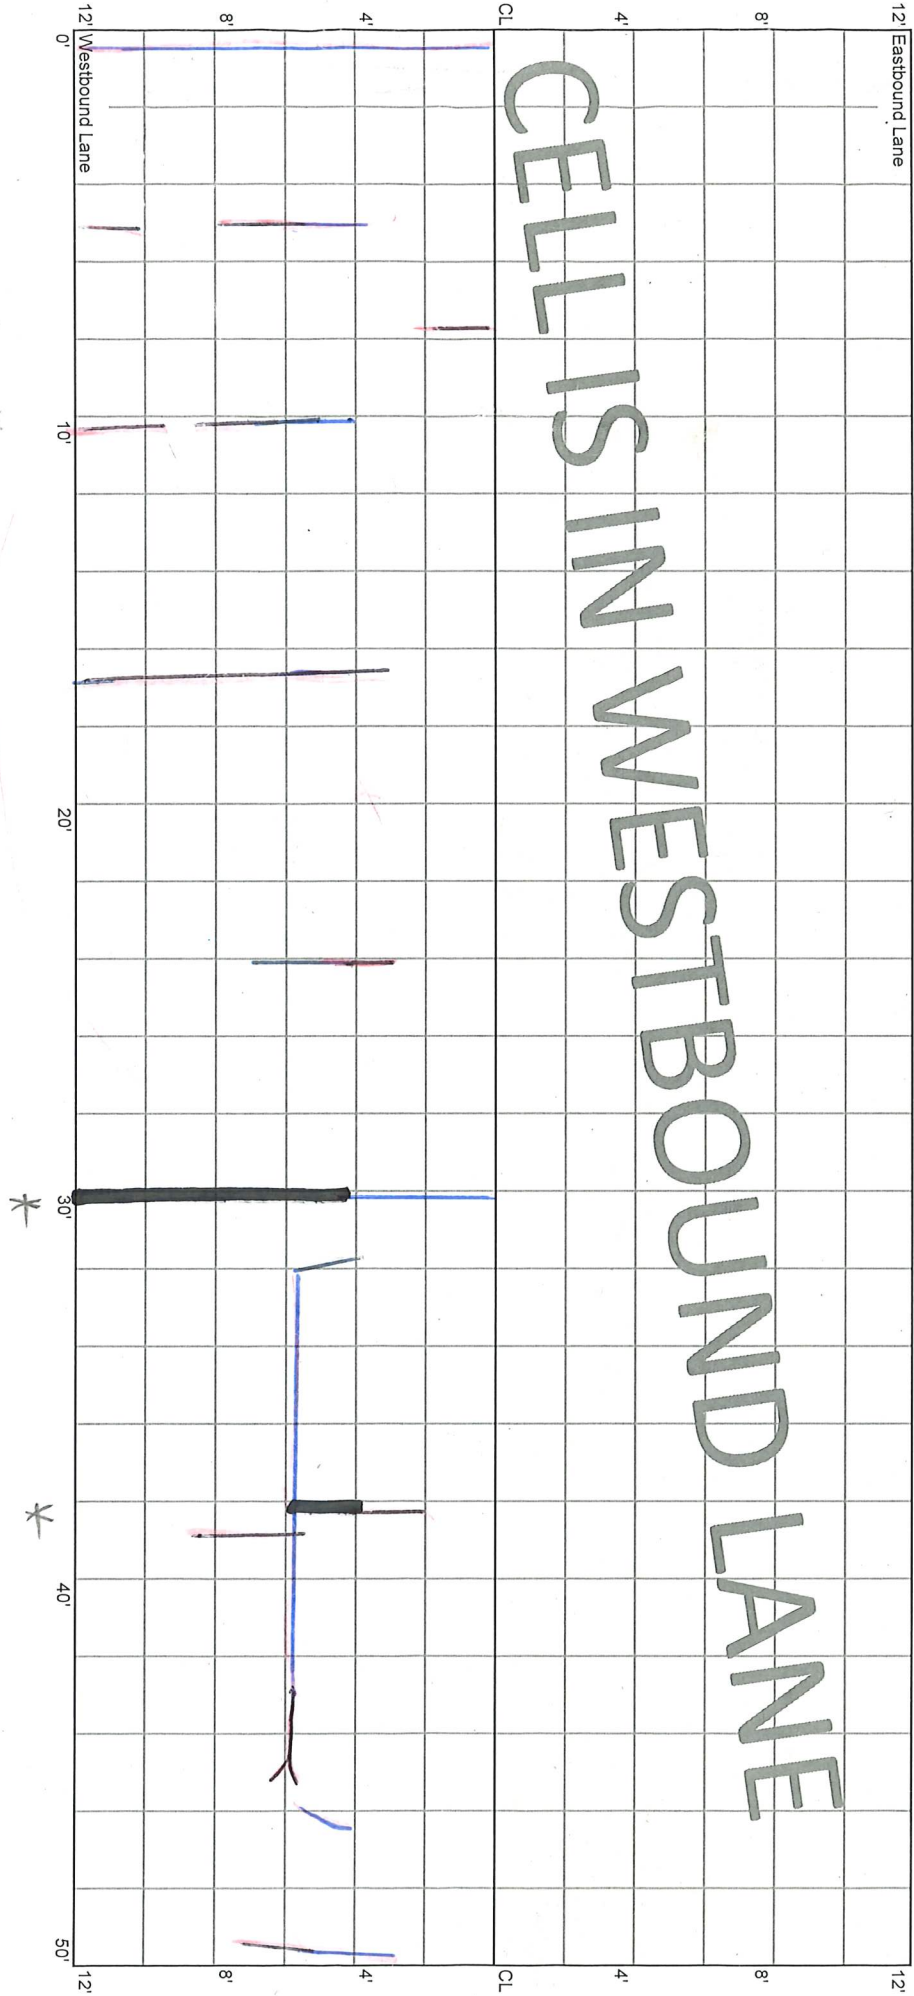

CELL 7008W
50 - 100 ft

43+00

42+50

0'

10'

20'

30'

40'

50'

12' Eastbound Lane

12'

8'

8'

4'

4'

CL

CL

4'

4'

8'

8'

12'

12'

0' Westbound Lane

10'

20'


30'

40'

50'

CELLS IN WESTBOUND LANE


M

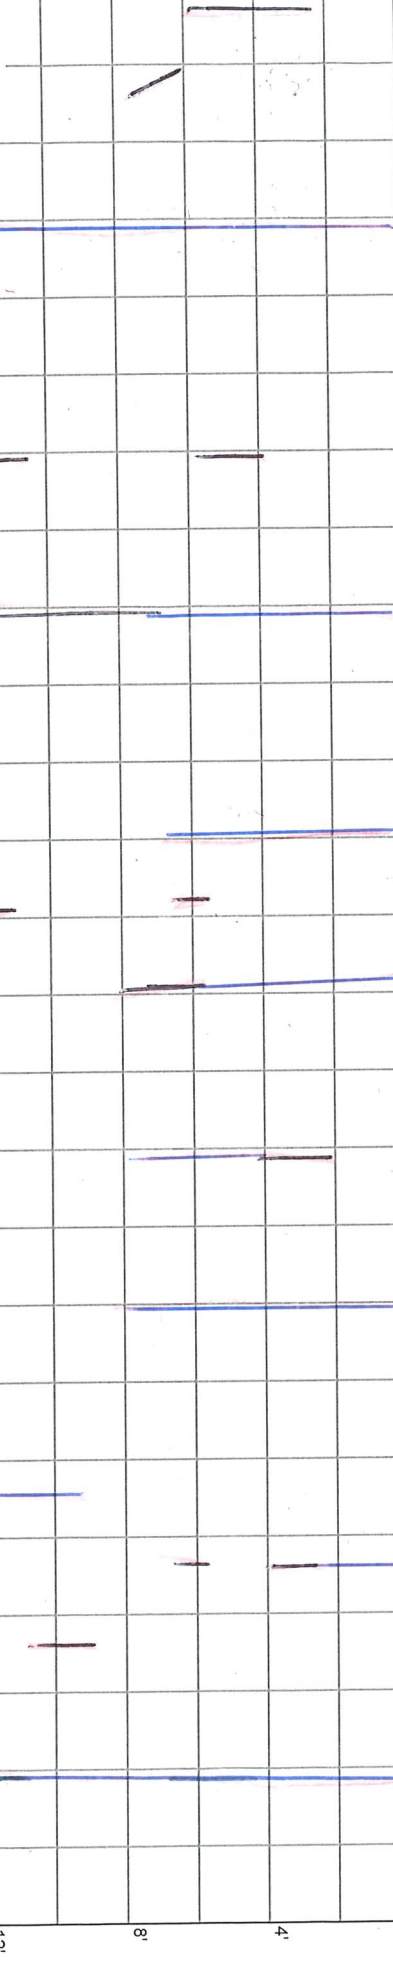

CELL 7008W
100 - 150 ft

42+50

42+00

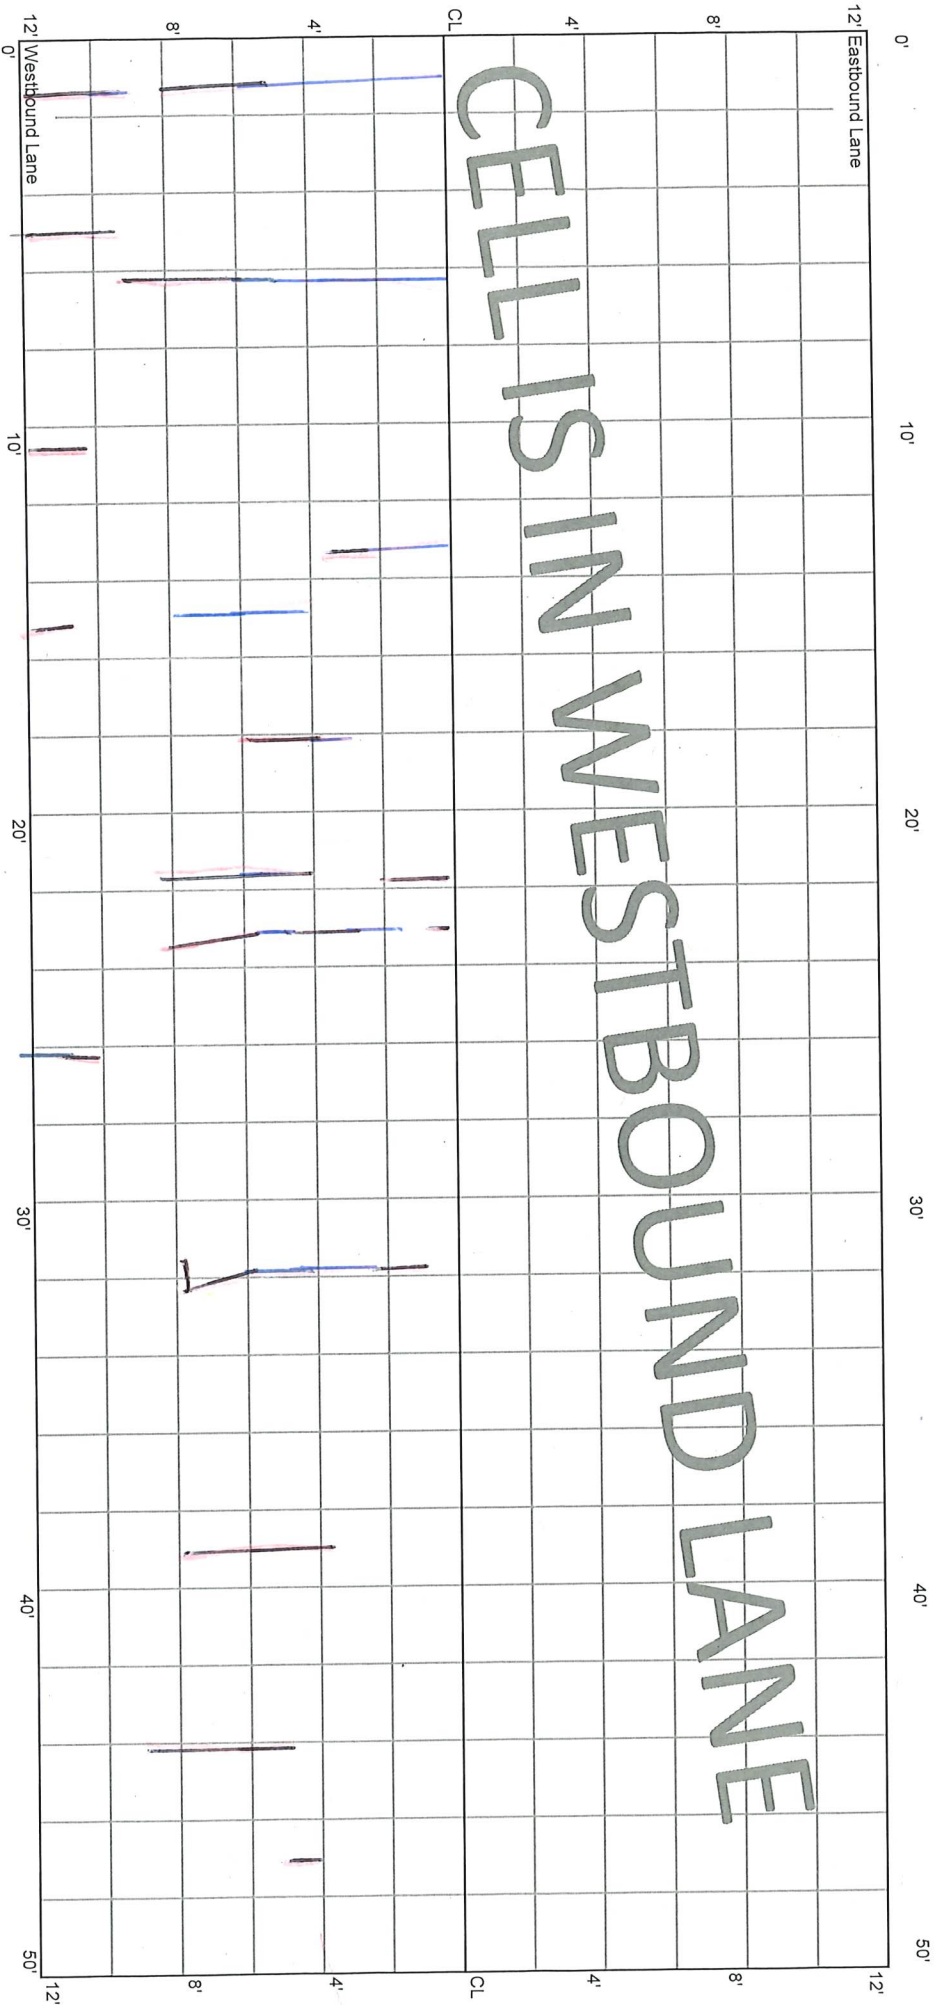

CELL 7008W
150 - 200 ft

42+00

41+50

12' Eastbound Lane

12'

CELLS IN WESTBOUND LANE

CL

CL



12' Westbound Lane

12'


*
M
AF

*

CELL 7008W
200 - 250 ft

41+50

41+00

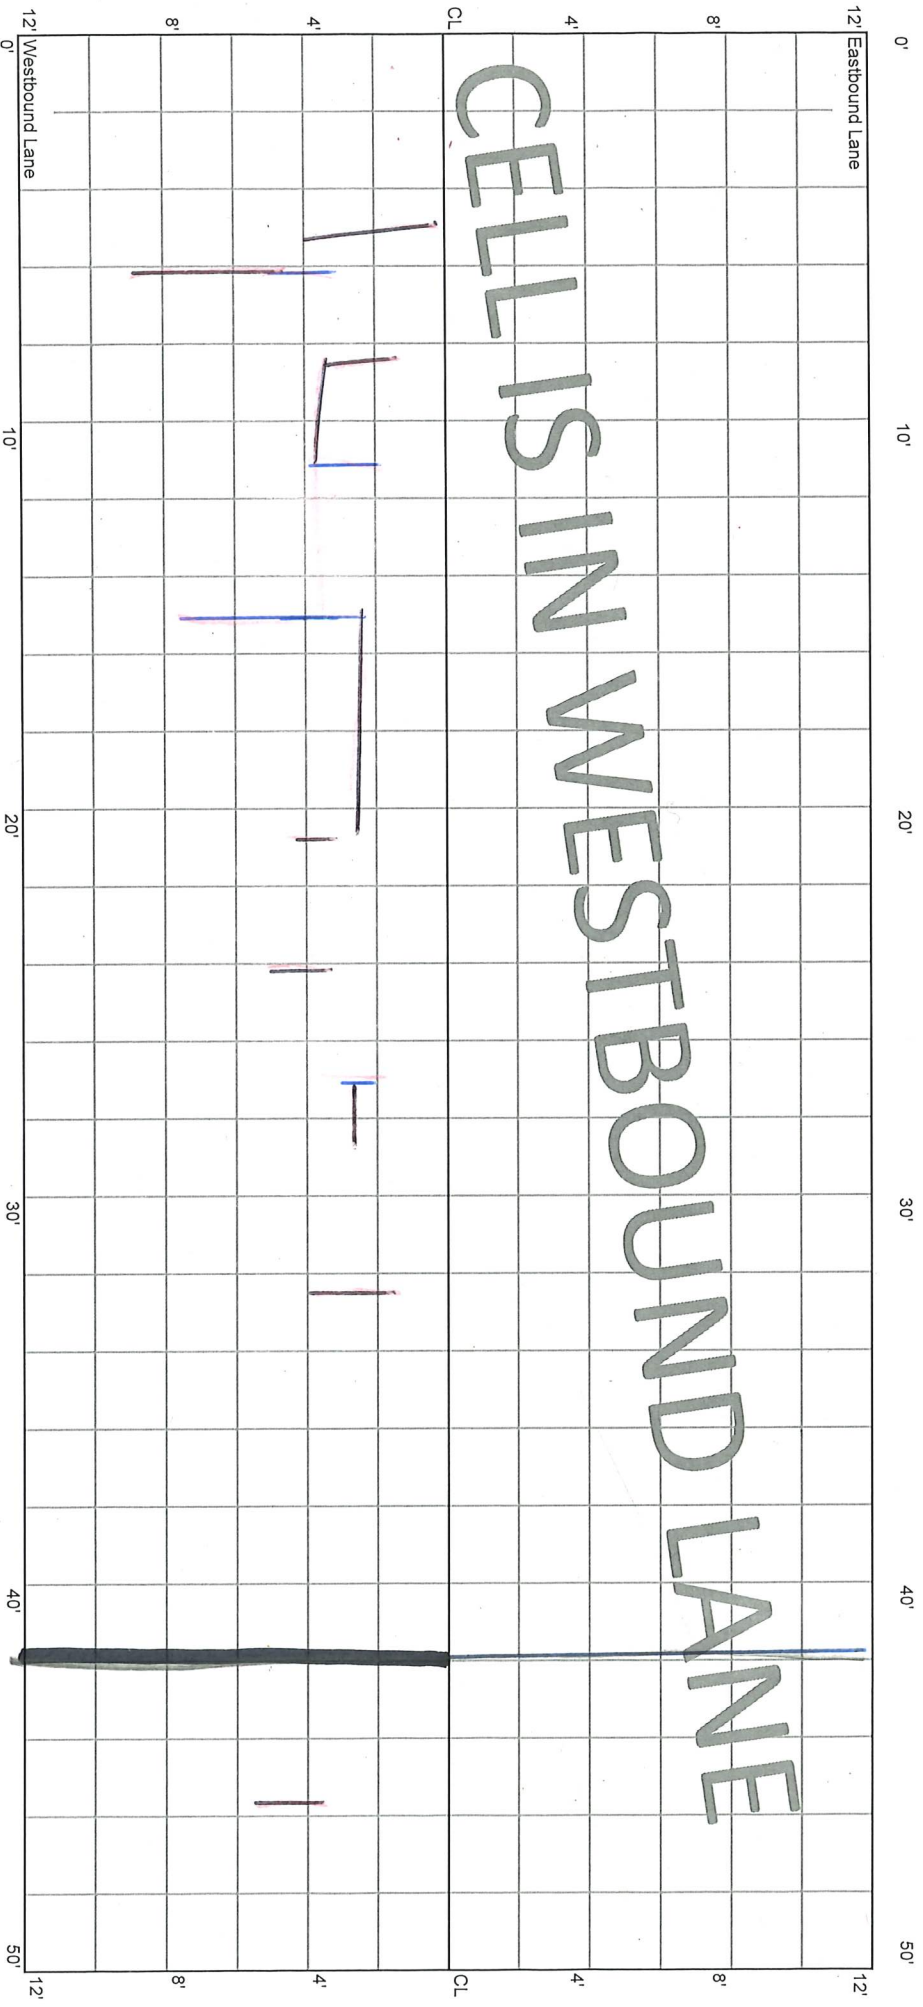


CELLS IN WESTBOUND LANE

*
M
AF, SP

CELL 7008W
250 - 300 ft

41+00


40+50

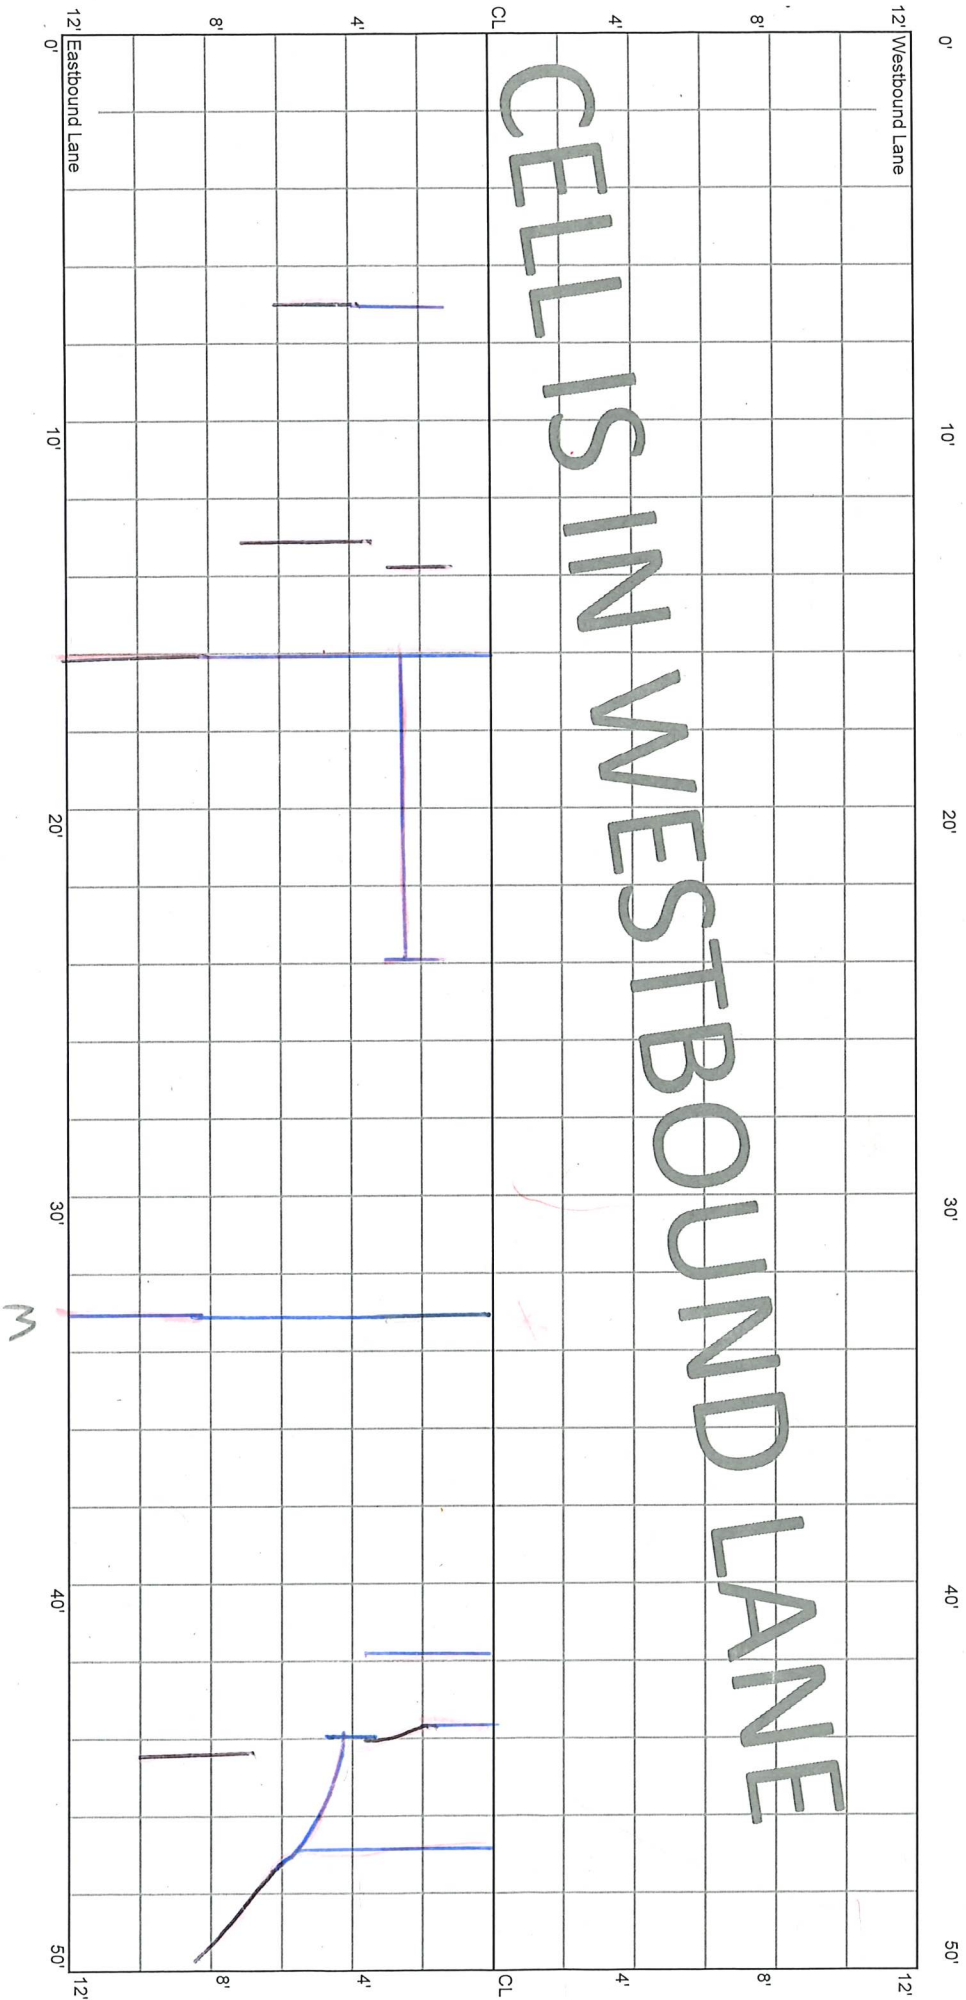

CELL 7008W
300 - 350 ft

40+50

40+00

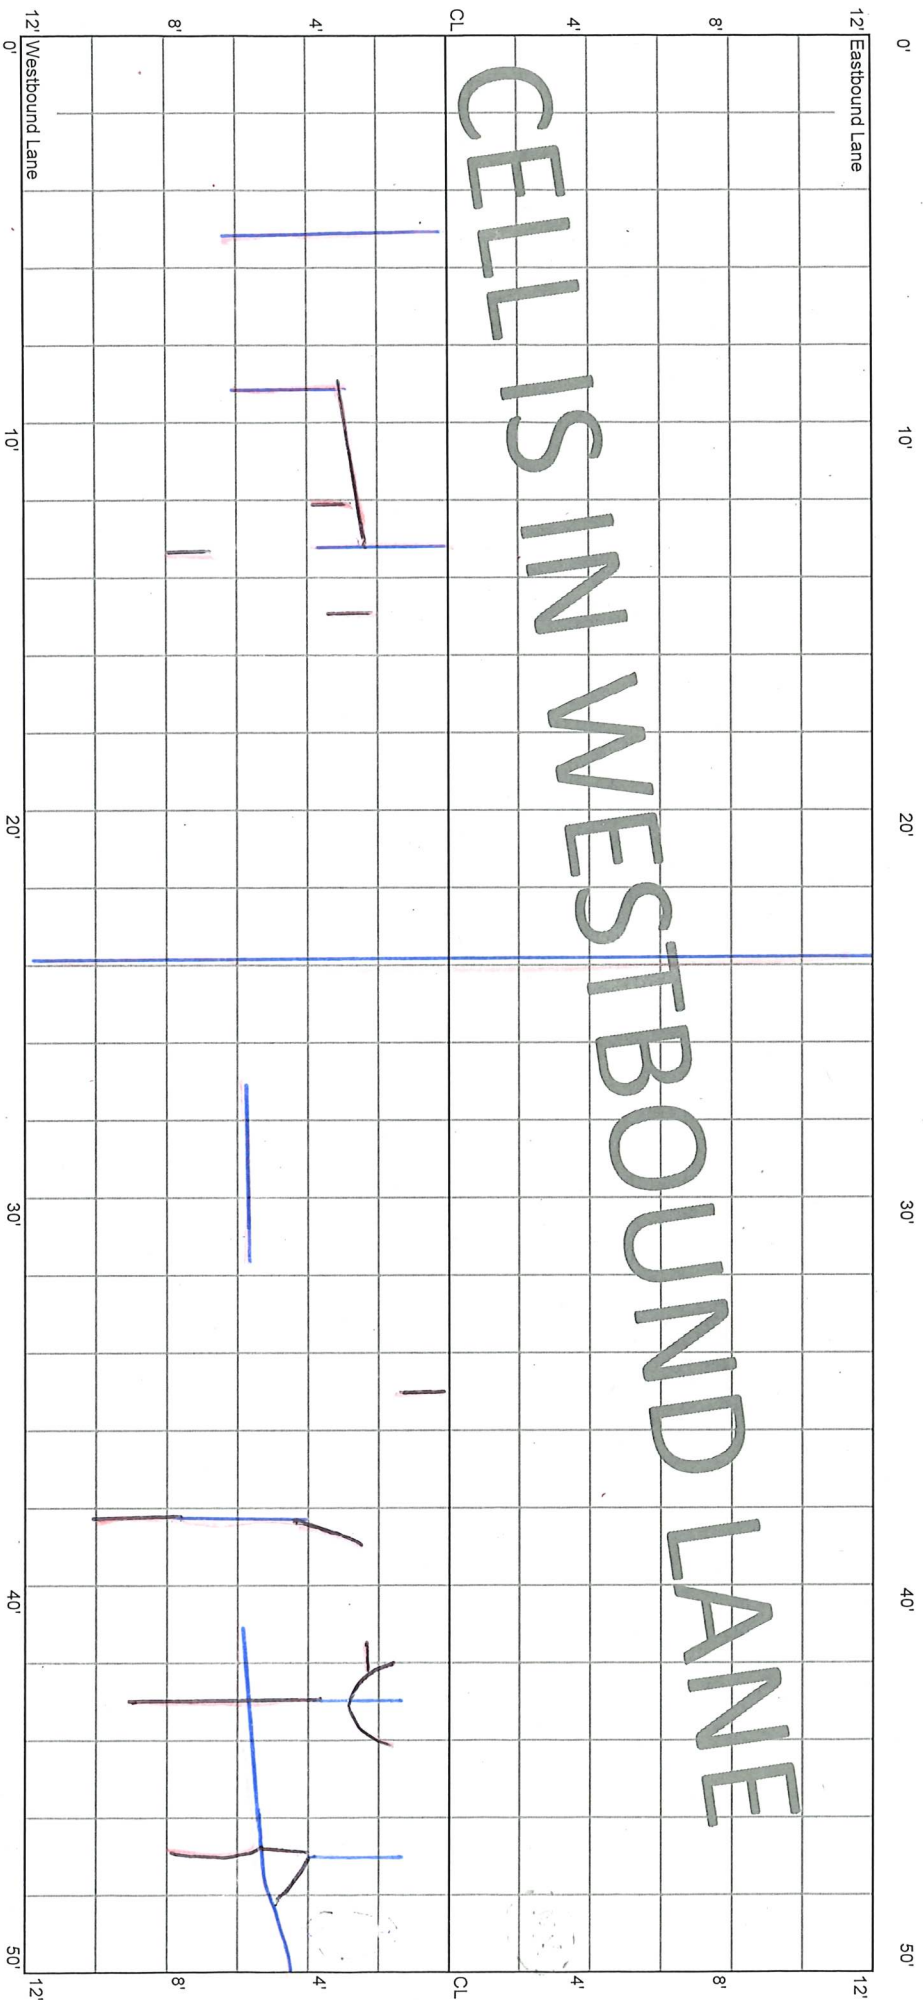


M

CELL 7008W
350 - 400 ft

40+00

39+50

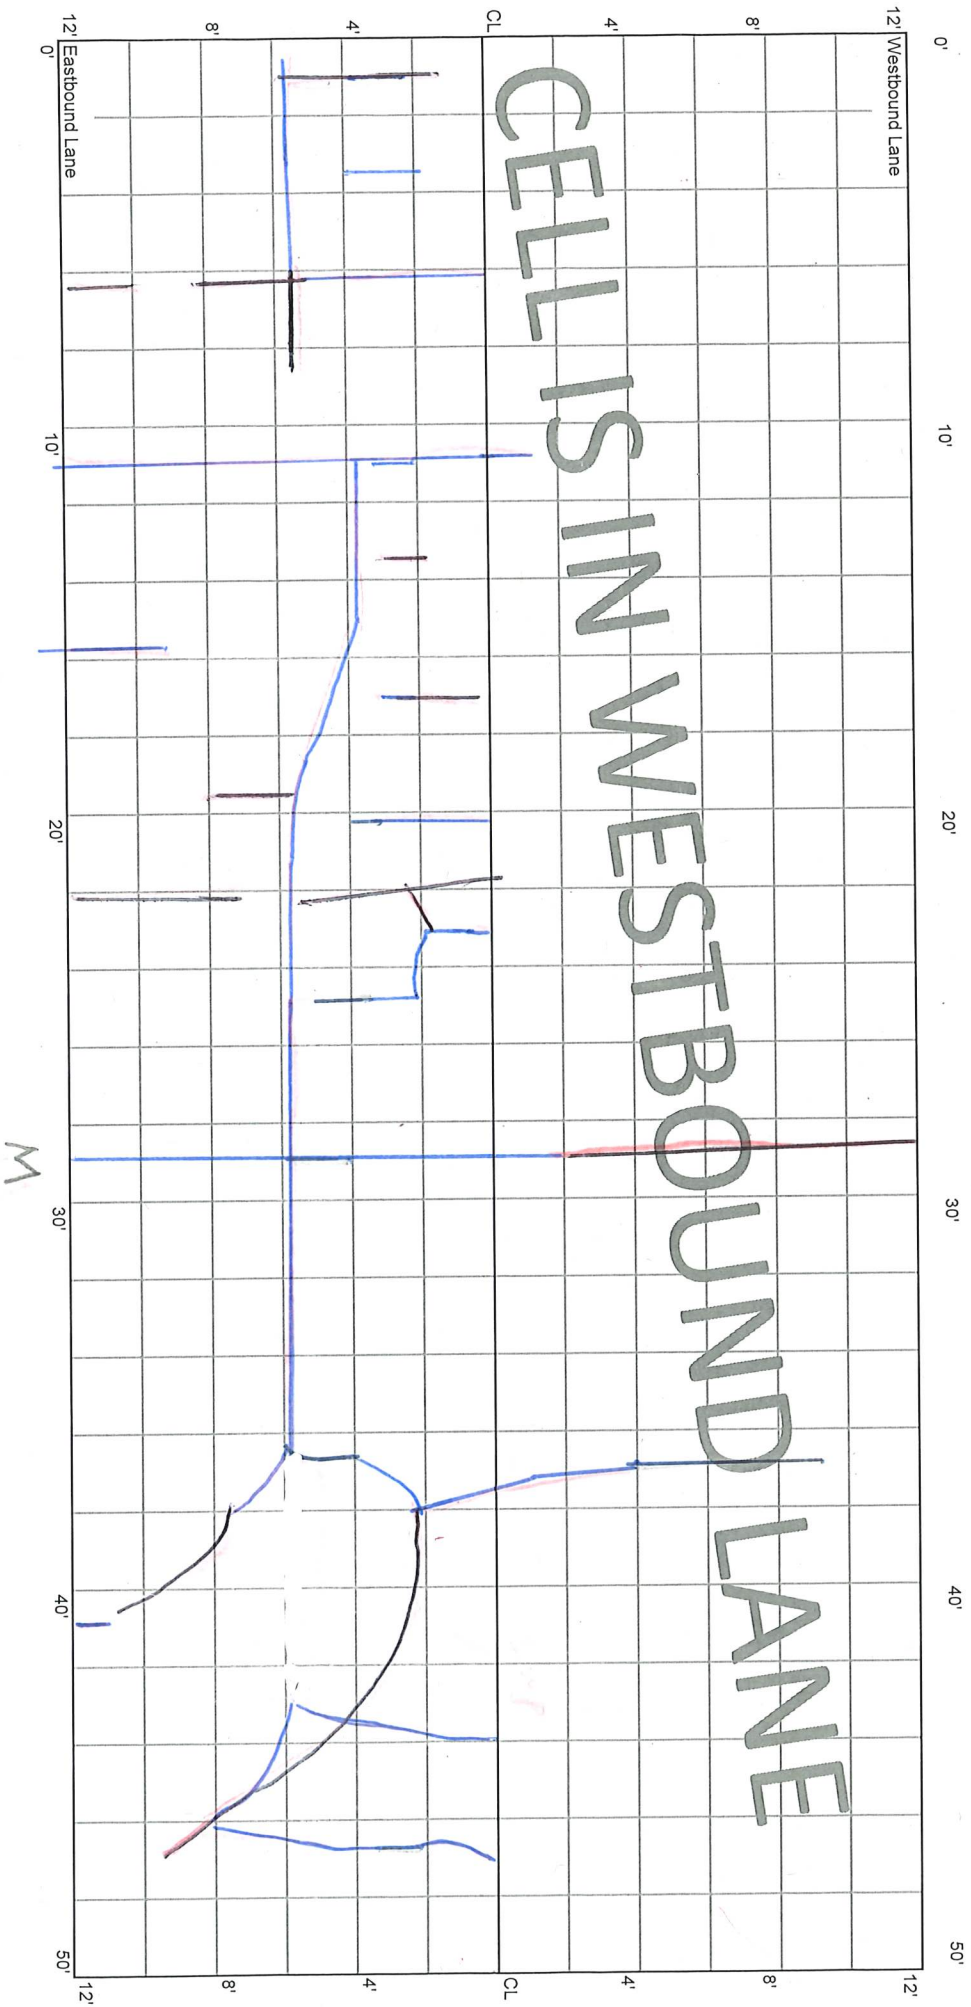

12' Westbound Lane

12'


0' 10' 20' 30' 40' 50'

M

CELL 7008W
400 - 450 ft

39+50


39+00

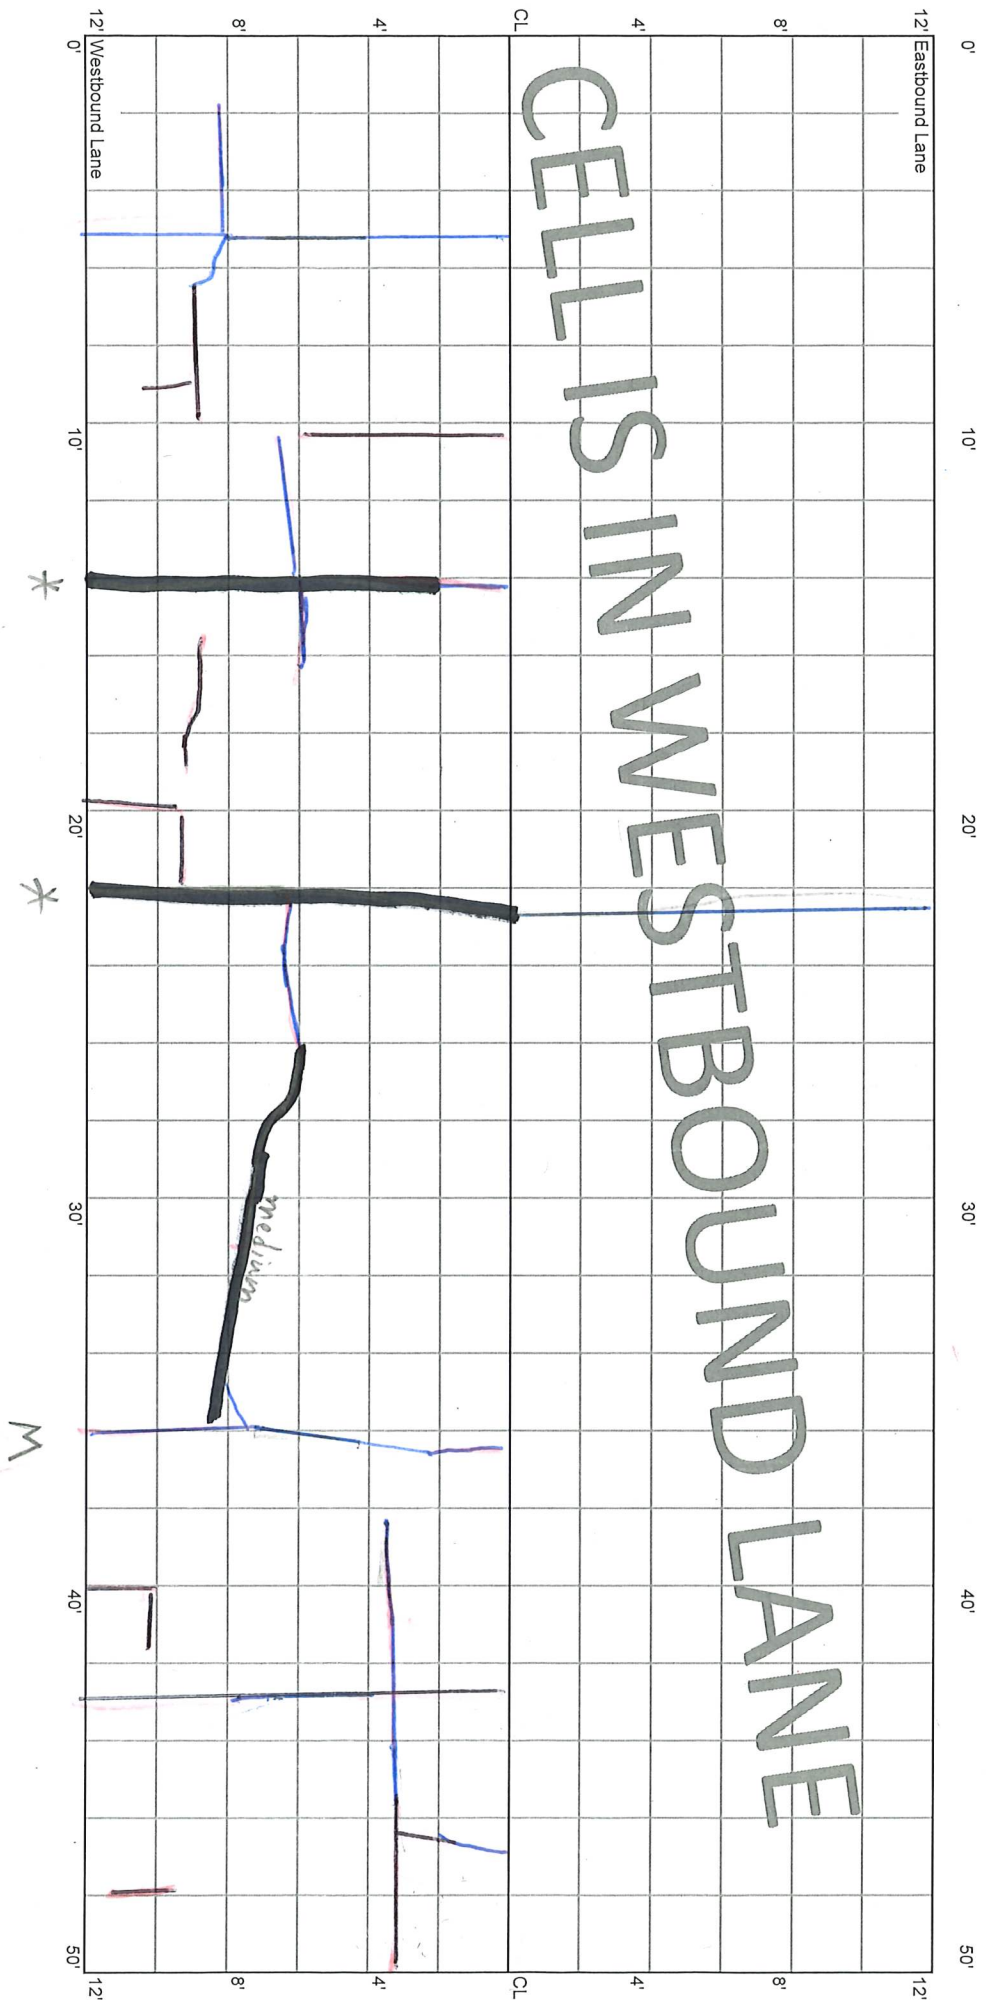

CELL 7008W
450 - 500 ft

39+00

38+50

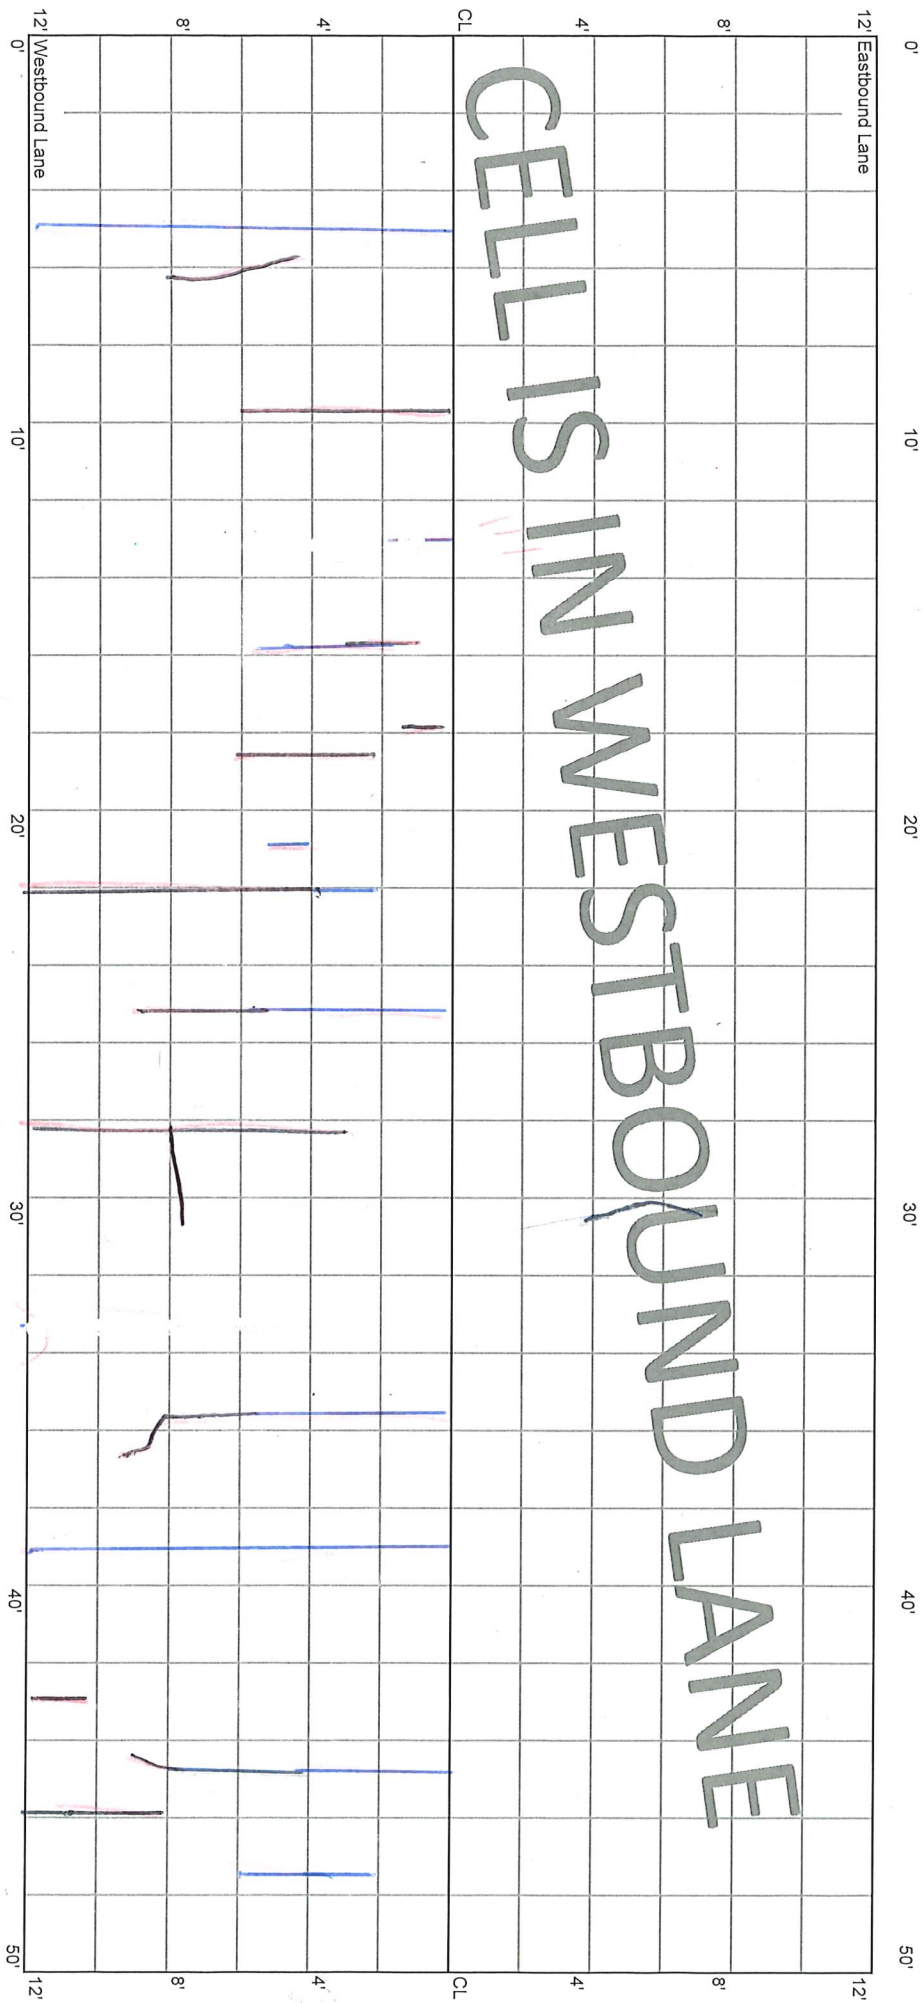

CELL 7008W
500 - 550 ft

38+50

38+25

38+00

