

B.25-21 - 59 Shldr cracks

5,28,20 E.S. - No cracking


10.14.20 - No Distress
1.14.21 - No Distress

File 707H ST
8.25.21
1.13.22
33+00

CELL 7007E
0 - 50 ft

33+50

CELLS IN EASTBOUND LANE

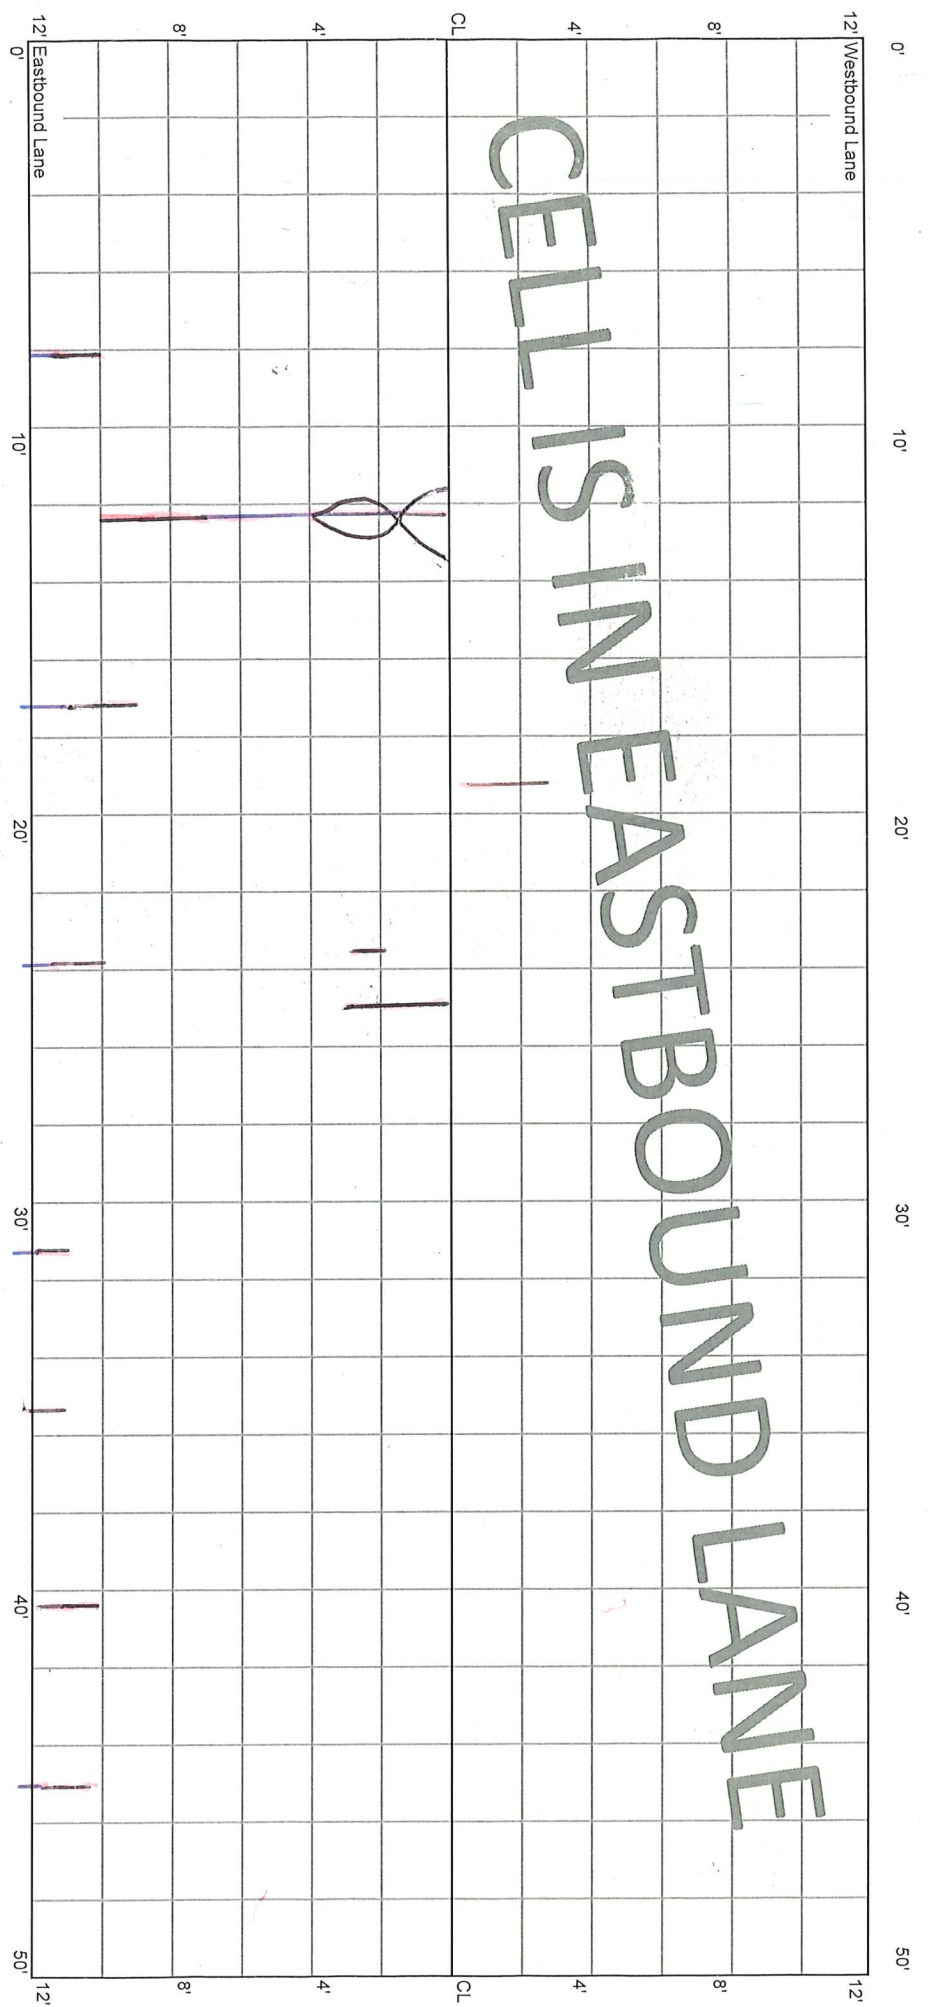


* 2023 Clean & Seal

CELL 7007E
50 - 100 ft

33+50


34+00

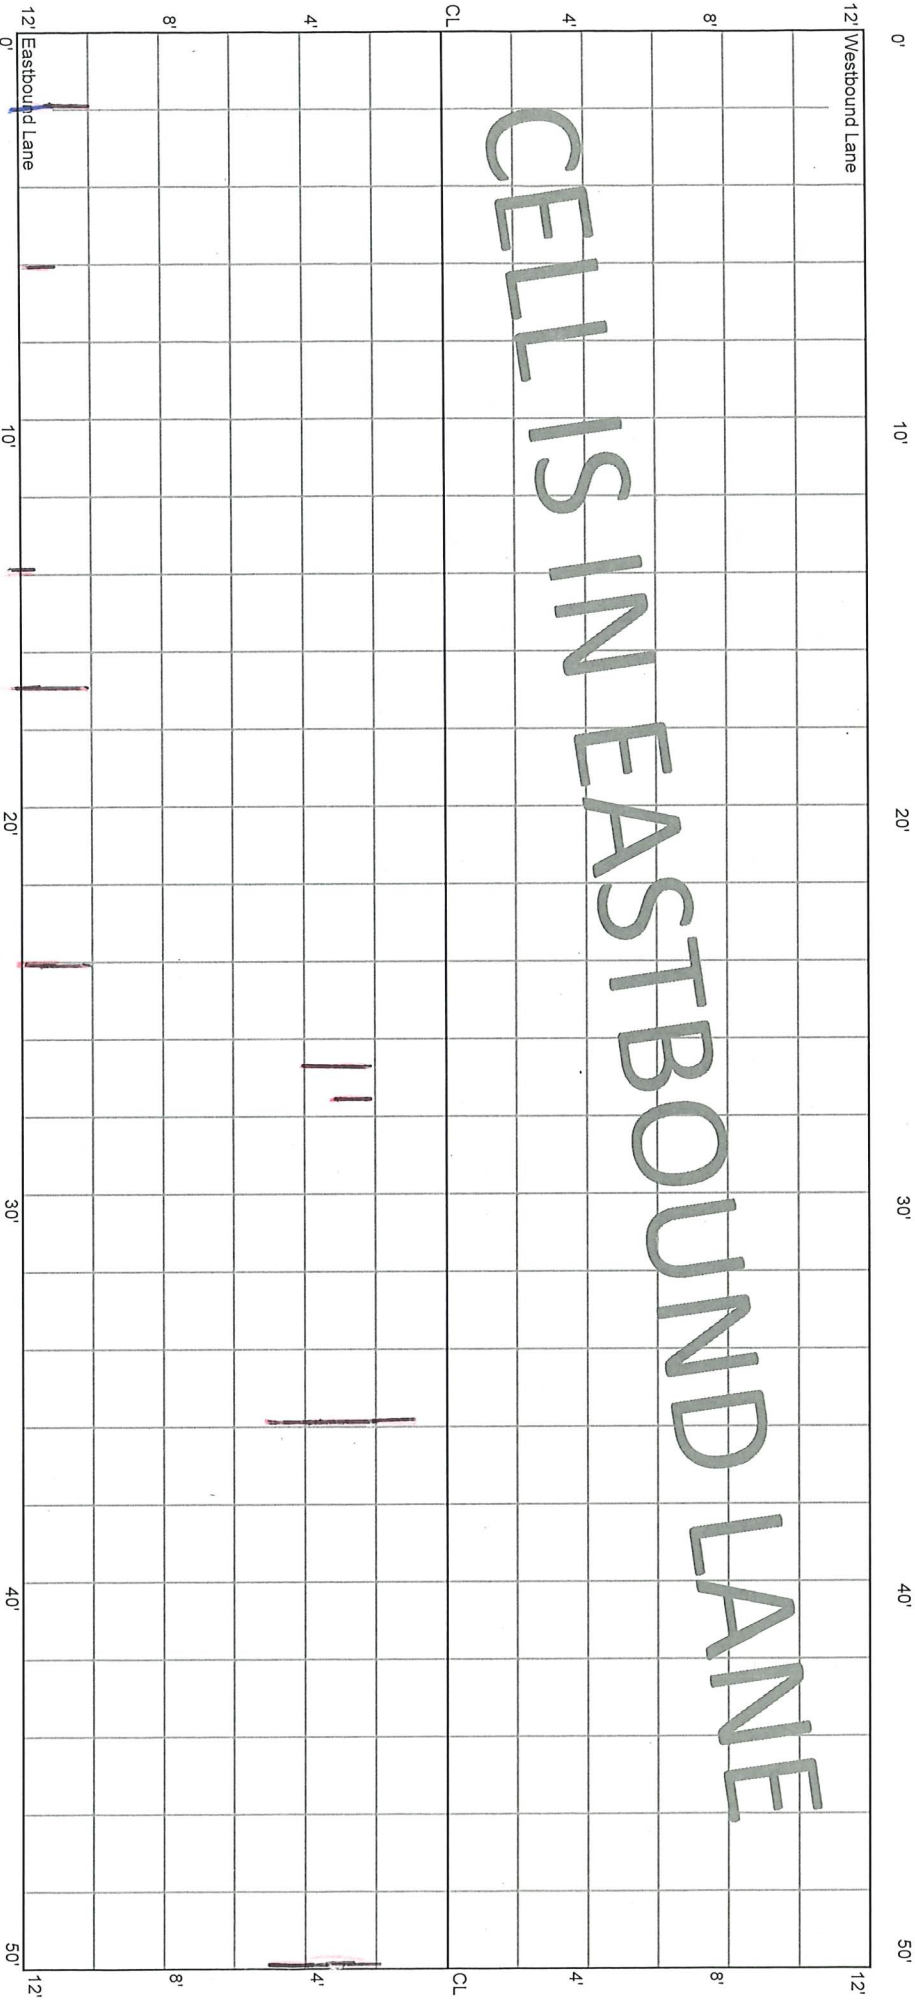

CELL 7007E
100 - 150 ft

34+00

34+50

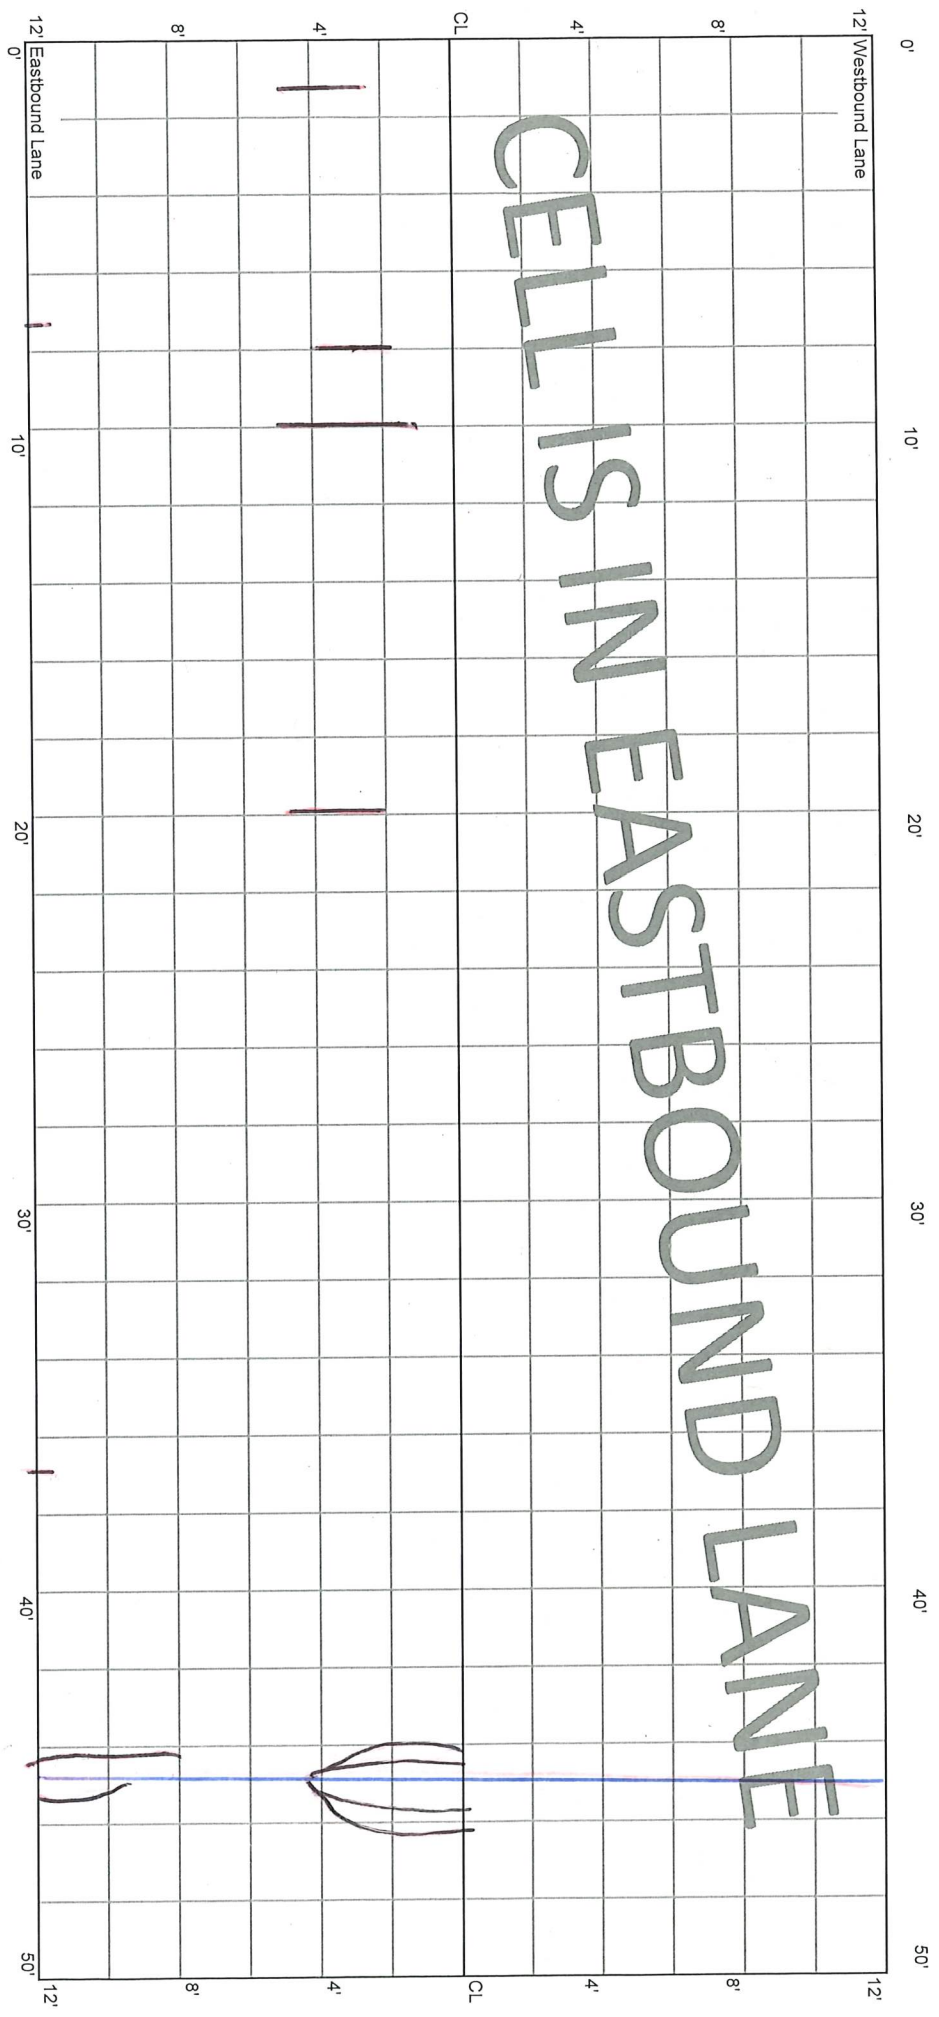


M

CELL 7007E
150 - 200 ft

34+50

35+00

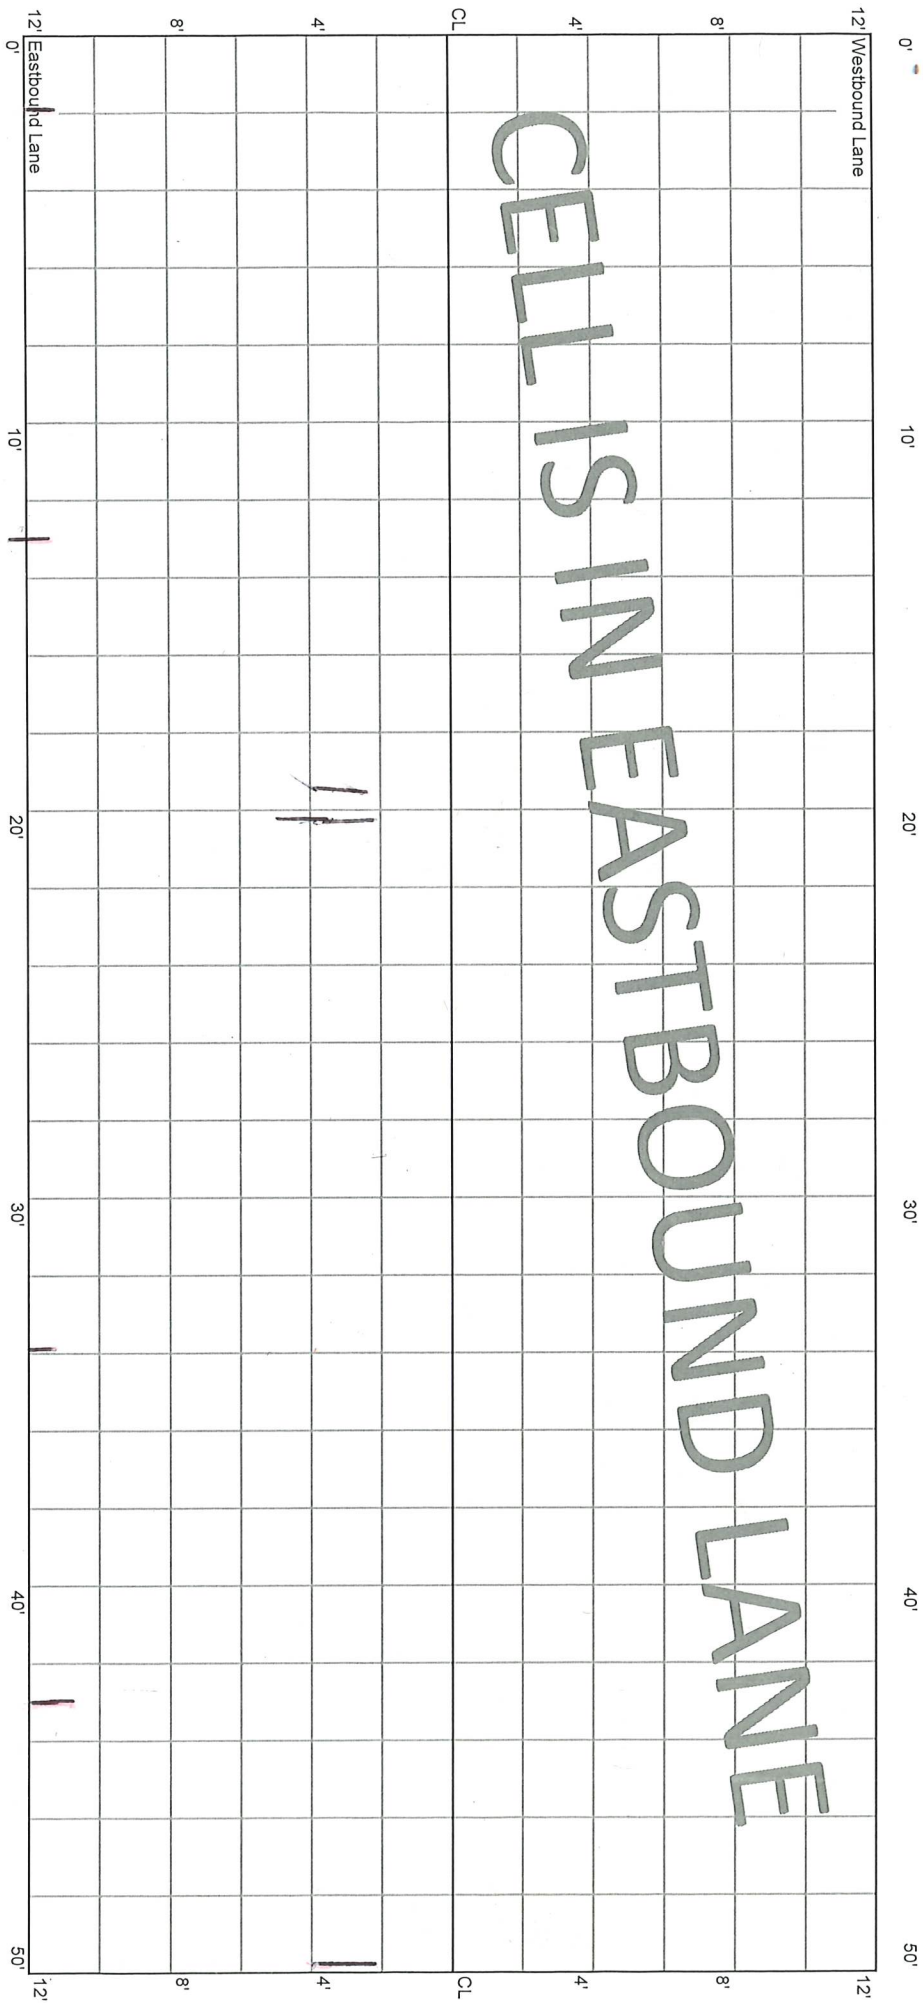


D. J. ...

CELL 7007E
200 - 250 ft

35+30
CL KALLAND

35+50

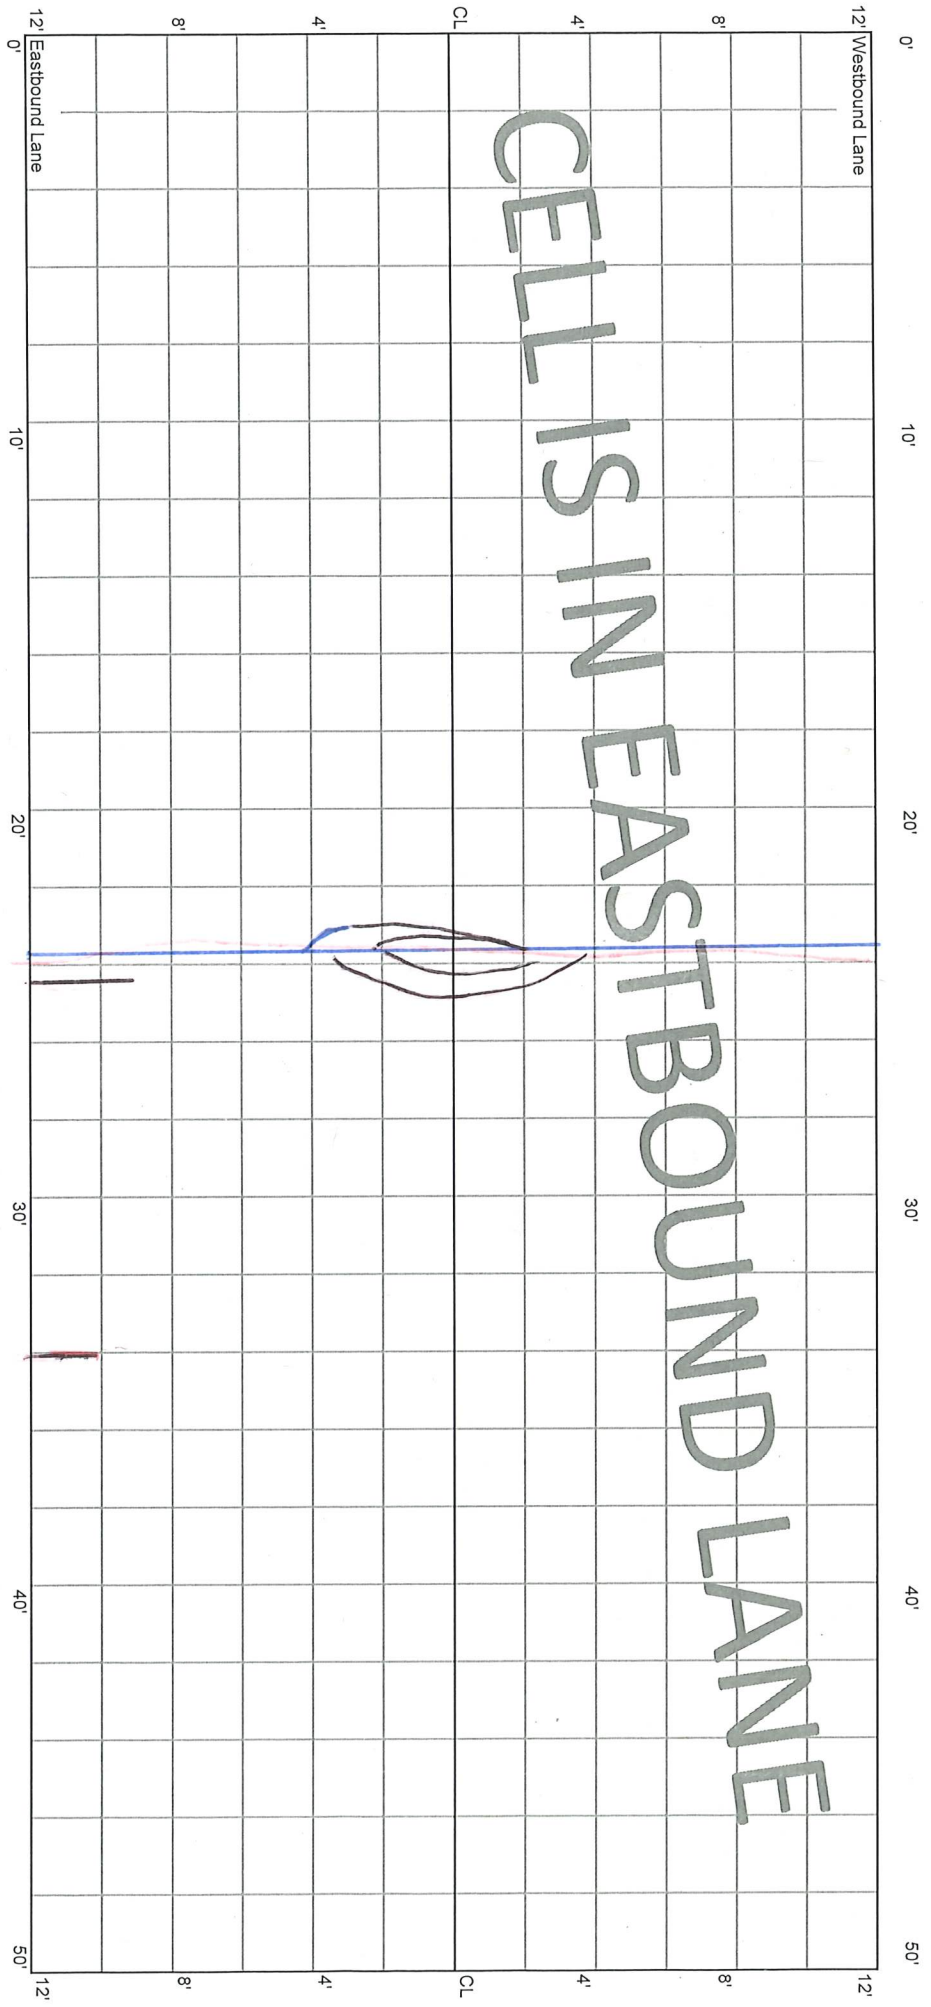

12\'' Westbound Lane

12\'' Eastbound Lane

35+30
CL KALLAND

35+50


CELL IS IN EASTBOUND LANE

M

CELL 7007E
250 - 300 ft

35+50

36+00

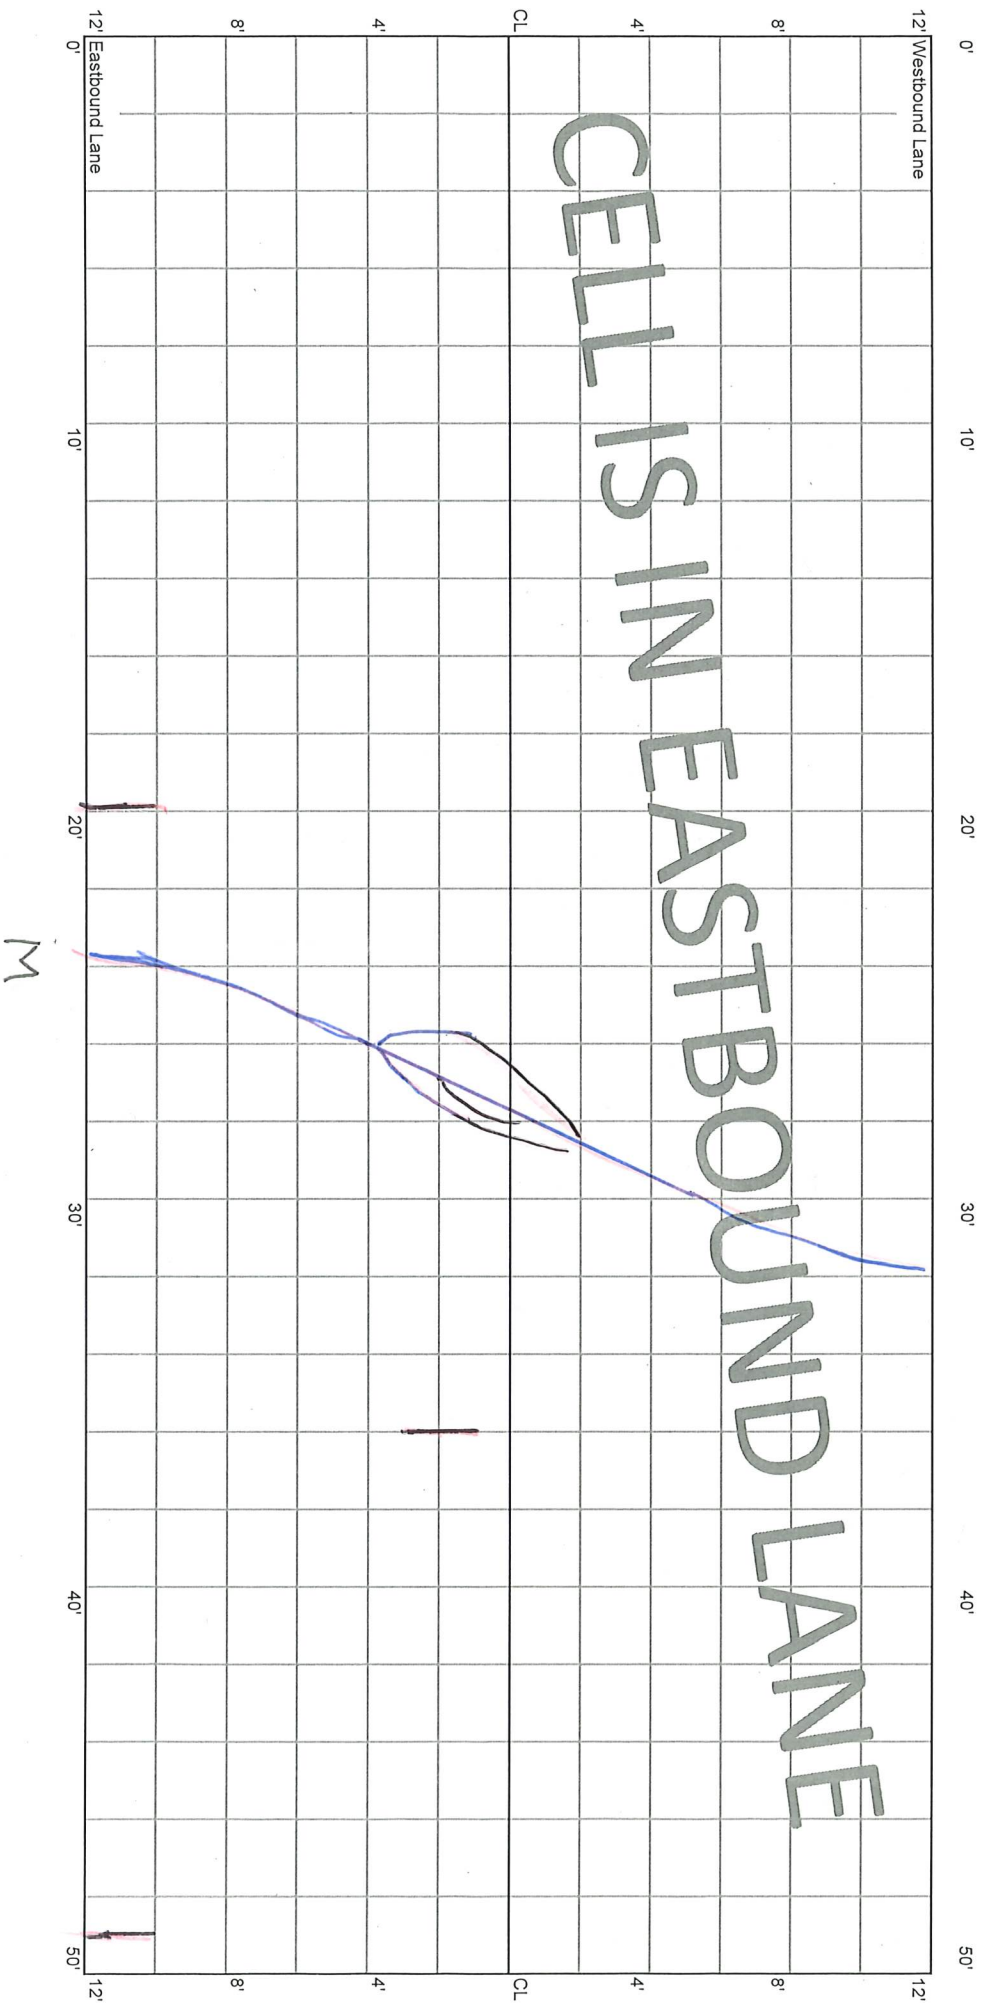


CELL IS IN EASTBOUND LANE

M

CELL 7007E
300 - 350 ft

36+00


36+50

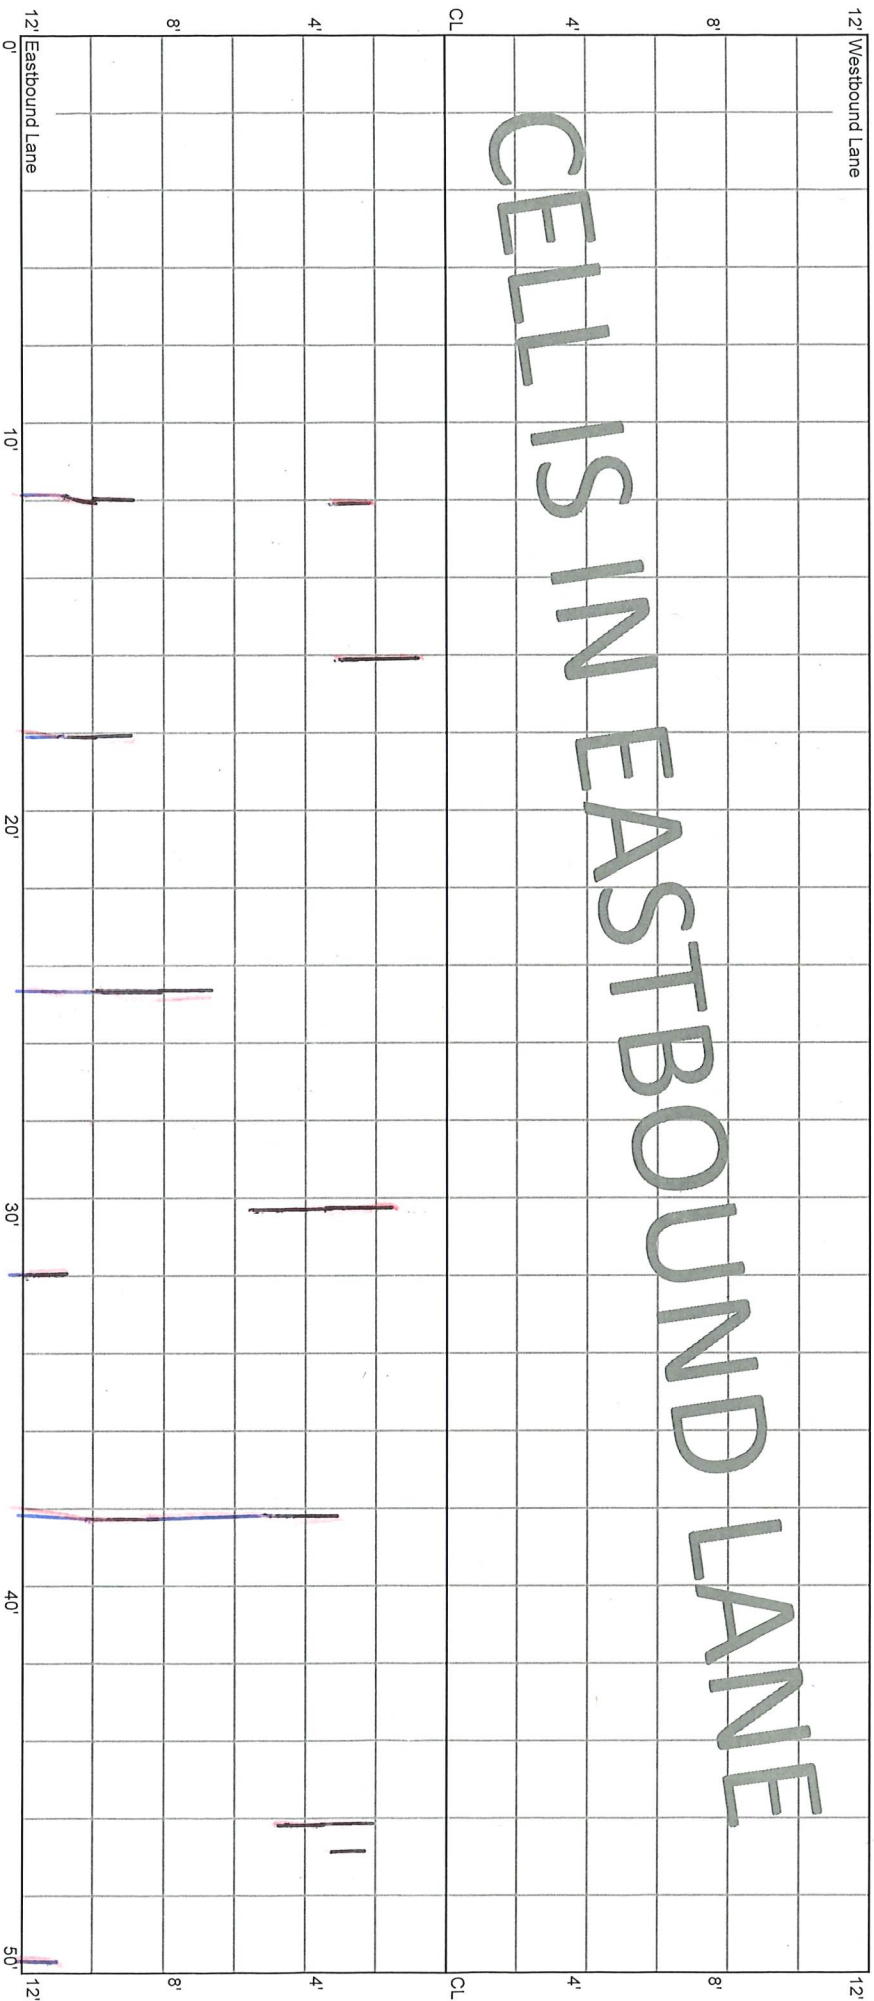

CELL 7007E
350 - 400 ft

36+50

37+00

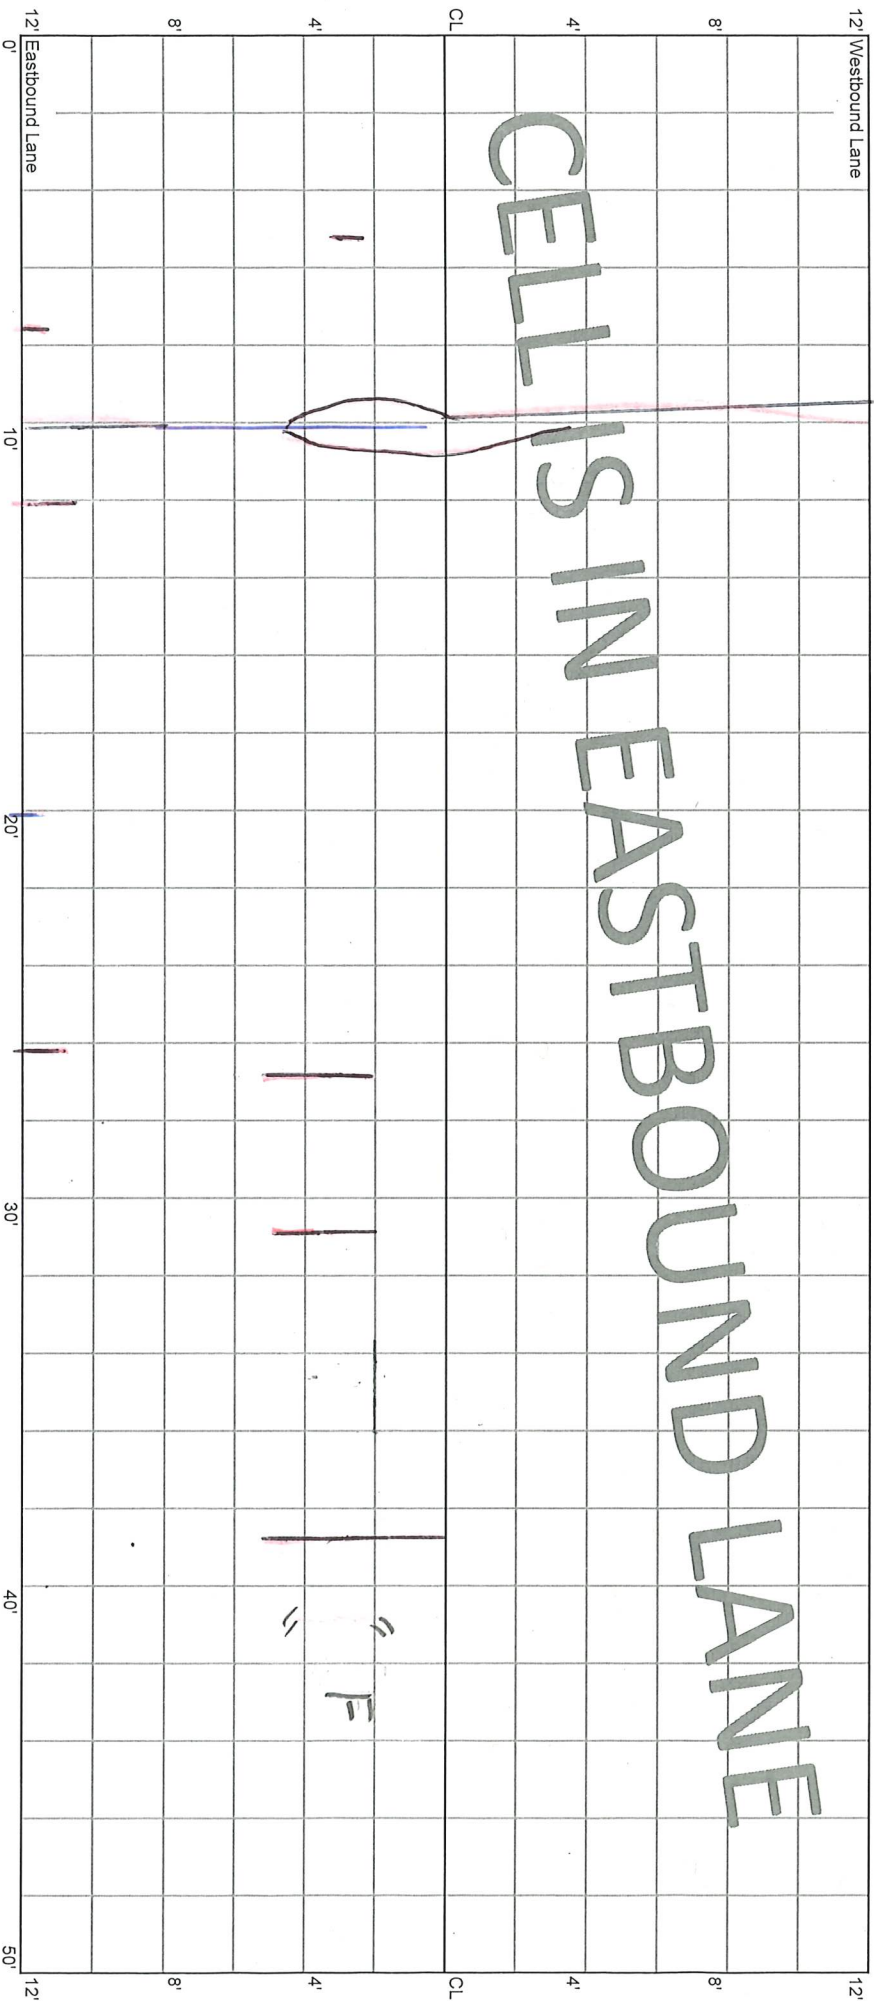

CELL IS IN EASTBOUND LANE

5/20/00
Shoulder Ruffin
outside P.F.
2944 - 380


M M

F

CELL 7007E
400 - 450 ft

37+00

37+50

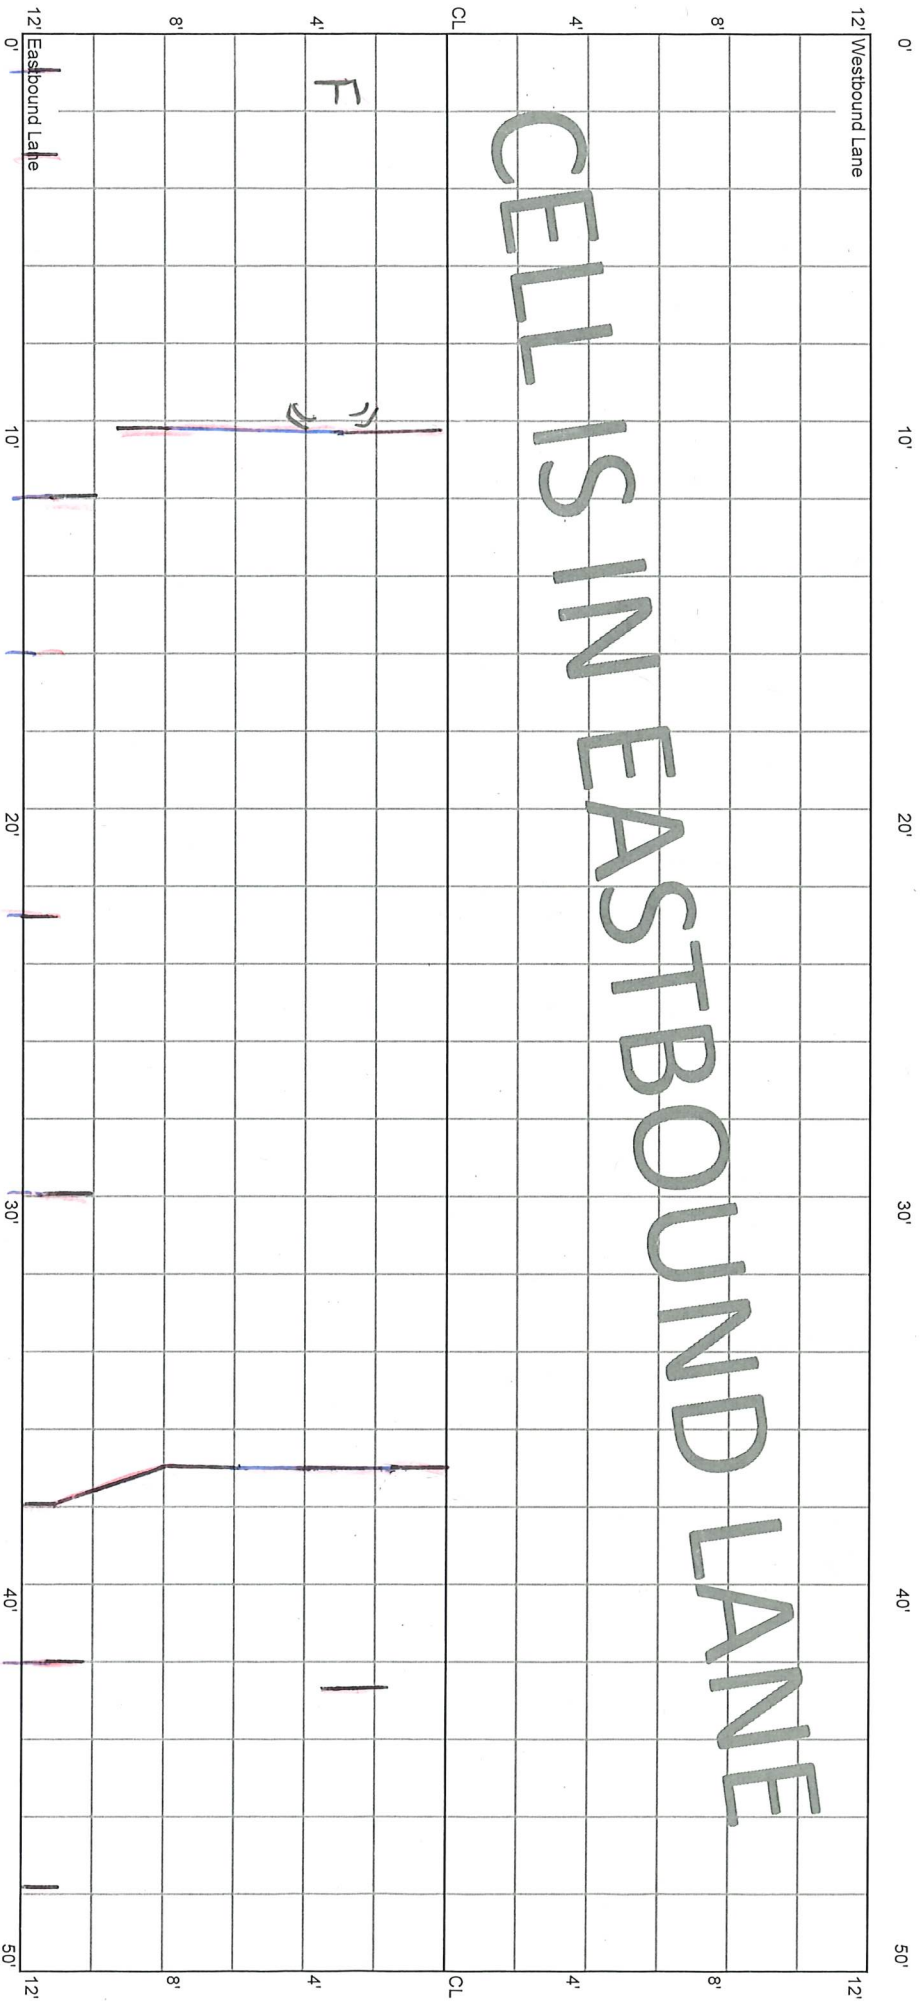


CELL 7007E
450 - 500 ft

37+50

38+00

CELL IS IN EASTBOUND LANE

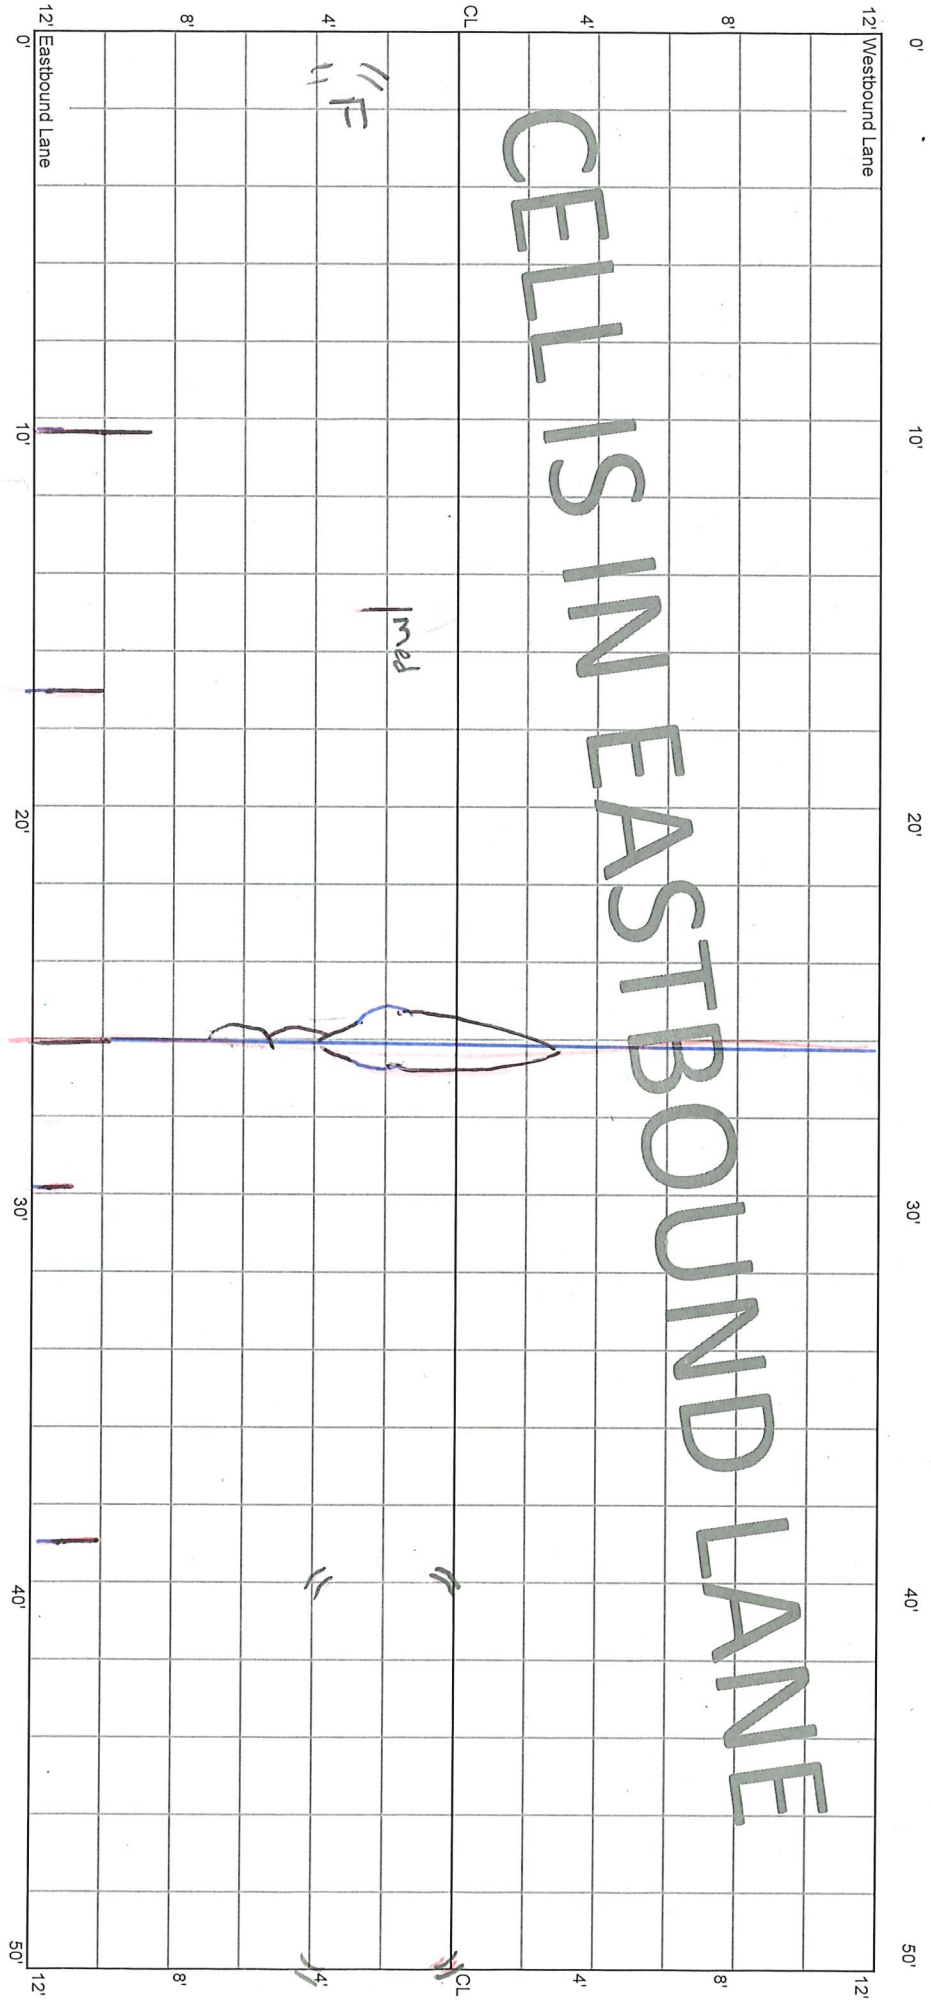

CELL 7007E
500 - 550 ft

38+00

16+25

38+50

