

8.25.21 - 35 Trans. cranes outside
Fog line.


5.28.20 EST. - No Distress
10.14.20 - No Distress
11.4.21 - No Distress

Cell 7016 W
CELL 7006W
0 - 50 ft

File 70TH ST
8.25.21
1.13.22
8.31.22
1.28.23
8.11.23
2.6.24

32+50

32+00

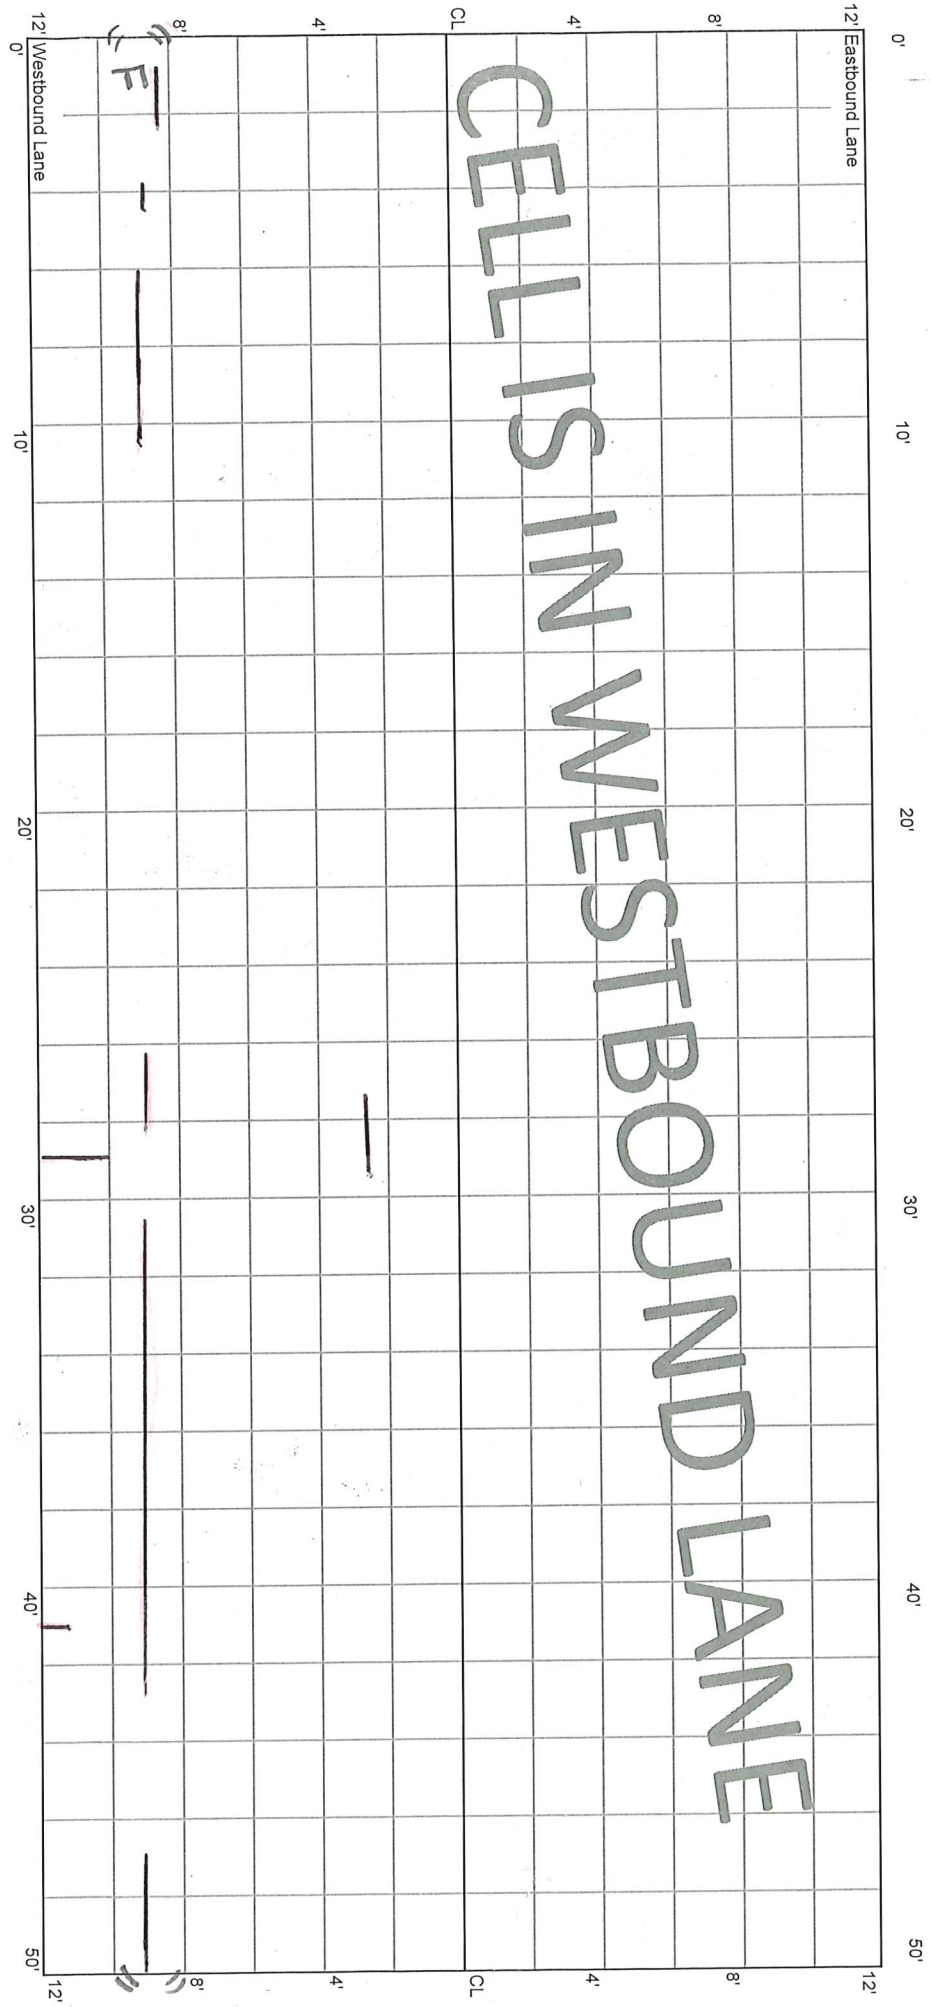


F=1.5' wide

** 2023 Clean & Seal

CELL 7006W
50 - 100 ft

32+00


31+50

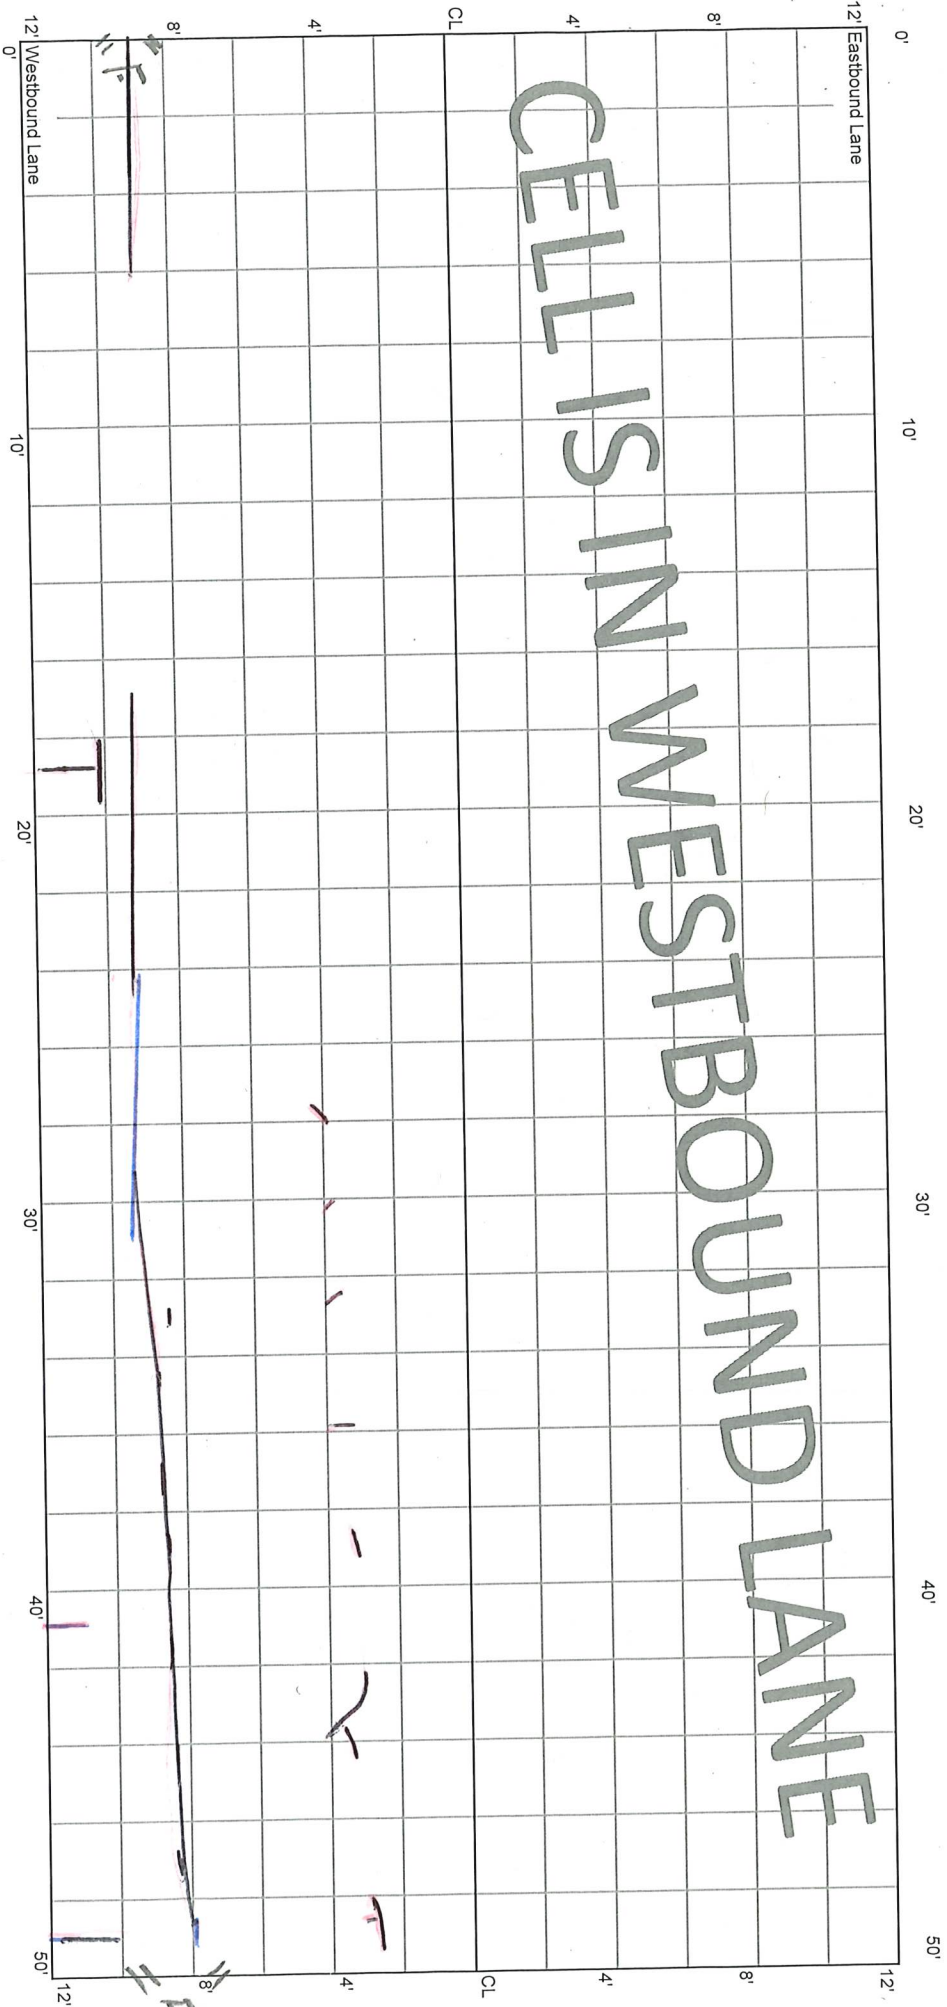

CELL 7006W
100 - 150 ft

31+50

31+00

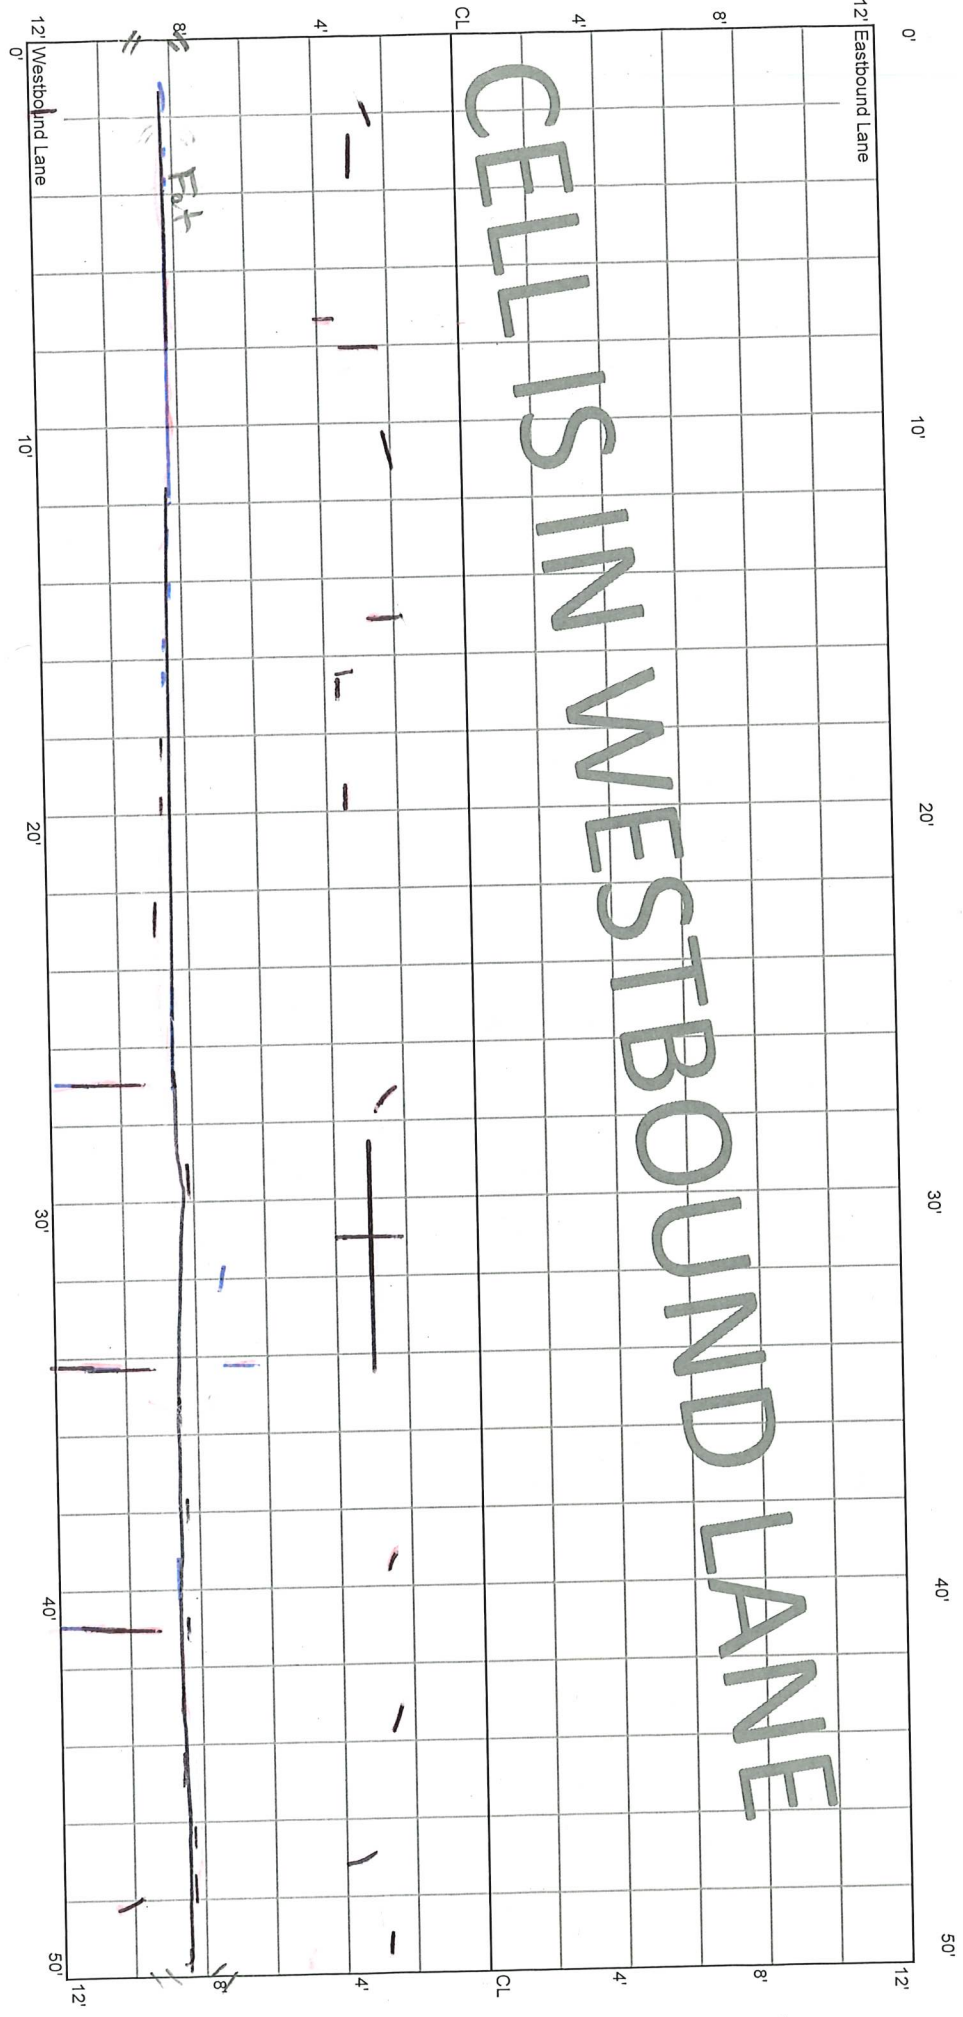

CELL 7006W
150 - 200 ft


31+00

30+50

12' Eastbound Lane

12' Westbound Lane

CELLS IN WESTBOUND LANE

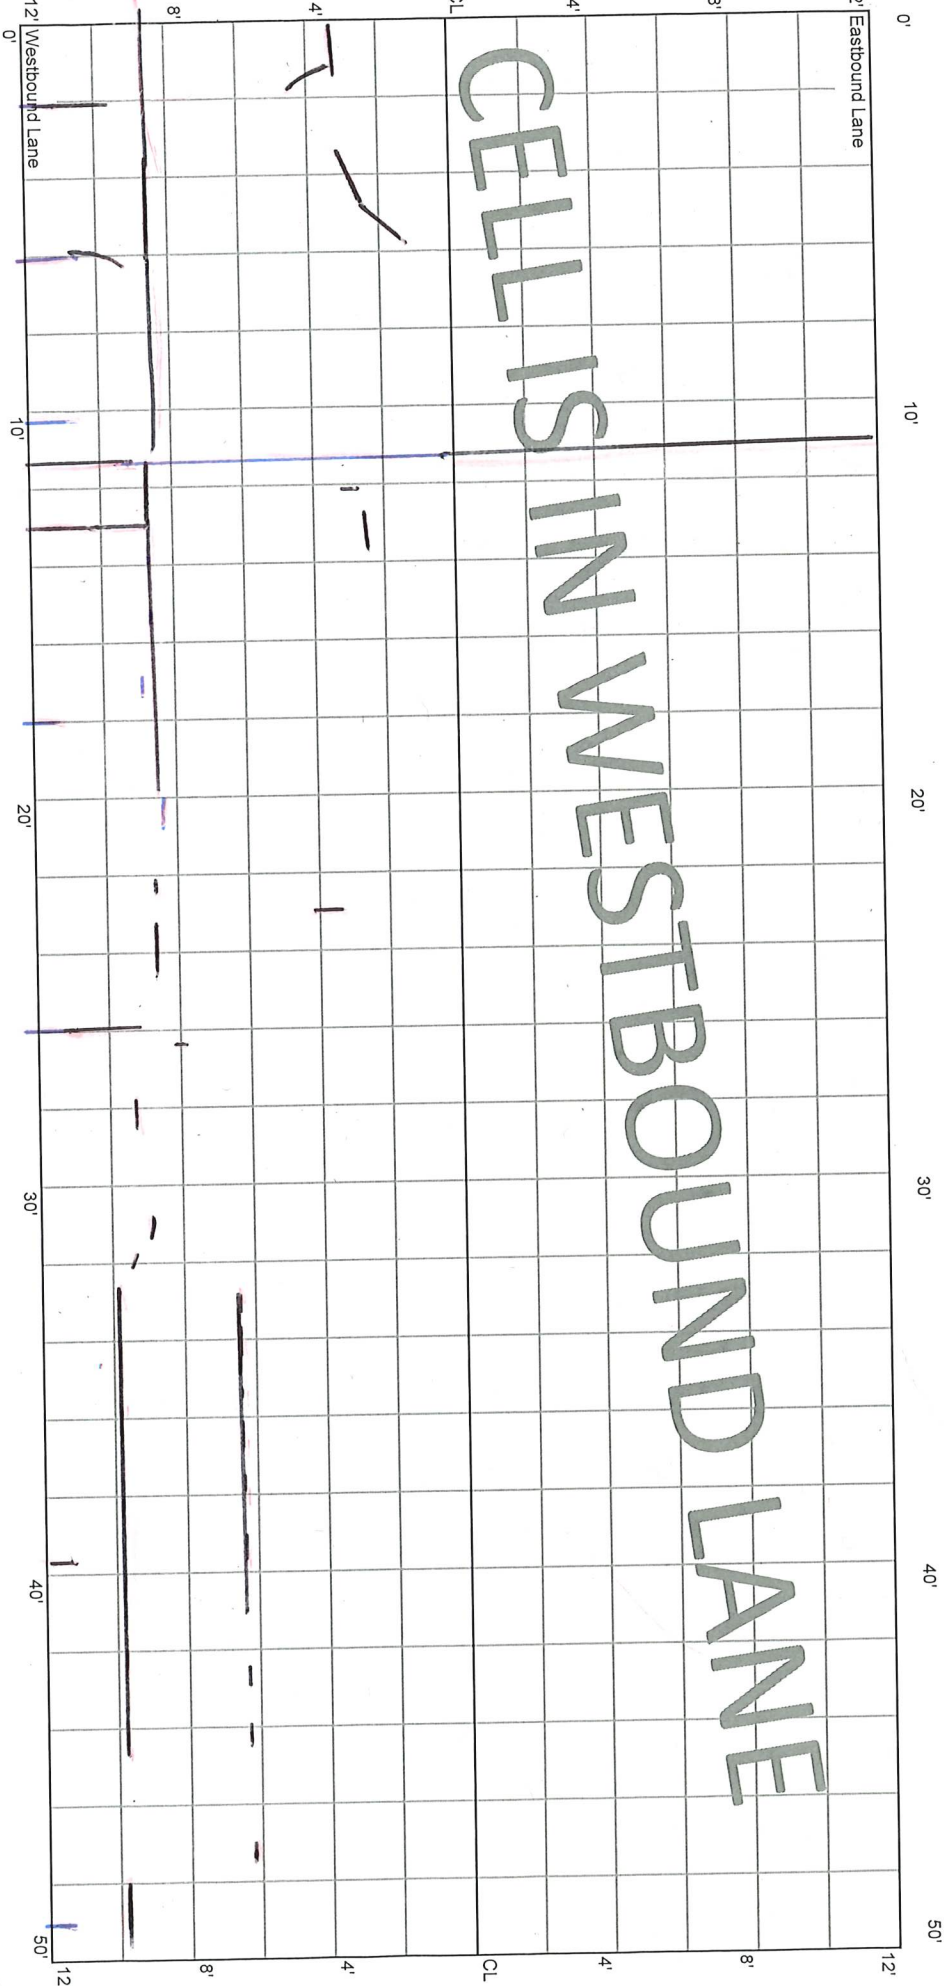


M

156

CELL 7006W
200 - 250 ft

30+50

30+00

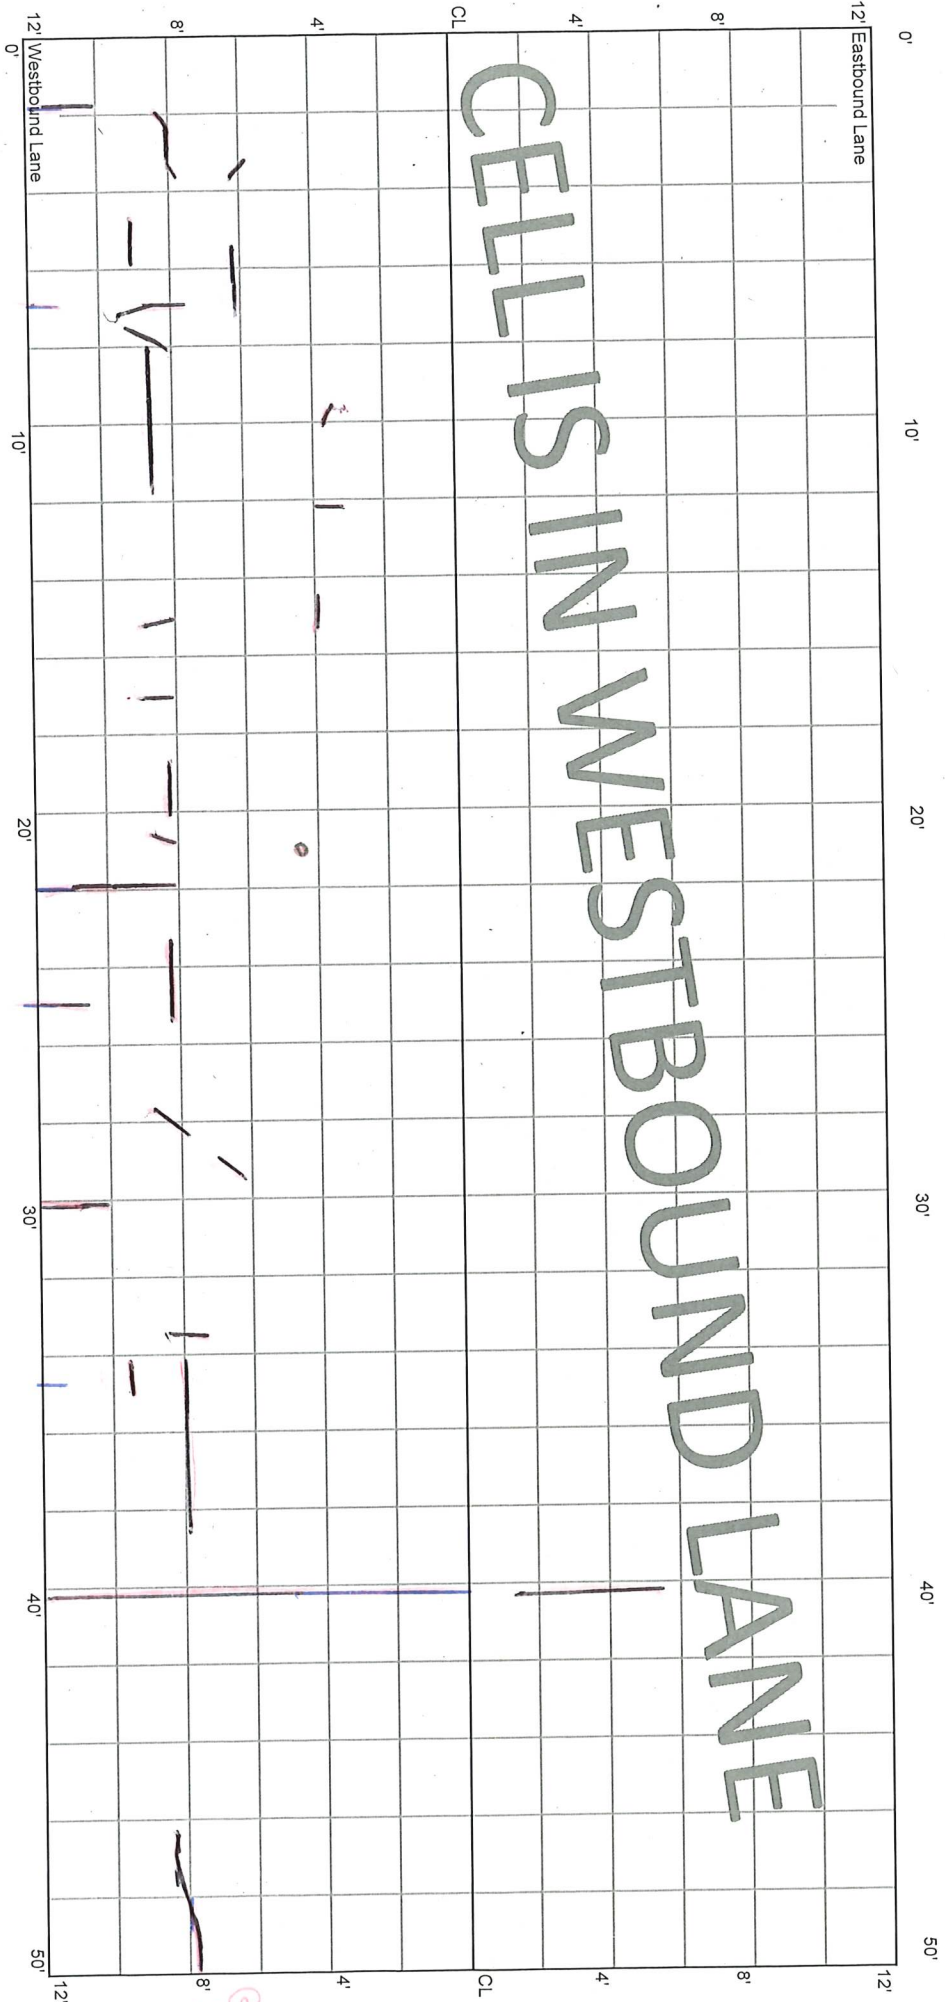

CELLS IN WESTBOUND LANE

M


B/C

8'

CELL 7006W
250 - 300 ft

30+00

29+50

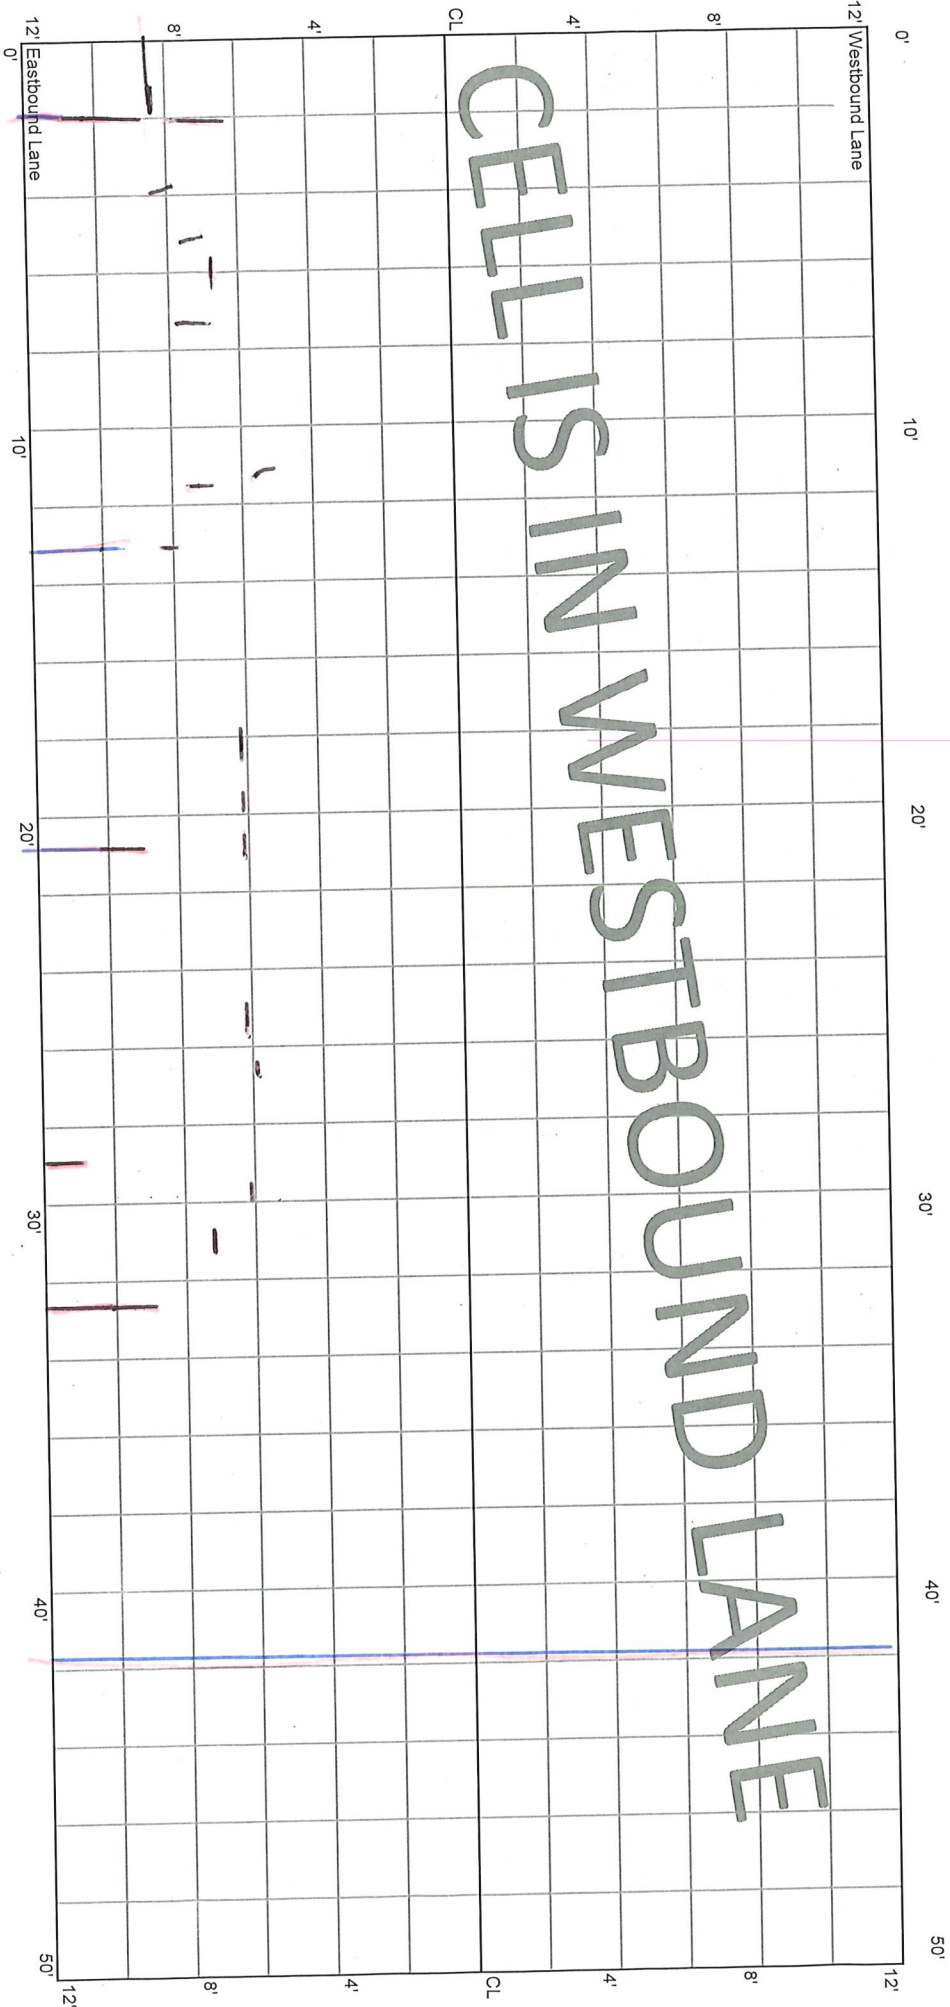


M
D/C

CELL 7006W
300 - 350 ft

29+50


29+00

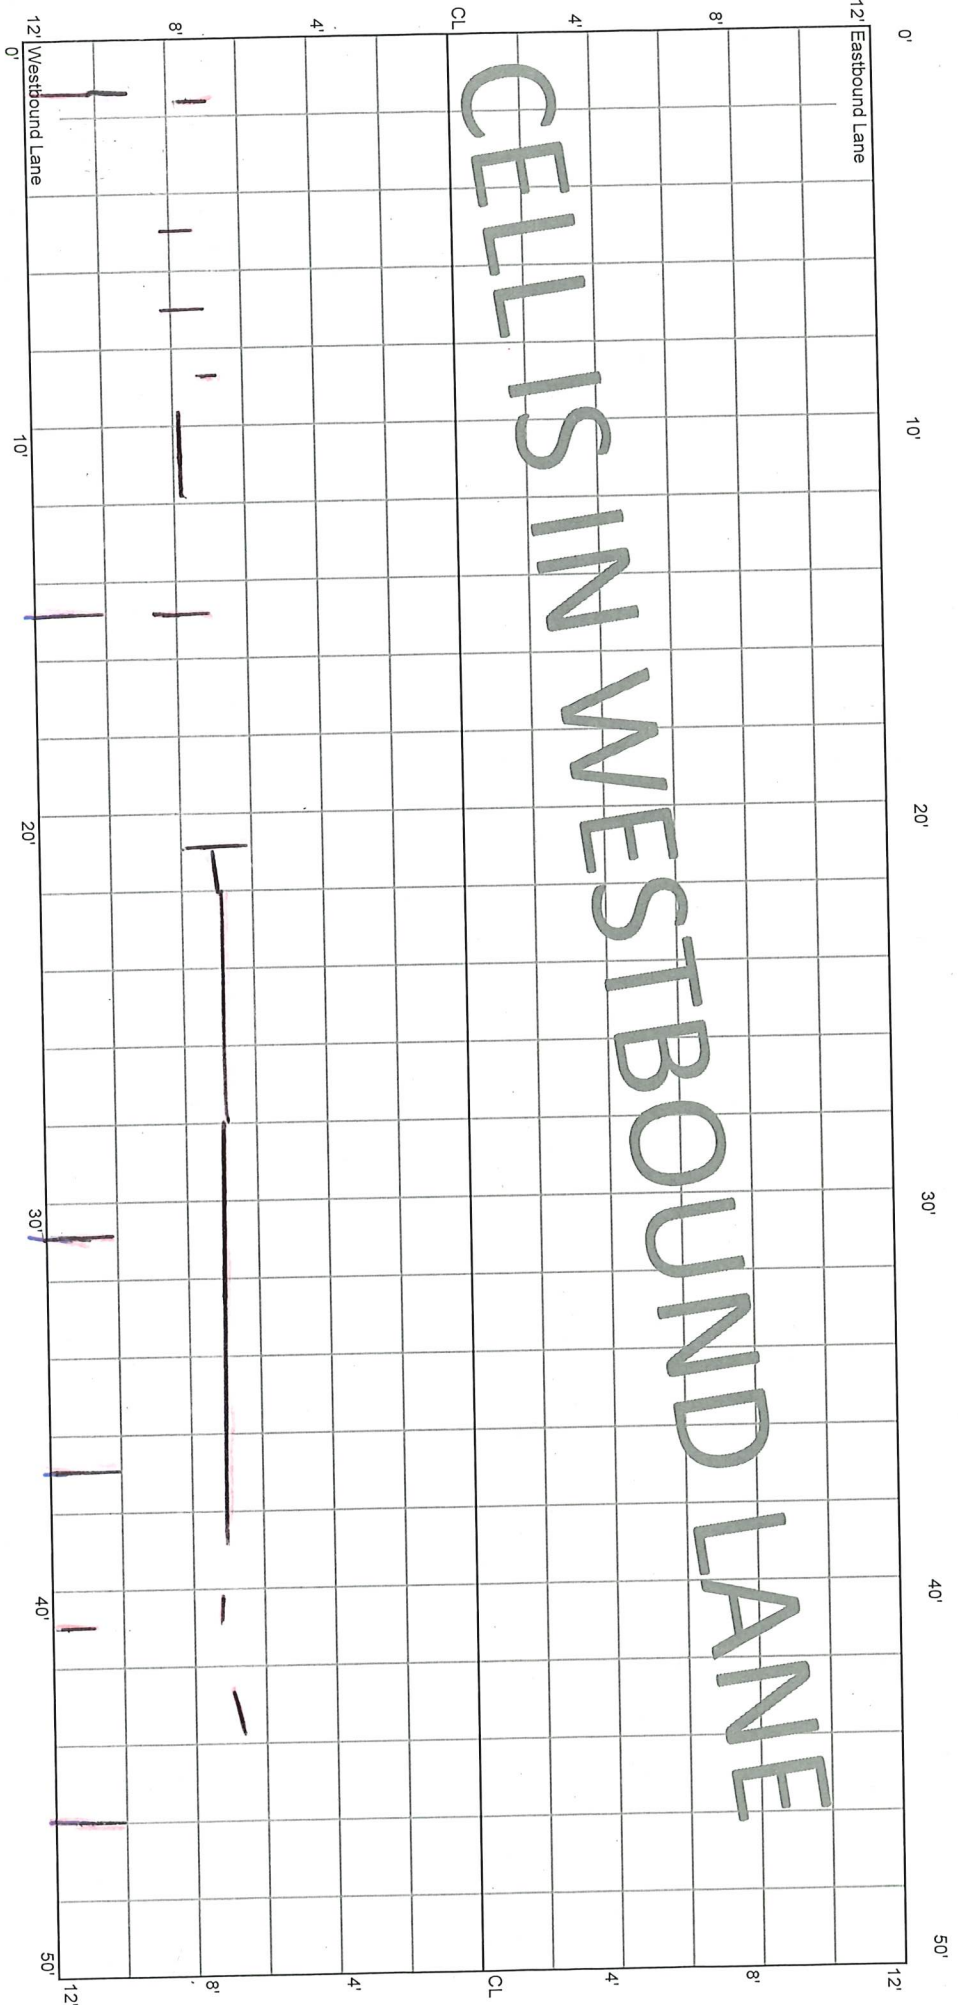

CELL 7006W
350 - 400 ft

29+00


28+50

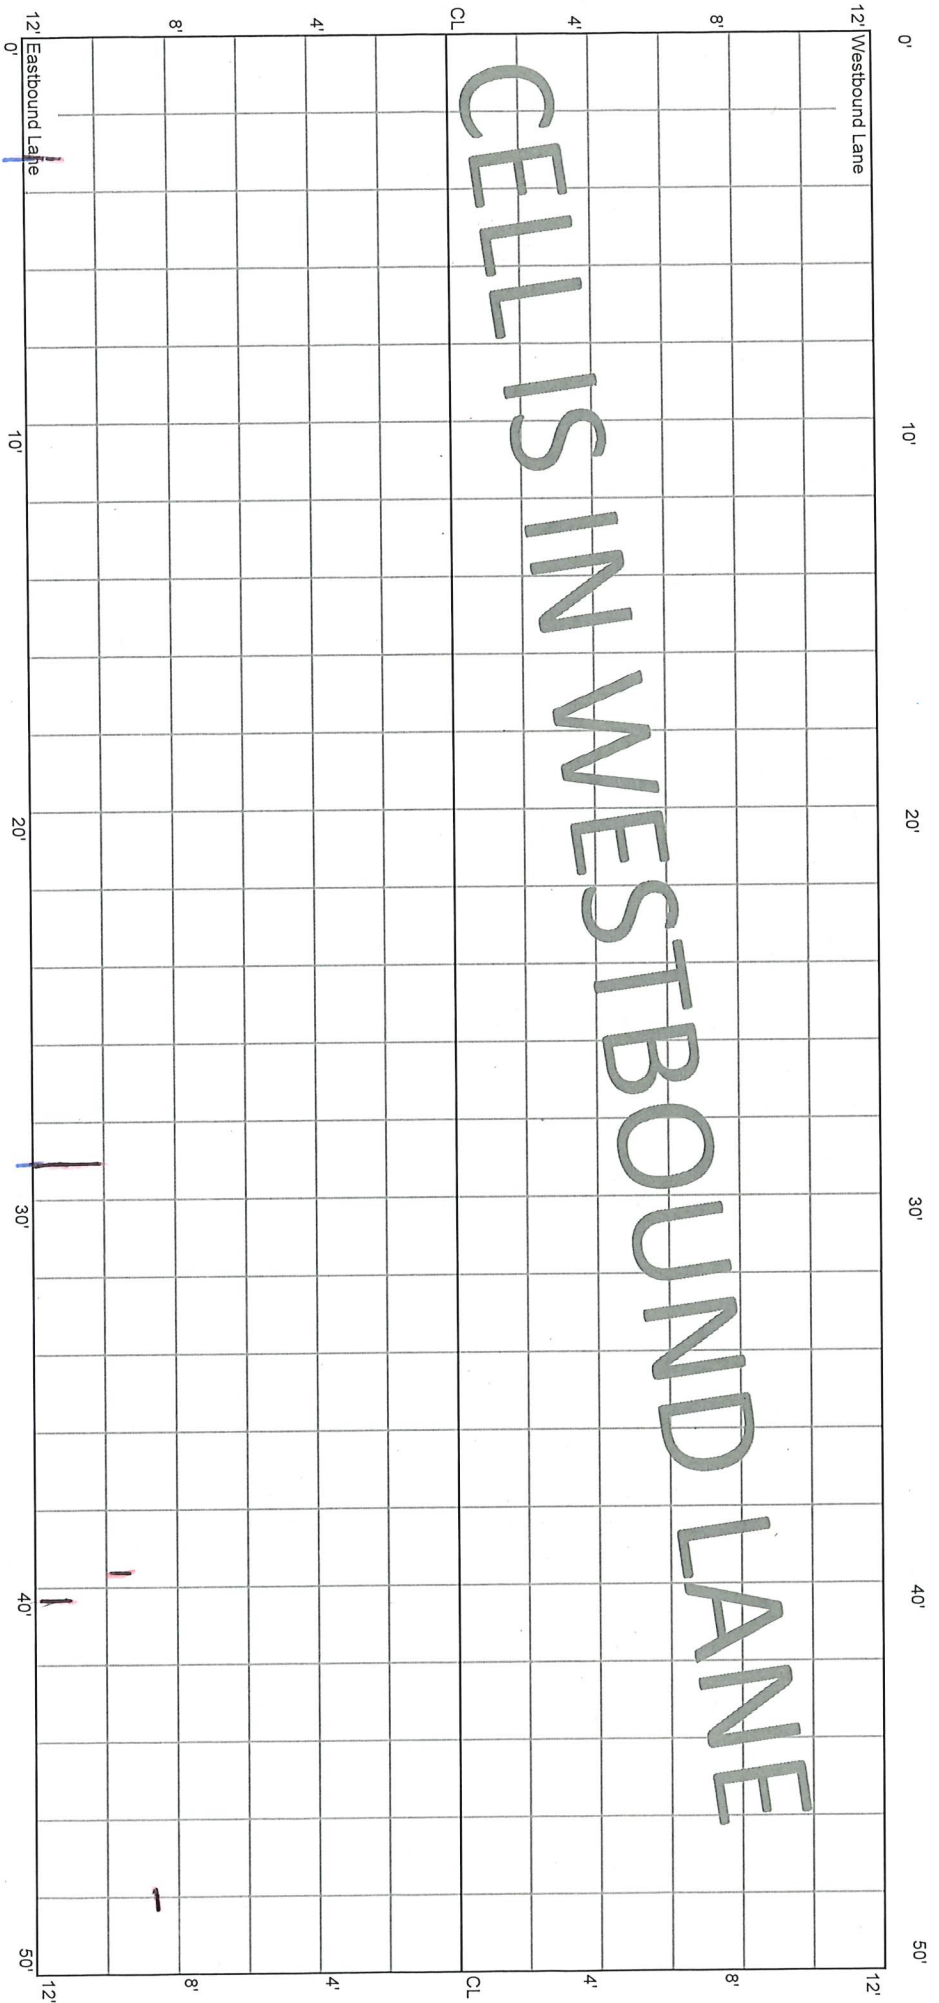

CELL 7006W
400 - 450 ft

28+50


28+00

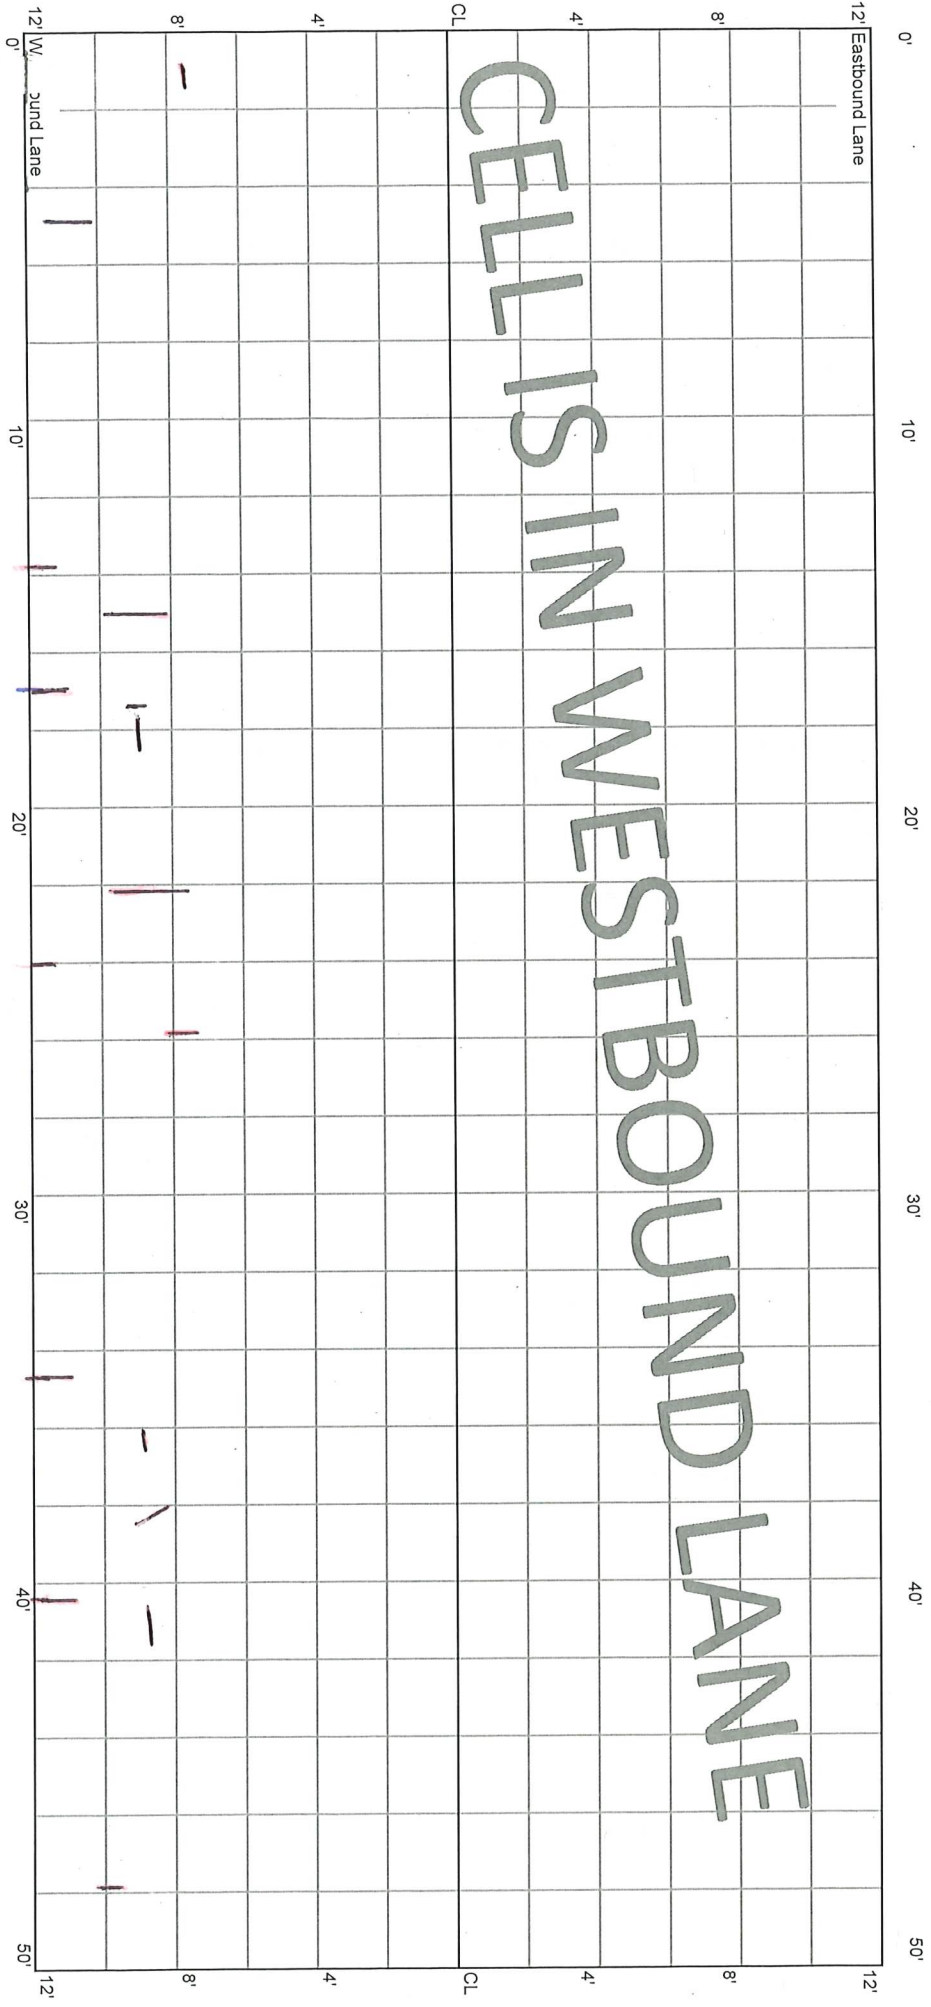

CELL 7006W
450 - 500 ft

28+00

27+50

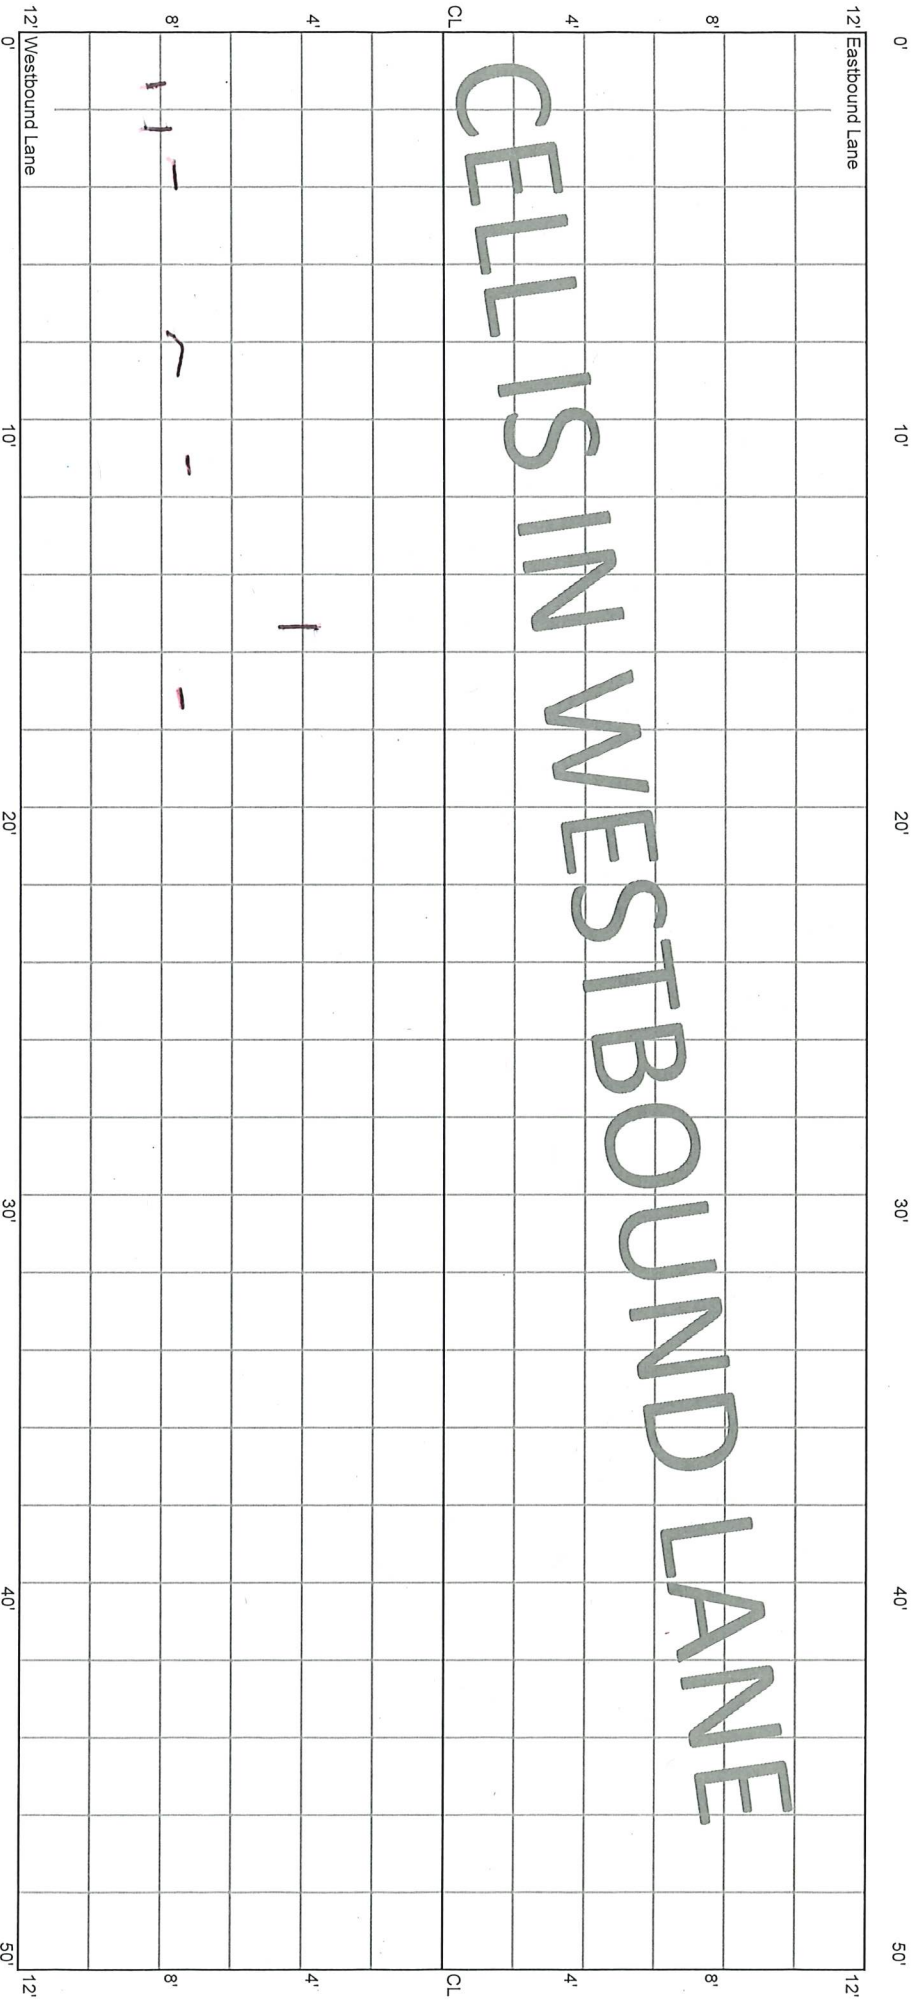

CELL 7006W
500 - 550 ft

27+50

27+25

27+00

