LEGEND

- INPLACE LIGHTING UNIT
- INPLACE ARMORED CABLE
- F.& I. ARMORED CABLE 4/C # 4
- 3" N.M.C. (DIRECT BURIED)

100

SCALE IN FEET

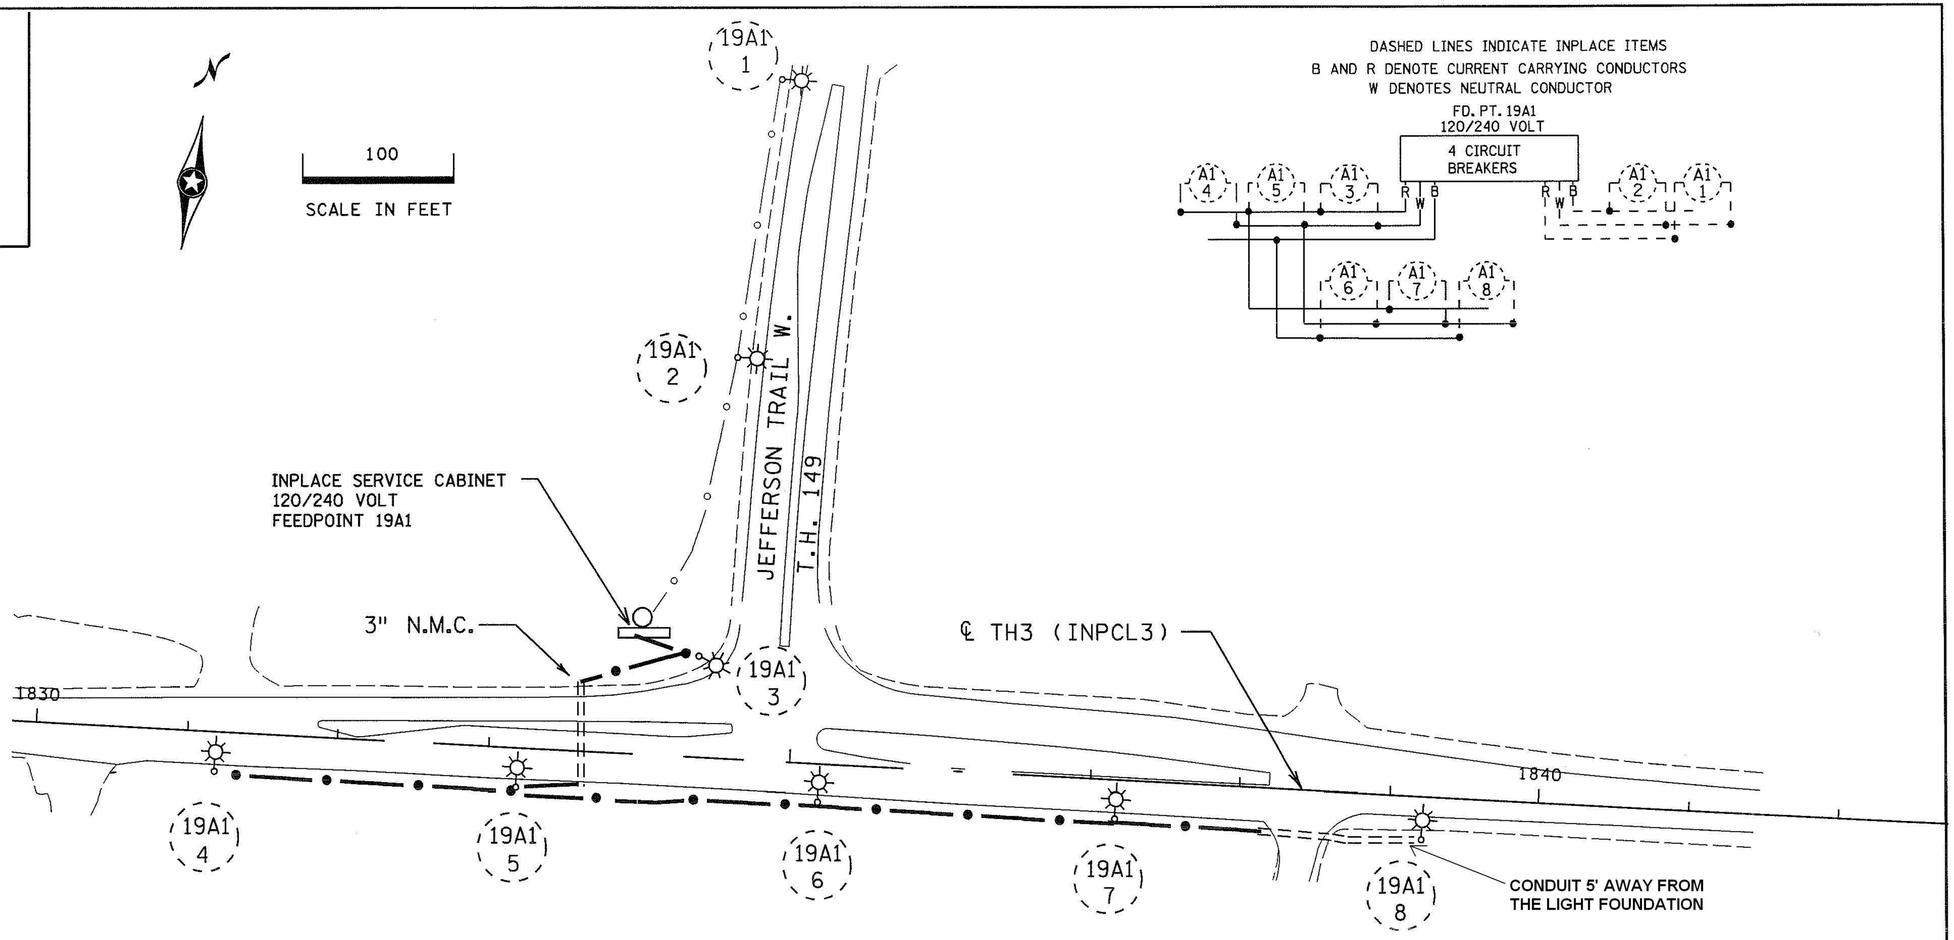

DASHED LINES INDICATE INPLACE ITEMS
B AND R DENOTE CURRENT CARRYING CONDUCTORS
W DENOTES NEUTRAL CONDUCTOR

TAB Q	TABULATION OF LIGHTING QUANTITIES	S.P. 1921-83 ESTIMATED QUANTITIES
ITEM	UNIT	TOTAL
ARMORED CABLE 4 COND NO 4	LIN. FT.	1050
3" N.M.C. (DIRECT BURIED)	LIN. FT.	135

BY	DATE	REVISIONS
DRAWN BY: NS	CKD BY: GB	DATE:

I HEREBY CERTIFY THAT SHEET 199A HAS BEEN PREPARED BY ME OR UNDER MY DIRECT SUPERVISION AND I AM A DULY LICENSED PROFESSIONAL ENGINEER UNDER THE LAWS OF THE STATE OF MINNESOTA.

MICHAEL GERBENSKY

DATE LIC. NO 19863

AS BUILT

LIGHTING PLAN

STATE PROJ.NO.1921-83 (T.H.3) SHEET NO.199A OF 220 SHEETS

PLOTTED/REVISED: 4/27/2010

DISTRICT *: METRO
IPLOT NAME: dl92183_dr
PATH & FILENAME: c:\Project Wise\PW_Working\SzabiNic\dl160137\dl92183_dr.dgn