


 



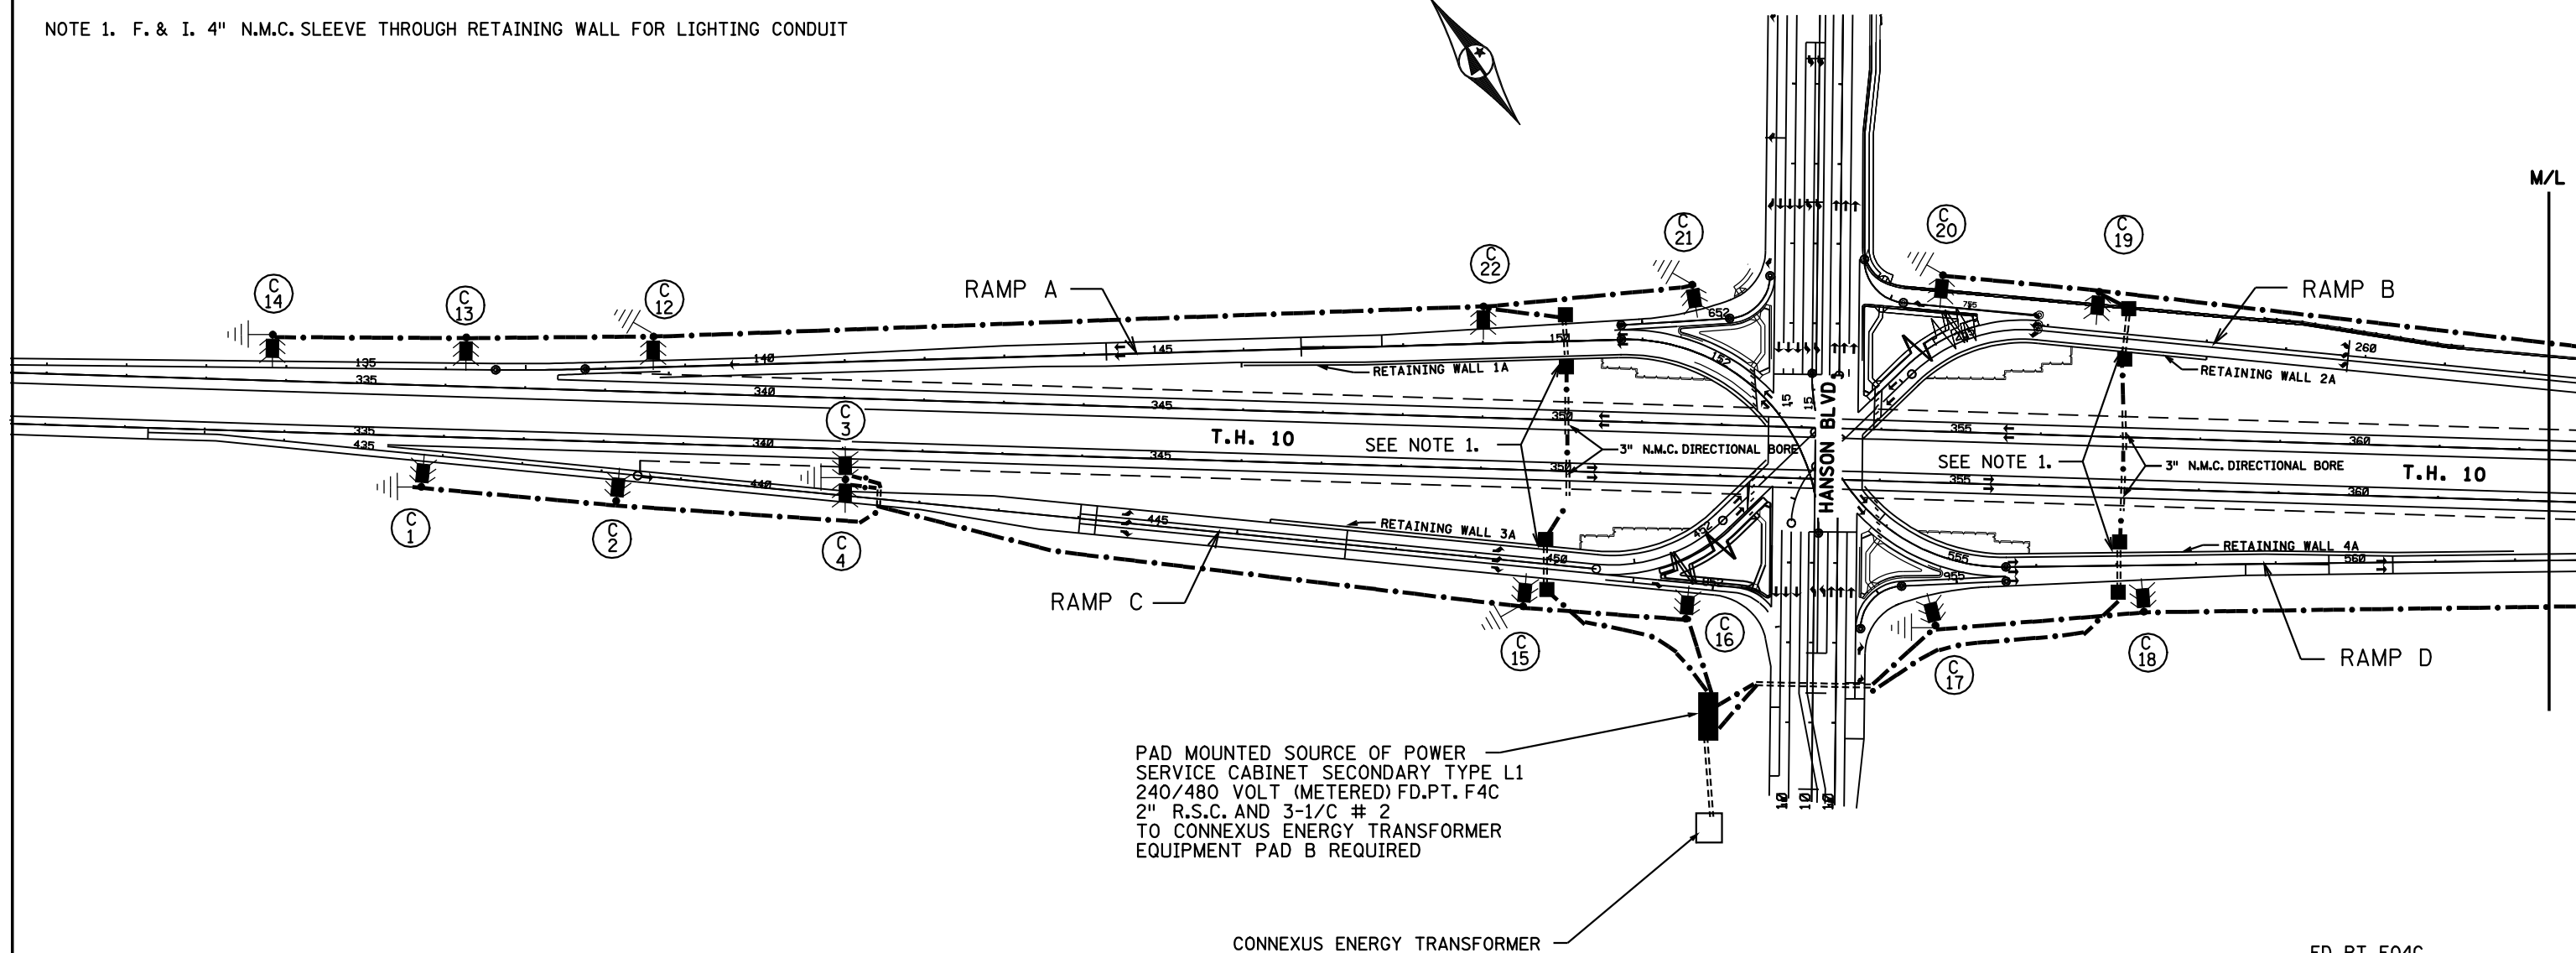
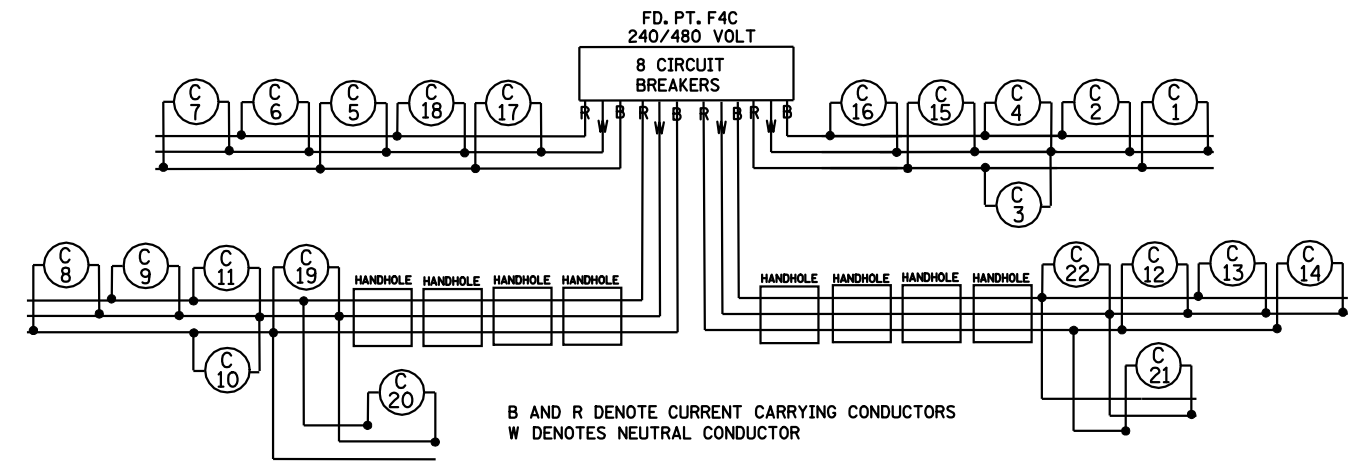


LEGEND


-  PAD MOUNTED SOURCE OF POWER (240/480 VOLT)
-  3" NON-METALLIC CONDUIT EXCEPT AS NOTED OTHERWISE
-  DIRECT BURIED POWER CABLE 4 CONDUCTOR NO. 4 AWG ARMORED CABLE SPEC. NO. 3815
-  250 WATT HIGH PRESSURE SODIUM LIGHTING UNIT
-  250 WATT HIGH PRESSURE SODIUM TWIN MAST ARM LIGHTING UNIT
-  PERMANENT GROUND ROD (25 OHMS OR LESS)
-  HANDHOLE

NOTE 1. F. & I. 4" N.M.C. SLEEVE THROUGH RETAINING WALL FOR LIGHTING CONDUIT

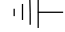

FD. PT. F04C
BUILT PER PLAN
LIGHTING PLAN (T.H. 10)

LIGHTING LAYOUT


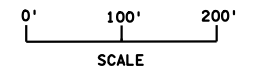


METER ADDRESS: 11456 HANSON BLVD.

FEEDPOINT F4C

LIGHTING STANDARDS AND BASES					
NO.	STATION	LT.	RT.	LOCATION	TYPE
1	435+80		-	RAMP C	VM-45
2	438+20		-	RAMP C	VM-45
3	341+00		-	E.B. T.H. 10	VMD-45
4					
5	574+10		-	RAMP D	VM-45
6	576+50		-	RAMP D	VM-45
7	578+90		-	RAMP D	VM-45
8	273+00	-		RAMP B	VM-45
9	270+60	-		RAMP B	VM-45
10	367+80	-		W.B. T.H. 10	VMD-45
11					
12	138+60	-		RAMP A	VM-45
13	136+20	-		RAMP A	VM-45
14	133+80	-		RAMP A	VM-45
15	449+70		-	RAMP C	VM-40
16	851+70		-	CONN C	VM-40
17	954+70		-	CONN D	VM-40
18	557+30		-	RAMP D	VM-40
19	256+60	-		RAMP B	VM-40
20	754+60	-		CONN B	VM-40
21	651+60	-		CONN A	VM-40
22	149+00	-		RAMP A	VM-40

SEE DETAIL SHEET FOR LIGHT UNIT PLACEMENT

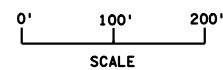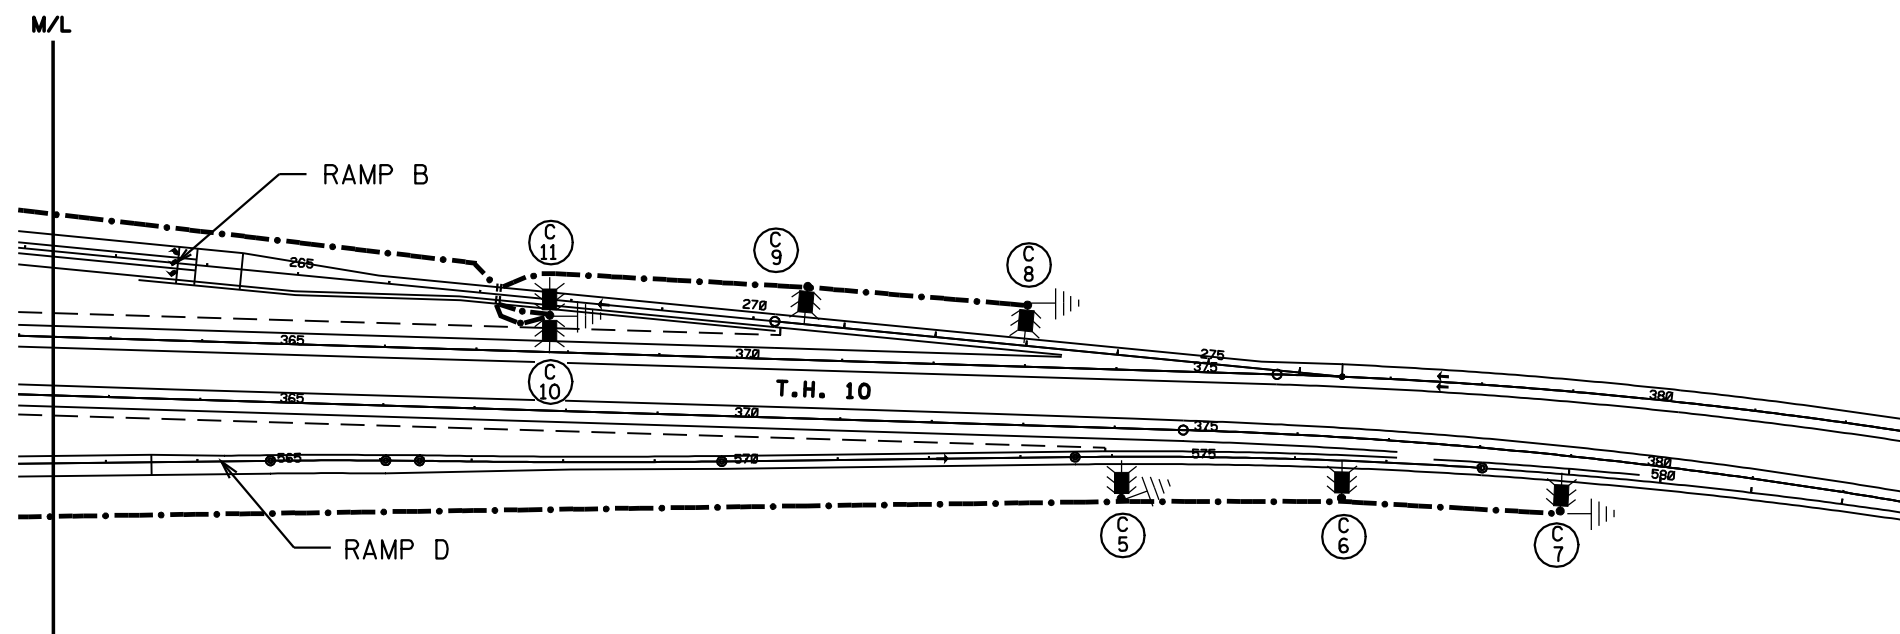

FD. PT. F04C
BUILT PER PLAN
LIGHTING PLAN (T.H. 10)

LIGHTING LAYOUT