

LEGEND




FD. PT. F27A

LIGHTING STANDARDS AND BASES					
NO.	STATION	LT.	RT.	LOCATION	TYPE
(1)	1	INP. 46+865	---	T.H. 610 W.B.	2B-12
(1)	2	INP. 46+930	---	T.H. 610 W.B.	2B-12
(1)	3	INP. 47+005	---	T.H. 610 W.B.	2B-12
(1)	4	INP. 47+080	---	T.H. 610 W.B.	2B-12
(1)	5	INP. 47+155	---	T.H. 610 W.B.	2B-12
(1)	6	INP. 47+230	---	T.H. 610 W.B.	2B-12
	7	46+865	---	T.H. 610 E.B.	2B-12
	8	46+930	---	T.H. 610 E.B.	2B-12
	9	47+005	---	T.H. 610 E.B.	2B-12
	10	47+080	---	T.H. 610 E.B.	2B-12
	11	47+155	---	T.H. 610 E.B.	2B-12
	12	47+230	---	T.H. 610 E.B.	2B-12

(1) F. & I. 250 WATT HIGH PRESSURE SODIUM LUMINAIRE

- PAD MOUNTED SOURCE OF POWER (240/480 VOLT)
- ⊛ 250 WATT HIGH PRESSURE SODIUM LIGHTING UNIT
- ⊛ 400 WATT HIGH PRESSURE SODIUM LIGHTING UNIT
- ⊛ 400 WATT HIGH PRESSURE SODIUM LIGHTING UNIT
- ⊛ 400 WATT HIGH PRESSURE SODIUM TWIN MAST ARM LIGHTING UNIT
- ⊛ INPLACE HIGH MAST LIGHTING UNIT
- PULLBOX
- INPLACE RIGID STEEL CONDUIT
- ===== F. & I. 78 mm RIGID STEEL CONDUIT
- INPLACE ARMORED CABLE
- F. & I. ARMORED CABLE
- ||| PERMANENT GROUND ROD (25 OHMS OR LESS)

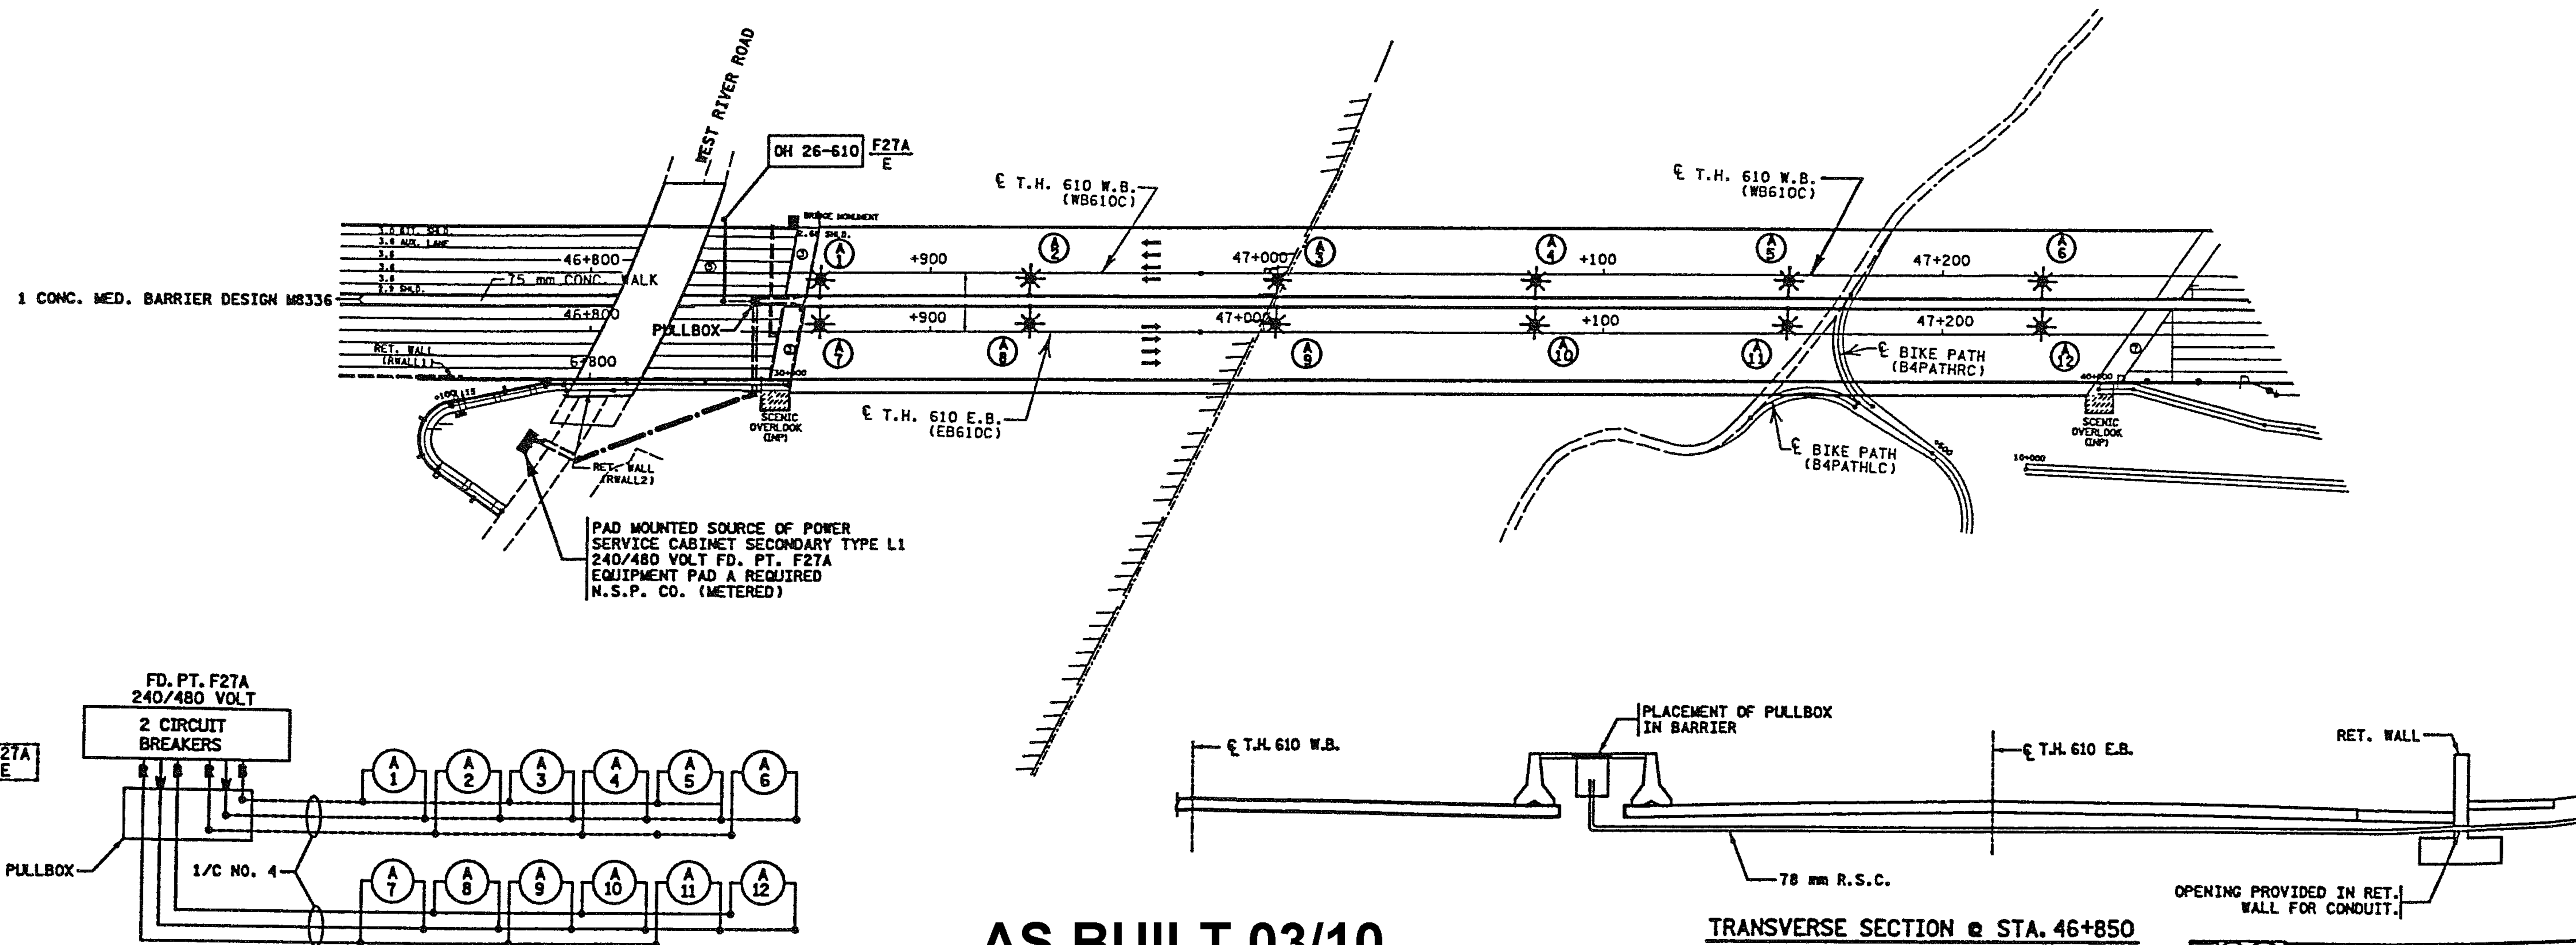

AS BUILT 03/10

TRANSVERSE SECTION @ STA. 46+850

LIGHTING PLAN