


B & R DENOTE CURRENT CARRYING CONDUCTORS  
 W DENOTES NEUTRAL CONDUCTOR  
 DASHED LINES DENOTE BY OTHERS

- LEGEND**
- PAD MOUNTED SOURCE OF POWER BY OTHERS 240/480V.
  - \* 200 WATT HIGH PRESSURE SODIUM LIGHTING UNIT
  - \*\* 250 WATT HIGH PRESSURE SODIUM TWIN MAST ARM LIGHTING UNITS
  - \* 200 WATT HIGH PRESSURE SODIUM UNDERPASS LIGHTING UNIT

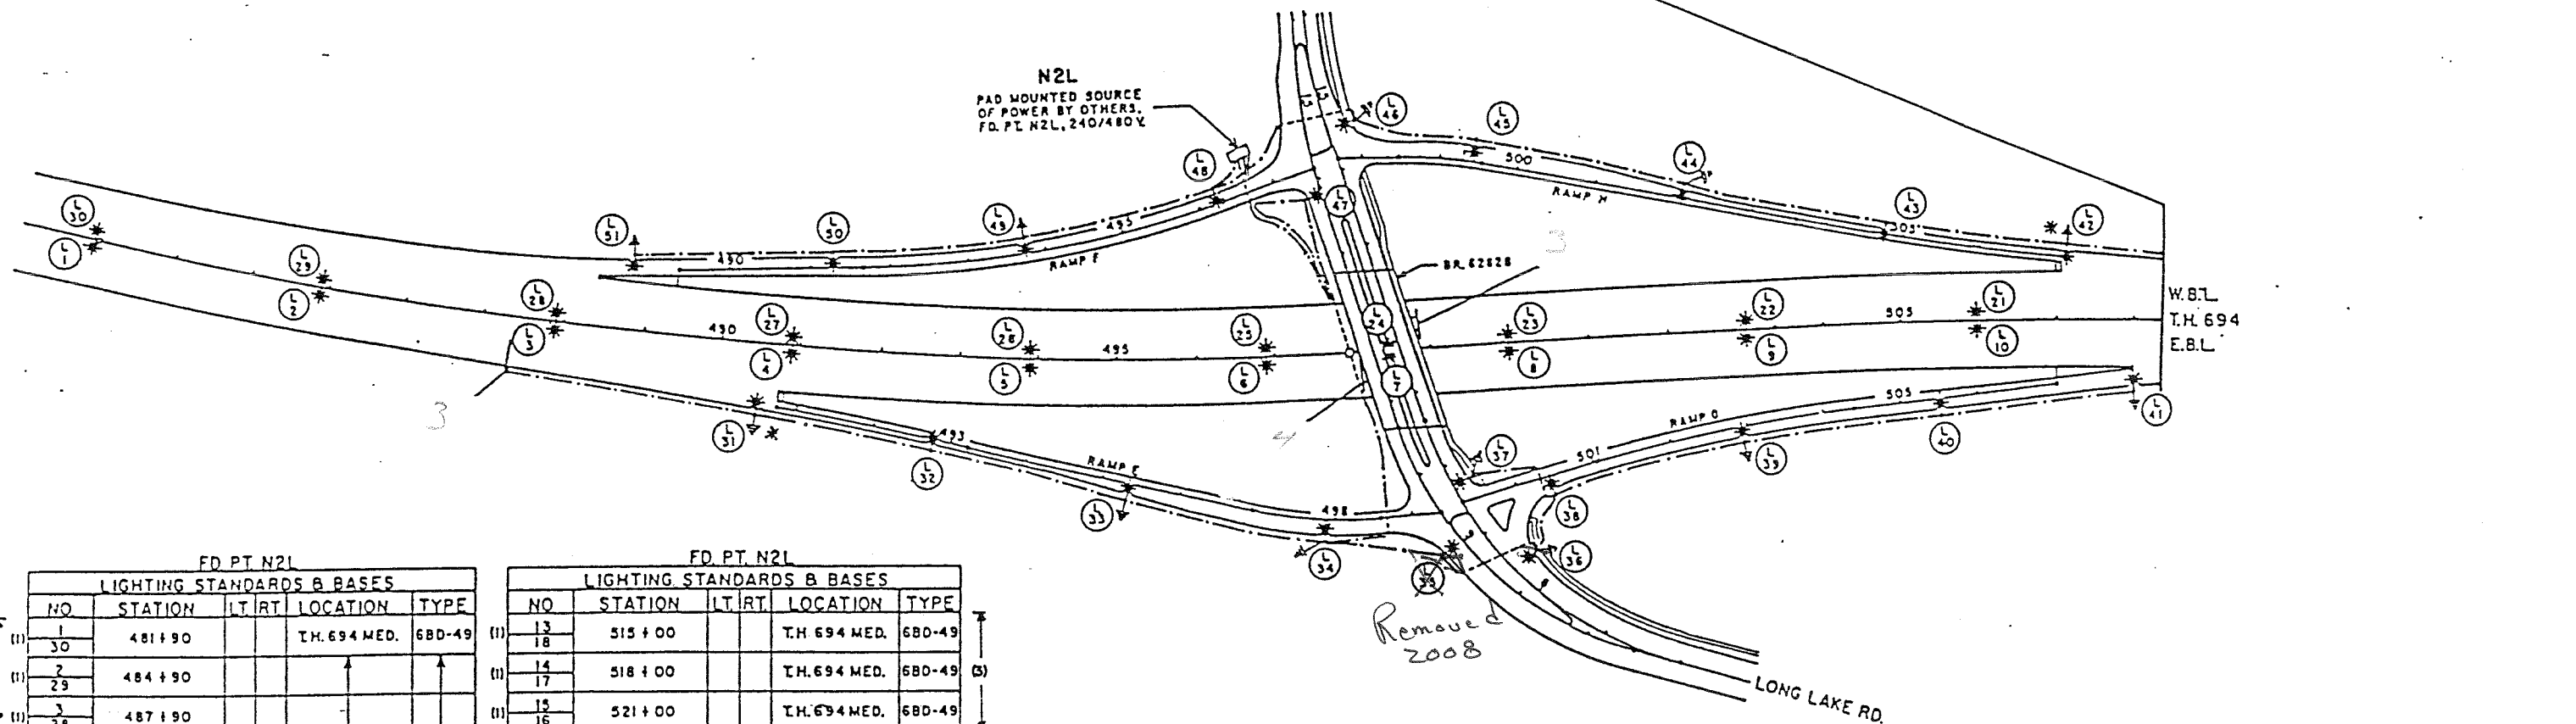

FD. PT. N2L LIGHTING STANDARDS & BASES

NO	STATION	LT/RT	LOCATION	TYPE
(1) 1	481+90		T.H. 694 MED.	6BD-49
(1) 2	484+90			
(1) 29	484+90			
(3) 3	487+90			
(3) 28	487+90			
(1) 4	490+90			
(1) 27	490+90			
(1) 5	493+90			
(1) 26	493+90			
(1) 6	496+90		T.H. 694 MED.	6BD-49
(1) 25	496+90			
(4) 7	498+50		T.H. 694 E.B.L.	L
(4) 24	498+50		T.H. 694 W.B.L.	L
(1) 8	500+00		T.H. 694 MED.	6BD-49
(1) 23	500+00			
(1) 9	503+00			
(1) 22	503+00			
(3) 10	506+00			
(3) 21	506+00			
(1) 11	509+00			
(1) 20	509+00			
(1) 12	512+00		T.H. 694 MED.	6BD-49
(1) 19	512+00			

FD. PT. N2L LIGHTING STANDARDS & BASES

NO	STATION	LT/RT	LOCATION	TYPE
(1) 13	515+00		T.H. 694 MED.	6BD-49
(1) 18	515+00			
(1) 14	518+00		T.H. 694 MED.	6BD-49
(1) 17	518+00			
(1) 15	521+00		T.H. 694 MED.	6BD-49
(1) 16	521+00			
(1) 31	490+55		T.H. 694 E.B.L.	6-40
(1) 32	492+80		RAMP F	
(1) 33	495+35		RAMP F	
(1) 34	497+90		RAMP F	6-40
(1) 35	9+00		LONG LK. RD.	6P-40
(1) 36	8+40		LONG LK. RD.	6P-40
(1) 37	9+75		LONG LK. RD.	6P-40
(1) 38	500+40		RAMP G	6-40
(1) 39	502+90		RAMP G	
(1) 40	505+50		RAMP G	
(1) 41	508+00		T.H. 694 E.B.L.	
(1) 42	507+10		T.H. 694 W.B.L.	
(1) 43	504+75		RAMP H	
(1) 44	502+10		RAMP H	
(1) 45	499+40		RAMP H	6-40
(1) 46	14+55		LONG LK. RD.	6P-40
(1) 47	13+80		LONG LK. RD.	6P-40
(1) 48	495+25		RAMP F	6-40
(1) 49	493+75		RAMP F	6-40
(1) 50	491+25		RAMP F	6-40
(1) 51	488+75		RAMP F	6-40

- (1) LIGHT ANCHORAGE BY OTHERS
- (2) 200 WHPS
- (3) 250 WHPS
- (4) 200 WHPS UNDERPASS LIGHTS

**SHEET TOTAL**

- 28 - 250 WATT HIGH PRESSURE SODIUM LIGHTING UNITS
- 21 - 200 WATT HIGH PRESSURE SODIUM LIGHTING UNITS
- 2 - 200 WATT HIGH PRESSURE SODIUM UNDERPASS LIGHTS

**GRAND TOTAL**

- 60 - 250 WATT HIGH PRESSURE SODIUM LIGHTING UNITS
- 37 - 200 WATT HIGH PRESSURE SODIUM LIGHTING UNITS
- 4 - 200 WATT HIGH PRESSURE SODIUM UNDERPASS LIGHTS

**EXHIBIT 53E**  
**T.H. 694 & LONG LAKE RD.**  
**IN NEW BRIGHTON**  
**N.S.P.**

**FD. PT. N2L**

TELETYPE POST - 121M 10/86 N84170