

FD. PT. P6H
LIGHTING STANDARD & BASES

NO.	STATION	LT. RT.	LOCATION	TYPE
(1)(3) 1	1133 + 05		T.H. 394 MED.	68D-49
(1)(3) 2	1136 + 55			
(8) 3	1140 + 05			
(1)(3) 4	1143 + 55			
(1)(3) 5	1147 + 05			
(1)(3) 6	1150 + 35			
(1)(3) 7	1153 + 65			
(1)(3) 8	1156 + 95		T.H. 394 MED.	68D-49
(3)(5) 9	1134 + 80	-	E.B.C-D	68-40
(3)(5) 10	1138 + 30	-		68-40
(3)(5) 11	1141 + 80	-		68-40
(3)(5) 12	1145 + 20	-		68-40
(5) 13	1147 + 70	-		6-40
(5) 14	1150 + 20	-	E.B.C-D	6-40
(5) 15	1190 + 90	-	LOOP F	6-40

(1) 250 WATT HIGH PRESSURE SODIUM
(3) LIGHT ANCHORAGE BY OTHERS
(5) FUTURE LIGHTING UNIT

FD. PT. P6H
LIGHTING STANDARDS & BASES

NO.	STATION	LT. RT.	LOCATION	TYPE
(5) 16	14 + 00	-	LOOP F	6-40
(5) 17	16 + 20	-	LOOP F	6-40
(5) 18	11 + 30	-	RAMP F	6-40
(5) 19	13 + 20	-	RAMP F	68-40
(5) 20	15 + 70	-	RAMP F	(3)
(5) 21	18 + 00	-	RAMP F	(3)
(5) 22	1155 + 30	-	E.B.C-D	(3)
(5) 23	1152 + 00	-	W.B.C-D	(3)
(5) 24	1148 + 70	-	W.B.C-D	(3)
(5) 25	1146 + 45	-	W.B.C-D	68-40 (3)
(5) 26	12 + 30	-	LOOP F	6-40
(5) 27	1144 + 50	-	W.B.C-D	(3)
(5) 28	1141 + 75	-	W.B.C-D	(3)
(5) 29	14 + 50	-	LOOP F	(3)
(5) 30	17 + 00	-	LOOP F	(3)
(5) 31	152 + 50	-	RAMP F	(3)
(5) 32	154 + 90	-	RAMP F	(3)
(5) 33	157 + 20	-	RAMP F	(3)
(5) 34	159 + 65	-	RAMP F	(3)
(5) 35	1137 + 90	-	W.B.C-D	(3)
(5) 36	1135 + 20	-	W.B.C-D	6-40

(5) 200 WATT HIGH PRESSURE SODIUM


GENERAL MILLS BLVD. FD. PT.
LIGHTING STANDARDS & BASES

NO.	STATION	LT. RT.	LOCATION	TYPE
(1) 29	57 + 25	-	GEN. MILLS BLVD	6P-40
(1) 30	59 + 80	-		6P-40
(4) 31	62 + 65	-		
(4) 32	63 + 55	-		
(1) 33	66 + 30	-		6P-40
(1) 34	68 + 85	-		6P-40
(1) 35	67 + 45	-		6P-40
(1) 36	65 + 20	-		6P-40
(4) 37	64 + 05	-		
(4) 38	63 + 15	-		
(4) 39	62 + 25	-		
(4) 40	60 + 85	-		6P-40
(4) 41	58 + 65	-	GEN. MILLS BLVD	6P-40

(1) 250 WATT HIGH PRESSURE SODIUM
(4) 250 WATT HIGH PRESSURE SODIUM UNDERPASS LIGHT

B AND R DENOTE CURRENT CARRYING CONDUCTOR
W DENOTES NEUTRAL CONDUCTOR
DASHED LINES DENOTE INR OR BY OTHERS
SOLID LINES DENOTE F & I.

LIGHTING UNITS NO. P6H/1-16 & P6H/2-15
SHALL BE WIRED FROM P6J/5-6.

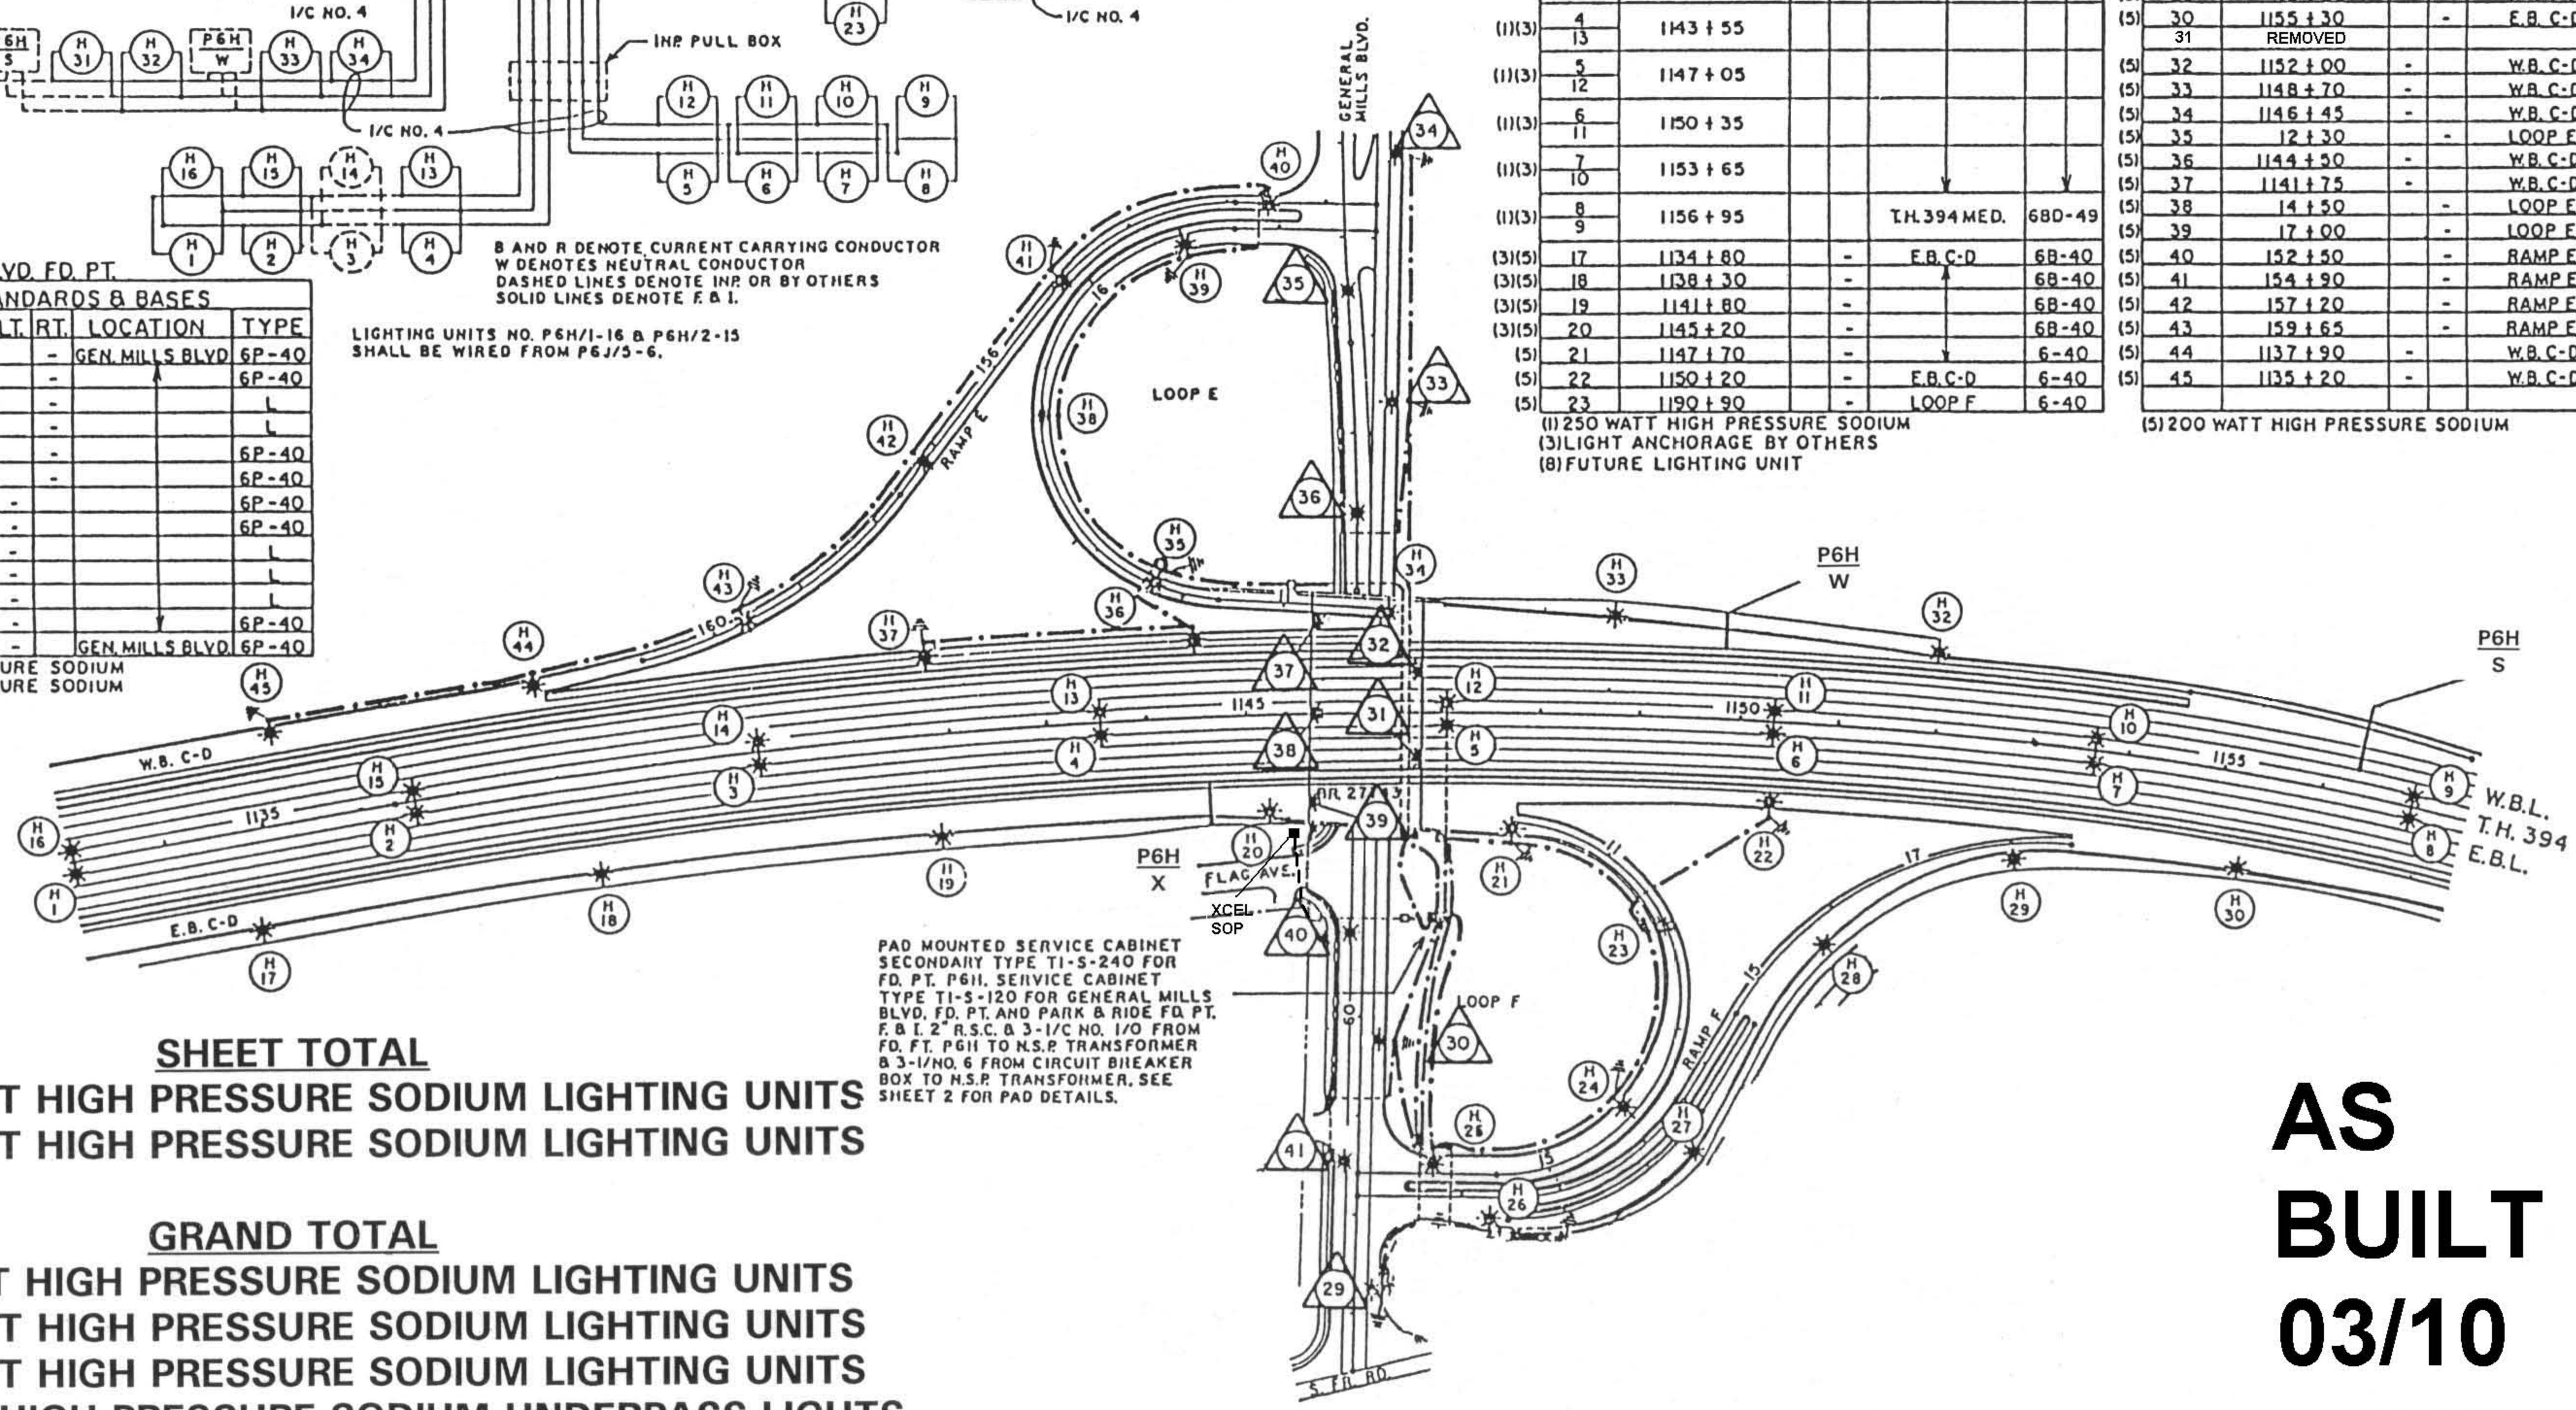

PAD MOUNTED SERVICE CABINET
SECONDARY TYPE T1-S-240 FOR
FD. PT. P6H. SERVICE CABINET
TYPE T1-S-120 FOR GENERAL MILLS
BLVD. FD. PT. AND PARK & RIDE FD. PT.
F & I. 2" R.S.C. & 3-1/2" NO. 1/0 FROM
FD. PT. P6H TO N.S.P. TRANSFORMER
& 3-1/2" NO. 6 FROM CIRCUIT BREAKER
BOX TO N.S.P. TRANSFORMER. SEE
SHEET 2 FOR PAD DETAILS.

SHEET TOTAL
16 - 250 WATT HIGH PRESSURE SODIUM LIGHTING UNITS
29 - 200 WATT HIGH PRESSURE SODIUM LIGHTING UNITS

GRAND TOTAL
3 - 400 WATT HIGH PRESSURE SODIUM LIGHTING UNITS
66 - 250 WATT HIGH PRESSURE SODIUM LIGHTING UNITS
85 - 200 WATT HIGH PRESSURE SODIUM LIGHTING UNITS
10 - 200 WATT HIGH PRESSURE SODIUM UNDERPASS LIGHTS
29 - 250 WATT MERCURY VAPOR SIGN LIGHTS

△ LIGHTS NOT INCLUDED IN THIS EXHIBIT

**AS
BUILT
03/10**

EXHIBIT 7D
T.H. 394 & GENERAL MILLS BLVD.
IN GOLDEN VALLEY
N.S.P.

FD. PT. P6H